

**VALUABLE**

SUBJECT ELEV. WELL HOUSE  
# RR-46 RIFLE RANGE

RETURN TO  
 PUBLIC WORKS  
 OFFICE  
 CAMP LEJEUNE  
 NORTH CAROLINA

FIELD PARTY  
DENNIS IN CHARGE  
 \_\_\_\_\_ INSTRUMENT  
 \_\_\_\_\_ NOTES  
 \_\_\_\_\_ TAPE READ  
 \_\_\_\_\_ TAPE OR ROD  
 \_\_\_\_\_ TAPE OR ROD  
 \_\_\_\_\_ INSTRUMENT No.  
 \_\_\_\_\_ TAPE No.

WEATHER  
 CLEAR \_\_\_\_\_ SNOW \_\_\_\_\_  
 CLOUDY \_\_\_\_\_ HOT \_\_\_\_\_  
 WINDY \_\_\_\_\_ MODERATE \_\_\_\_\_  
 RAIN \_\_\_\_\_ COLD \_\_\_\_\_  
 FAIR \_\_\_\_\_ FOG \_\_\_\_\_  
 FIGURED BY \_\_\_\_\_  
 NOTES CHECKED BY \_\_\_\_\_  
 PLOTTED BY \_\_\_\_\_

FILE No. \_\_\_\_\_  
 FLDR. No. \_\_\_\_\_  
 SHEET 1 of 1  
 DATE 12-19-50

Quad. No. \_\_\_\_\_

STATION	DIST.	ANGLE ° ' "	H. I. BEARING	VER. ANG. DIFF.	ELEVATION	
B.m.			346 59 56	✓	54 10	SPIKE IN P.P. # SR-26 S.E. SIDE OF RANGER D. BETWEEN GUARD HOUSE AND BLDG. # RR-39
T.P.			362 56 09	✓	7.09 52 47	
T.P.			5 32 57 99	✓	3.42 52 67	
			2 96 57 93	✓	3.02 54 97	FLOOR RR-46
T.P.			3 36 55 94	✓	5 35 52 58	
T.P.			6 60 59 59	✓	2.95 52 99	
B.m.				✓	3 49 56 10	SAME AS ABOVE

REV LEAD 2

REV LEAD 2

REV LEAD 2

REV LEAD 2



Faint, illegible text at the bottom of the page, possibly bleed-through from the reverse side.

19537

**VALUABLE**

Return To  
Public Works  
Office  
Camp Lejeune  
North Carolina


SUBJECT Location Well  
House # R.R. 48

**FIELD PARTY**  
Tullinger in Charge  
Instrument \_\_\_\_\_  
Notes \_\_\_\_\_  
Tape Read \_\_\_\_\_  
Tape or Rod \_\_\_\_\_  
Tape or Rod \_\_\_\_\_  
Instrument No. \_\_\_\_\_  
Tape No. \_\_\_\_\_

**WEATHER**  
Clear \_\_\_\_\_  
Cloudy \_\_\_\_\_  
Windy \_\_\_\_\_  
Rain \_\_\_\_\_  
Fair \_\_\_\_\_  
Snow \_\_\_\_\_  
Hot \_\_\_\_\_  
Moderate \_\_\_\_\_  
Cold \_\_\_\_\_  
Fog \_\_\_\_\_

FILE No. 218-13  
Fldr. No. \_\_\_\_\_  
Sheet 48049  
Date 5-29 19 46  
Quad. No. 218

Station	Dist.	Angle " "	+	H. I. Bearing	Ver: Ang. Diff.	Elevation
Well House R.R. 48 Cor A	55'					
		121 56 30				
		5 49 30				
		121 56 30				
Cor B	61 1/2'					
		130 05 15				
		30 16				
		130 05 20				
PI A	739 1/8					
		195 37				
		226 51				
		195 37	M			
at #104						
BS Mon 103						

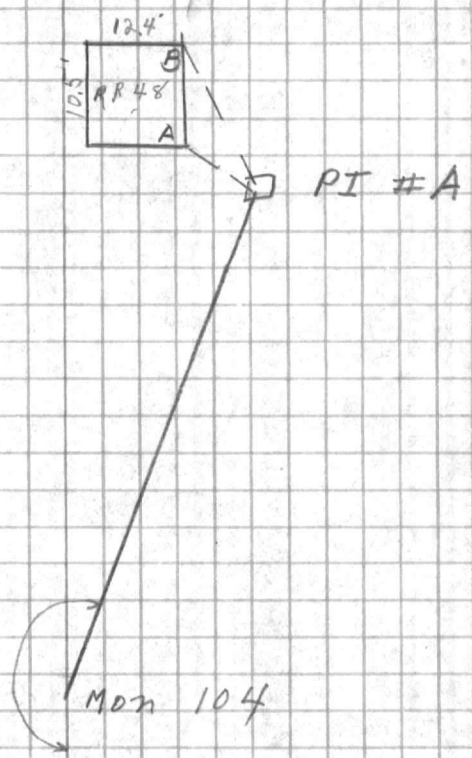

Plotted By: VLT 6-5-46  
Checked By: J.F.M. 6-11-46

Mon 103














**VALUABLE**

SUBJECT BENCH MARKS FOR  
PROPOSED WELL SITE AT  
RIFLE RANGE

RETURN TO  
PUBLIC WORKS  
OFFICE  
CAMP LEJEUNE  
NORTH CAROLINA

FIELD PARTY  
DENNIS IN CHARGE  
INSTRUMENT \_\_\_\_\_  
NOTES \_\_\_\_\_  
TAPE READ \_\_\_\_\_  
TAPE OR ROD \_\_\_\_\_  
TAPE OR ROD \_\_\_\_\_  
INSTRUMENT NO. \_\_\_\_\_  
TAPE NO. \_\_\_\_\_

WEATHER  
CLEAR \_\_\_\_\_ SNOW \_\_\_\_\_  
CLOUDY \_\_\_\_\_ HOT \_\_\_\_\_  
WINDY \_\_\_\_\_ MODERATE \_\_\_\_\_  
RAIN \_\_\_\_\_ COLD \_\_\_\_\_  
FAIR \_\_\_\_\_ FOG \_\_\_\_\_  
FIGURED BY \_\_\_\_\_ SHEET 1 of 1  
NOTES CHECKED BY \_\_\_\_\_ DATE 11-5-58  
PLOTTED BY \_\_\_\_\_

FILE No. 218-13  
FLDR. No. \_\_\_\_\_  
DATE 11-5-58

Quad. No. \_\_\_\_\_

STATION	DIST.	ANGLE			H. I. BEARING	VER: ANG. DIFF.	ELEVATION	
		°	'	"				
B.m.				5 10	54.71	49.61	✓	MON # 101
B.m.				2.74	54.80	2 65 52.06	✓	ON TOP BOLT N.E. PIER WATER TANK AT RIFLE RANGE For Well T-18
B.m.						5 19 49.61	✓	MON # 101
B.m.				3 43	59.53	56 10		SPIKE IN P.P.# SR-26 EAST SIDE OF RANGER D. BETWEEN GUARD GATE & BLDG.# RR-39
B.m.				5 48	59.71	5 30 54.23		SPIKE IN P.P.# SR-24 NEAR GUARD GATE For Well T-19
B.m.						3 61 56.10		SPIKE IN P.P.# SR-26


























VALUABLE

SUBJECT Officer Holmes  
Rifle Range

Return To  
 Public Works  
 Office  
 Camp Lejeune  
 North Carolina

FIELD PARTY  
Turlington In Charge  
 Instrument \_\_\_\_\_  
 Notes \_\_\_\_\_  
 Tape Read \_\_\_\_\_  
 Tape or Rod \_\_\_\_\_  
 Tape or Rod \_\_\_\_\_  
 Instrument No. \_\_\_\_\_  
 Tape No. \_\_\_\_\_

WEATHER  
 Clear \_\_\_\_\_  
 Cloudy  \_\_\_\_\_  
 Windy \_\_\_\_\_  
 Rain \_\_\_\_\_  
 Fair \_\_\_\_\_  
 Snow \_\_\_\_\_  
 Hot \_\_\_\_\_  
 Moderate \_\_\_\_\_  
 Cold \_\_\_\_\_  
 Fog \_\_\_\_\_  
 Figured By \_\_\_\_\_  
 Notes Checked By \_\_\_\_\_  
 Plotted By \_\_\_\_\_


FILE No. 218-13  
 Fldr. No. \_\_\_\_\_  
 Sheet 2/049  
 Date 6/3 19 46

Quad. No. \_\_\_\_\_

Station	Dist.	Angle	+	H. I. Bearing	Ver: Ang. Diff.	Elevation
House 39						
		7619 30				
(3)		228 58 30				
		7619 30				
Well # RR 49						
(2)		173 15				
		19 01 30				
		57 04 30				
(1)		19 01 30	M			
		172 89				
		13 51 45				
		41 35 15				
		13 51 45	M			

Tat Mon #103

BS  
 Water Tank

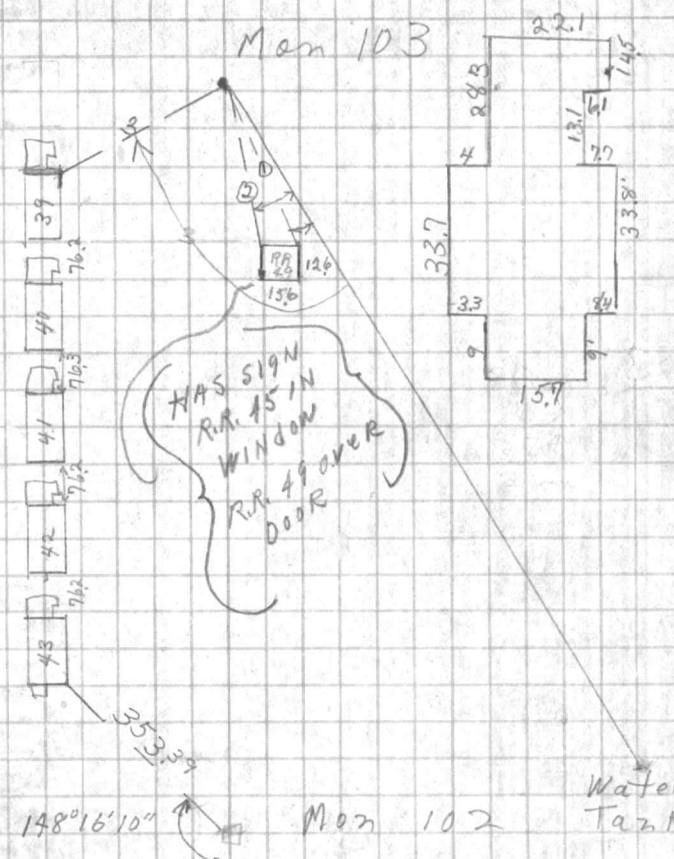

Plotted By: J.F.M. 6-11-46  
 Checked By: V.L.T. 7-31-46

MON 101





































PUBLIC WORKS DEPARTMENT  
Camp Lejeune, North Carolina  
Survey Department

File 218-B  
Quadrangle 218  
Date 4 June 1946  
Sheet 1 of 3

Traverse Computation  
Description

*Building Coordinates - Rifle Range Area*

*R.D.D.*

Station	Distance	Bearing	Cosine	Sine	Latitude	Departure	Y Coordinate North	X Coordinate East
Mon. 101 to 102 Bldg. # 43	353.39	50°54'27"E	8420943	5393302	297.59	190.59	309,686.87	2,466,660.00
Mon. 103 to Water Tank Well # RR 45 (1)	172.89	N1°19'46"W	9997314	0231720	172.84	4.05	308,817.31	2,466,674.70
" " " (2)	173.15	N3°50'05"E	9977611	0668786	172.76	11.58	308,990.07	2,466,686.28
Bldg. # 39	209.15	N61°08'05"E	4827517	8757572	100.96	183.16	308,918.27	2,466,857.01
Mon. 102 to 101 Bldg. # RRS	29.04	N0°54'27"W	0172924	9998505	0.50	29.03	309,686.27	2,466,631.90
Mon. 101 to 102 Bldg. # RRI	29.00	S89°00'33"W	0170500	9998546	0.49	28.99	310,634.74	2,466,616.93
Mon. 102 to 101 Bldg. # RR 47 (1)	139.80	S0°54'27"E	9785968	2057867	136.80	78.60	310,634.74	2,466,616.93
" " " (2)	142.40	N11°55'32"W	9572816	2891571	136.31	41.17	310,771.54	2,466,617.37
" " 19 (3)	444.31	N16°48'27"W	9209834	3896017	409.20	173.10	311,043.94	2,466,472.87
" " 16 (4)	628.14	N22°55'47"W	4800661	8772373	301.55	551.02	310,936.29	2,466,094.90
" " 17 (5)	464.01	N61°18'37"W	6203609	7843164	287.85	363.93	310,927.59	2,466,791.99
" " 17 (6)	441.60	N51°39'27"W	6765654	7363825	298.77	325.18	310,933.51	2,466,370.71

Plotted By: V.C.T. 6-5-46  
checked By: J.F.M. 6-11-46



PUBLIC WORKS DEPARTMENT  
Camp Lejeune, North Carolina  
Survey Department

File 218-13  
Quadrangle 218  
Date 4 June 1946  
Sheet 7 of 3

Traverse Computation  
Description

*Building Coordinates - Rifle Range Area*

*RDP*

Station	Distance	Bearing	Cosine	Sine	Latitude	Departure	Y Coordinate North	X Coordinate East
Bldg. # RR18 (7)	405.71	N30°00'12"W	8657054	5005541	350.79	202.22	310,634.74	2,466,645.92
" " " (8)	400.34	N26°56'27"W	8914748	4530702	356.89	181.38	310,991.63	2,466,464.54
U.S.N. # 7 to 6		S2°24'00"E					309,079.90	2,468,792.24
Bldg. # 210	7.00	S46°54'00"W	6836984	7297646	4.78	5.10	309,075.12	2,468,787.14
" " 217	105.05	S84°42'30"E	0922257	9957381	4.68	104.60	309,070.42	2,468,896.84
U.S.N. # 6 to 7		N2°24'00"E					308,138.29	2,468,752.78
Bldg. # 201	7.05	N42°43'40"W	7345857	6785159	5.17	4.78	308,143.46	2,468,748.00
" " 211	104.86	N89°34'30"E	0074175	9999725	0.78	104.85	308,137.27	2,468,857.63
U.S.N. # 7 to 6		S2°24'00"W					308,138.29	2,468,752.78
Bldg. # 218	204.75	S89°44'30"E	0030543	9999953	8.48	204.72	308,134.81	2,468,957.50
U.S.N. # 6 to 7		N2°24'00"E					309,079.90	2,468,792.24
Bldg. # 206	204.92	S86°07'00"E	0677250	9977040	13.88	204.45	309,066.02	2,468,996.69
U.S.N. # 6 to 7		N2°24'00"E					308,138.29	2,468,752.78
P.O.T.	555.21	N2°24'00"E	9991228	0418256	554.72	23.25	308,693.01	2,468,776.53

Plotted By: J.F.M. 6-11-46  
Checked By: VLT 8-6-46



PUBLIC WORKS DEPARTMENT  
Camp Lejeune, North Carolina  
Survey Department

File 218-B  
Quadrangle 218  
Date 4 June 1946  
Sheet 3 of 3

Traverse Computation  
Description

*Building Co-ordinates - Rifle Range Area.*

*RDP*

Station	Distance	Bearing	Cosine	Sine	Latitude	Departure	Y Coordinate North	X Coordinate East
							308,693.01	2,468,776.03
Bldg. # 200 (1)	314.80	S59°52'20"W	5019301	8649082	158.00	272.27	308,535.01	2,468,503.76
" " (2)	370.90	S77°49'10"W	2109930	9774876	78.25	362.55	308,614.76	2,468,413.48
Well T-1 HRR227 (3)	603.38	S79°33'20"W	1812820	9834311	109.38	593.38	308,583.63	2,468,182.65
(4)	608.80	S80°45'50"W	1605033	9870353	97.71	600.90	308,595.30	2,468,175.13
Mon. 103 to 104		S0°54'26"E					308,217.66	2,466,684.20
P.T. # A	739.18	S14°42'34"W	9673259	2539174	715.03	187.69	307,502.63	2,466,496.51
Bldg. # RR 48 (A)	55.00	S43°20'56"E	7772873	6864391	40.00	37.75	307,467.63	2,466,534.26
" " " " (B)	61.41	S35°12'06"E	8171281	5764561	50.18	35.40	307,487.25	2,466,531.91
102 to 101		N0°54'26"W					309,686.87	2,466,660.93
P.O.T.	180.0	N0°54'26"W	9998746	0158333	179.98	2.85	309,866.85	2,466,658.09
Bldg. # RR 6 (A)	386.84	S83°20'04"W	1160736	9933080	44.90	384.25	309,821.95	2,466,273.83
" " " " (B)	415.26	N81°15'26"W	1519988	9883807	63.11	410.43	309,949.96	2,466,247.65

Plotted By: *J.F.M.* 6-11-46  
Checked By: *YLT* 8-6-46

11030 ZID  
 599  
 217  
 1226  
 De Hoop  
 11710

$$\begin{array}{r}
 24 \overline{) 160} \\
 \underline{144} \phantom{0} \\
 160
 \end{array}$$

VALUABLE

SUBJECT

TEST BORING

Return To  
Public Works  
Office  
Camp Lejeune  
North Carolina

RIFLE RANGE

Swimming Pool

FIELD PARTY  
Garner In Charge  
Instrument  
Notes  
Tape Read  
Tape or Rod  
Tape or Rod  
Instrument No.  
Tape No.WEATHER  
Clear  
Cloudy  
Windy  
Rain  
Fair  
Snow  
Hot  
Moderate  
Cold  
Fog  
Figured By  
Notes Checked By  
Plotted By

FILE No.

218-B

Fldr. No.

Sheet

#1 of 3

Date

6/26 1946

Quad. No.

218

Station	Dist.	Angle " "	+	H. I. Bearing	Ver: Ang. Diff.	Elevation
1+26.00 = #1		274		5363	89	50.89 44.73 ✓
						Depth of Hole 40 40.7 ✓
		" "		" "	11.5	<del>42.1</del> 33.2 ✓
						Depth of Steel Rod 13.5 31.2 ✓
						06 44.1 ✓

6" OAK  
(GROUND ELE. (INDITCH))  
BLACK SAND (MUD?)  
BROWN SAND

Sand packed too tight to withdraw auger  
from a greater depth.

Contact of 2" Steel Rod with apparently a  
fairly solid strata.

WATER TABLE


























VALUABLE

Return To  
Public Works  
Office  
Camp Lejeune  
North Carolina

SUBJECT Test Boring  
Swimming Pool  
Rifled Range

FIELD PARTY  
Garnett In Charge  
Instrument \_\_\_\_\_  
Notes \_\_\_\_\_  
Tape Read \_\_\_\_\_  
Tape or Rod \_\_\_\_\_  
Tape or Rod \_\_\_\_\_  
Instrument No. \_\_\_\_\_  
Tape No. \_\_\_\_\_

WEATHER  
Clear \_\_\_\_\_  
Cloudy \_\_\_\_\_  
Windy \_\_\_\_\_  
Rain \_\_\_\_\_  
Fair \_\_\_\_\_  
Snow \_\_\_\_\_  
Hot \_\_\_\_\_  
Moderate \_\_\_\_\_  
Cold \_\_\_\_\_  
Fog \_\_\_\_\_  
Figured By \_\_\_\_\_  
Notes Checked By \_\_\_\_\_  
Plotted By \_\_\_\_\_  
Quad. No. 218

FILE No. 218-13  
Fldr. No. \_\_\_\_\_  
Sheet # 2 of 3  
Date 6/26 1946

Station	Dist.	Angle "	+	H. I. Bearing	Ver: Ang. Diff.	Elevation	
				274 53 63		50.89	6" OAK
					9 13	44.50	GROUND ELE. BRACK MUD BROWN SAND 90% CLAY - SAND BLIE MUCK
				Depth of Hole 45		40.0	
				" " "	140	30.5	
				" " "	220	22.5	
				Water Table	1.5	43.0	

1467.00  
= H2















VALUABLE

SUBJECT

Test Borings  
Swimming Pool  
11 Rifled Range

Return To  
Public Works  
Office  
Camp Lejeune  
North Carolina

FIELD PARTY

Garner In Charge  
Instrument  
Notes  
Tape Read  
Tape or Rod  
Tape or Rod  
Instrument No.  
Tape No.

WEATHER

Clear  
Cloudy  
Windy  
Rain  
Fair  
Snow  
Hot  
Moderate  
Cold  
Fog

FILE No. 218-15  
Fldr. No. \_\_\_\_\_  
Sheet # 3 of 3  
Date 6/26 19 46  
Plotted By \_\_\_\_\_  
Quad. No. 218

Station	Dist.	Angle " "	+	H. I. Bearing	Ver: Ang. Diff.	Elevation	
				274 5363		50.89	6" OAK
2+12.00 = #3					11.8	41.83 ✓	GROUND ELE.
				Depth of Hole	3.0	38.8 ✓	BLACK MUD
				" " "	11.0	30.8 ✓	BROWN SAND
				Depth of Steel Rod	11.0	30.8 ✓	
				Water Table	2.6	39.2 ✓	Sand Packed too tight to withdraw auger from a greater depth.

































VALUABLE

Return To  
Public Works  
Office  
Camp Lejeune  
North Carolina

SUBJECT

Location Bldg  
# 6 Rifle Range

FIELD PARTY

Turlington In Charge  
Instrument  
Notes  
Tape Read  
Tape or Rod  
Tape or Rod  
Instrument No.  
Tape No.


WEATHER

Clear  
Cloudy  
Windy  
Rain  
Fair  
Snow  
Hot  
Moderate  
Cold  
Fog

FILE No. 218-13  
Fldr. No.  
Sheet 49079  
Date 5-29 1946  
Quad. No. 218

Station	Dist.	Angle	"	+	H. I. Bearing	Ver: Ang. Diff.	Elevation
Bldg RR 6							
Cor A	386 <sup>84</sup>						
	84	1430					
	252	4330					
	84	1430		M			
Cor B	415 <sup>26</sup>						
	99	39					
	298	57					
	99	39		M			

Δ Mon 101

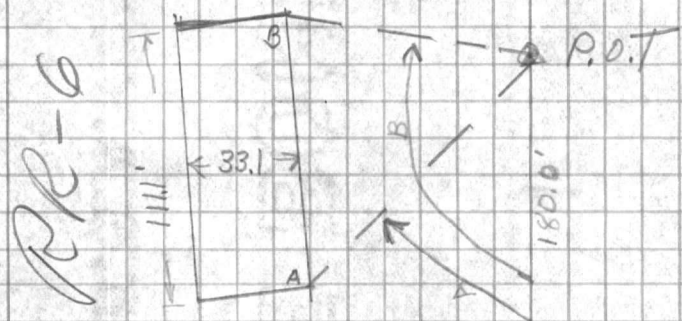

Δ Mon # 102

Plotted By: TDR  
6-7-46

Plotted By: V.C.T. 6-5-46  
Checked By: J.F.M. 6-11-46













