

**VALUABLE**

SUBJECT LOCATION WATER LINE  
CH & 'A' ST. CAMPGEIGER

RETURN TO  
PUBLIC WORKS  
OFFICE  
CAMP LEJEUNE  
NORTH CAROLINA

**FIELD PARTY**

DEWIK IN CHARGE  
\_\_\_\_\_  
INSTRUMENT  
\_\_\_\_\_  
NOTES  
\_\_\_\_\_  
TAPE READ  
\_\_\_\_\_  
TAPE OR ROD  
\_\_\_\_\_  
TAPE OR ROD  
\_\_\_\_\_  
INSTRUMENT NO. \_\_\_\_\_  
TAPE NO. \_\_\_\_\_


**WEATHER**

CLEAR \_\_\_\_\_  
CLOUDY \_\_\_\_\_  
WINDY \_\_\_\_\_  
RAIN \_\_\_\_\_  
FAIR \_\_\_\_\_  
SNOW \_\_\_\_\_  
HOT \_\_\_\_\_  
MODERATE \_\_\_\_\_  
COLD \_\_\_\_\_  
FOG \_\_\_\_\_

FILE No. 98-P  
FLDR. No. \_\_\_\_\_  
SHEET 1271  
DATE A-C 1954

Quad. No. \_\_\_\_\_

STATION	DIST.	ANGLE			H. I. BEARING	VER. ANG. DIFF.	ELEVATION
		°	'	"			

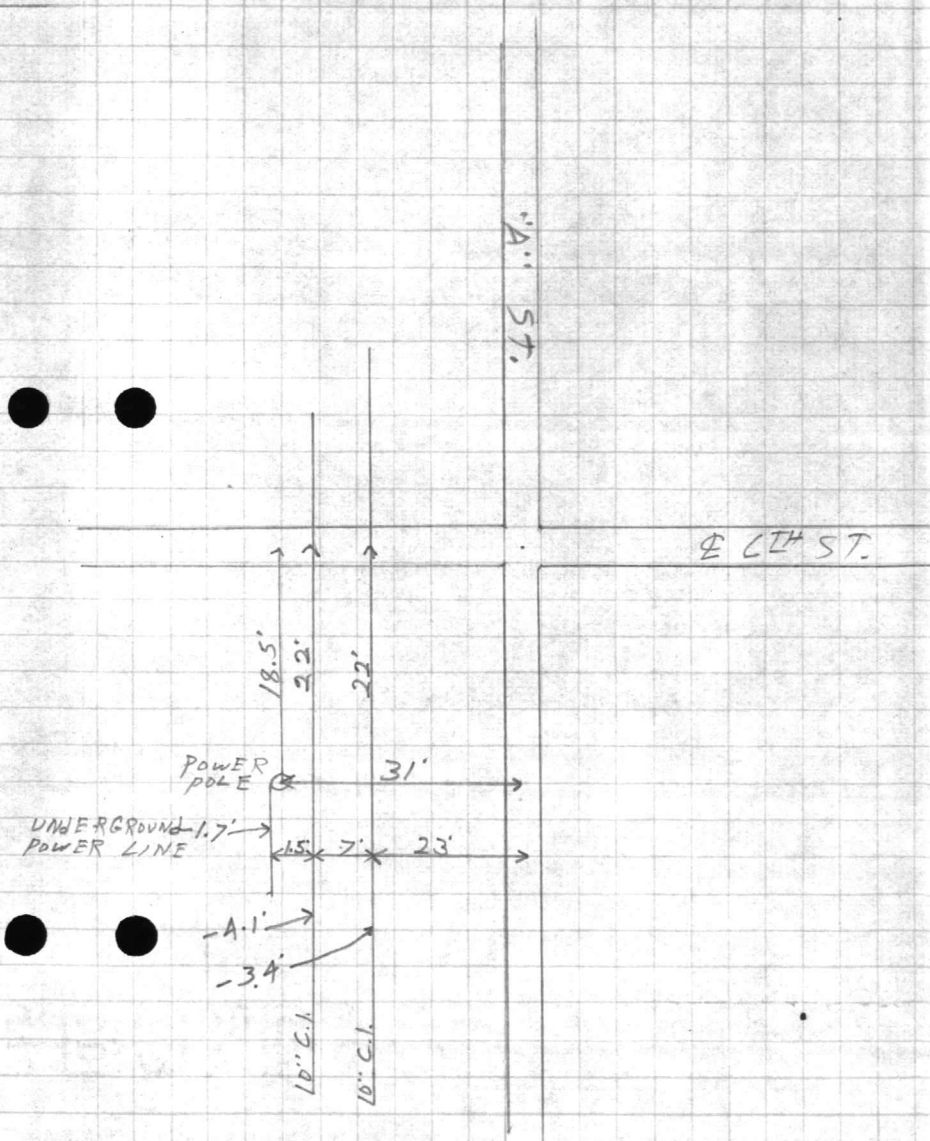












**VALUABLE**

SUBJECT \_\_\_\_\_  
\_\_\_\_\_  
\_\_\_\_\_  
\_\_\_\_\_  
\_\_\_\_\_

RETURN TO  
PUBLIC WORKS  
OFFICE  
CAMP LEJEUNE  
NORTH CAROLINA

**FIELD PARTY**

\_\_\_\_\_  
IN CHARGE  
\_\_\_\_\_  
INSTRUMENT  
\_\_\_\_\_  
NOTES  
\_\_\_\_\_  
TAPE READ  
\_\_\_\_\_  
TAPE OR ROD  
\_\_\_\_\_  
TAPE OR ROD  
\_\_\_\_\_  
INSTRUMENT No.  
\_\_\_\_\_  
TAPE No. \_\_\_\_\_

**WEATHER**


CLEAR  
CLOUDY  
WINDY  
RAIN  
FAIR

SNOW  
HOT  
MODERATE  
COLD  
FOG

FILE No. \_\_\_\_\_  
FLDR. No. \_\_\_\_\_  
SHEET \_\_\_\_\_  
DATE \_\_\_\_\_ 19\_\_

FIGURED BY \_\_\_\_\_  
NOTES CHECKED BY \_\_\_\_\_  
PLOTTED BY \_\_\_\_\_  
Quad. No. \_\_\_\_\_

STATION	DIST.	ANGLE ° ' "	+	H. I. BEARING	VER. ANG. DIFF.	ELEVATION
"F" St						
"E" St						
"D" St						
"C" St						
"B" St						
"A" St						

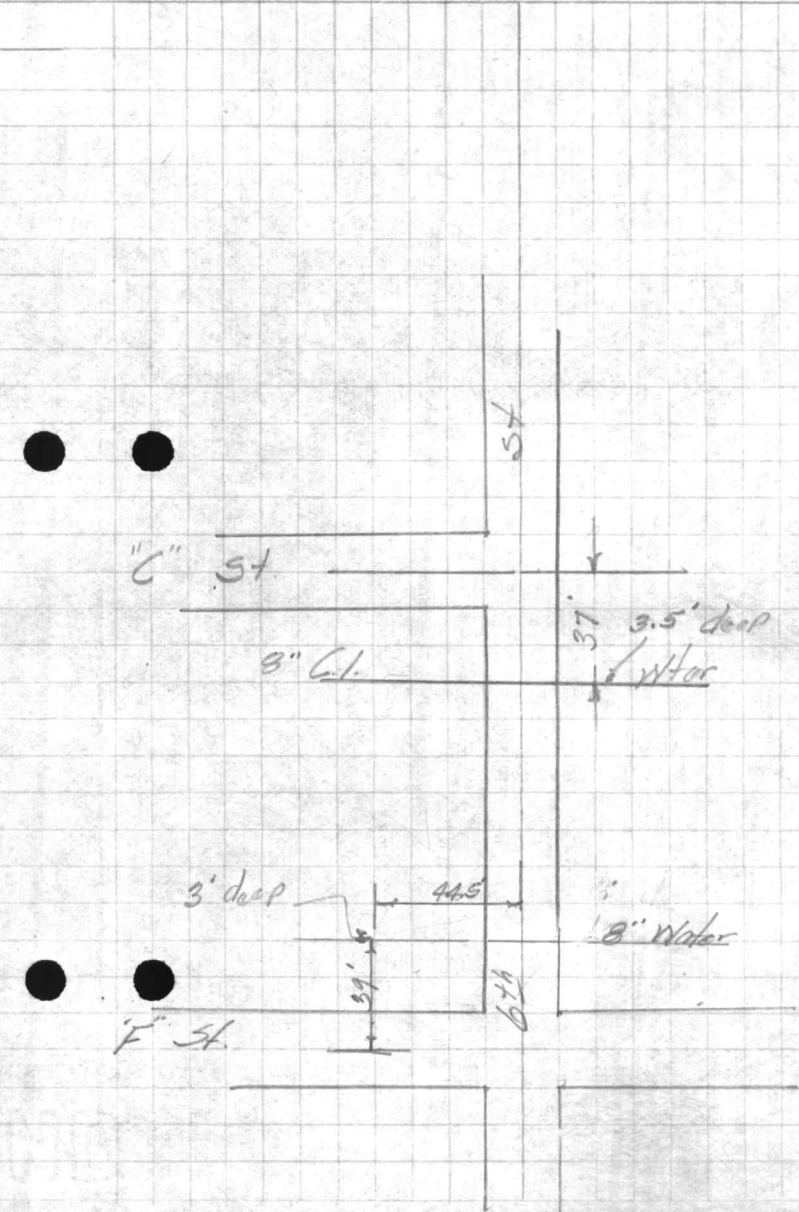













**VALUABLE**

SUBJECT \_\_\_\_\_

 RETURN TO  
 PUBLIC WORKS  
 OFFICE  
 CAMP LEJEUNE  
 NORTH CAROLINA
**FIELD PARTY**
 \_\_\_\_\_ IN CHARGE  
 \_\_\_\_\_ INSTRUMENT  
 \_\_\_\_\_ NOTES  
 \_\_\_\_\_ TAPE READ  
 \_\_\_\_\_ TAPE OR ROD  
 \_\_\_\_\_ TAPE OR ROD  
 \_\_\_\_\_ INSTRUMENT NO.  
 \_\_\_\_\_ TAPE NO.
**WEATHER**
 CLEAR  
 CLOUDY  
 WINDY  
 RAIN  
 FAIR  
 SNOW  
 HOT  
 MODERATE  
 COLD  
 FOG

FILE No. \_\_\_\_\_

FLDR. No. \_\_\_\_\_

FIGURED BY \_\_\_\_\_

SHEET \_\_\_\_\_

NOTES CHECKED BY \_\_\_\_\_

PLOTTED BY \_\_\_\_\_

DATE \_\_\_\_\_

19\_\_

Quad. No. \_\_\_\_\_

STATION	DIST.	ANGLE			+	H. I. BEARING	VER. ANG. DIFF.	ELEVATION
		°	'	"				

"F" St.

39'

 "E" St.  
 "D" St.

44.5'

"C" St.

34'

8" Water

3.5' deep

15 1/2'


























**VALUABLE**

SUBJECT Location and Elevation  
on Pipes Waterline Bldg  
508 Camp Geiger

RETURN TO  
 PUBLIC WORKS  
 OFFICE  
 CAMP LEJEUNE  
 NORTH CAROLINA

**FIELD PARTY**

\_\_\_\_ IN CHARGE  
 \_\_\_\_ INSTRUMENT  
 \_\_\_\_ NOTES  
 \_\_\_\_ TAPE READ  
 \_\_\_\_ TAPE OR ROD  
 \_\_\_\_ TAPE OR ROD  
 \_\_\_\_ INSTRUMENT NO.  
 \_\_\_\_ TAPE NO.

**WEATHER**


CLEAR \_\_\_\_\_ SNOW \_\_\_\_\_  
 CLOUDY \_\_\_\_\_ HOT \_\_\_\_\_  
 WINDY \_\_\_\_\_ MODERATE \_\_\_\_\_  
 RAIN \_\_\_\_\_ COLD \_\_\_\_\_  
 FAIR \_\_\_\_\_ FOG \_\_\_\_\_  
 FIGURED BY \_\_\_\_\_  
 NOTES CHECKED BY \_\_\_\_\_  
 PLOTTED BY \_\_\_\_\_

FILE No. 98-P  
 FLDR. No. \_\_\_\_\_  
 SHEET 1 of 2  
 DATE 4/12 1954

Quad. No. \_\_\_\_\_

STATION	DIST.	ANGLE ° ' "	+	H. I. BEARING	VER: ANG. DIFF.	ELEVATION	
B.M.						20.31	on transformer pole North Bldg* 508
	7.42	27 73 9			<del>2</del> 68	18.05	Top 12" C.I. Pipe 24.5' from pipe at Bld.
					<del>2</del> 63	18.10	Top 12" C.I. " 14.5' " " "
					<del>2</del> 58	18.15	at storage tank
					11.02	16.71	Top 10" Raw Water line at tank into aerator
					11.08	16.65	at valve on Raw Water Line
B.M.					7.42	20.31 ✓	

check & update

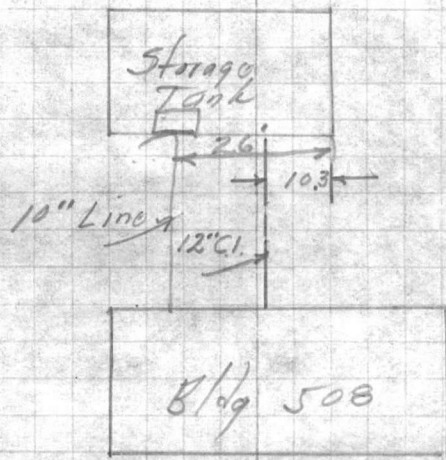





































22

11



**VALUABLE**

SUBJECT \_\_\_\_\_

 RETURN TO  
 PUBLIC WORKS  
 OFFICE  
 CAMP LEJEUNE  
 NORTH CAROLINA

## FIELD PARTY

 \_\_\_\_\_ IN CHARGE  
 \_\_\_\_\_ INSTRUMENT  
 \_\_\_\_\_ NOTES  
 \_\_\_\_\_ TAPE READ  
 \_\_\_\_\_ TAPE OR ROD  
 \_\_\_\_\_ TAPE OR ROD  
 \_\_\_\_\_ INSTRUMENT NO.  
 \_\_\_\_\_ TAPE NO.

## WEATHER

 CLEAR  
 CLOUDY  
 WINDY  
 RAIN  
 FAIR  
 SNOW  
 HOT  
 MODERATE  
 COLD  
 FOG

FILE No. \_\_\_\_\_

FLDR. No. \_\_\_\_\_

SHEET 2 of 2

DATE \_\_\_\_\_ 19\_\_

FIGURED BY \_\_\_\_\_

NOTES CHECKED BY \_\_\_\_\_

PLOTTED BY \_\_\_\_\_

Quad. No. \_\_\_\_\_

STATION	DIST.	ANGLE			H. I. BEARING	VER. ANG. DIFF.	ELEVATION
		°	'	"			
B.M.					3.60 23.91 ✓		20.31
					7.65		16.26
					7.90		16.01
					7.90		16.01
B.M.					3.60 20.31 ✓		

2aw  
 12" Water line at softening plant  
 Entrance  
 10" Raw Water line around Resol.  
 Top Main Raw Water Line 8" on "A" St.









**VALUABLE**SUBJECT Elevs and location pipes  
at water plant Camp LejeuneRETURN TO  
PUBLIC WORKS  
OFFICE  
CAMP LEJEUNE  
NORTH CAROLINA

## FIELD PARTY

Worton IN CHARGE  
 \_\_\_\_\_ INSTRUMENT  
 \_\_\_\_\_ NOTES  
 \_\_\_\_\_ TAPE READ  
 \_\_\_\_\_ TAPE OR ROD  
 \_\_\_\_\_ TAPE OR ROD  
 \_\_\_\_\_ INSTRUMENT No.  
 \_\_\_\_\_ TAPE No.

## WEATHER

CLEAR  
CLOUDY  
WINDY  
RAIN  
FAIR

SNOW  
HOT  
MODERATE  
COLD  
FOG

FILE No. \_\_\_\_\_

FLDR. No. \_\_\_\_\_

SHEET 10 of 1DATE 4/13 1954

FIGURED BY \_\_\_\_\_

NOTES CHECKED BY \_\_\_\_\_

PLOTTED BY \_\_\_\_\_

Quad. No. \_\_\_\_\_

STATION	DIST.	ANGLE		+	H. I. BEARING	VER. ANG. DIFF.	ELEVATION
		°	"				
B.M.				3.94	24.25		20.31
①						6.06	18.19
②						7.82	16.43
B.M.						3.86	20.39
				3.77	24.16		20.39
B.M. -						3.84	20.32 (20.31)
B.M.				0.78	29.09		20.31
①						$\frac{H.I. 29.09}{\text{Rod} + 1.47} =$	30.56
②						4.49	24.60
B.M.						0.78	20.31 (20.31)

on transformer pole North Bldg # 508

Top 8" T.C. drain pipe 10' from bldg  
Inlet outlet 8" T.C. pipe at C.B.

S.E. Cor. door stoop Bldg # 508

Church St.

② C.B.

8" T.C. Pipe

Bldg # 508


626 929

on transformer pole North Bldg # 508

Top of tank

Church St.

bottom of drain

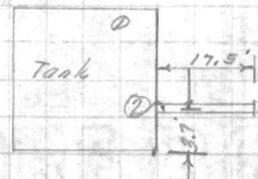

7.01  
4.31  
2.70

7.01  
7.82

1.75  
4.31  
6.06



20.31  
8.78  
29.09

29.09  
1.47  
30.56

20.31  
20.39  
**VALUABLE**

SUBJECT LOCATION & INV. ELEV. OF  
DRAIN PIPES & DROP INLETS  
WATER TREATING PLANT  
CAMP GEIGER.

RETURN TO  
PUBLIC WORKS  
OFFICE  
CAMP LEJEUNE  
NORTH CAROLINA


FIELD PARTY  
DENNIS IN CHARGE  
INSTRUMENT  
NOTES  
TAPE READ  
TAPE OR ROD  
TAPE OR ROD  
INSTRUMENT No.  
TAPE No.

WEATHER  
CLEAR  
CLOUDY  
WINDY  
RAIN  
FAIR  
SNOW  
HOT  
MODERATE  
COLD  
FOG  
FIGURED BY  
NOTES CHECKED BY  
PLOTTED BY

FILE No. \_\_\_\_\_  
FLDR. No. \_\_\_\_\_  
SHEET 1 of 2  
DATE 9-7 1954

Quad. No. \_\_\_\_\_

STATION	DIST.	ANGLE ° ' "	+	H. I. BEARING	VER. ANG. DIFF.	ELEVATION
B.M.				5 04 25 43		20 39
TOP. 12" R.C.P.					11 59	
INV. 6" C.I.				10 09	15 34	
TOP. 12" CROSS				8 37	17 00	
B.M.				5 04	20 39	

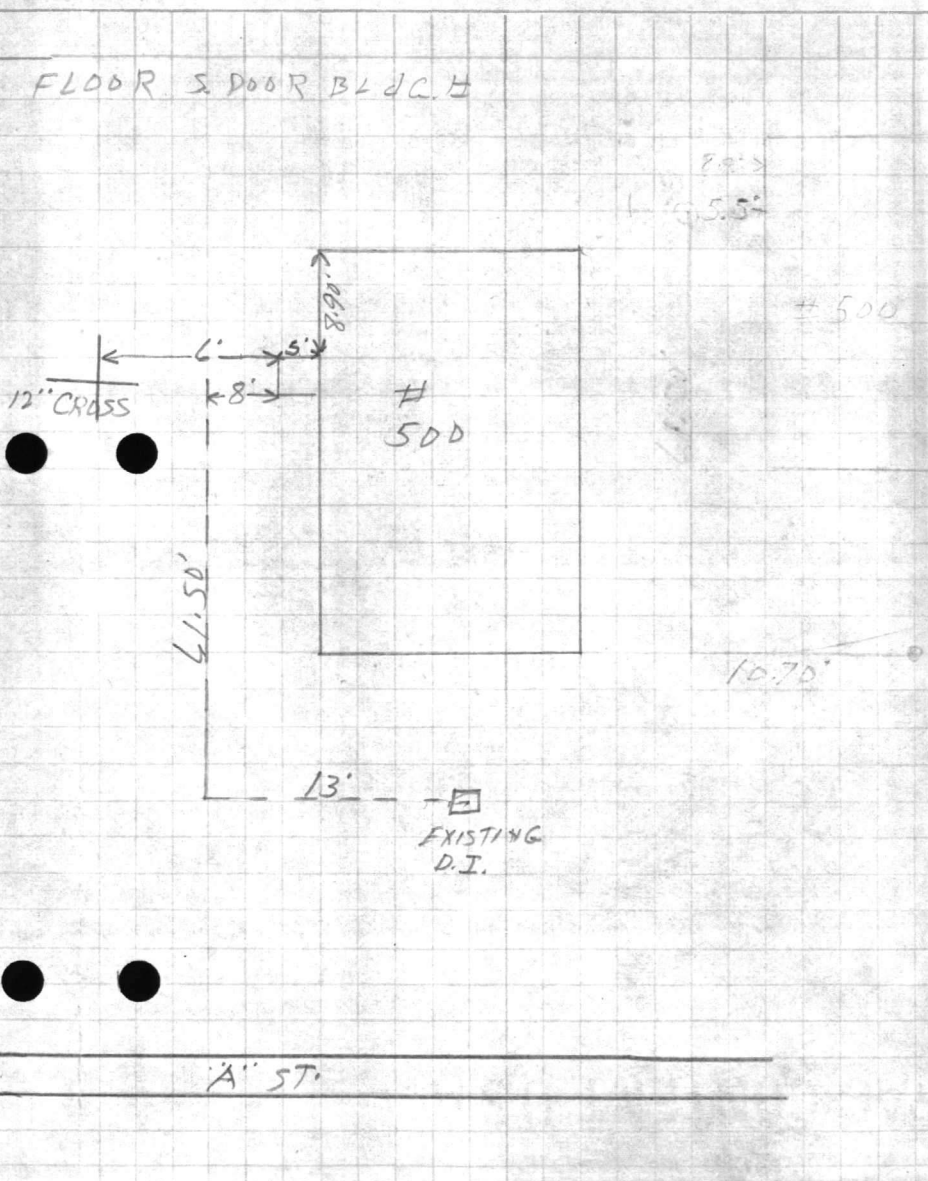






















**VALUABLE**

SUBJECT \_\_\_\_\_  
 \_\_\_\_\_  
 \_\_\_\_\_  
 \_\_\_\_\_  
 \_\_\_\_\_

RETURN TO  
 PUBLIC WORKS  
 OFFICE  
 CAMP LEJEUNE  
 NORTH CAROLINA

**FIELD PARTY**

\_\_\_\_\_  
 IN CHARGE  
 \_\_\_\_\_  
 INSTRUMENT  
 \_\_\_\_\_  
 NOTES  
 \_\_\_\_\_  
 TAPE READ  
 \_\_\_\_\_  
 TAPE OR ROD  
 \_\_\_\_\_  
 TAPE OR ROD  
 \_\_\_\_\_  
 INSTRUMENT No. \_\_\_\_\_  
 TAPE No. \_\_\_\_\_

**WEATHER**

CLEAR \_\_\_\_\_  
 CLOUDY \_\_\_\_\_  
 WINDY \_\_\_\_\_  
 RAIN \_\_\_\_\_  
 FAIR \_\_\_\_\_  
 SNOW \_\_\_\_\_  
 HOT \_\_\_\_\_  
 MODERATE \_\_\_\_\_  
 COLD \_\_\_\_\_  
 FOG \_\_\_\_\_

FILE No. \_\_\_\_\_

FLDR. No. \_\_\_\_\_

SHEET 2 of 2

FIGURED BY \_\_\_\_\_

NOTES CHECKED BY \_\_\_\_\_


PLOTTED BY \_\_\_\_\_

DATE \_\_\_\_\_

19 \_\_\_\_\_

Quad. No. \_\_\_\_\_

STATION	DIST.	ANGLE ° ' "	+	H. I. BEARING	VER: ANG. DIFF.	ELEVATION
				653	<del>26 84</del> 26 64	20 31 X
INV. 6" C.I.					11.80	14.84 15.14
0+13 <sup>35</sup>				6 3		20.3 X
0+32				5 5		21.1
0+54				5 9		20.7
0+57						
0+77				6 6		20.0
0+82 <sup>35</sup>				6 6		20.0
0+90 <sup>11</sup>	Bend			6 5		20.1
1+0				6 6		20.0
1+50				6 9		19.7
1+87	BANK			7 0		19.6
1+95	DITCH			8 4		18.2
1+97	E.R.D.			8 1		18.5
2+0				7 9		18.7
2+11				7 5		19.1
2+22	BANK			6 8		19.8
2+31 <sup>20</sup>	TOP.			12 65		13.99
B.M.				6.52		20.33 20.12
0+15 <sup>35</sup>	TOP 12" C.I.			9.9		16.7
B.M. 1+81 <sup>21</sup>				3.58	23 89	20 31 16.41

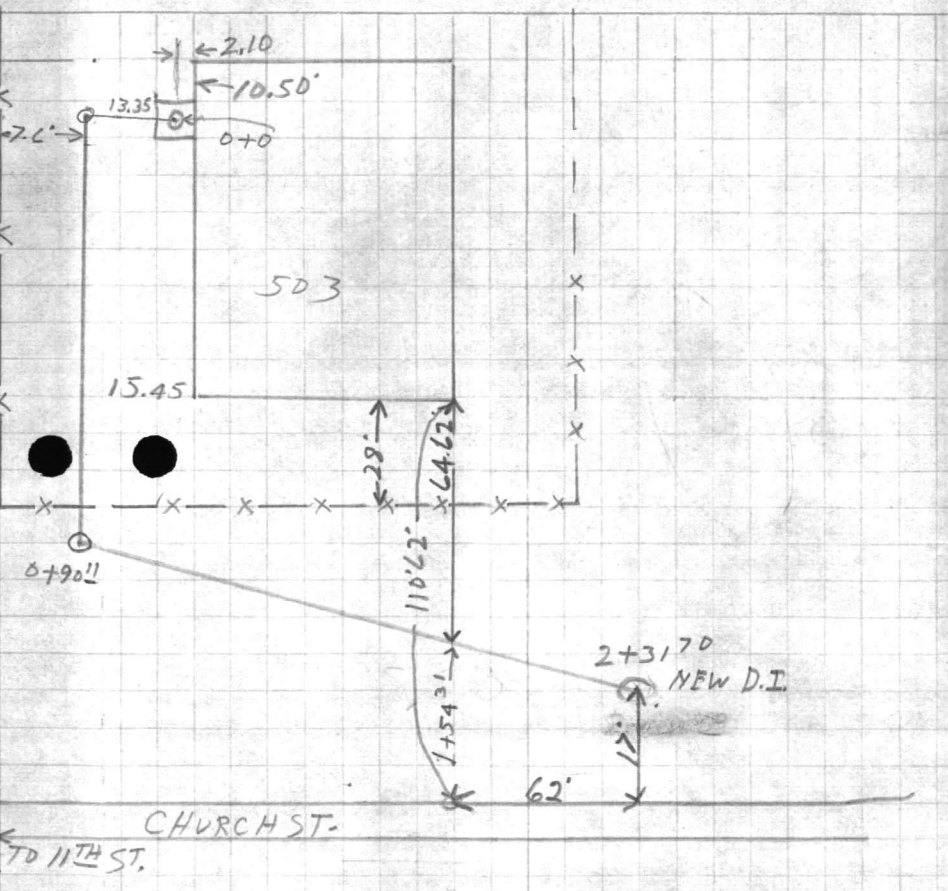

← CHURCH ST.  
 TO 11TH ST.

12" A.C.














**VALUABLE**

SUBJECT

Water Line Locations

RETURN TO  
PUBLIC WORKS  
OFFICE  
CAMP LEJEUNE  
NORTH CAROLINA

Camp Geiger  
Warehouse Section

FIELD PARTY

Morton  
IN CHARGE  
INSTRUMENT  
NOTES  
TAPE READ  
TAPE OR ROD  
TAPE OR ROD  
INSTRUMENT No.  
TAPE No.

WEATHER

CLEAR  
CLOUDY  
WINDY  
RAIN  
FAIR  
SNOW  
HOT  
MODERATE  
COLD  
FOG

FILE No. 98 P

Fldr. No.


FIGURED BY SHEET 1 of 3

NOTES CHECKED BY

PLOTTED BY DATE 10/2 1954

Quad. No.

STATION	DIST.	ANGLE ° ' "	H. I. BEARING	VER. ANG. DIFF.	ELEVATION
---------	-------	----------------	------------------	--------------------	-----------

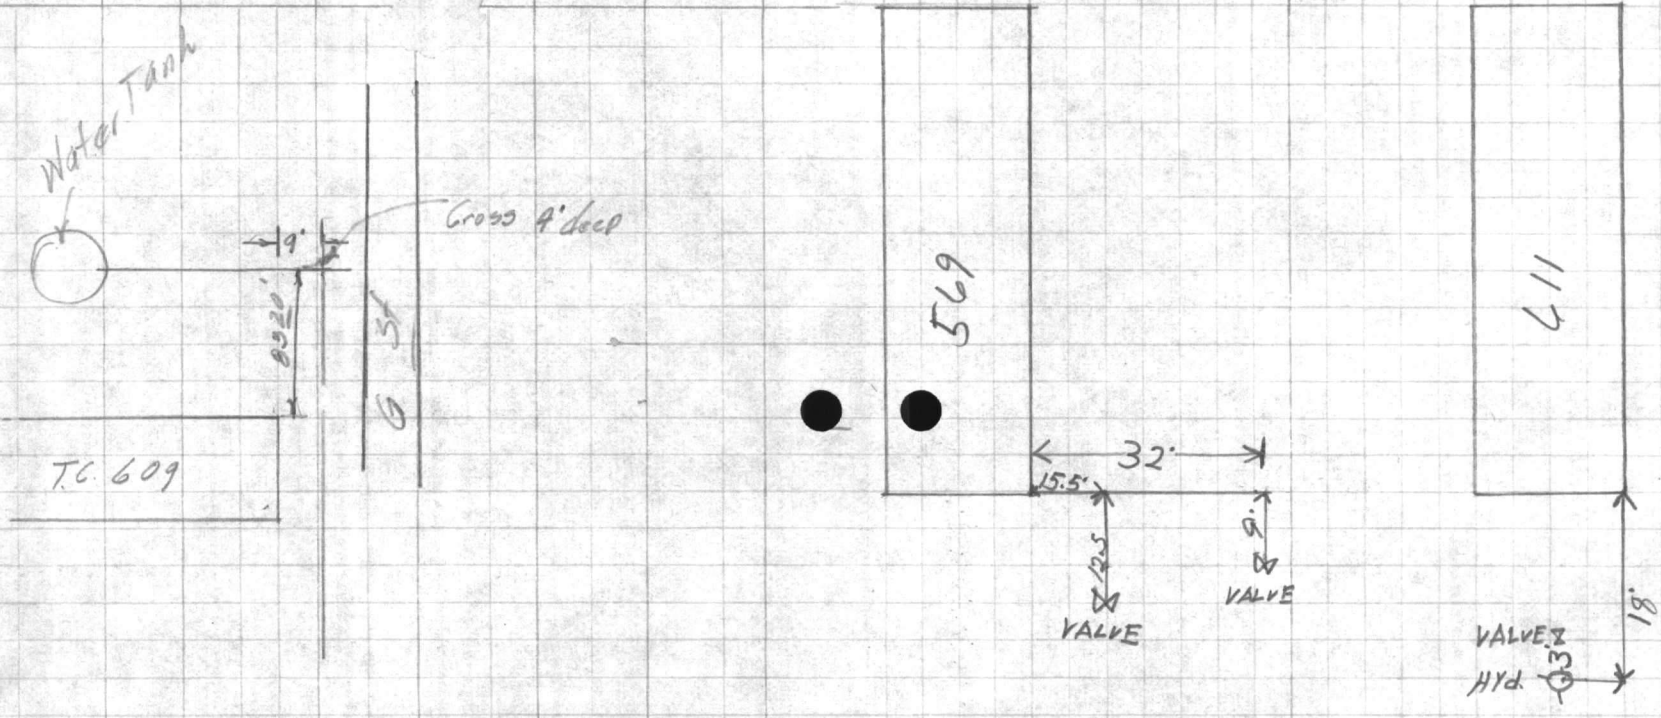














**VALUABLE**

SUBJECT \_\_\_\_\_

RETURN TO  
PUBLIC WORKS  
OFFICE  
CAMP LEJEUNE  
NORTH CAROLINA

**FIELD PARTY**

*Morton* IN CHARGE  
\_\_\_\_\_  
INSTRUMENT  
\_\_\_\_\_  
NOTES  
\_\_\_\_\_  
TAPE READ  
\_\_\_\_\_  
TAPE OR ROD  
\_\_\_\_\_  
TAPE OR ROD  
\_\_\_\_\_  
INSTRUMENT NO.  
\_\_\_\_\_  
TAPE NO. \_\_\_\_\_


**WEATHER**

CLEAR  
CLOUDY  
WINDY  
RAIN  
FAIR  
SNOW  
HOT  
MODERATE  
COLD  
FOG

FILE No. <sup>39</sup>  
21  
8  
FLDR. No. \_\_\_\_\_  
SHEET 26 of 3  
DATE 10-10 1954

FIGURED BY \_\_\_\_\_  
NOTES CHECKED BY \_\_\_\_\_  
PLOTTED BY \_\_\_\_\_  
Quad. No. \_\_\_\_\_

STATION    DIST.    ANGLE  
                  '    "    +  
                  H. I.    VER. ANG.  
                  BEARING    DIFF.  
                  ELEVATION

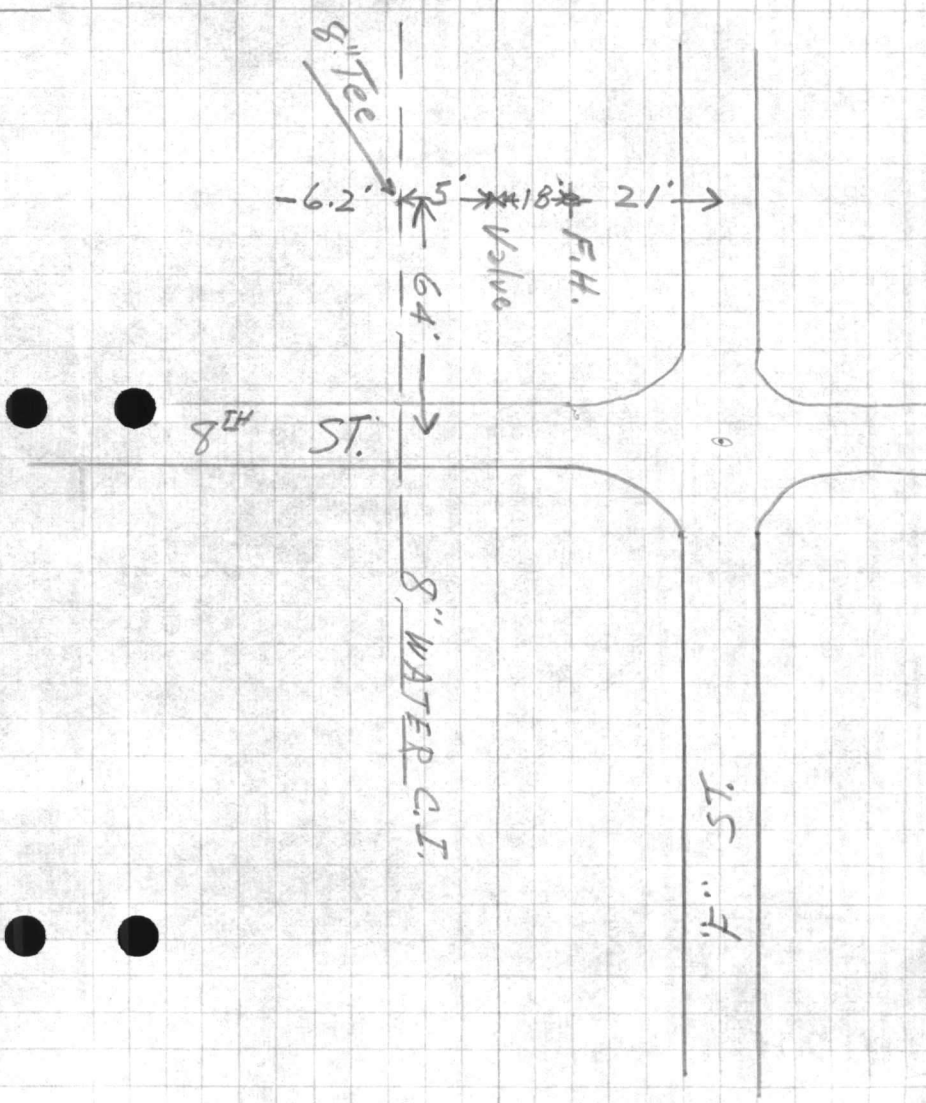









VALUABLE

RETURN TO  
PUBLIC WORKS  
OFFICE  
CAMP LEJEUNE  
NORTH CAROLINA

SUBJECT

Impr. to Water Dist.

Loc. of Ex. Lines

Camp Geiger

FIELD PARTY

\_\_\_\_\_  
IN CHARGE  
\_\_\_\_\_  
INSTRUMENT  
\_\_\_\_\_  
NOTES  
\_\_\_\_\_  
TAPE READ  
\_\_\_\_\_  
TAPE OR ROD  
\_\_\_\_\_  
TAPE OR ROD  
\_\_\_\_\_  
INSTRUMENT NO.  
\_\_\_\_\_  
TAPE NO.

WEATHER

CLEAR  
CLOUDY  
WINDY  
RAIN  
FAIR

SNOW  
HOT  
MODERATE  
COLD  
FOG

FILE No. 98-P

FLDR. No. \_\_\_\_\_


SHEET 1 of 1

DATE 9-7-55

FIGURED BY \_\_\_\_\_  
NOTES CHECKED BY \_\_\_\_\_  
PLOTTED BY \_\_\_\_\_  
Quad. No. \_\_\_\_\_

STATION	DIST.	ANGLE ° ' "	+	H. I. BEARING	VER. ANG. DIFF.	ELEVATION
---------	-------	----------------	---	------------------	--------------------	-----------

NOTE.  
WE DID NOT DIG  
FOR THIS TEE  
GROUND TO WET.

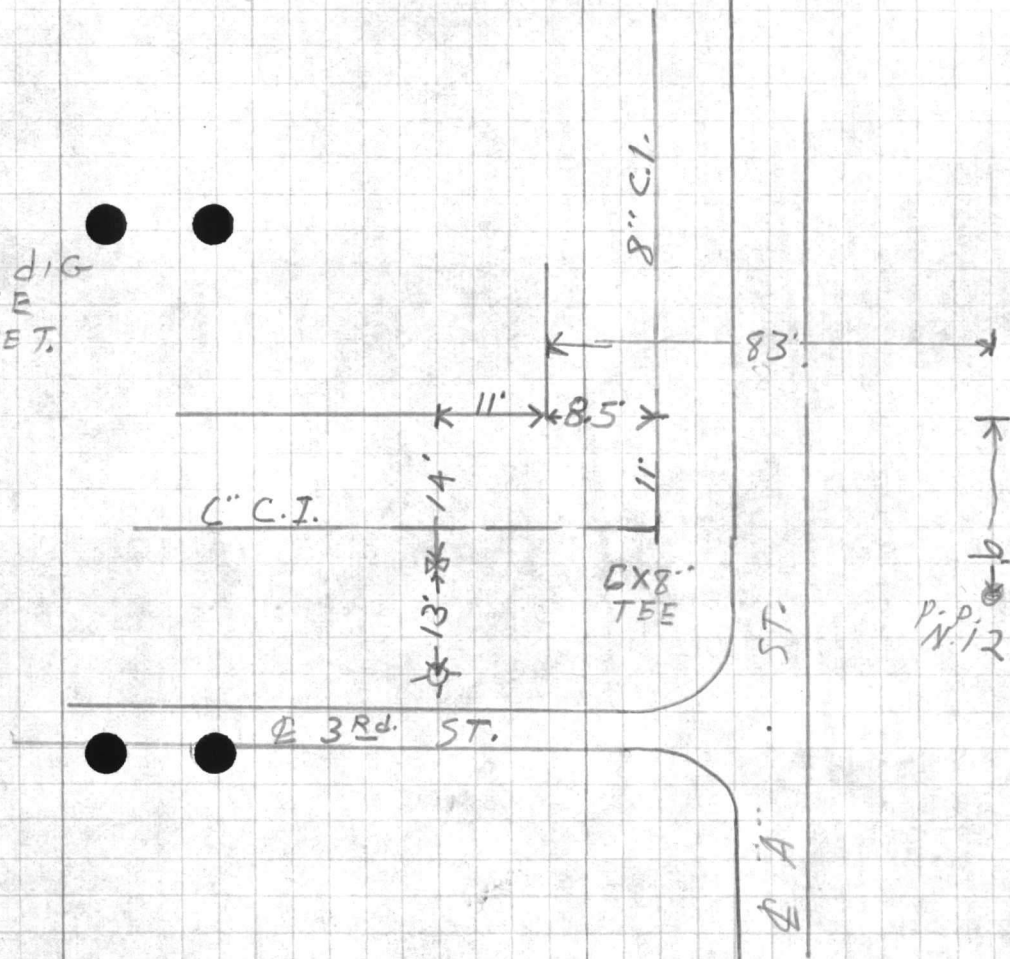








VALUABLE

SUBJECT \_\_\_\_\_

RETURN TO  
PUBLIC WORKS  
OFFICE  
CAMP LEJEUNE  
NORTH CAROLINA

FIELD PARTY

\_\_\_\_\_  
IN CHARGE  
\_\_\_\_\_  
INSTRUMENT  
\_\_\_\_\_  
NOTES  
\_\_\_\_\_  
TAPE READ  
\_\_\_\_\_  
TAPE OR ROD  
\_\_\_\_\_  
TAPE OR ROD  
\_\_\_\_\_  
INSTRUMENT No.  
\_\_\_\_\_  
TAPE No.

WEATHER

CLEAR  
CLOUDY  
WINDY  
RAIN  
FAIR  
SNOW  
HOT  
MODERATE  
COLD  
FOG

FILE No. \_\_\_\_\_


FLDR. No. \_\_\_\_\_

SHEET 18A

DATE 9-2 1955

FIGURED BY \_\_\_\_\_  
NOTES CHECKED BY \_\_\_\_\_  
PLOTTED BY \_\_\_\_\_  
Quad. No. \_\_\_\_\_

STATION	DIST.	LINE ANGLE	H. I. BEARING	VER. ANG. DIFF.	ELEVATION
---------	-------	------------	---------------	-----------------	-----------

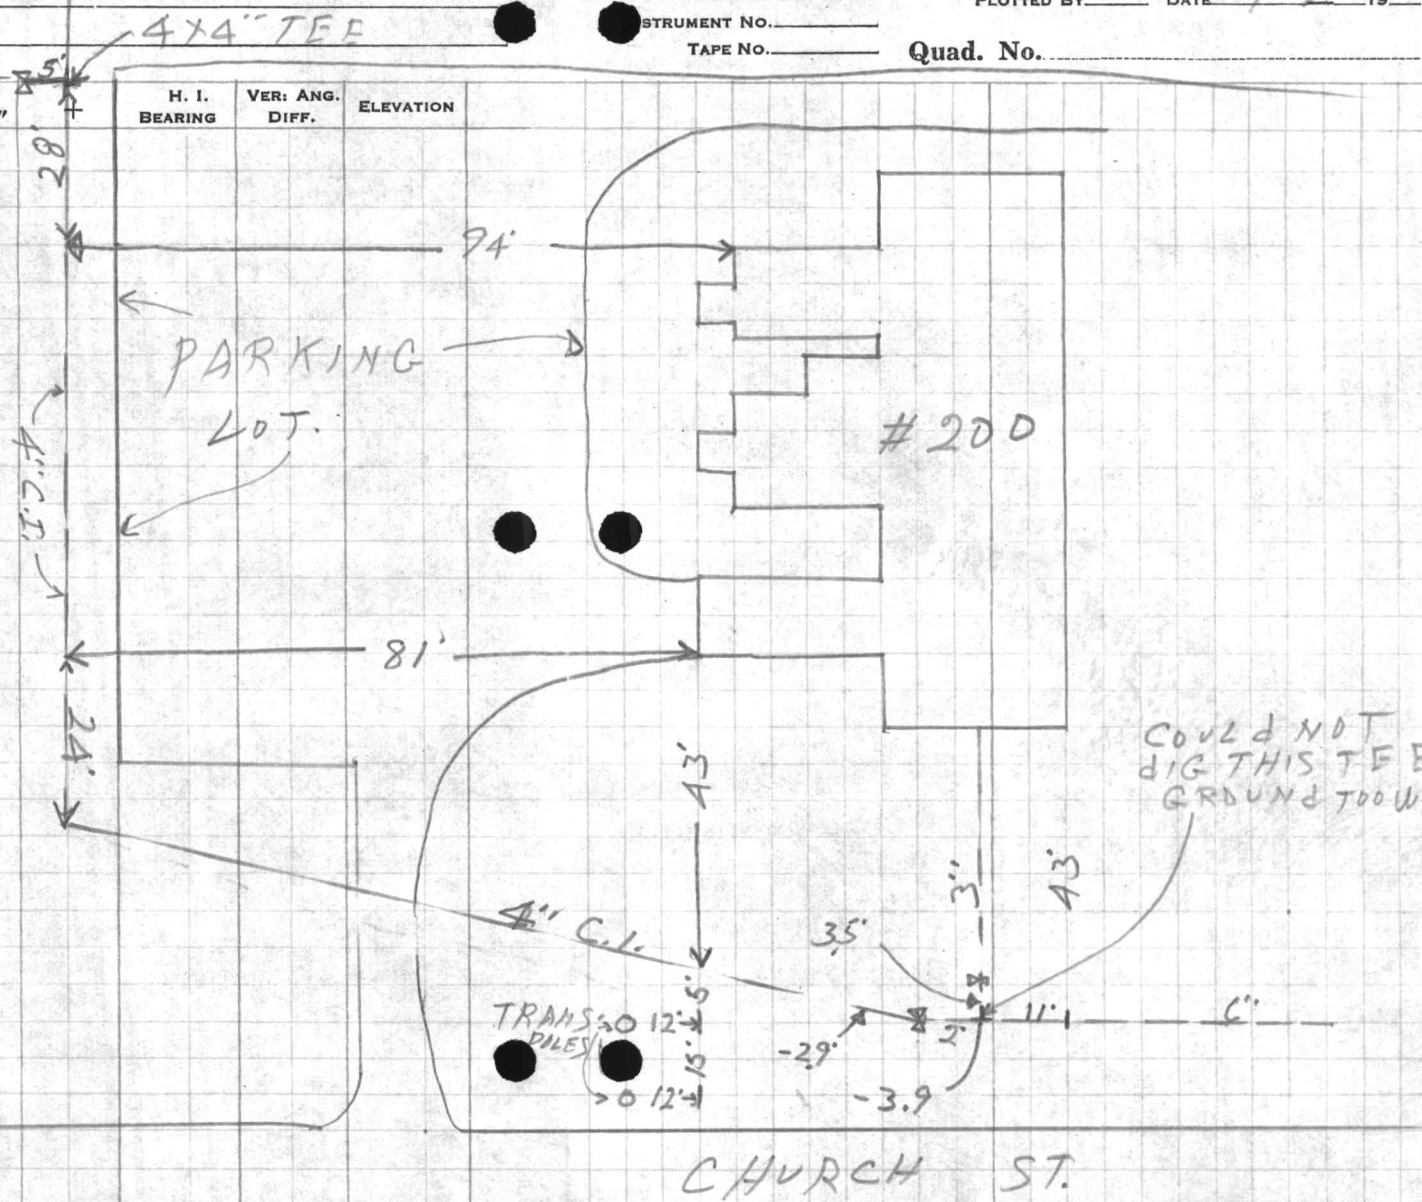

COULD NOT  
DIG THIS TEE  
GROUND TOO WET

48  
43
















































































































































**VALUABLE**

SUBJECT \_\_\_\_\_

RETURN TO  
PUBLIC WORKS  
OFFICE  
CAMP LEJEUNE  
NORTH CAROLINA

**FIELD PARTY**

\_\_\_\_\_  
IN CHARGE  
\_\_\_\_\_  
INSTRUMENT  
\_\_\_\_\_  
NOTES  
\_\_\_\_\_  
TAPE READ  
\_\_\_\_\_  
TAPE OR ROD  
\_\_\_\_\_  
TAPE OR ROD  
\_\_\_\_\_  
INSTRUMENT NO.  
\_\_\_\_\_  
TAPE NO.

**WEATHER**

CLEAR  
CLOUDY  
WINDY  
RAIN  
FAIR

SNOW  
HOT  
MODERATE  
COLD  
FOG

FILE No. \_\_\_\_\_

FLDR. No. \_\_\_\_\_

SHEET 121


FIGURED BY \_\_\_\_\_

NOTES CHECKED BY \_\_\_\_\_

PLOTTED BY \_\_\_\_\_

DATE 9-7 1955

Quad. No. \_\_\_\_\_

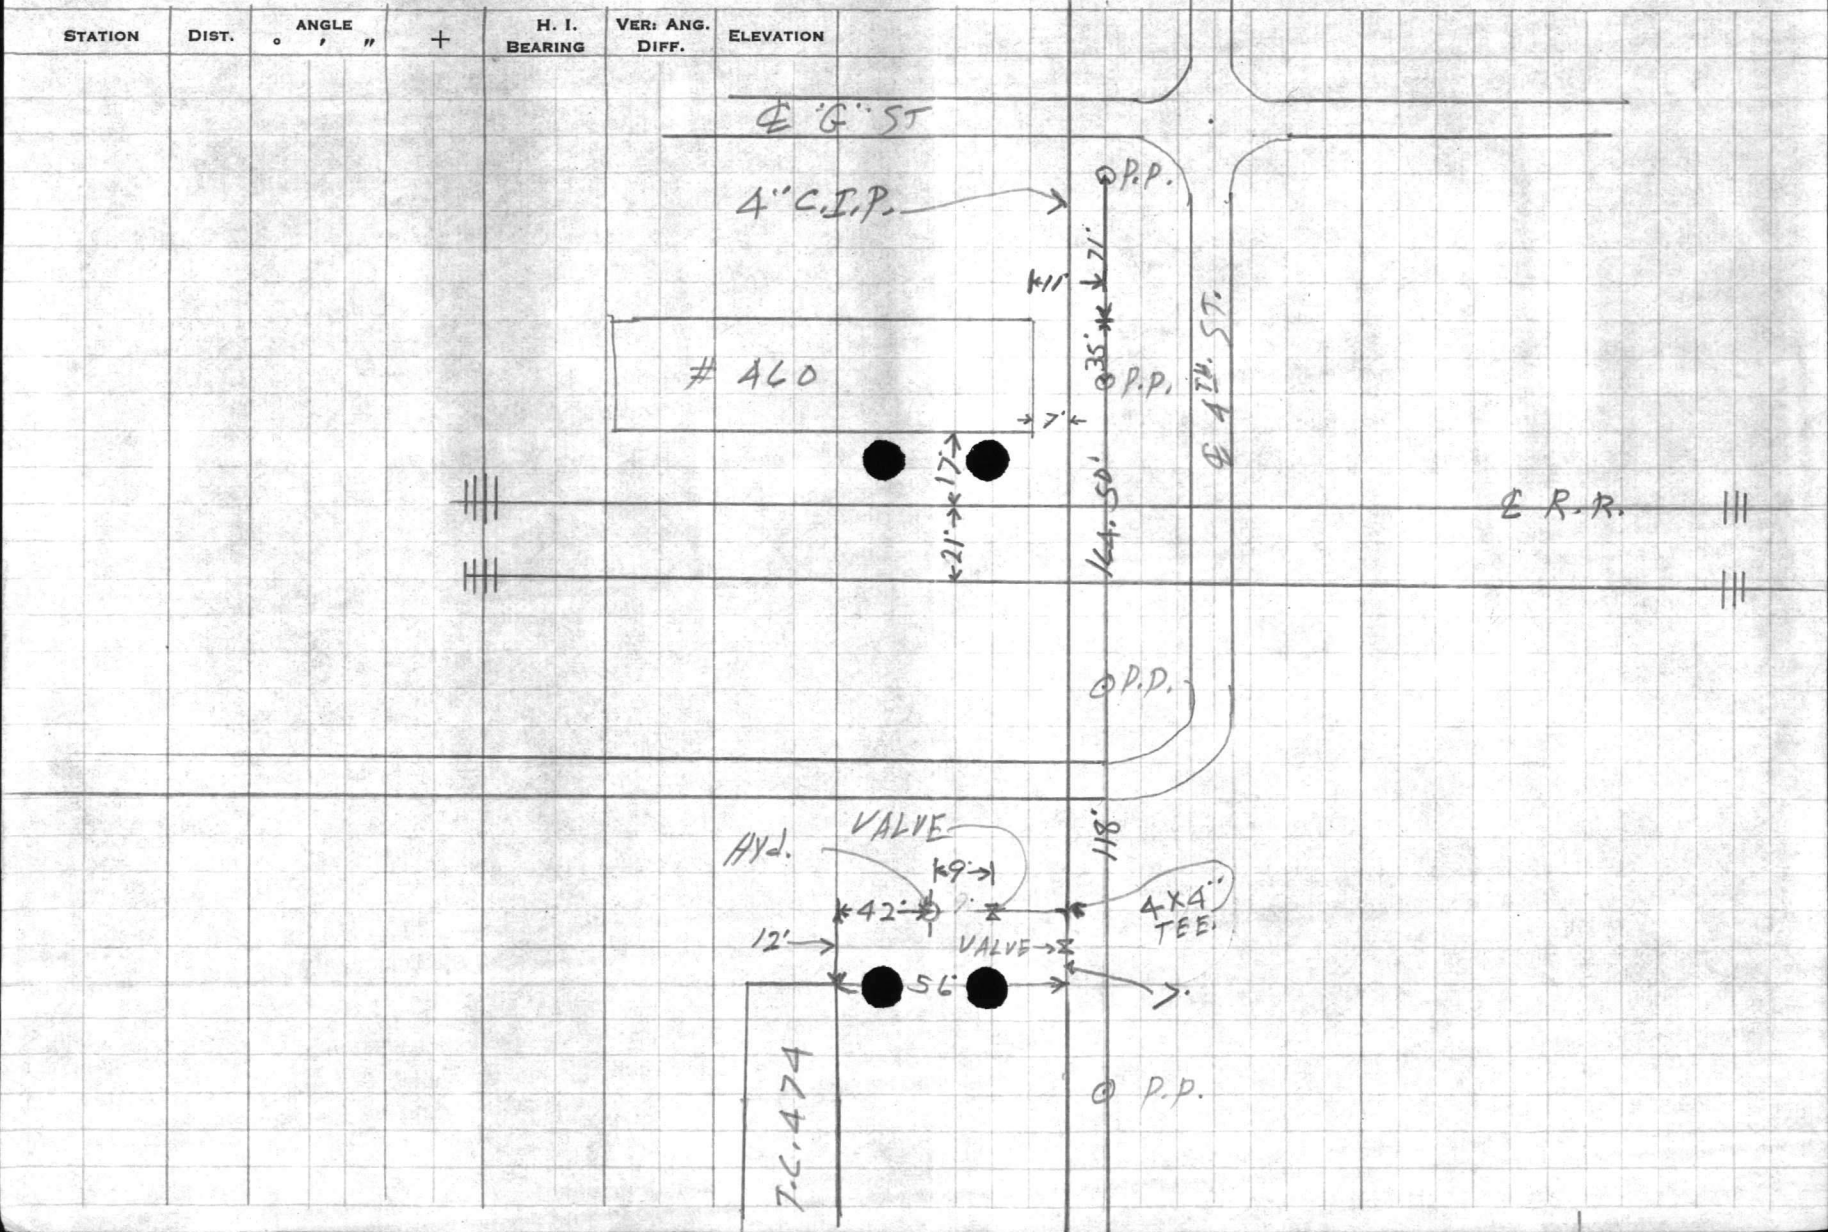











**VALUABLE**

SUBJECT \_\_\_\_\_  
\_\_\_\_\_  
\_\_\_\_\_  
\_\_\_\_\_  
\_\_\_\_\_

RETURN TO  
PUBLIC WORKS  
OFFICE  
CAMP LEJEUNE  
NORTH CAROLINA

**FIELD PARTY**

\_\_\_\_\_  
IN CHARGE  
\_\_\_\_\_  
INSTRUMENT  
\_\_\_\_\_  
NOTES  
\_\_\_\_\_  
TAPE READ  
\_\_\_\_\_  
TAPE OR ROD  
\_\_\_\_\_  
TAPE OR ROD  
\_\_\_\_\_  
INSTRUMENT NO.  
\_\_\_\_\_  
TAPE NO.


**WEATHER**

CLEAR  
CLOUDY  
WINDY  
RAIN  
FAIR  
SNOW  
HOT  
MODERATE  
COLD  
FOG

FILE No. \_\_\_\_\_  
FLDR. No. \_\_\_\_\_  
SHEET 10 of 1  
DATE 9-7 1955

Quad. No. \_\_\_\_\_

STATION	DIST.	ANGLE ' "	+	H. I. BEARING	VER. ANG. DIFF.	ELEVATION
B.M			241			8 43
"A"					8 32	
"B"					9 52	

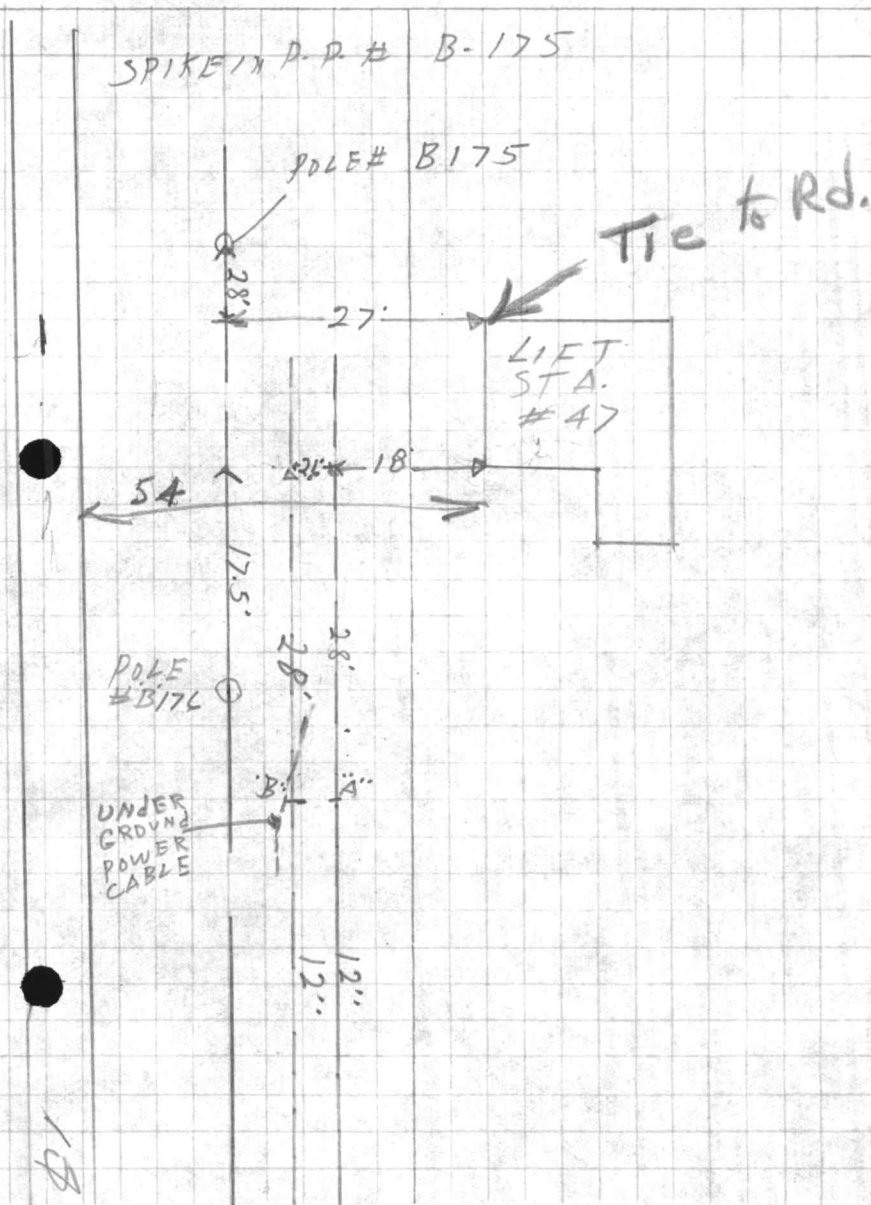









**VALUABLE**

SUBJECT \_\_\_\_\_

RETURN TO  
PUBLIC WORKS  
OFFICE  
CAMP LEJEUNE  
NORTH CAROLINA

FIELD PARTY

\_\_\_\_ IN CHARGE  
\_\_\_\_ INSTRUMENT  
\_\_\_\_ NOTES  
\_\_\_\_ TAPE READ  
\_\_\_\_ TAPE OR ROD  
\_\_\_\_ TAPE OR ROD  
\_\_\_\_ INSTRUMENT No.  
\_\_\_\_ TAPE No.

WEATHER

CLEAR SNOW  
CLOUDY HOT  
WINDY MODERATE  
RAIN COLD  
FAIR FOG

FILE No. \_\_\_\_\_

FLDR. No. \_\_\_\_\_


SHEET 1041

FIGURED BY \_\_\_\_\_  
NOTES CHECKED BY \_\_\_\_\_

PLOTTED BY \_\_\_\_\_ DATE 9-8 1955

Quad. No. \_\_\_\_\_

STATION	DIST.	ANGLE			H. I. BEARING	VER. ANG. DIFF.	ELEVATION
		°	'	"			

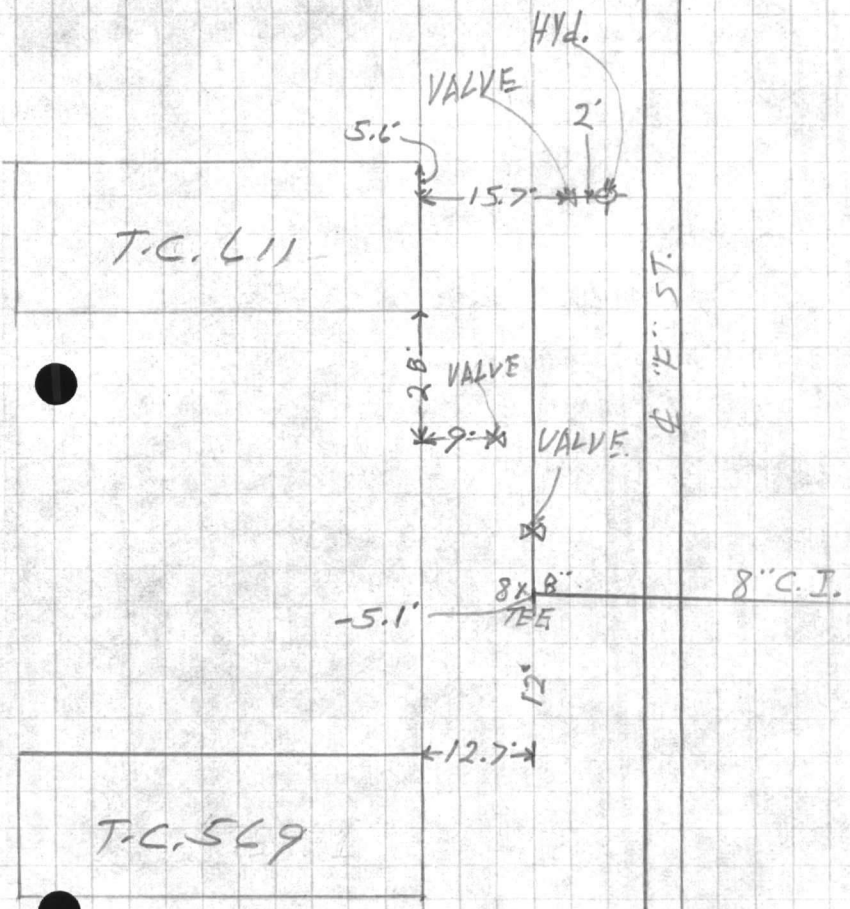

































**VALUABLE**
 RETURN TO  
 PUBLIC WORKS  
 OFFICE  
 CAMP LEJEUNE  
 NORTH CAROLINA

SUBJECT

 Location Water  
 Lines Between 6th and  
 7th St. Camp Greger

## FIELD PARTY

 \_\_\_\_\_ IN CHARGE  
 \_\_\_\_\_ INSTRUMENT  
 \_\_\_\_\_ NOTES  
 \_\_\_\_\_ TAPE READ  
 \_\_\_\_\_ TAPE OR ROD  
 \_\_\_\_\_ TAPE OR ROD  
 \_\_\_\_\_ INSTRUMENT NO.  
 \_\_\_\_\_ TAPE NO.

## WEATHER

 CLEAR  
 CLOUDY  
 WINDY  
 RAIN  
 FAIR  
 SNOW  
 HOT  
 MODERATE  
 COLD  
 FOG  
 FIGURED BY \_\_\_\_\_  
 NOTES CHECKED BY \_\_\_\_\_  
 PLOTTED BY \_\_\_\_\_
FILE No. 98-P


FLDR. No. \_\_\_\_\_

SHEET 1 of 1DATE 2/8 1956

Quad. No. \_\_\_\_\_

STATION	DIST.	ANGLE		+	H. I. BEARING	VER. ANG. DIFF.	ELEVATION
		°	' "				
B.M.					3.06 21.33		18.27
"A"						9.34	11.99
"B"						8.95	12.38
"C"						6.03	15.30
B.M.					3.06		18.27

on 24" Pine Int. 6th &amp; "E" Sts

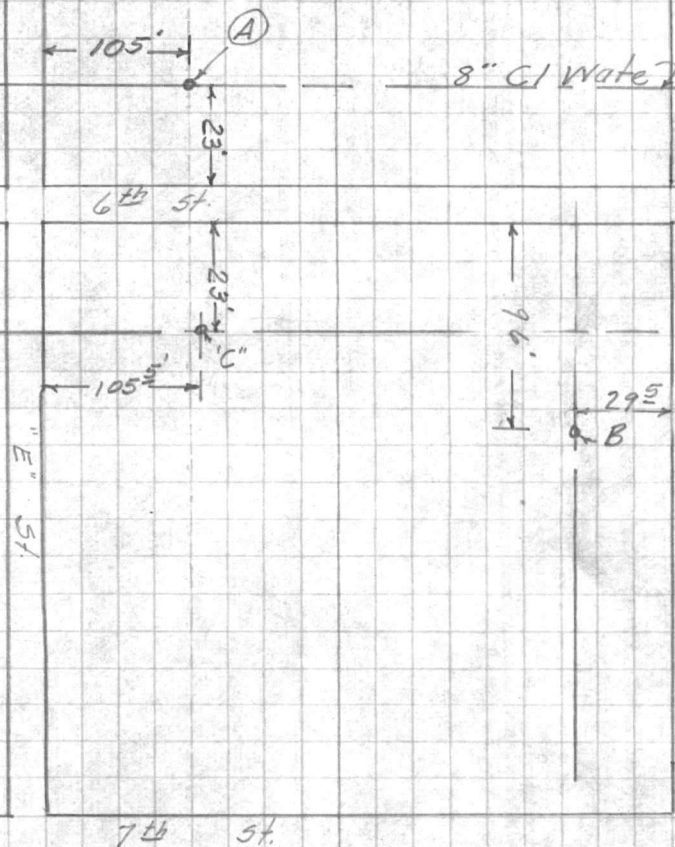

7.74  
 1.60  
9.34

[ ]

X









**VALUABLE**

SUBJECT \_\_\_\_\_  
 \_\_\_\_\_  
 \_\_\_\_\_  
 \_\_\_\_\_

RETURN TO  
 PUBLIC WORKS  
 OFFICE  
 CAMP LEJEUNE  
 NORTH CAROLINA

**FIELD PARTY**

\_\_\_\_\_  
 IN CHARGE  
 \_\_\_\_\_  
 INSTRUMENT  
 \_\_\_\_\_  
 NOTES  
 \_\_\_\_\_  
 TAPE READ  
 \_\_\_\_\_  
 TAPE OR ROD  
 \_\_\_\_\_  
 TAPE OR ROD  
 \_\_\_\_\_  
 INSTRUMENT NO. \_\_\_\_\_  
 TAPE NO. \_\_\_\_\_

**WEATHER**

CLEAR  
 CLOUDY  
 WINDY  
 RAIN  
 FAIR  
 SNOW  
 HOT  
 MODERATE  
 COLD  
 FOG

FILE No. 78-P  
 FLDR. No. \_\_\_\_\_  
 FIGURED BY \_\_\_\_\_ SHEET \_\_\_\_\_  
 NOTES CHECKED BY \_\_\_\_\_  
 PLOTTED BY \_\_\_\_\_ DATE \_\_\_\_\_ 19\_\_

Quad. No. \_\_\_\_\_

STATION	DIST.	ANGLE ° ' "	+	H. I. BEARING	VER. ANG. DIFF.	ELEVATION	
B.M.			4.70	25.26 ✓		20.56	Int "A" and 6th St.
					+ 5.32	30.58	Top Res.
B.M.				4.87	20.39 ✓		S. E. Cor. Stop South Door Bldg. 508
			3.53	23.92 ✓			
B.M.				3.39	20.53 ✓	(20.56)	
B.M.			3.39	23.95		20.56	Int. Church & 6th St's.
				3.52		20.43	
B.M.			3.58	23.89		20.31	Trans for pole
				3.50	20.39 ✓		
























































RECEIVED

**VALUABLE**

SUBJECT Stake out Fences  
Water Treatment plant  
Camp Gieger

RETURN TO  
PUBLIC WORKS  
OFFICE  
CAMP LEJEUNE  
NORTH CAROLINA

**FIELD PARTY**

W. H. Hester IN CHARGE  
INSTRUMENT \_\_\_\_\_  
NOTES \_\_\_\_\_  
TAPE READ \_\_\_\_\_  
TAPE OR ROD \_\_\_\_\_  
TAPE OR ROD \_\_\_\_\_  
INSTRUMENT NO. \_\_\_\_\_  
TAPE NO. \_\_\_\_\_


**WEATHER**

CLEAR \_\_\_\_\_ SNOW \_\_\_\_\_  
CLOUDY \_\_\_\_\_ HOT \_\_\_\_\_  
WIND \_\_\_\_\_ MODERATE \_\_\_\_\_  
RAIN \_\_\_\_\_ COLD \_\_\_\_\_  
FAIR \_\_\_\_\_ FOG \_\_\_\_\_

FILE No. 98-P  
FLDR. No. \_\_\_\_\_  
SHEET 19 of 1  
DATE 8/9 1953  
FIGURED BY \_\_\_\_\_  
NOTES CHECKED BY \_\_\_\_\_  
PLOTTED BY \_\_\_\_\_

Quad. No. \_\_\_\_\_

STATION	DIST.	ANGLE ° ' "	+	H. I. BEARING	VER. ANG. DIFF.	ELEVATION
---------	-------	----------------	---	------------------	--------------------	-----------

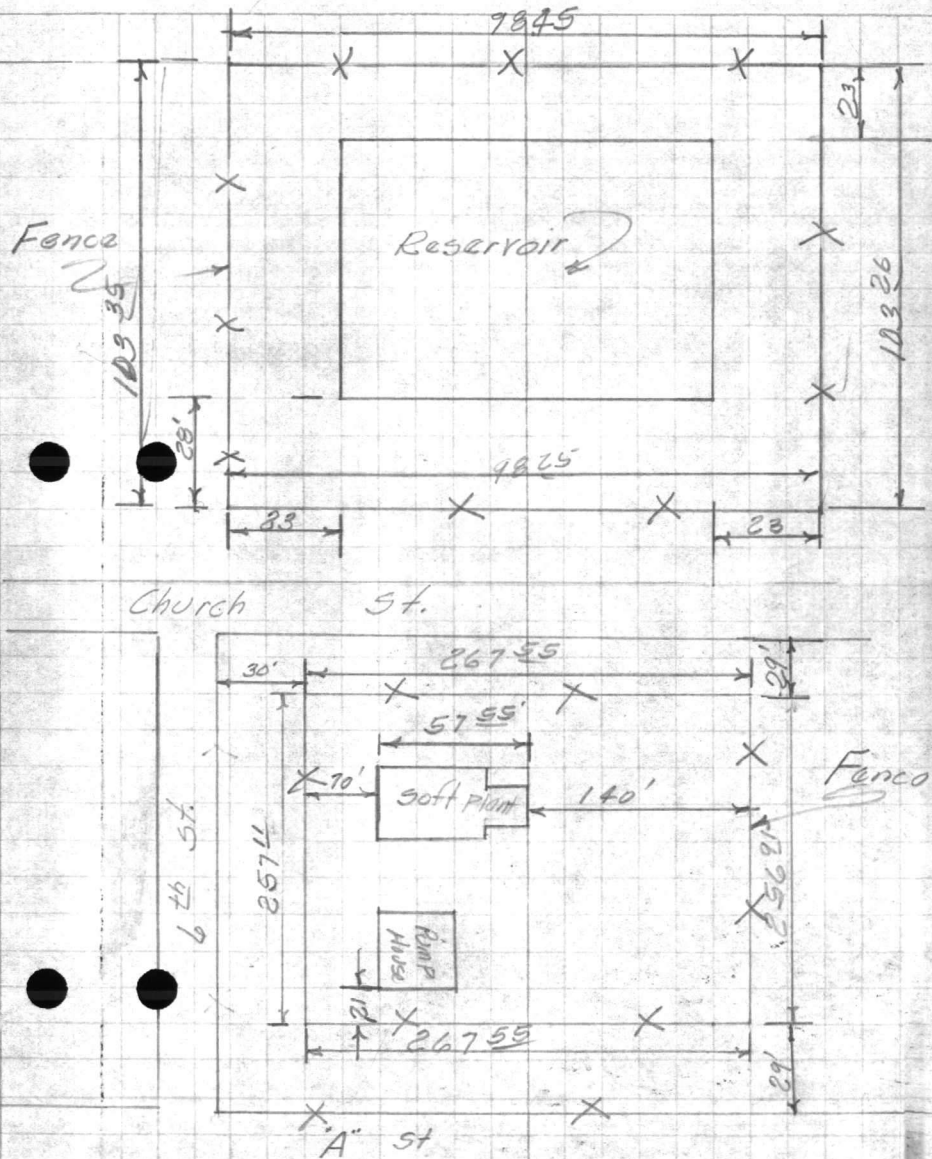































**VALUABLE**

RETURN TO  
PUBLIC WORKS  
OFFICE  
CAMP LEJEUNE  
NORTH CAROLINA

SUBJECT Utilities Loc. in  
Garbage House AT Mess Hall  
# 920  
Camp Geiger

**FIELD PARTY**

\_\_\_\_ IN CHARGE  
\_\_\_\_ INSTRUMENT  
\_\_\_\_ NOTES  
\_\_\_\_ TAPE READ  
\_\_\_\_ TAPE OR ROD  
\_\_\_\_ TAPE OR ROD  
\_\_\_\_ INSTRUMENT NO.  
\_\_\_\_ TAPE NO.

**WEATHER**

CLEAR  
CLOUDY  
WINDY  
RAIN  
FAIR  
SNOW  
HOT  
MODERATE  
COLD  
FOG

FILE No. \_\_\_\_\_

FLDR. No. \_\_\_\_\_



FIGURED BY \_\_\_\_\_ SHEET 6 of 8

NOTES CHECKED BY 1

PLOTTED BY \_\_\_\_\_ DATE 1-8 19-8

Quad. No. \_\_\_\_\_

STATION	DIST.	ANGLE ° ' "	H. I. BEARING	VER. ANG. DIFF.	ELEVATION
---------	-------	----------------	------------------	--------------------	-----------

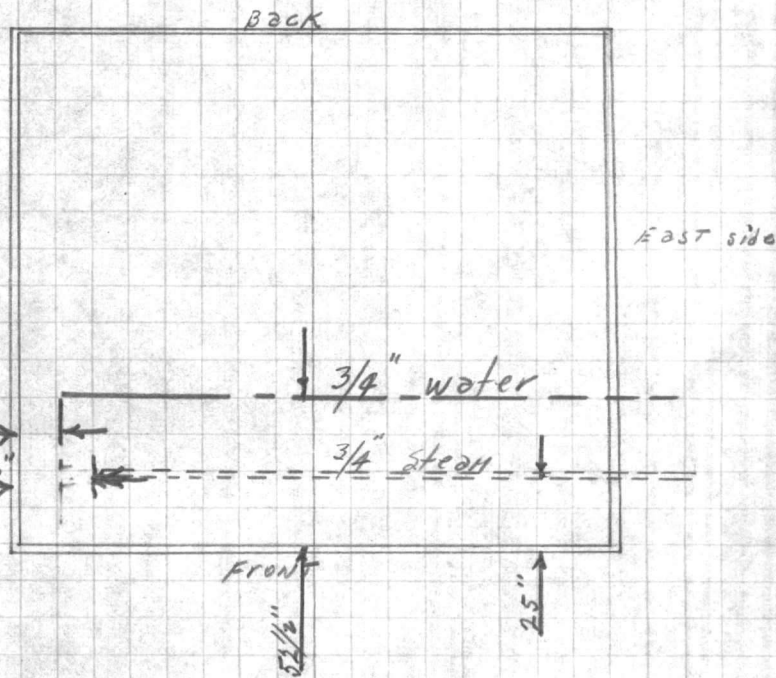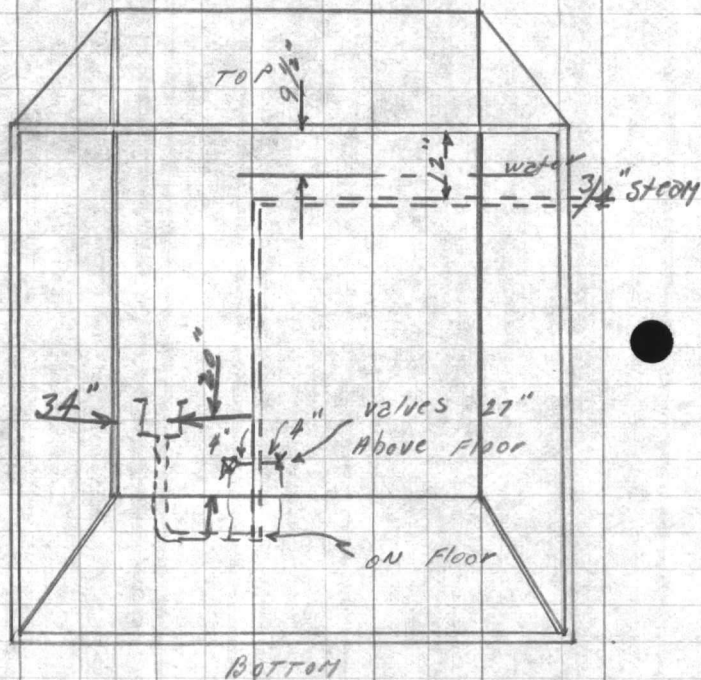










**VALUABLE**

RETURN TO  
PUBLIC WORKS  
OFFICE  
CAMP LEJEUNE  
NORTH CAROLINA

SUBJECT Water Line Loc. TO  
Garbage House AT  
Bldg. # 920  
Mess Hall  
CAMP Geiger

**FIELD PARTY**

\_\_\_\_ IN CHARGE  
\_\_\_\_ INSTRUMENT  
\_\_\_\_ NOTES  
\_\_\_\_ TAPE READ  
\_\_\_\_ TAPE OR ROD  
\_\_\_\_ TAPE OR ROD  
\_\_\_\_ INSTRUMENT NO.  
\_\_\_\_ TAPE NO.

**WEATHER**

CLEAR  
CLOUDY  
WINDY  
RAIN  
FAIR

SNOW  
HOT  
MODERATE  
COLD  
FOG

FILE No. \_\_\_\_\_

FLDR. No. \_\_\_\_\_

FIGURED BY \_\_\_\_\_ SHEET 6-0f 8


NOTES CHECKED BY \_\_\_\_\_

PLOTTED BY \_\_\_\_\_ DATE 1-8 1958

Quad. No. \_\_\_\_\_

STATION	DIST.	ANGLE ° ' "	+	H. I. BEARING	VER: ANG. DIFF.	ELEVATION
---------	-------	----------------	---	------------------	--------------------	-----------

Garbage  
House

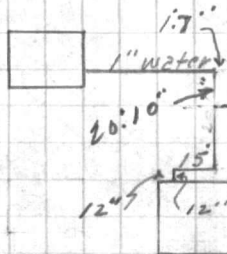

Mess Hall  
#920









**VALUABLE**

RETURN TO  
PUBLIC WORKS  
OFFICE  
CAMP LEJEUNE  
NORTH CAROLINA

SUBJECT Utilities loc. in Garage  
House AT Mess Hall #930  
Camp Geiger

FIELD PARTY

\_\_\_\_ IN CHARGE  
\_\_\_\_ INSTRUMENT  
\_\_\_\_ NOTES  
\_\_\_\_ TAPE READ  
\_\_\_\_ TAPE OR ROD  
\_\_\_\_ TAPE OR ROD  
\_\_\_\_ INSTRUMENT No.  
\_\_\_\_ TAPE No.

WEATHER

CLEAR \_\_\_\_\_  
CLOUDY \_\_\_\_\_  
WINDY \_\_\_\_\_  
RAIN \_\_\_\_\_  
FAIR \_\_\_\_\_  
SNOW \_\_\_\_\_  
HOT \_\_\_\_\_  
MODERATE \_\_\_\_\_  
COLD \_\_\_\_\_  
FOG \_\_\_\_\_

FILE No. \_\_\_\_\_

FLDR. No. \_\_\_\_\_

SHEET 7 - of 8

FIGURED BY \_\_\_\_\_



NOTES CHECKED BY \_\_\_\_\_

PLOTTED BY \_\_\_\_\_

DATE 1-8 1958

Quad. No. \_\_\_\_\_

STATION	DIST.	ANGLE ° ' "	+	H. I. BEARING	VER. ANG. DIFF.	ELEVATION
---------	-------	----------------	---	------------------	--------------------	-----------

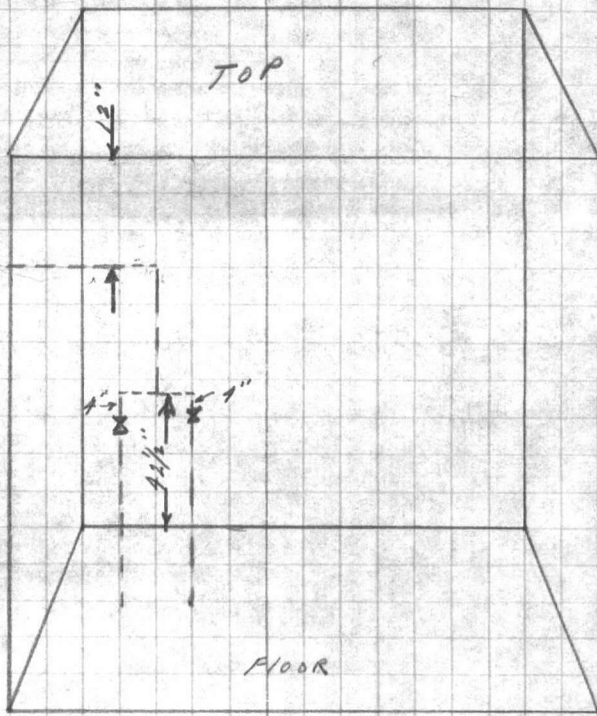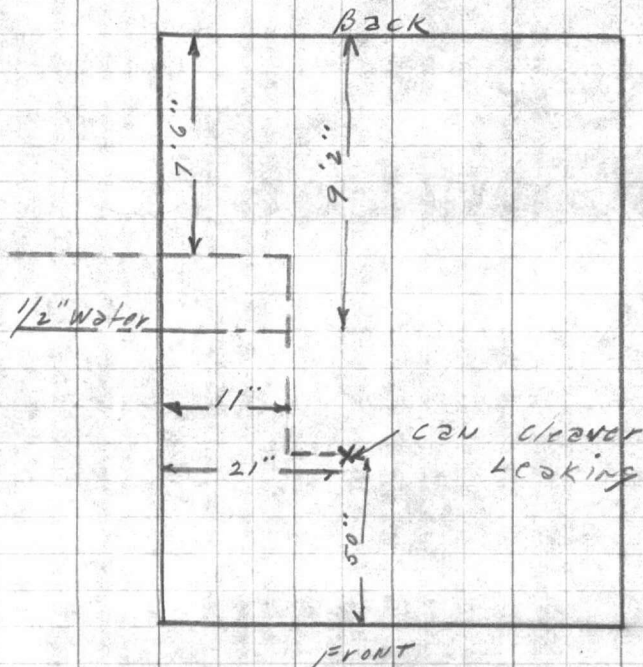

water line 27" Above floor

steam line 2" AND 6"  
Above floor between valves  
AND CAN CLEANER




















**VALUABLE**

RETURN TO  
PUBLIC WORKS  
OFFICE  
CAMP LEJEUNE  
NORTH CAROLINA

SUBJECT Water Line Loc. AT  
Garbage House - Bldg. # 930  
Camp Geiger

**FIELD PARTY**

\_\_\_\_\_  
IN CHARGE  
\_\_\_\_\_  
INSTRUMENT  
\_\_\_\_\_  
NOTES  
\_\_\_\_\_  
TAPE READ  
\_\_\_\_\_  
TAPE OR ROD  
\_\_\_\_\_  
TAPE OR ROD  
\_\_\_\_\_  
INSTRUMENT NO.  
\_\_\_\_\_  
TAPE NO.

**WEATHER**

CLEAR  
CLOUDY  
WINDY  
RAIN  
FAIR

SNOW  
HOT  
MODERATE  
COLD  
FOG

FILE No. \_\_\_\_\_

FLDR. No. \_\_\_\_\_


SHEET 8-0 of 8

DATE 1-8 1958

Quad. No. \_\_\_\_\_

STATION	DIST.	ANGLE		+	H. I. BEARING	VER. ANG. DIFF.	ELEVATION
		°	"				

Garbage House

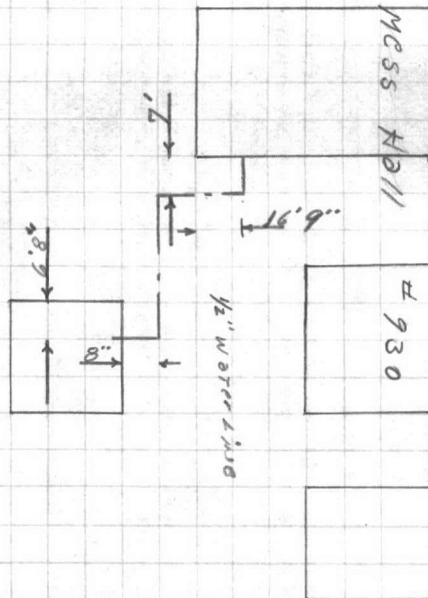

Mess Hall

# 930








**VALUABLE**

SUBJECT \_\_\_\_\_  
 \_\_\_\_\_  
 \_\_\_\_\_  
 \_\_\_\_\_  
 \_\_\_\_\_

RETURN TO  
 PUBLIC WORKS  
 OFFICE  
 CAMP LEJEUNE  
 NORTH CAROLINA

**FIELD PARTY**

\_\_\_\_\_  
 IN CHARGE  
 \_\_\_\_\_  
 INSTRUMENT  
 \_\_\_\_\_  
 NOTES  
 \_\_\_\_\_  
 TAPE READ  
 \_\_\_\_\_  
 TAPE OR ROD  
 \_\_\_\_\_  
 TAPE OR ROD  
 \_\_\_\_\_  
 INSTRUMENT NO. \_\_\_\_\_  
 TAPE NO. \_\_\_\_\_


**WEATHER**

CLEAR \_\_\_\_\_  
 CLOUDY \_\_\_\_\_  
 WINDY \_\_\_\_\_  
 RAIN \_\_\_\_\_  
 FAIR \_\_\_\_\_  
 SNOW \_\_\_\_\_  
 HOT \_\_\_\_\_  
 MODERATE \_\_\_\_\_  
 COLD \_\_\_\_\_  
 FOG \_\_\_\_\_

FILE No. \_\_\_\_\_  
 FLDR. No. \_\_\_\_\_  
 SHEET 208  
 DATE \_\_\_\_\_ 19\_\_

Quad. No. \_\_\_\_\_

STATION	DIST.	ANGLE ° ' "	+	H. I. BEARING	VER. ANG. DIFF.	ELEVATION
				⊕	B Rd.	ST.
9+10 <sup>60</sup>		21'	LT. POINT	RAD.		
8+94 <sup>60</sup>				RAD ON ⊕		
8+91 <sup>30</sup>	8.10'		LT. END	18" CON. PIPE	34.80'	RT. END
8+84 <sup>30</sup>		3'	RT. POINT	RAD.		
4+40 <sup>20</sup>	38.10'		RT. END	18"		C. METAL
4+40 <sup>20</sup>	10.65'		LT. END	18"		
4+97 <sup>60</sup>		3'	RT. POINT	RAD.		
4+93 <sup>50</sup>	16.70'		LT. WATER VALVE			
4+85 <sup>60</sup>				RAD ON ⊕		
				⊕	2 Rd.	ST.

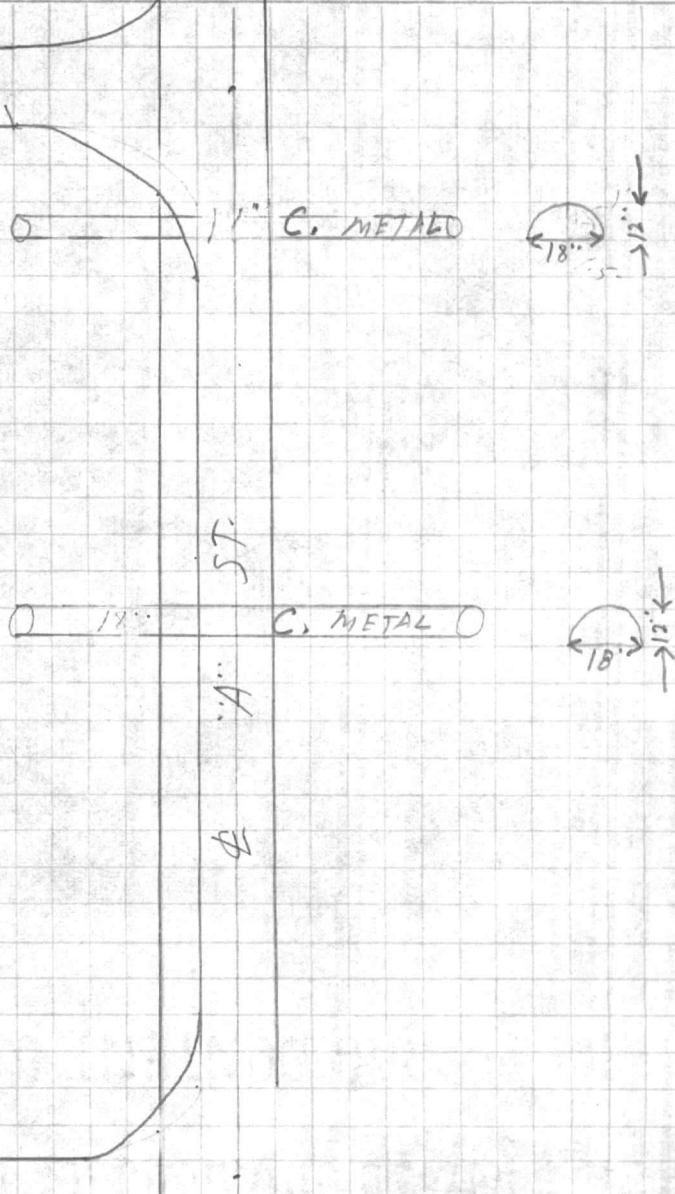



**VALUABLE**

SUBJECT \_\_\_\_\_

RETURN TO  
PUBLIC WORKS  
OFFICE  
CAMP LEJEUNE  
NORTH CAROLINA

**FIELD PARTY**

\_\_\_\_\_  
IN CHARGE  
\_\_\_\_\_  
INSTRUMENT  
\_\_\_\_\_  
NOTES  
\_\_\_\_\_  
TAPE READ  
\_\_\_\_\_  
TAPE OR ROD  
\_\_\_\_\_  
TAPE OR ROD  
\_\_\_\_\_  
INSTRUMENT NO.  
\_\_\_\_\_  
TAPE NO.

**WEATHER**

CLEAR  
CLOUDY  
WINDY  
RAIN  
FAIR

SNOW  
HOT  
MODERATE  
COLD  
FOG

FILE No. \_\_\_\_\_

FLDR. No. \_\_\_\_\_


FIGURED BY \_\_\_\_\_ SHEET 3 of

NOTES CHECKED BY \_\_\_\_\_

PLOTTED BY \_\_\_\_\_ DATE \_\_\_\_\_ 19\_\_


Quad. No. \_\_\_\_\_

STATION	DIST.	ANGLE " +	H. I. BEARING	VER. ANG. DIFF.	ELEVATION
10+71 <sup>90</sup>	3'		POINT RAD.		
10+67 <sup>50</sup>			RAD ON $\Phi$		
10+66	4' LT.		ON RAD.	C' LT. EDGE PAVEMENT POINT RAD.	
10+27 <sup>50</sup>	9.20'		LT. EDGE PAVEMENT	12' LT. END FENCE	
10+05 <sup>80</sup>			RAD ON $\Phi$	2.50' LT. FENCE	
9+98 <sup>40</sup>	0.30'		LT. FENCE	3' RT. POINT RAD.	
9+92 <sup>10</sup>			EDR. FENCE ON $\Phi$		
9+78 <sup>40</sup>			COR. FENCE ON $\Phi$		
9+77 <sup>50</sup>			EDGE C' CONC. WALK		
9+71 <sup>50</sup>			EDGE C' CONC. WALK		
9+70 <sup>90</sup>			COR. FENCE ON $\Phi$		
9+58 <sup>70</sup>	0.30'		LT. FENCE	3' RT. POINT RAD.	
9+49 <sup>00</sup>	2'		LT. FENCE	14' LT. WATER VALVE	
9+46 <sup>00</sup>	28.70'		RT. END	PIPE	
9+46 <sup>00</sup>	8.00'		END	METAL PIPE 30.20' LT. WATER VALVE	
9+44 <sup>80</sup>			RAD ON $\Phi$	5' LT. FENCE	
9+38 <sup>50</sup>	8.70'		LT. FENCE		
9+33 <sup>40</sup>	30'		LT. FIRE HYD.		
9+28 <sup>60</sup>	28.30'		LT. POINT RAD.		
			$\Phi$ 3 Rd.		ST.

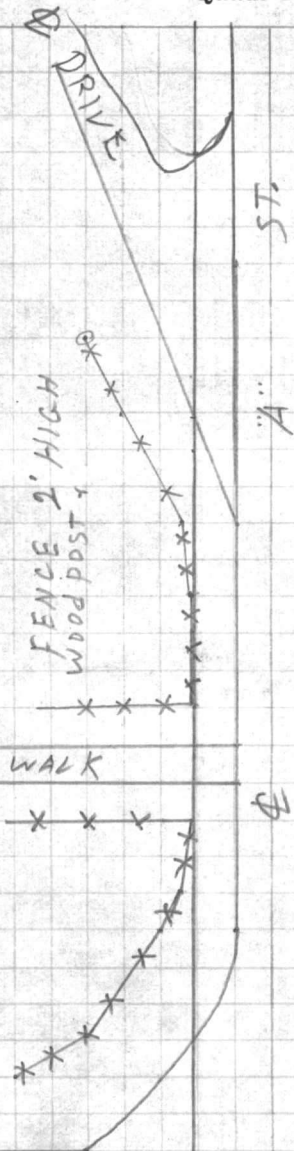



 



**VALUABLE**

SUBJECT \_\_\_\_\_  
 \_\_\_\_\_  
 \_\_\_\_\_  
 \_\_\_\_\_  
 \_\_\_\_\_

RETURN TO  
 PUBLIC WORKS  
 OFFICE  
 CAMP LEJEUNE  
 NORTH CAROLINA

**FIELD PARTY**

\_\_\_\_\_  
 IN CHARGE  
 \_\_\_\_\_  
 INSTRUMENT  
 \_\_\_\_\_  
 NOTES  
 \_\_\_\_\_  
 TAPE READ  
 \_\_\_\_\_  
 TAPE OR ROD  
 \_\_\_\_\_  
 TAPE OR ROD  
 \_\_\_\_\_  
 INSTRUMENT NO. \_\_\_\_\_  
 TAPE NO. \_\_\_\_\_


**WEATHER**

CLEAR \_\_\_\_\_  
 CLOUDY \_\_\_\_\_  
 WINDY \_\_\_\_\_  
 RAIN \_\_\_\_\_  
 FAIR \_\_\_\_\_  
 SNOW \_\_\_\_\_  
 HOT \_\_\_\_\_  
 MODERATE \_\_\_\_\_  
 COLD \_\_\_\_\_  
 FOG \_\_\_\_\_

FILE No. \_\_\_\_\_  
 FLD. No. \_\_\_\_\_  
 SHEET 4 of \_\_\_\_\_  
 FIGURED BY \_\_\_\_\_  
 NOTES CHECKED BY \_\_\_\_\_  
 PLOTTED BY \_\_\_\_\_ DATE \_\_\_\_\_ 19\_\_

Quad. No. \_\_\_\_\_

STATION	DIST.	ANGLE ° ' "	+	H. I. BEARING	VER. ANG. DIFF.	ELEVATION
13+43 <sup>50</sup>						3' RT. POINT RAD. 19.30' LT. WATER VALVE
13+40 <sup>40</sup>						3' LT. COR. FENCE 15.40' LT. WATER VALVE
13+30'						3' LT. COR. FENCE
13+29 <sup>05</sup>						Edge walk
13+23 <sup>05</sup>						EDGE 6' CONC. WALK
13+22 <sup>00</sup>						3' LT. COR. FENCE
12+83 <sup>50</sup>						3' RT. POINT RAD.
12+81 <sup>30</sup>						3' LT. COR. FENCE
12+77 <sup>10</sup>						RAD ON $\Phi$
12+71 <sup>95</sup>						3' LT. EDGE DRIVE 10.30' LT. END FENCE
12+35 <sup>30</sup>						4' LT. RAD.
12+33 <sup>80</sup>						RAD ON $\Phi$
12+31 <sup>15</sup>						3' RT. POINT RAD. 10.70' LT. POINT RAD. EDGE PAVEMENT
12+23 <sup>00</sup>						7' LT. shrub
11+50 <sup>50</sup>						13.00' LT. FLAG POLE
11+50 <sup>50</sup>						3.14' LT. CONC. SLAB FLAG POLE
11+09 <sup>80</sup>						2' LT. OVER HEAD STEAM POLE 23' LT. OVERHEAD STEAM POLE
10+80 <sup>00</sup>						7' LT. shrub

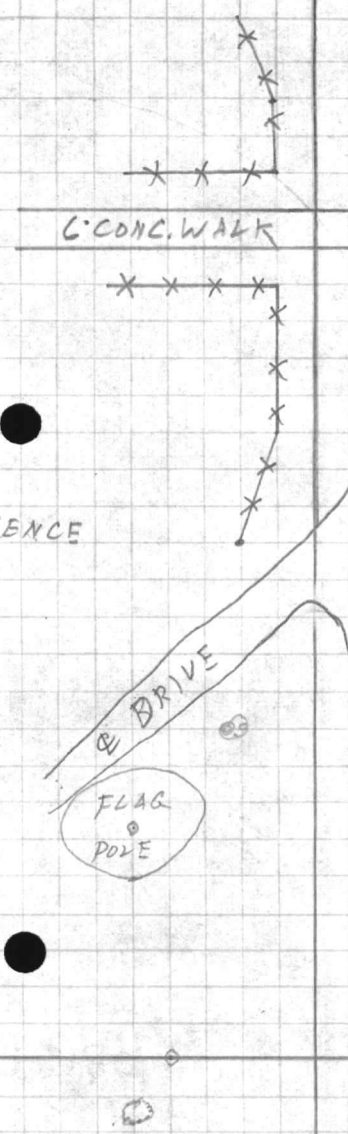






**VALUABLE**

SUBJECT \_\_\_\_\_

RETURN TO  
PUBLIC WORKS  
OFFICE  
CAMP LEJEUNE  
NORTH CAROLINA

**FIELD PARTY**

\_\_\_\_\_  
IN CHARGE  
\_\_\_\_\_  
INSTRUMENT  
\_\_\_\_\_  
NOTES  
\_\_\_\_\_  
TAPE READ  
\_\_\_\_\_  
TAPE OR ROD  
\_\_\_\_\_  
TAPE OR ROD  
\_\_\_\_\_  
INSTRUMENT NO.  
\_\_\_\_\_  
TAPE NO.

**WEATHER**

CLEAR  
CLOUDY  
WINDY  
RAIN  
FAIR  
SNOW  
HOT  
MODERATE  
COLD  
FOG  
FIGURED BY \_\_\_\_\_  
NOTES CHECKED BY \_\_\_\_\_  
PLOTTED BY \_\_\_\_\_

FILE No. \_\_\_\_\_


FLDR. No. \_\_\_\_\_

SHEET 5 of

DATE \_\_\_\_\_ 19\_\_



Quad. No. \_\_\_\_\_

STATION	DIST.	ANGLE ° ' "	+	H. I. BEARING	VER. ANG. DIFF.	ELEVATION
18+67 <sup>10</sup>		RAD ON $\Phi$				
18+66 <sup>00</sup>	8.50'	LT. END	C	METAL PIPE		36' RT. END C. METAL
18+48 <sup>90</sup>		2700' LT. POINT RAD.				$\Phi$ 5 <sup>TH</sup> ST.
18+30 <sup>40</sup>		2700' LT. POINT RAD.				
18+12 <sup>00</sup>		36.50' RT. END	C	METAL PIPE		
18+12 <sup>00</sup>		RAD ON $\Phi$		8' LT. END	C.	METAL PIPE
17+99 <sup>50</sup>		3' LT. POINT RAD.				
16+13 <sup>54</sup>		12' LT. END.		15" R.C.P.		
16+10 <sup>29</sup>		EDGE WALK				
16+04 <sup>99</sup>		EDGE C' CONC. WALK				
16+01 <sup>39</sup>		12' LT. END.		15" R.C.P.		
14+18 <sup>20</sup>		3' RT. POINT RAD.				
14+06 <sup>00</sup>		RAD ON $\Phi$				
13+88 <sup>00</sup>		25' LT. POINT RAD.				
13+70 <sup>00</sup>		22.50' LT. POINT RAD.				
13+61 <sup>20</sup>		35.10' LT. FIRE HYD.				
13+60 <sup>20</sup>		18.70' LT. COR. FENCE				
13+54'		RAD ON $\Phi$				
13+49 <sup>20</sup>		35.10' LT. WATER VALVE				
13+47 <sup>00</sup>		4' LT. COR. FENCE				

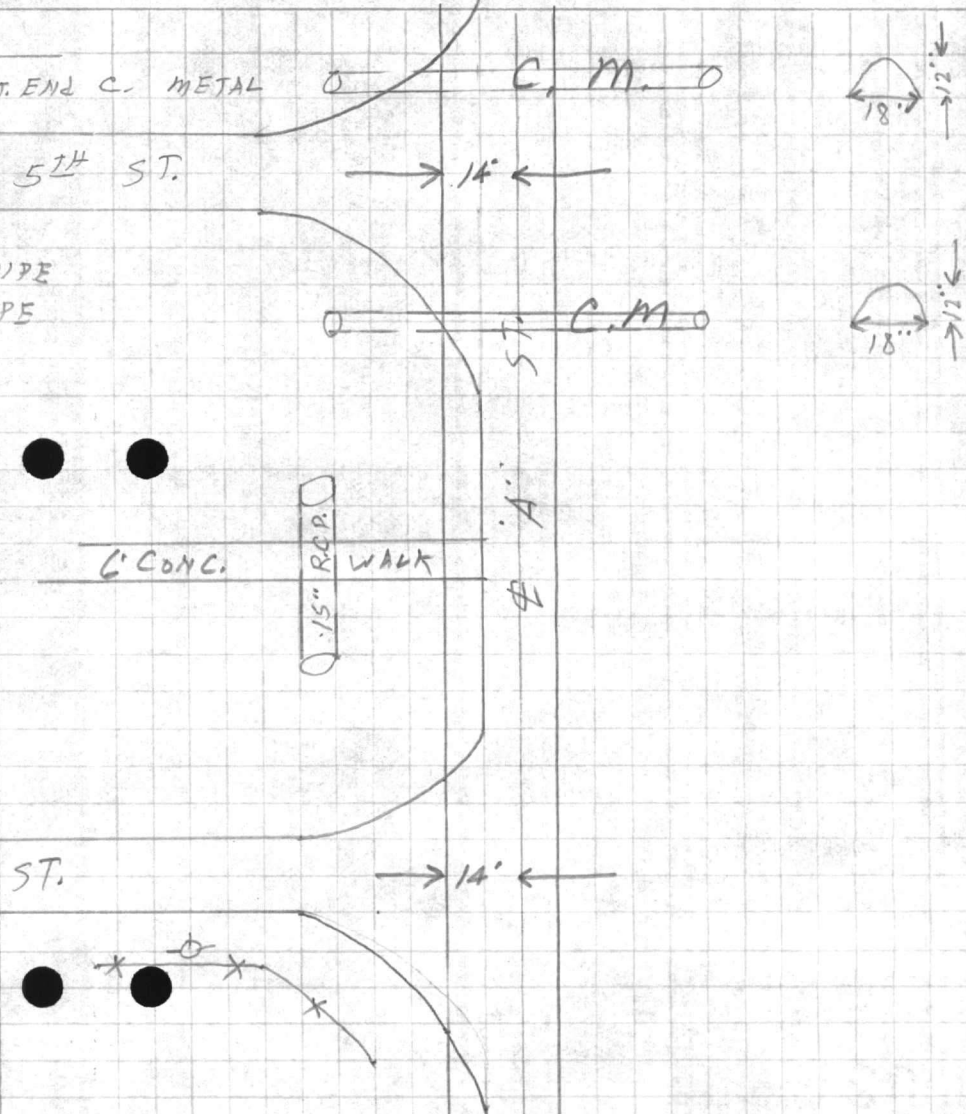



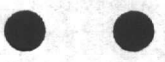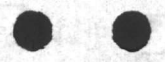

**VALUABLE**

SUBJECT \_\_\_\_\_

RETURN TO  
PUBLIC WORKS  
OFFICE  
CAMP LEJEUNE  
NORTH CAROLINA

**FIELD PARTY**

\_\_\_\_\_  
IN CHARGE  
\_\_\_\_\_  
INSTRUMENT  
\_\_\_\_\_  
NOTES  
\_\_\_\_\_  
TAPE READ  
\_\_\_\_\_  
TAPE OR ROD  
\_\_\_\_\_  
TAPE OR ROD  
\_\_\_\_\_  
INSTRUMENT No.  
\_\_\_\_\_  
TAPE No.

**WEATHER**

CLEAR  
CLOUDY  
WINDY  
RAIN  
FAIR

SNOW  
HOT  
MODERATE  
COLD  
FOG

FILE No. \_\_\_\_\_


FLDR. No. \_\_\_\_\_

FIGURED BY \_\_\_\_\_ SHEET cat

NOTES CHECKED BY \_\_\_\_\_

PLOTTED BY \_\_\_\_\_ DATE \_\_\_\_\_ 19\_\_

Quad. No. \_\_\_\_\_

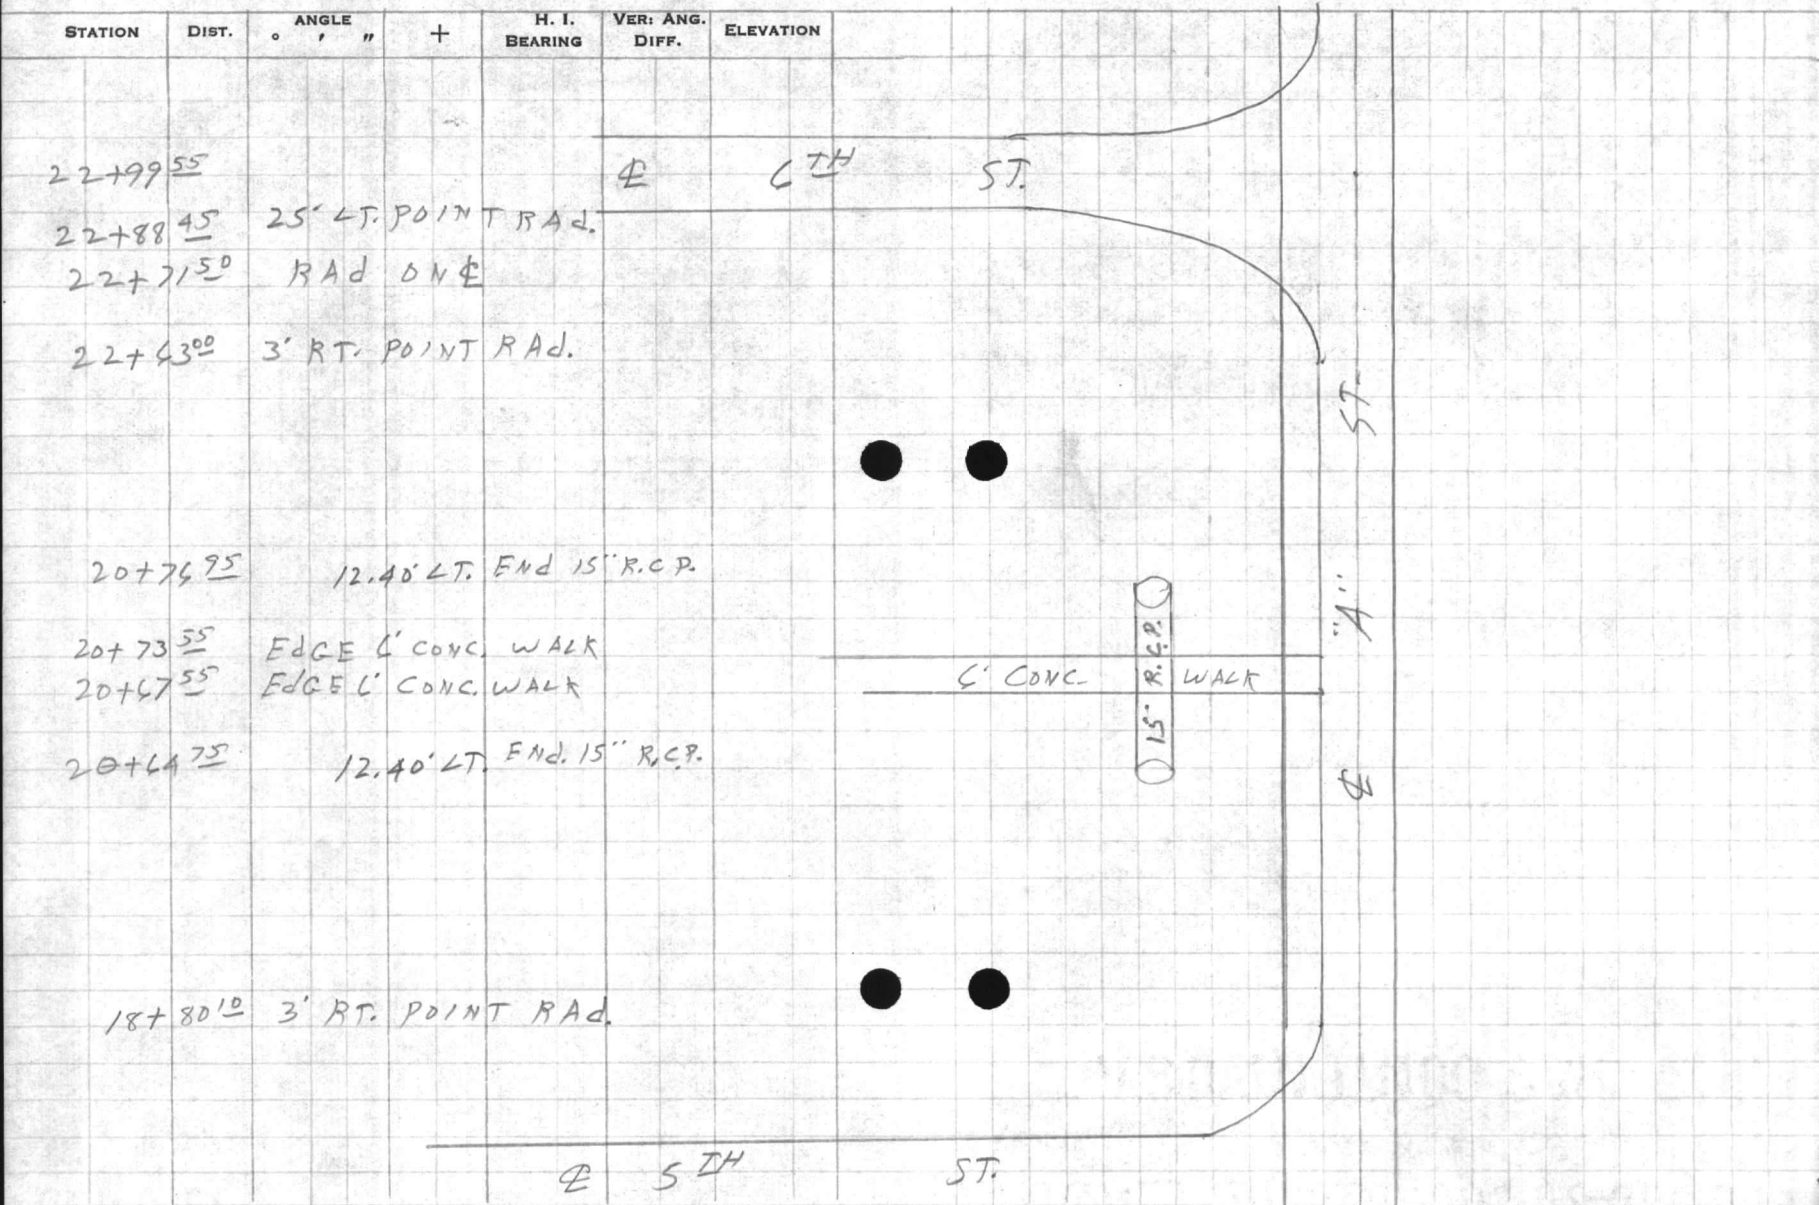








**VALUABLE**

SUBJECT \_\_\_\_\_  
 \_\_\_\_\_  
 \_\_\_\_\_  
 \_\_\_\_\_  
 \_\_\_\_\_

RETURN TO  
 PUBLIC WORKS  
 OFFICE  
 CAMP LEJEUNE  
 NORTH CAROLINA

**FIELD PARTY**

\_\_\_\_\_  
 IN CHARGE  
 \_\_\_\_\_  
 INSTRUMENT  
 \_\_\_\_\_  
 NOTES  
 \_\_\_\_\_  
 TAPE READ  
 \_\_\_\_\_  
 TAPE OR ROD  
 \_\_\_\_\_  
 TAPE OR ROD  
 \_\_\_\_\_  
 INSTRUMENT NO. \_\_\_\_\_  
 TAPE NO. \_\_\_\_\_


**WEATHER**

CLEAR \_\_\_\_\_  
 CLOUDY \_\_\_\_\_  
 WINDY \_\_\_\_\_  
 RAIN \_\_\_\_\_  
 FAIR \_\_\_\_\_  
 SNOW \_\_\_\_\_  
 HOT \_\_\_\_\_  
 MODERATE \_\_\_\_\_  
 COLD \_\_\_\_\_  
 FOG \_\_\_\_\_  
 FIGURED BY \_\_\_\_\_  
 NOTES CHECKED BY \_\_\_\_\_  
 PLOTTED BY \_\_\_\_\_

FILE No. \_\_\_\_\_  
 FLDR. No. \_\_\_\_\_  
 SHEET 7 of  
 DATE \_\_\_\_\_ 19\_\_

Quad. No. \_\_\_\_\_

STATION	DIST.	ANGLE ° ' "	+	H. I. BEARING	VER. ANG. DIFF.	ELEVATION
27+89 <sup>42</sup>				⊕ 7 <sup>TH</sup> ST.		
27+78 <sup>10</sup>				25' LT. POINT RAD.		
27+62 <sup>90</sup>				RAD ONE 13' LT. ⊕ DROP INLET.		
27+48 <sup>30</sup>				3' RT. POINT RAD.		
26+97 <sup>35</sup>				EDGE 6' CONC. WALK		
26+91 <sup>35</sup>				EDGE 6' CONC. WALK		
26+15 <sup>22</sup>				EDGE 6' CONC. WALK		
26+09 <sup>22</sup>				EDGE 6' CONC. WALK 3' RT. POINT MARL RAD.		
26+05 <sup>00</sup>				5' LT-EDGE MARL DRIVE		
25+74 <sup>90</sup>				4.50' LT-EDGE MARL DRIVE		
25+74 <sup>90</sup>				13.50' LT-END 18" R.C.P.		
25+59 <sup>00</sup>				3' RT. POINT MARL RAD.		
23+35 <sup>30</sup>				3' RT-POINT RAD.		
23+29 <sup>35</sup>				RAD ONE		
23+10 <sup>85</sup>				22.00' LT. POINT RAD ⊕ 6 <sup>TH</sup>		

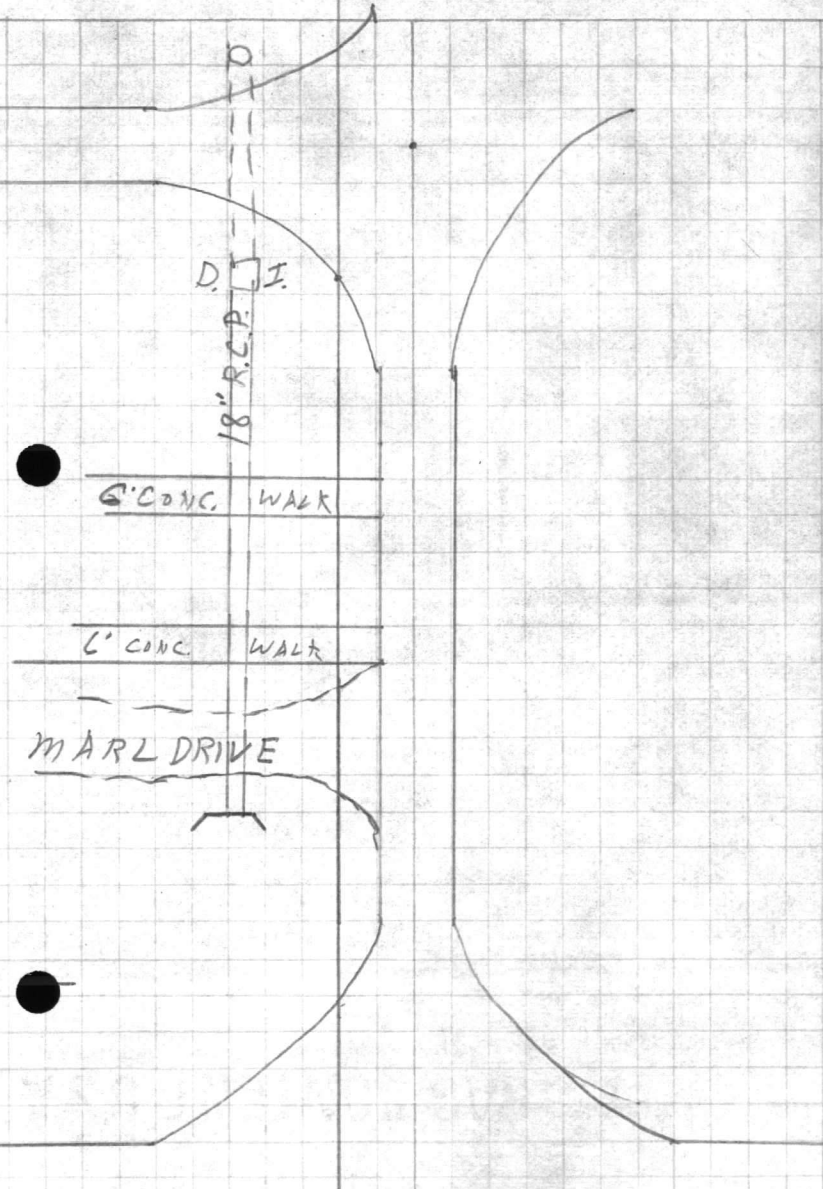









**VALUABLE**

SUBJECT \_\_\_\_\_

RETURN TO  
PUBLIC WORKS  
OFFICE  
CAMP LEJEUNE  
NORTH CAROLINA

**FIELD PARTY**

\_\_\_\_\_  
IN CHARGE  
\_\_\_\_\_  
INSTRUMENT  
\_\_\_\_\_  
NOTES  
\_\_\_\_\_  
TAPE READ  
\_\_\_\_\_  
TAPE OR ROD  
\_\_\_\_\_  
TAPE OR ROD  
\_\_\_\_\_  
INSTRUMENT No.  
\_\_\_\_\_  
TAPE No. \_\_\_\_\_

**WEATHER**

CLEAR  
CLOUDY  
WINDY  
RAIN  
FAIR

SNOW  
HOT  
MODERATE  
COLD  
FOG

FILE No. \_\_\_\_\_

Fldr. No. \_\_\_\_\_

FIGURED BY \_\_\_\_\_ SHEET 8 of

NOTES CHECKED BY \_\_\_\_\_

PLOTTED BY \_\_\_\_\_ DATE \_\_\_\_\_ 19\_\_

Quad. No. \_\_\_\_\_

STATION	DIST.	ANGLE ° ' "	+	H. I. BEARING	VER. ANG. DIFF.	ELEVATION
33+49 <sup>55</sup>		13.40'		LT. END	18" R.C.P.	
33+46 <sup>42</sup>		EDGE		6' CONC. WALK		
33+40 <sup>43</sup>		EDGE		6' CONC. WALK		
33+37 <sup>02</sup>		13.40'		LT. END	18" R.C.P.	

32+59 <sup>40</sup>		16'		LT. END	18" R.C.P.	
32+55 <sup>90</sup>		EDGE		6' CONC.		
32+49 <sup>90</sup>		EDGE		6' CONC.		
32+47 <sup>00</sup>		16'		LT. END	18" R.C.P.	

31+38 <sup>80</sup>		20.50'		LT. & DROP INLET	37' RT. END 30" R.C.P.	
---------------------	--	--------	--	------------------	------------------------	--

30+08 <sup>20</sup>		16'		LT. END	18" R.C.P.	
---------------------	--	-----	--	---------	------------	--

30+05 <sup>20</sup>		EDGE		6' CONC. WALK		
29+99 <sup>20</sup>		EDGE		6' CONC. WALK		

29+95 <sup>90</sup>		16'		LT. END	18" R.C.P.	
---------------------	--	-----	--	---------	------------	--

28+23 <sup>53</sup>		3'		RT. POINT RAD.		
---------------------	--	----	--	----------------	--	--

28+20 <sup>00</sup>		12.90'		LT. END	18" R.C.P.	
---------------------	--	--------	--	---------	------------	--

28+16 <sup>00</sup>				RAD ON &		
---------------------	--	--	--	----------	--	--

28+01 <sup>10</sup>		22'		LT. POINT RAD.		
---------------------	--	-----	--	----------------	--	--

& 7TH ST.

6' CONC. WALK  
18" R.C.P.

6' CONC. WALK  
18" R.C.P.

DROP  
INLET. 30" ST. R.C.P.


6' CONC. WALK  
18" R.C.P.

18" R.C.P.




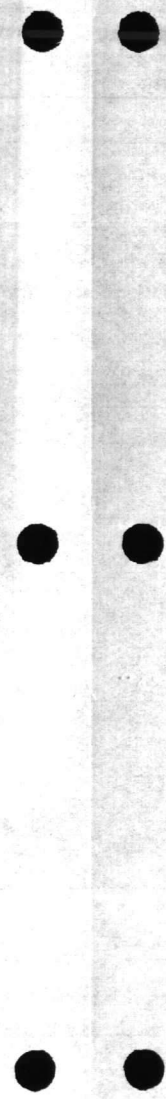

**VALUABLE**

SUBJECT \_\_\_\_\_

RETURN TO  
PUBLIC WORKS  
OFFICE  
CAMP LEJEUNE  
NORTH CAROLINA

**FIELD PARTY**

\_\_\_\_\_  
IN CHARGE  
\_\_\_\_\_  
INSTRUMENT  
\_\_\_\_\_  
NOTES  
\_\_\_\_\_  
TAPE READ  
\_\_\_\_\_  
TAPE OR ROD  
\_\_\_\_\_  
TAPE OR ROD  
\_\_\_\_\_  
INSTRUMENT NO.  
\_\_\_\_\_  
TAPE NO.

**WEATHER**

CLEAR  
CLOUDY  
WINDY  
RAIN  
FAIR

SNOW  
HOT  
MODERATE  
COLD  
FOG

FILE No. \_\_\_\_\_

FLDR. No. \_\_\_\_\_


FIGURED BY \_\_\_\_\_ SHEET 9 of

NOTES CHECKED BY \_\_\_\_\_

PLOTTED BY \_\_\_\_\_ DATE \_\_\_\_\_ 19\_\_

Quad. No. \_\_\_\_\_

STATION	DIST.	ANGLE " +	H. I. BEARING	VER. ANG. DIFF.	ELEVATION
			E 9TH ST.		
40+30 <sup>50</sup>					33.30' LT. POINT RAD.
40+12 <sup>50</sup>					RAD ON E
40+02 <sup>80</sup>					3' RT. POINT RAD.
39+30 <sup>40</sup>					12.10' RT. END 18" R.C.P.
39+27 <sup>60</sup>					EDGE 6' CONC. WALK
39+21 <sup>60</sup>					EDGE 6' CONC. WALK
39+18 <sup>10</sup>					12.10' LT. END 18" R.C.P.
37+60 <sup>25</sup>					12.90' LT. END 18" R.C.P.
37+57 <sup>85</sup>					EDGE 6' CONC. WALK
37+51 <sup>85</sup>					EDGE 6' CONC. WALK
37+48 <sup>40</sup>					12.90' LT. END 18" R.C.P.
35+88 <sup>25</sup>					12.80' LT. END 18" R.C.P.
35+85 <sup>25</sup>					EDGE 6' CONC. WALK
35+79 <sup>25</sup>					EDGE 6' CONC. WALK
35+76 <sup>05</sup>					12.80' LT. END 18" R.C.P.
35+02 <sup>70</sup>					3' RT. POINT RADIUS
34+94 <sup>50</sup>					RAD ON E
34+75 <sup>90</sup>					25' LT. POINT RAD.
34+53 <sup>15</sup>					29.50' LT. POINT RAD.
34+33 <sup>20</sup>					RAD ON E
34+24 <sup>00</sup>					

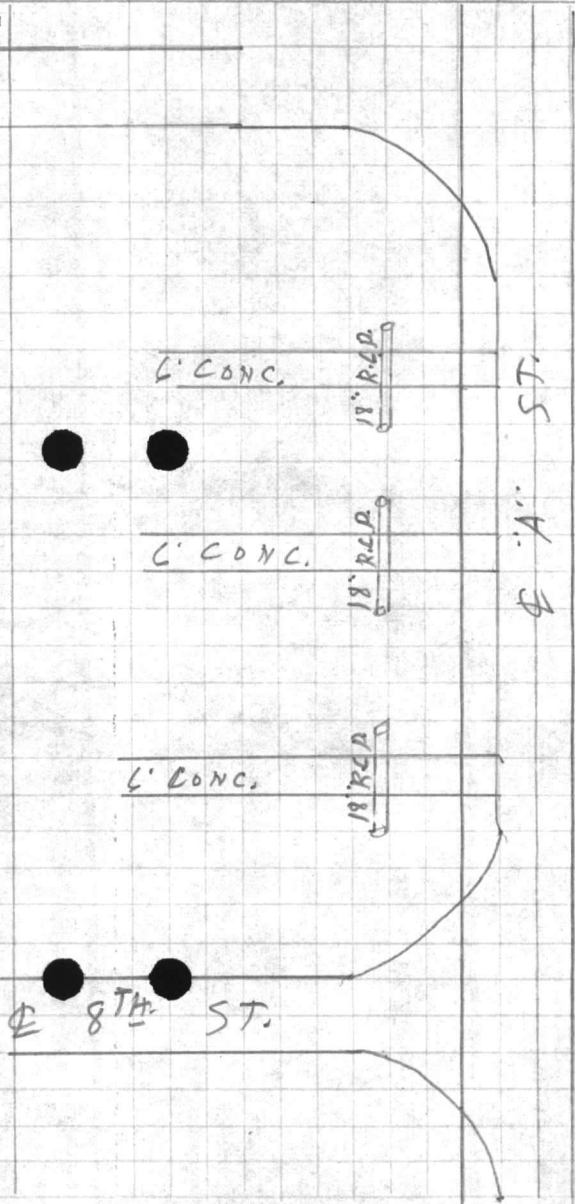

36+00 00  
20.80  
-----  
79 10

79 25  
3 15  
-----  
75 10








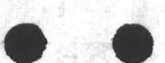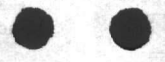

**VALUABLE**

SUBJECT \_\_\_\_\_

RETURN TO  
PUBLIC WORKS  
OFFICE  
CAMP LEJEUNE  
NORTH CAROLINA

**FIELD PARTY**

\_\_\_\_\_  
IN CHARGE  
\_\_\_\_\_  
INSTRUMENT  
\_\_\_\_\_  
NOTES  
\_\_\_\_\_  
TAPE READ  
\_\_\_\_\_  
TAPE OR ROD  
\_\_\_\_\_  
TAPE OR ROD  
\_\_\_\_\_  
INSTRUMENT No.  
\_\_\_\_\_  
TAPE No.

**WEATHER**

CLEAR  
CLOUDY  
WINDY  
RAIN  
FAIR  
SNOW  
HOT  
MODERATE  
COLD  
FOG

FILE No. \_\_\_\_\_

FLDR. No. \_\_\_\_\_

SHEET 1 of

FIGURED BY \_\_\_\_\_

NOTES CHECKED BY \_\_\_\_\_

PLOTTED BY \_\_\_\_\_ DATE \_\_\_\_\_ 19\_\_

Quad. No. \_\_\_\_\_

STATION	DIST.	ANGLE " "	+	H. I. BEARING	VER: ANG. DIFF.	ELEVATION
---------	-------	--------------	---	------------------	--------------------	-----------

43+12<sup>50</sup> 41.00' LT. EDGE MARL 59' LT. EDGE MARL

42+45<sup>00</sup> 41.50' LT. EDGE MARL 56' LT. EDGE MARL

42+12<sup>00</sup> 20' LT. EDGE MARL 48' LT. EDGE MARL

42+12<sup>00</sup> 22.50' LT. END CONC. CURB

42+10<sup>00</sup> 12.50' LT. END 12" R.C.P.

42+00<sup>00</sup> 2.20' RT. END CONC. CURB.

41+79<sup>20</sup> 22.70' LT. END CONC. CURB

41+70<sup>00</sup> 9' LT. EDGE CONC. CURB. 12.50' LT. END 12" R.C.P.

41+61<sup>60</sup> 3' RT. END CONC. CURB.

41+30<sup>00</sup> 7' LT. FIRE HYD. 23.40' LT. VALVE

40+80<sup>50</sup> 3' RT. POINT RAD.


40+71<sup>70</sup> RAD ON  $\Phi$

40+52<sup>00</sup> 36' LT. POINT RAD.

$\Phi$  9TH ST

$\Phi$  4th ST

12" R.C.P.

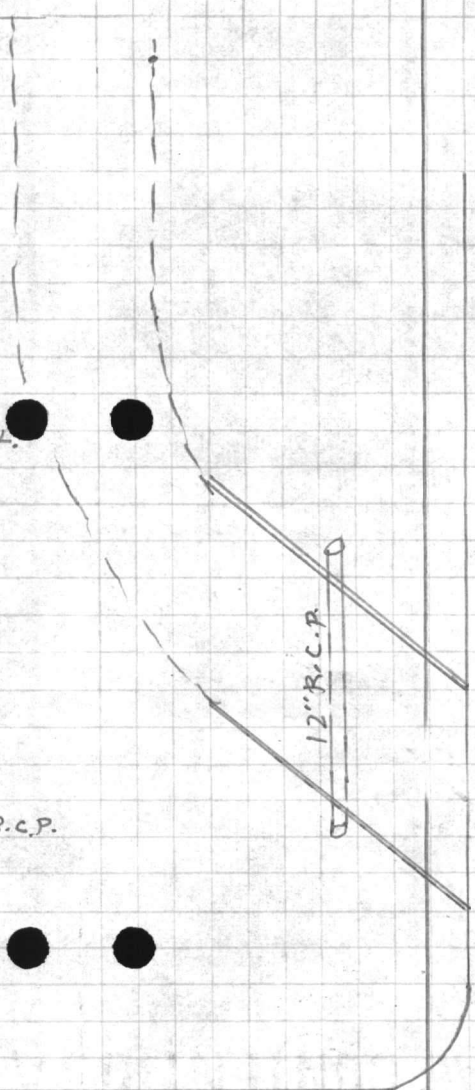









**VALUABLE**

SUBJECT \_\_\_\_\_

RETURN TO  
PUBLIC WORKS  
OFFICE  
CAMP LEJEUNE  
NORTH CAROLINA

**FIELD PARTY**

\_\_\_\_\_  
IN CHARGE  
\_\_\_\_\_  
INSTRUMENT  
\_\_\_\_\_  
NOTES  
\_\_\_\_\_  
TAPE READ  
\_\_\_\_\_  
TAPE OR ROD  
\_\_\_\_\_  
TAPE OR ROD  
\_\_\_\_\_  
INSTRUMENT No.  
\_\_\_\_\_  
TAPE No.

**WEATHER**

CLEAR \_\_\_\_\_  
CLOUDY \_\_\_\_\_  
WINDY \_\_\_\_\_  
RAIN \_\_\_\_\_  
FAIR \_\_\_\_\_  
SNOW \_\_\_\_\_  
HOT \_\_\_\_\_  
MODERATE \_\_\_\_\_  
COLD \_\_\_\_\_  
FOG \_\_\_\_\_

FILE No. \_\_\_\_\_

F.L.D.R. No. \_\_\_\_\_


FIGURED BY \_\_\_\_\_ SHEET 11 of

NOTES CHECKED BY \_\_\_\_\_

PLOTTED BY \_\_\_\_\_ DATE \_\_\_\_\_ 19\_\_

Quad. No. \_\_\_\_\_

STATION	DIST.	ANGLE ' "	+	H. I. BEARING	VER. ANG. DIFF.	ELEVATION
				Φ 10TH.		
45+11 <sup>00</sup>				20' LT. POINT RAD.		
44+90 <sup>00</sup>				RAD ON Φ		
44+83 <sup>00</sup>				3' RT. POINT RAD.		
44+71 <sup>85</sup>				3' LT.	15.50' LT.	OVERHEAD STEAM POLES
44+60 <sup>30</sup>				7.50' LT.	FIRE HYD.	24' LT. VALVE
44+09 <sup>30</sup>				2' RT. END CONC. CURB.		
43+98 <sup>00</sup>				12.50' LT-END 12" R.C.P.		
43+83 <sup>50</sup>				24.50' LT. END CONC. CURB + EDGE MARL.		
43+70 <sup>30</sup>				2.20' RT. END CONC. CURB.		
43+57 <sup>20</sup>				12.50' LT. END 12" R.C.P.		
43+50 <sup>00</sup>				24.40' LT. END CONC. CURB.		
43+50 <sup>00</sup>				27.40' LT. EDGE		

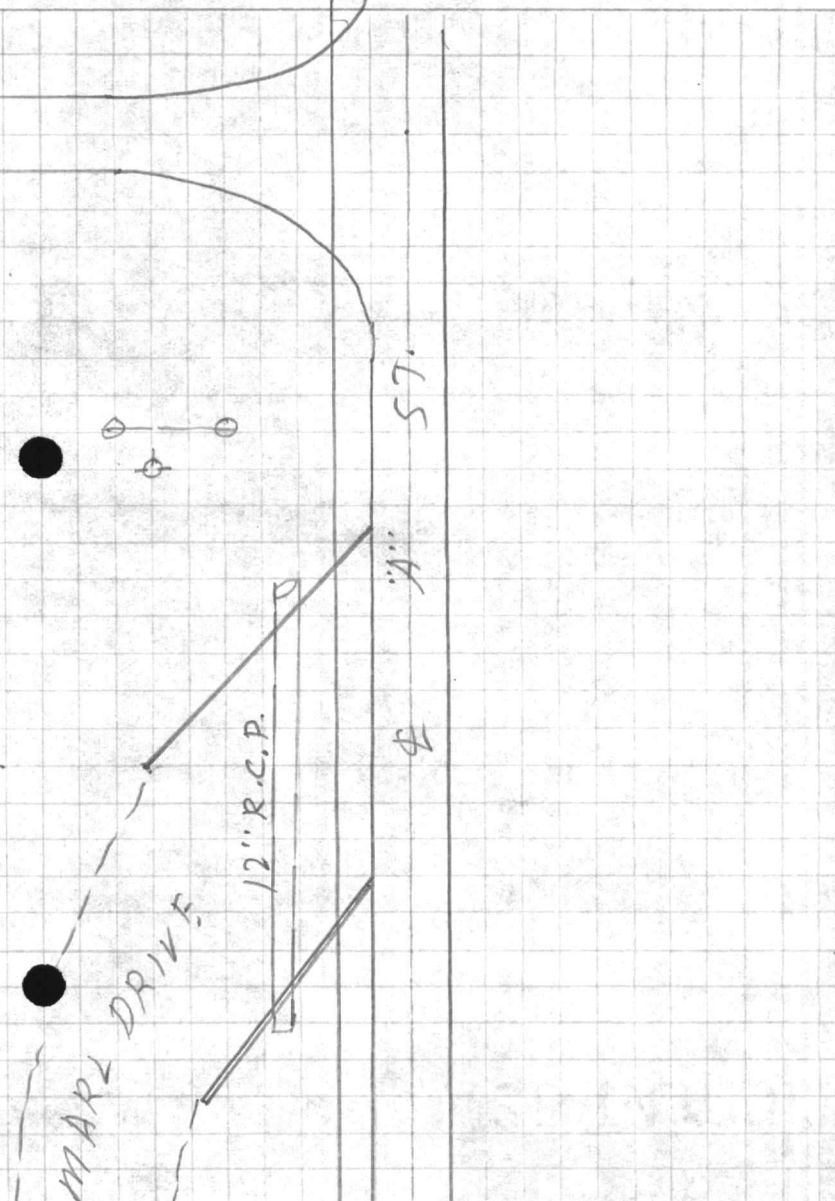










VALUABLE

SUBJECT \_\_\_\_\_

RETURN TO  
PUBLIC WORKS  
OFFICE  
CAMP LEJEUNE  
NORTH CAROLINA

FIELD PARTY

\_\_\_\_\_  
IN CHARGE  
\_\_\_\_\_  
INSTRUMENT  
\_\_\_\_\_  
NOTES  
\_\_\_\_\_  
TAPE READ  
\_\_\_\_\_  
TAPE OR ROD  
\_\_\_\_\_  
TAPE OR ROD  
\_\_\_\_\_  
INSTRUMENT No.  
\_\_\_\_\_  
TAPE No.

WEATHER

CLEAR  
CLOUDY  
WINDY  
RAIN  
FAIR

SNOW  
HOT  
MODERATE  
COLD  
FOG

FILE No. \_\_\_\_\_

FLDR. No. \_\_\_\_\_

SHEET 120f

NOTES CHECKED BY \_\_\_\_\_

FIGURED BY \_\_\_\_\_ DATE \_\_\_\_\_ 19\_\_

Quad. No. \_\_\_\_\_

STATION	DIST.	ANGLE " "	+	H. I. BEARING	VER. ANG. DIFF.	ELEVATION
---------	-------	--------------	---	------------------	--------------------	-----------


49+41 <sup>45</sup>						15' LT. END 18" R.C.P.
49+36 <sup>50</sup>						
49+30 <sup>50</sup>						
49+25 <sup>30</sup>						15' LT. END 18" R.C.P.
49+23 <sup>00</sup>						7' LT. FIRE HYD. 29.50' LT. VALVE

48+65 <sup>10</sup>						17' LT. END 18" R.C.P.
48+59 <sup>90</sup>						EDGE 6' CONC. WALK
48+53 <sup>90</sup>						EDGE 6' CONC. WALK
48+48 <sup>80</sup>						17' LT. END 18" R.C.P.



47+35 <sup>20</sup>						14.80' LT. END 24" R.C.P. 39' END 24" R.C.P.
46+31 <sup>80</sup>						12.50' RT. END 18" R.C.P.
46+26 <sup>30</sup>						EDGE 6' CONC. WALK
46+20 <sup>30</sup>						EDGE 6' CONC. WALK
46+15 <sup>30</sup>						12.50' RT. END 18" R.C.P.

45+59 <sup>40</sup>						3' RT. POINT RAD.
45+53 <sup>60</sup>						RAD ON $\Phi$
45+32 <sup>60</sup>						27.00' LT. POINT RAD.

$\Phi$  10<sup>TH</sup> ST.

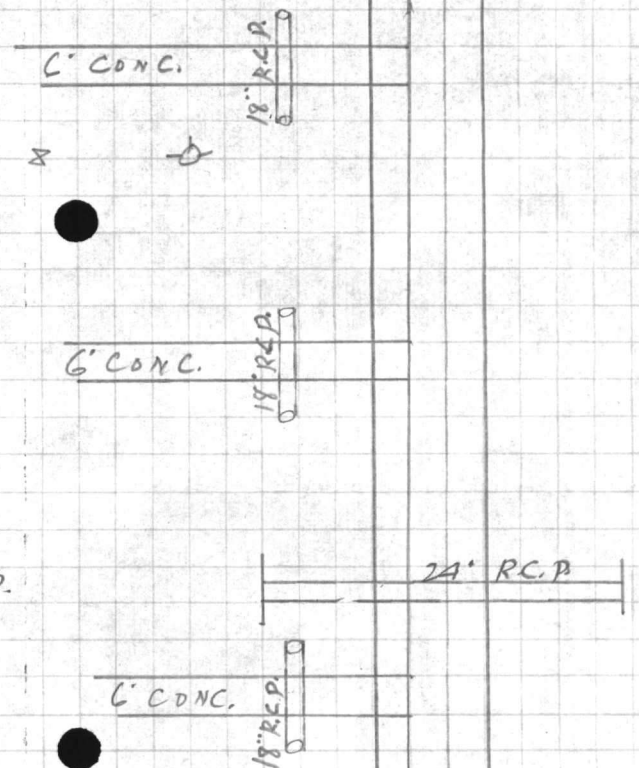


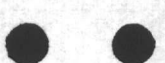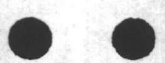

1918

**VALUABLE**

SUBJECT \_\_\_\_\_

RETURN TO  
PUBLIC WORKS  
OFFICE  
CAMP LEJEUNE  
NORTH CAROLINA

## FIELD PARTY

 \_\_\_\_\_ IN CHARGE  
 \_\_\_\_\_ INSTRUMENT  
 \_\_\_\_\_ NOTES  
 \_\_\_\_\_ TAPE READ  
 \_\_\_\_\_ TAPE OR ROD  
 \_\_\_\_\_ TAPE OR ROD  
 \_\_\_\_\_ INSTRUMENT No. \_\_\_\_\_  
 \_\_\_\_\_ TAPE No. \_\_\_\_\_

## WEATHER

 CLEAR  
 CLOUDY  
 WINDY  
 RAIN  
 FAIR  
 SNOW  
 HOT  
 MODERATE  
 COLD  
 FOG

FILE No. \_\_\_\_\_

FLDR. No. \_\_\_\_\_

SHEET 13 of 13

FIGURED BY \_\_\_\_\_

NOTES CHECKED BY \_\_\_\_\_

PLOTTED BY \_\_\_\_\_


DATE \_\_\_\_\_ 19\_\_

Quad. No. \_\_\_\_\_

STATION	DIST.	ANGLE ° ' "	+	H. I. BEARING	VER: ANG. DIFF.	ELEVATION
---------	-------	----------------	---	------------------	--------------------	-----------

52+00 <sup>00</sup>		∠ 11 <sup>TH</sup> ST.		∠ 11 <sup>TH</sup> ST		
51+88 <sup>20</sup>		37' LT. POINT RAD.				
51+71 <sup>65</sup>		RAD ON ∠				
51+52 <sup>50</sup>		3' RT. POINT RAD.				

50+94 <sup>65</sup>		12.50' LT. END 18" R.C.P.				
50+89 <sup>30</sup>		Edge walk				
50+83 <sup>30</sup>		Edge walk				
50+78 <sup>15</sup>		12.50' LT. END 18" R.C.P.				

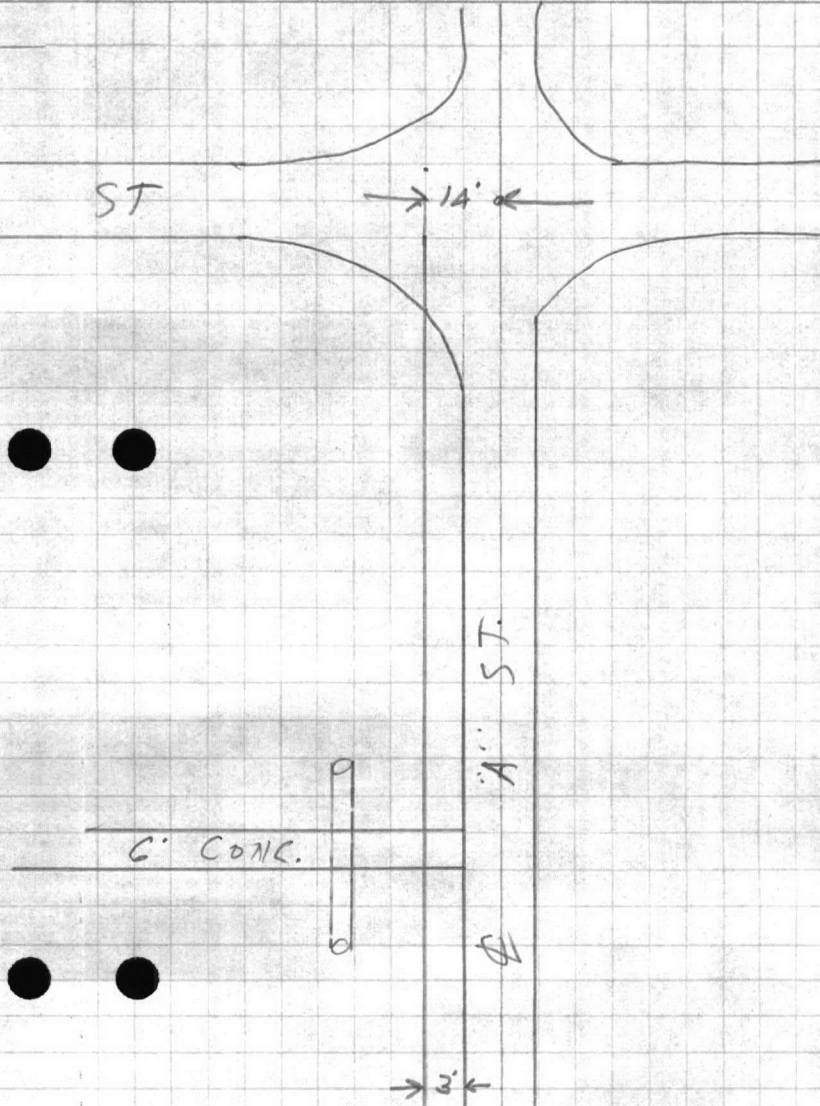

























PUBLIC WORKS DEPARTMENT  
Camp Lejeune, North Carolina  
Survey Department

File 98-P  
Quadrangle \_\_\_\_\_  
Date \_\_\_\_\_  
Sheet \_\_\_\_\_ of \_\_\_\_\_

Traverse Computation  
Description

*NEW ROAD LOCATION - CAMP GEIGER (AS BUILT.)*

Station	Distance	Bearing	Cosine	Sine	Latitude	Departure	Y Coordinate North	X Coordinate East
POINT opposite cor. Bldg #569		N 2-07-25 W					364,368.13	2,465,946.51
P.I. #1 Road Loc. Traverse	594.48	N 2-07-25 W	9993132	0370555	594.47 + .30	21.94 24.03 - .09	362,962.50	2,465,424.57
P.I. #2	122.90	N 87-47-24 E	0385622	9992562	4.74	123.33 122.81 + .52	362,967.24	2,465,547.90
P.I. #3	255.21	S 72-14-57 E	3048781	9523914	77.87 - .04	244.10 243.06 + 1.04	362,889.47	2,465,792.00
P.O.T. #1	123.80	S 50-27-18 E	6366841	7711248	78.87 - .04	95.87 95.47 + .40	362,810.69	2,465,887.87
P.I. #4	69.65	S 50-27-18 E	6366841	7711248	44.34 - .02	.32 94	362,766.37	2,465,941.81
P.I. #5	342.54	S 41-29-34 E	7490392	6625256	256.58 - .13	.45 227.90 226.94 + .96	362,509.92	2,466,169.71
P.I. #6	229.79	S 44-41-20 E	7109359	7032568	163.37 - .08	.29 162.28 161.60 + .68	362,346.63	2,466,331.99
P.I. #7 intersection of NEW ROAD AND AC 2 RR	206.15	S 54-28-51 E	5809753	8139212	119.77 - .06	.71 168.50 167.79 + .71	362,226.92	2,466,500.49
Boundary Pipe Marker #363	585.98	S 11-10-23 W	9810464	1937730	574.87 - .29	.58 107 113.55 - .48	361,652.34	2,466,387.42
TOTAL							361,651.38	2,466,382.31
					-1315.56	+1071.38		
					+598.81	-135.58		-5.11
					-716.75	+935.80		
TO TENT CAMP #2 water TANK		S 23-20-29 W						
		23-26						

error + 5' 31" Adj.



**VALUABLE**

RETURN TO  
PUBLIC WORKS  
OFFICE  
CAMP LEJEUNE  
NORTH CAROLINA

SUBJECT LOCATION & ELEV.  
WATER & SEWER LINES  
BLDG # 400 CAMP  
GEIGER


FIELD PARTY  
DENNIS IN CHARGE  
\_\_\_\_ INSTRUMENT  
\_\_\_\_ NOTES  
\_\_\_\_ TAPE READ  
\_\_\_\_ TAPE OR ROD  
\_\_\_\_ TAPE OR ROD  
\_\_\_\_ INSTRUMENT No.  
\_\_\_\_ TAPE No.

WEATHER  
CLEAR \_\_\_\_\_  
CLOUDY \_\_\_\_\_  
WINDY \_\_\_\_\_  
RAIN \_\_\_\_\_  
FAIR \_\_\_\_\_

SNOW \_\_\_\_\_  
HOT \_\_\_\_\_  
MODERATE \_\_\_\_\_  
COLD \_\_\_\_\_  
FOG \_\_\_\_\_

FIGURED BY \_\_\_\_\_  
NOTES CHECKED BY \_\_\_\_\_  
PLOTTED BY \_\_\_\_\_

FILE No. 98-P  
FLDR. No. \_\_\_\_\_  
SHEET 1 of 4  
DATE 3. 7 19 58  
Quad. No. \_\_\_\_\_

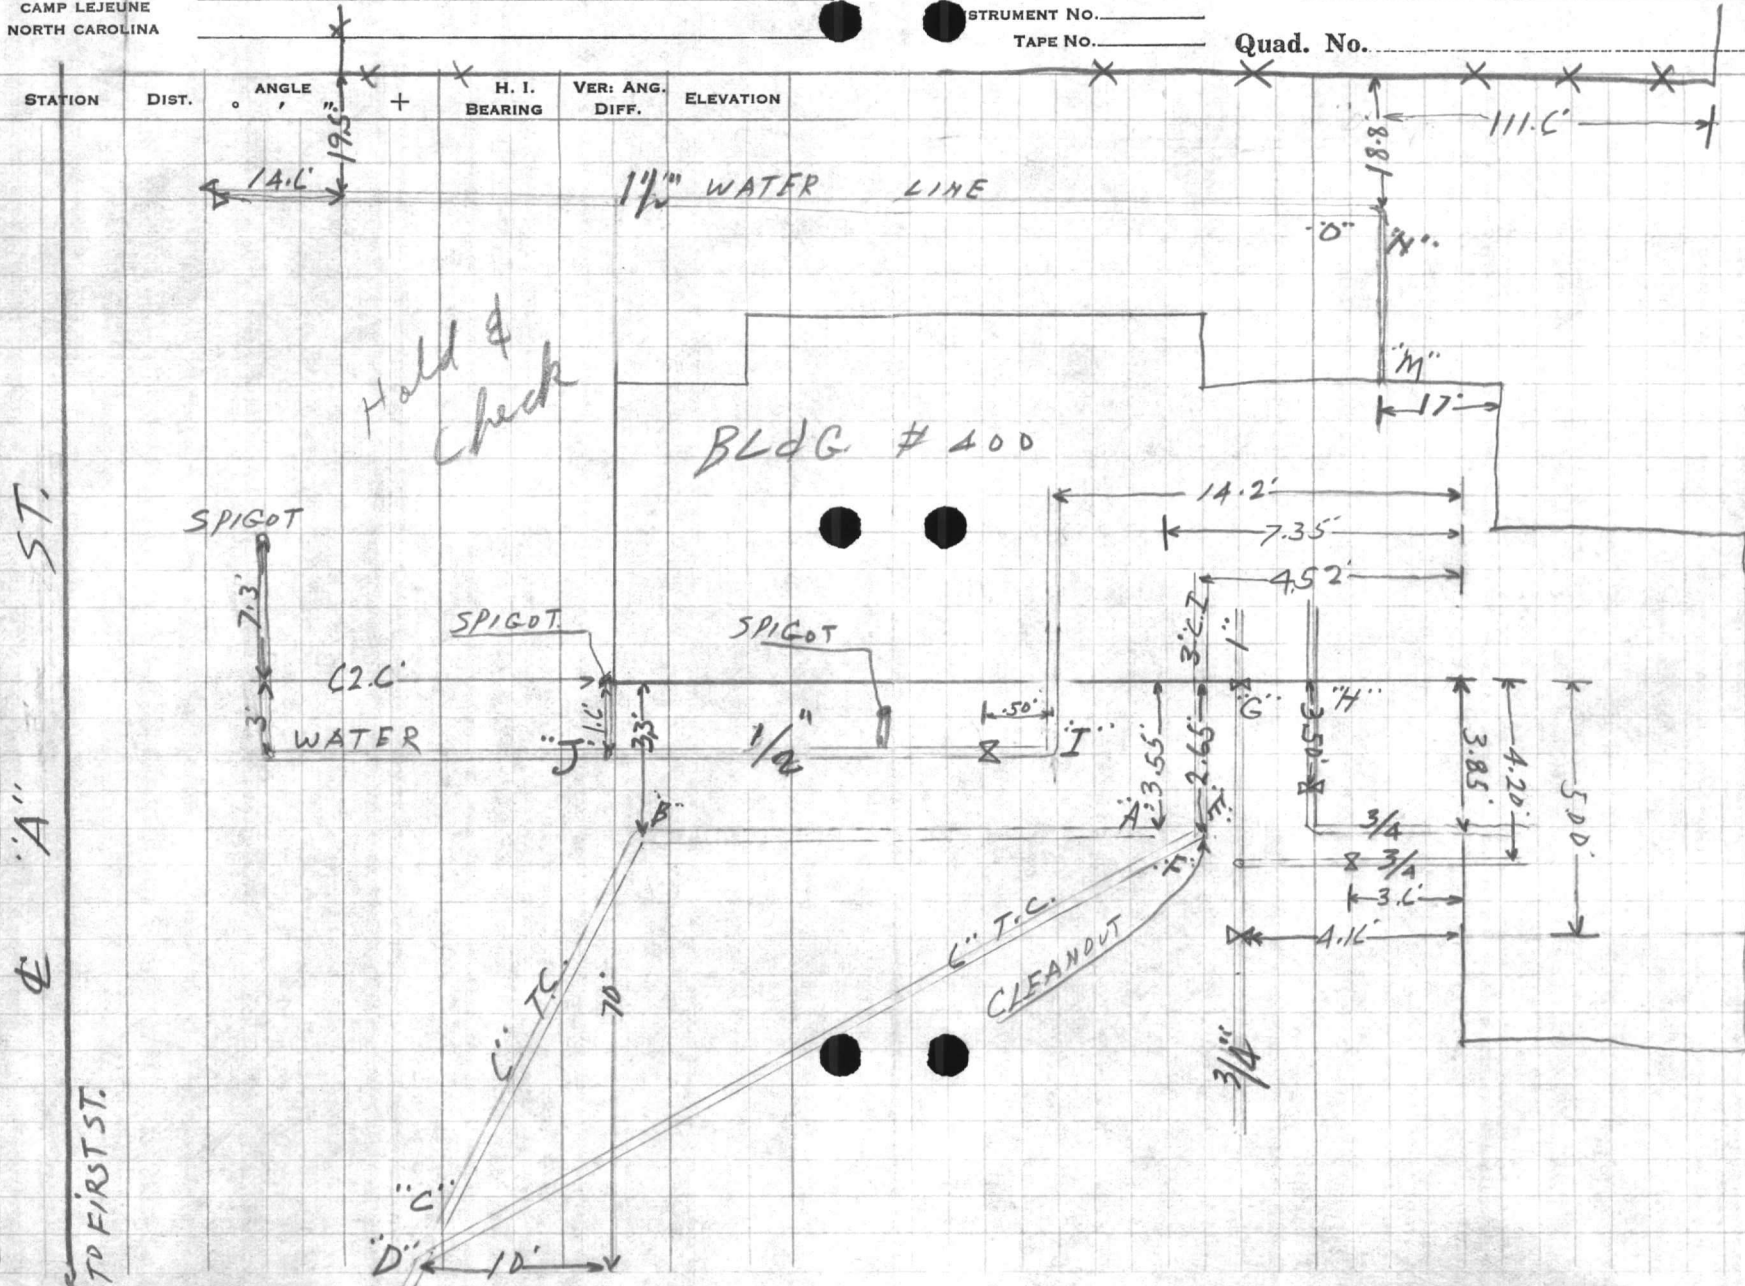












**VALUABLE**

SUBJECT \_\_\_\_\_  
 \_\_\_\_\_  
 \_\_\_\_\_  
 RETURN TO  
 PUBLIC WORKS  
 OFFICE  
 CAMP LEJEUNE  
 NORTH CAROLINA

**FIELD PARTY**


\_\_\_\_\_ IN CHARGE  
 \_\_\_\_\_ INSTRUMENT  
 \_\_\_\_\_ NOTES  
 \_\_\_\_\_ TAPE READ  
 \_\_\_\_\_ TAPE OR ROD  
 \_\_\_\_\_ TAPE OR ROD  
 \_\_\_\_\_ INSTRUMENT NO.  
 \_\_\_\_\_ TAPE NO.

**WEATHER**

CLEAR \_\_\_\_\_ SNOW \_\_\_\_\_  
 CLOUDY \_\_\_\_\_ HOT \_\_\_\_\_  
 WINDY \_\_\_\_\_ MODERATE \_\_\_\_\_  
 RAIN \_\_\_\_\_ COLD \_\_\_\_\_  
 FAIR \_\_\_\_\_ FOG \_\_\_\_\_

FILE No. \_\_\_\_\_  
 FLD. No. \_\_\_\_\_  
 SHEET 2 of 4  
 FIGURED BY \_\_\_\_\_  
 NOTES CHECKED BY \_\_\_\_\_  
 PLOTTED BY \_\_\_\_\_ DATE \_\_\_\_\_ 19\_\_

Quad. No. \_\_\_\_\_

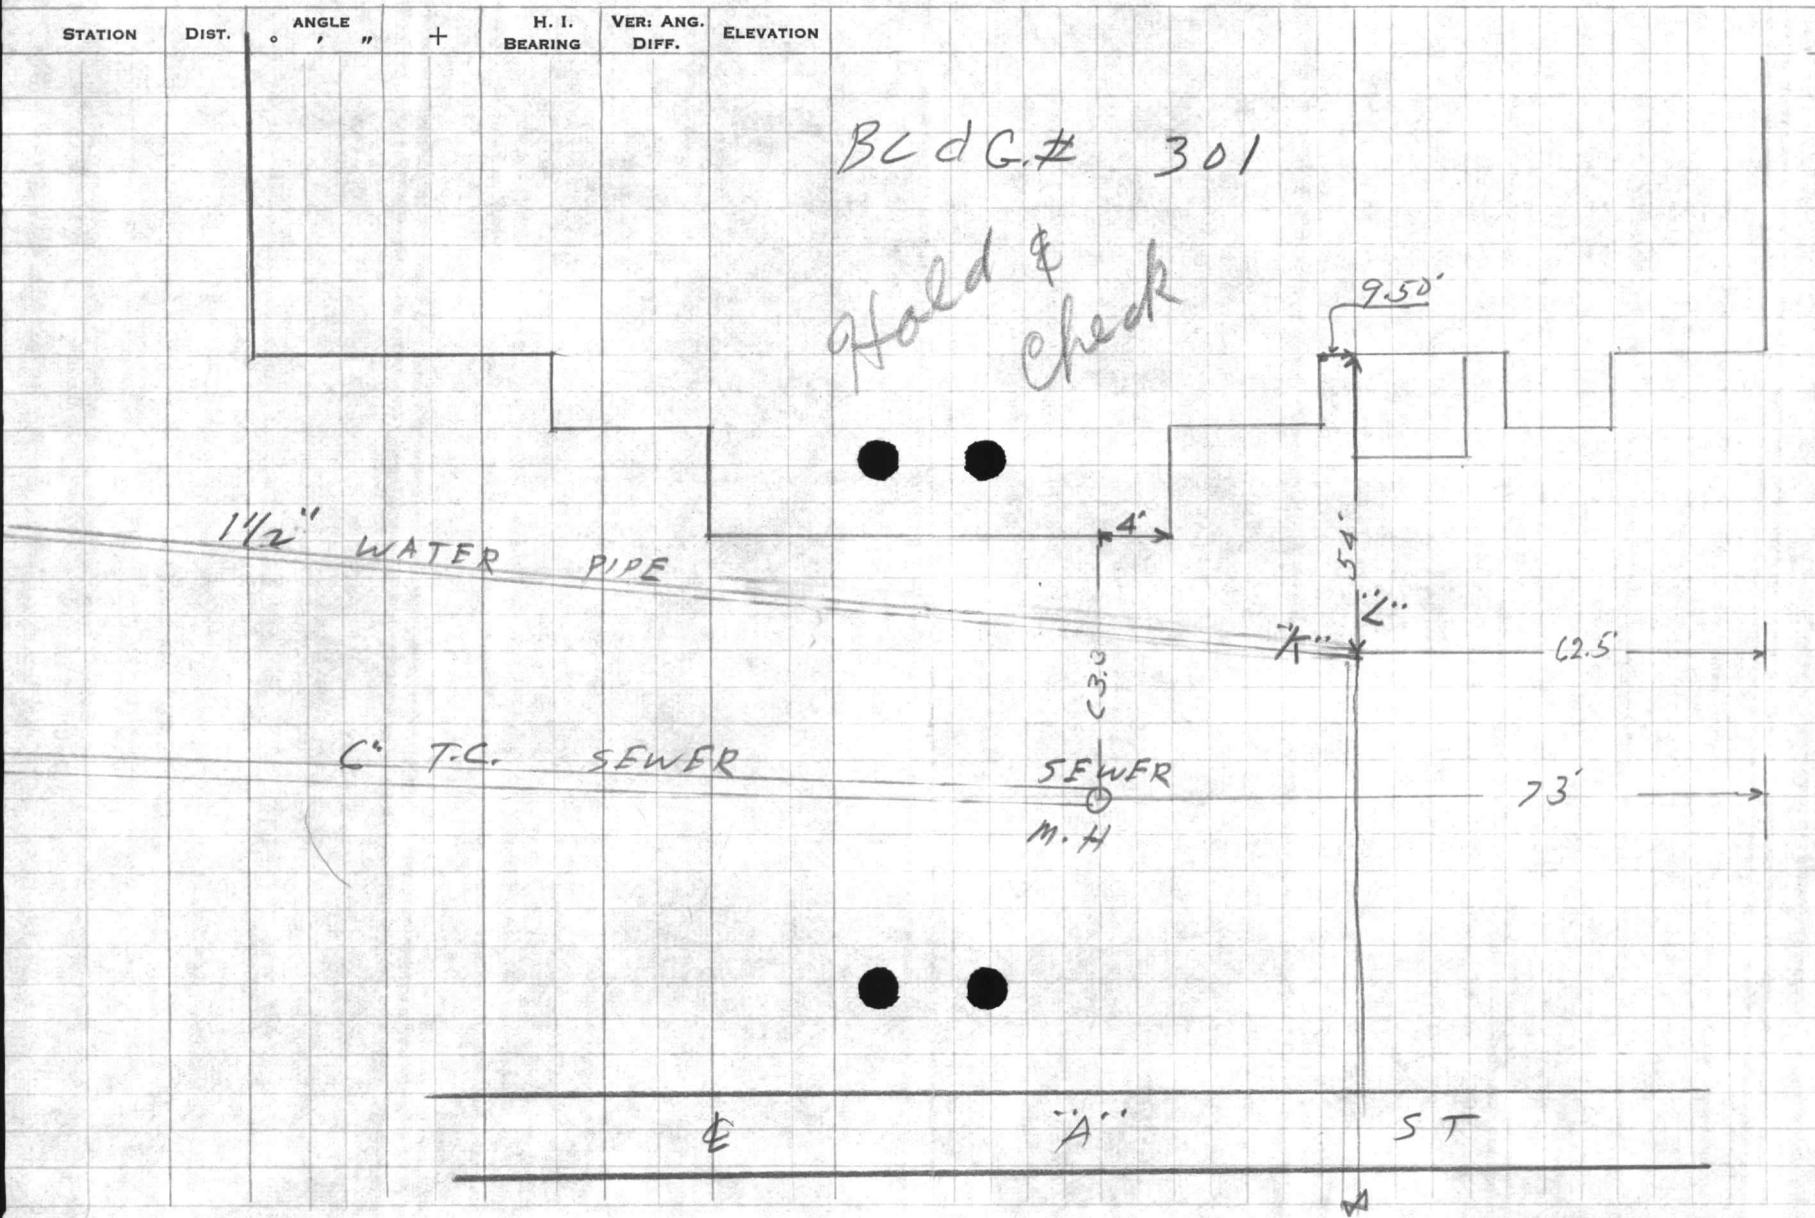



**VALUABLE**

SUBJECT \_\_\_\_\_

RETURN TO  
PUBLIC WORKS  
OFFICE  
CAMP LEJEUNE  
NORTH CAROLINA

**FIELD PARTY**

\_\_\_\_\_  
IN CHARGE  
\_\_\_\_\_  
INSTRUMENT  
\_\_\_\_\_  
NOTES  
\_\_\_\_\_  
TAPE READ  
\_\_\_\_\_  
TAPE OR ROD  
\_\_\_\_\_  
TAPE OR ROD  
\_\_\_\_\_  
INSTRUMENT NO.  
\_\_\_\_\_  
TAPE NO.

**WEATHER**

CLEAR  
CLOUDY  
WINDY  
RAIN  
FAIR  
SNOW  
HOT  
MODERATE  
COLD  
FOG  
FIGURED BY \_\_\_\_\_  
NOTES CHECKED BY \_\_\_\_\_  
PLOTTED BY \_\_\_\_\_

FILE No. \_\_\_\_\_

FLDR. No. \_\_\_\_\_

SHEET 3 of 4

DATE \_\_\_\_\_ 19\_\_

Quad. No. \_\_\_\_\_

STATION	DIST.	ANGLE ° ' "	+	H. I. BEARING	VER: ANG. DIFF.	ELEVATION	
B.m			244				FLOOR BLDG.# 400
"A"					6.07		END OLD SEWER 6"
"B"					6.40		TOP 90° BEND ON OLD SEWER 6"
"C"					6.38		END OLD SEWER
"D"					6.58		TOP NEW T.C. 45° BEND 6"
"E"					6.20		TOP 3" C.I. SEWER PIPE
"F"					6.08		TOP 6" T.C. SEWER PIPE
"G"					5.92		TOP 1" WATER PIPE
"H"					5.95		TOP 3/4" WATER PIPE
"I"					5.92		TOP 3/4" WATER PIPE
"J"					5.47		" " " "
"K"					6.12		TOP 2" OUTSIDE WATER
"L"					6.57		TOP 2" OUTSIDE WATER
					8.07		TOP 6" SEWER LINE IN M.H.
					4.51		TOP SEWER M.H.
T.P.			444		4.78		



**VALUABLE**

SUBJECT \_\_\_\_\_

RETURN TO  
PUBLIC WORKS  
OFFICE  
CAMP LEJEUNE  
NORTH CAROLINA

## FIELD PARTY

\_\_\_\_\_  
IN CHARGE  
\_\_\_\_\_  
INSTRUMENT  
\_\_\_\_\_  
NOTES  
\_\_\_\_\_  
TAPE READ  
\_\_\_\_\_  
TAPE OR ROD  
\_\_\_\_\_  
TAPE OR ROD  
\_\_\_\_\_  
INSTRUMENT NO.  
\_\_\_\_\_  
TAPE NO.

## WEATHER

CLEAR  
CLOUDY  
WINDY  
RAIN  
FAIR  
SNOW  
HOT  
MODERATE  
COLD  
FOG

FILE No. \_\_\_\_\_

FLDR. No. \_\_\_\_\_

SHEET 4 of 4

FIGURED BY \_\_\_\_\_

NOTES CHECKED BY \_\_\_\_\_

PLOTTED BY \_\_\_\_\_

DATE \_\_\_\_\_ 19\_\_

Quad. No. \_\_\_\_\_

STATION	DIST.	ANGLE		+	H. I. BEARING	VER. ANG. DIFF.	ELEVATION	
		°	' "					
"M"						5 25		TOP 2" WATER LINE
"N"						6 84		TOP 2" WATER LINE
"D"						7 61		TOP 2" WATER LINE









**VALUABLE**

RETURN TO  
PUBLIC WORKS  
OFFICE  
CAMP LEJEUNE  
NORTH CAROLINA

SUBJECT

Location Rd. to  
Dump Camp Greger  
Asphalt Surface

FIELD PARTY  
Morton IN CHARGE  
INSTRUMENT  
NOTES  
TAPES READ  
TAPES OR RODS  
TAPES OR RODS  
INSTRUMENT NO.  
TAPES NO.


WEATHER  
CLEAR  
CLOUDY  
WINDY  
RAIN  
FAIR  
SNOW  
HOT  
MODERATE  
COLD  
FOG  
FIGURED BY  
NOTES CHECKED BY  
PLOTTED BY

FILE NO.  
FLDR. NO.  
SHEET 101  
DATE 7/2 1955

Quad. No.

STATION	DIST.	ANGLE " "	+	H. I. BEARING	VER. ANG. DIFF.	ELEVATION
	19345					575
Lat pt # 3	2014830		①			
	2452500		③			
	2014820		④			
	25521					
Lat pt # 2	1995830		①	P.C.	173 RT Q Rd.	
	2895500		③			
	1995820		④			
	010165				RT Q Rd.	
	12290					
Lat pt # 1	895545		①			
BS Point A	2694630		③			
To pt # 2	895530		④			

193.45  
123.80  
69.65

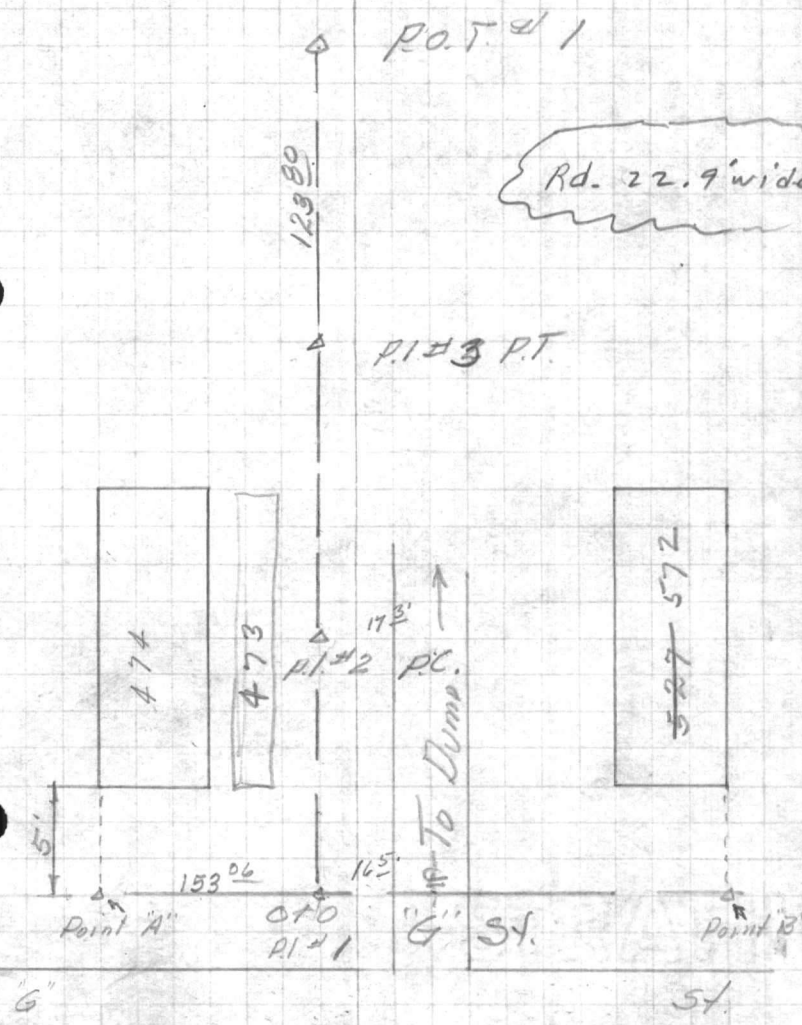

✓ ✓  
201 4830

245 25      120  
360            25  
3)605 (201) 3)145 (48)  
6                12  
0                25  
0  
5  
3  
2



**VALUABLE**

SUBJECT \_\_\_\_\_

 RETURN TO  
 PUBLIC WORKS  
 OFFICE  
 CAMP LEJEUNE  
 NORTH CAROLINA

## FIELD PARTY

 \_\_\_\_\_ IN CHARGE  
 \_\_\_\_\_ INSTRUMENT  
 \_\_\_\_\_ NOTES  
 \_\_\_\_\_ TAPE READ  
 \_\_\_\_\_ TAPE OR ROD  
 \_\_\_\_\_ TAPE OR ROD  
 \_\_\_\_\_ INSTRUMENT NO.  
 \_\_\_\_\_ TAPE NO.

## WEATHER

 CLEAR  
 CLOUDY  
 WINDY  
 RAIN  
 FAIR  
 SNOW  
 HOT  
 MODERATE  
 COLD  
 FOG

FILE No. \_\_\_\_\_

FLDR. No. \_\_\_\_\_

SHEET 1A

NOTES CHECKED BY \_\_\_\_\_

PLOTTED BY \_\_\_\_\_ DATE \_\_\_\_\_ 19\_\_

Quad. No. \_\_\_\_\_

STATION	DIST.	ANGLE ° ' "	+	H. I. BEARING	VER. ANG. DIFF.	ELEVATION
---------	-------	----------------	---	------------------	--------------------	-----------

 Not RL #1  
 BS point #A

7	130	15 00				
19	286	15 00				
31	298	50 00				
55	209	11 00				
37	204	12 00				
31	194	29 00				
32	153	18 00				











1 / 1  
188 58 30

2 06 55 15

360  
3 ) 566 ( 188

3  
26  
24

26  
24

2

11  
60

3 ) 75 ( 25  
~~60~~  
15

120  
45

3 ) 175 ( 58  
15  
25

sta

0+50

17.0

1+0

18.20

1+50

18.20

2+29.79

15.10

176 49 00  
170 26 45

360  
3 ) 30 ( 176

3  
23  
21  
20  
18

120  
26

3 ) 146 ( 48  
12  
26  
24  
2

120  
45

3 ) 175 ( 58  
15  
25

VALUABLE

SUBJECT \_\_\_\_\_

RETURN TO  
PUBLIC WORKS  
OFFICE  
CAMP LEJEUNE  
NORTH CAROLINA

150  
50  
333

150  
56 15

FIELD PARTY

\_\_\_\_\_  
IN CHARGE  
\_\_\_\_\_  
INSTRUMENT  
\_\_\_\_\_  
NOTES  
\_\_\_\_\_  
TAPE READ  
\_\_\_\_\_  
TAPE OR ROD  
\_\_\_\_\_  
TAPE OR ROD  
\_\_\_\_\_  
INSTRUMENT NO.  
\_\_\_\_\_  
TAPE NO.

WEATHER

CLEAR  
CLOUDY  
WINDY  
RAIN  
FAIR

SNOW  
HOT  
MODERATE  
COLD  
FOG

FILE No. \_\_\_\_\_

FLDR. No. \_\_\_\_\_

SHEET 30f

FIGURED BY \_\_\_\_\_ NOTES CHECKED BY \_\_\_\_\_

PLOTTED BY \_\_\_\_\_ DATE \_\_\_\_\_ 19\_\_

Quad. No. \_\_\_\_\_

STATION	DIST.	ANGLE ° ' "	+	H. I. BEARING	VER: ANG. DIFF.	ELEVATION
---------	-------	----------------	---	------------------	--------------------	-----------

At U.S.M.C. 192 10 00 (1)  
Marker 363 216 32 30 (3)  
B.S. P.I.#7 192 10 50 (M)

To Water Tank  
Tent Camp #2  
585 98

At P.I.#7 225 40 00 (1)  
16 59 45 (3)  
295 39 55 (M)

178 33 60' P.I. & Rd END pavement  
1750 120' P.I. & Rd  
170 174' P.I. & Rd  
0750 180' P.I. & Rd

P.I.#7  
Q. Rd. & R.R.

206 W

At P.I. 6 170 13 15 (1)  
150 39 30 (3)  
170 13 10 (M)

P.I.#6

✓ ✓  
~~170 1330~~

~~150 3915~~

~~360~~

~~3  $\overline{) 190}$  (163)~~

~~3~~

~~79~~

~~78~~

~~70~~

~~3  $\overline{) 570}$  (170)~~

~~3~~

~~21~~

3  $\overline{) 39}$  (13)

✓ 10

192 1100

216 3230

360

3  $\overline{) 576}$  (192)

3

27

27

120

30

3  $\overline{) 150}$  (50)

✓  
245 4000

16 5945

720

3  $\overline{) 736}$  (245)

6

13

12

16

✓ ✓ 15  
170 1300

150 3930

360

3  $\overline{) 1027}$

213  $\overline{) 39}$  (13)

3  $\overline{) 30}$  (10)

120

45

3  $\overline{) 65}$  (15)

60

59

3  $\overline{) 119}$  (39)

9

29

**VALUABLE**
 RETURN TO  
 PUBLIC WORKS  
 OFFICE  
 CAMP LEJEUNE  
 NORTH CAROLINA

SUBJECT

 Location Water Line  
 Camp Glegar

## FIELD PARTY

 \_\_\_\_\_ IN CHARGE  
 \_\_\_\_\_ INSTRUMENT  
 \_\_\_\_\_ NOTES  
 \_\_\_\_\_ TAPE READ  
 \_\_\_\_\_ TAPE OR ROD  
 \_\_\_\_\_ TAPE OR ROD  
 \_\_\_\_\_ INSTRUMENT NO.  
 \_\_\_\_\_ TAPE NO.

## WEATHER

 CLEAR  
 CLOUDY  
 WINDY  
 RAIN  
 FAIR  
 SNOW  
 HOT  
 MODERATE  
 COLD  
 FOG

FILE No. \_\_\_\_\_

FLDR. No. \_\_\_\_\_

SHEET

DATE

7/2 1955

Quad. No. \_\_\_\_\_

STATION	DIST.	ANGLE ° ' "	+	H. I. BEARING	VER: ANG. DIFF.	ELEVATION
---------	-------	----------------	---	------------------	--------------------	-----------

 Not pt #1  
 BS PI #3

325	290	14 00		1" Water Line		
297	291	00 00		" " "		
327	285	27 00		2" Riser		
204	294	35 00		1" "		
90	270	35 00		1" Water Line		
126	251	29 00		2" " "		
193	291	06 00		1" Riser		

 Not pt #1  
 BS PI #4

35	75	25 00		2" Water Line		
146	704	20 00		2" " "		
188	605	59 00		1" " "		
180	633	31 00		1" " "		
215	733	38 00		2" " "		
180	104	17 00		2" " "		
177	955	10 00		1" " "		END Line



















**VALUABLE**

SUBJECT \_\_\_\_\_  
\_\_\_\_\_  
\_\_\_\_\_  
RETURN TO  
PUBLIC WORKS  
OFFICE  
CAMP LEJEUNE  
NORTH CAROLINA

**FIELD PARTY**

\_\_\_\_\_  
IN CHARGE  
\_\_\_\_\_  
INSTRUMENT  
\_\_\_\_\_  
NOTES  
\_\_\_\_\_  
TAPE READ  
\_\_\_\_\_  
TAPE OR ROD  
\_\_\_\_\_  
TAPE OR ROD  
\_\_\_\_\_  
INSTRUMENT NO.  
\_\_\_\_\_  
TAPE NO.


**WEATHER**

CLEAR  
CLOUDY  
WINDY  
RAIN  
FAIR  
SNOW  
HOT  
MODERATE  
COLD  
FOG

FILE No. \_\_\_\_\_  
FLDR. No. \_\_\_\_\_  
FIGURED BY \_\_\_\_\_ SHEET 1-A  
NOTES CHECKED BY \_\_\_\_\_  
PLOTTED BY \_\_\_\_\_ DATE \_\_\_\_\_ 19\_\_

Quad. No. \_\_\_\_\_

STATION	DIST.	ANGLE			+	H. I. BEARING	VER. ANG. DIFF.	ELEVATION
		°	'	"				

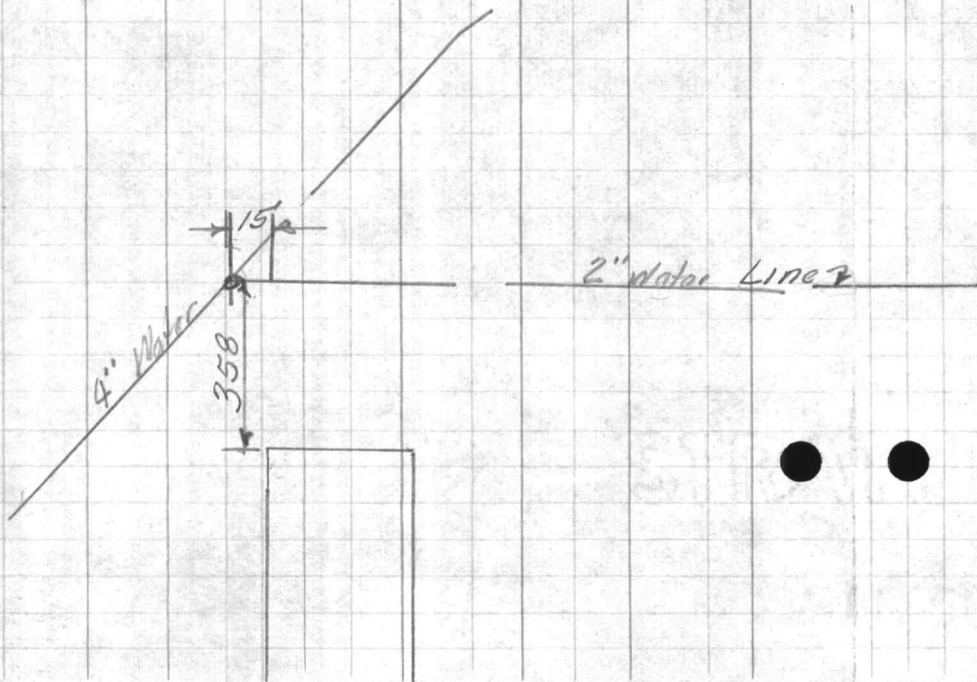



**VARIABLE**

SUBJECT \_\_\_\_\_

RETURN TO  
PUBLIC WORKS  
OFFICE  
CAMP LEJEUNE  
NORTH CAROLINA

**FIELD PARTY**

\_\_\_\_\_  
IN CHARGE  
\_\_\_\_\_  
INSTRUMENT  
\_\_\_\_\_  
NOTES  
\_\_\_\_\_  
TAPE READ  
\_\_\_\_\_  
TAPE OR ROD  
\_\_\_\_\_  
TAPE OR ROD  
\_\_\_\_\_  
INSTRUMENT NO.  
\_\_\_\_\_  
TAPE NO.

**WEATHER**

CLEAR  
CLOUDY  
WINDY  
RAIN  
FAIR

SNOW  
HOT  
MODERATE  
COLD  
FOG

FILE No. \_\_\_\_\_

FLDR. No. \_\_\_\_\_


FIGURED BY \_\_\_\_\_ SHEET \_\_\_\_\_

NOTES CHECKED BY \_\_\_\_\_

PLOTTED BY \_\_\_\_\_ DATE \_\_\_\_\_ 19\_\_

Quad. No. \_\_\_\_\_

STATION	DIST.	ANGLE ° ' "	+	H. I. BEARING	VER. ANG. DIFF.	ELEVATION
---------	-------	----------------	---	------------------	--------------------	-----------

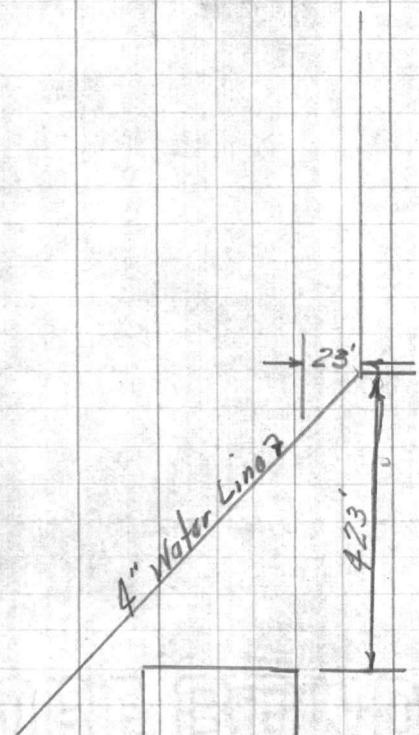












**VALUABLE**

SUBJECT \_\_\_\_\_  
 \_\_\_\_\_  
 \_\_\_\_\_  
 \_\_\_\_\_

RETURN TO  
 PUBLIC WORKS  
 OFFICE  
 CAMP LEJEUNE  
 NORTH CAROLINA

**FIELD PARTY**

\_\_\_\_\_ IN CHARGE  
 \_\_\_\_\_ INSTRUMENT  
 \_\_\_\_\_ NOTES  
 \_\_\_\_\_ TAPE READ  
 \_\_\_\_\_ TAPE OR ROD  
 \_\_\_\_\_ TAPE OR ROD  
 \_\_\_\_\_ INSTRUMENT No.  
 \_\_\_\_\_ TAPE No.

**WEATHER**


CLEAR  
 CLOUDY  
 WINDY  
 RAIN  
 FAIR

SNOW  
 HOT  
 MODERATE  
 COLD  
 FOG

FILE No. \_\_\_\_\_  
 FLDR. No. \_\_\_\_\_  
 SHEET 10f  
 DATE 6/6 1955

FIGURED BY \_\_\_\_\_  
 NOTES CHECKED BY \_\_\_\_\_  
 PLOTTED BY \_\_\_\_\_  
 Quad. No. \_\_\_\_\_

STATION	DIST.	ANGLE " "	H. I. BEARING	VER: ANG. DIFF.	ELEVATION
---------	-------	--------------	------------------	--------------------	-----------

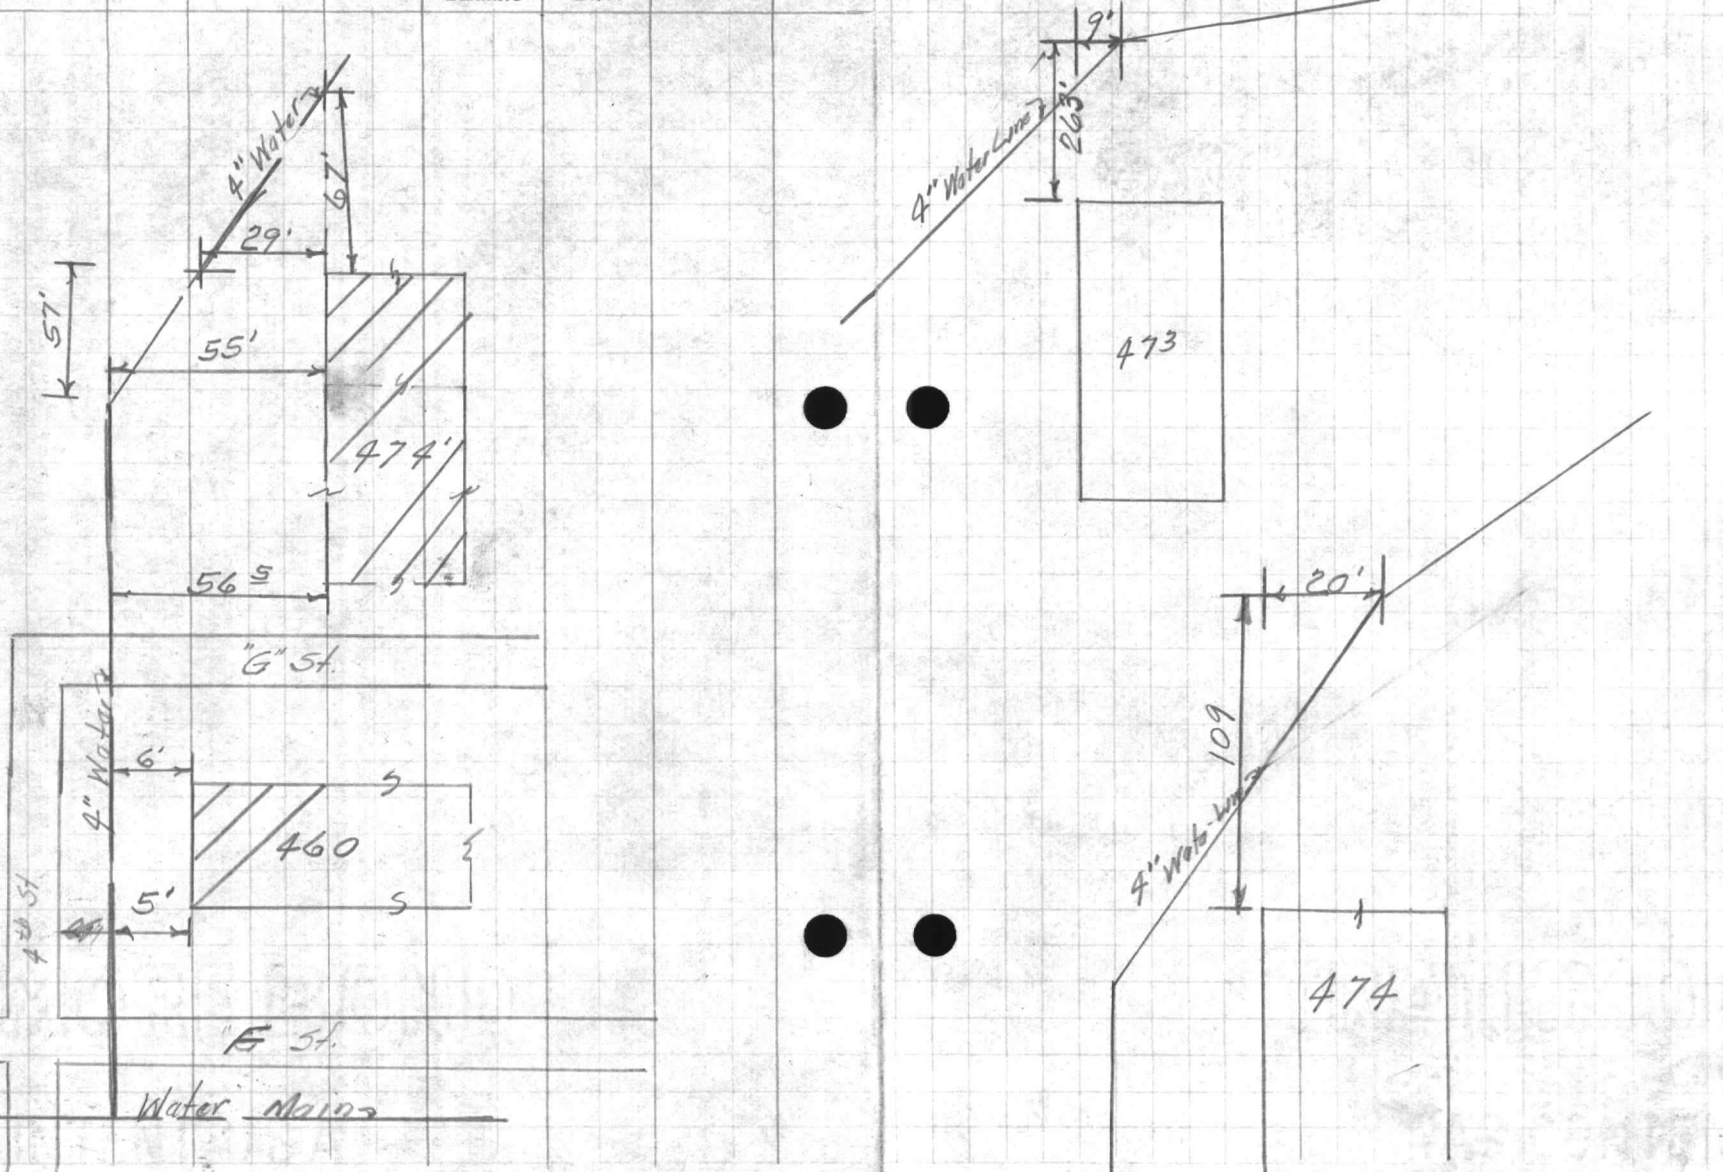



**VALUABLE**

SUBJECT

*Dimensions - Water  
plant - Camp Geiger*

*Fence*

RETURN TO  
PUBLIC WORKS  
OFFICE  
CAMP LEJEUNE  
NORTH CAROLINA

FIELD PARTY

*Murphy*  
IN CHARGE

INSTRUMENT

NOTES

TAPE READ

TAPE OR ROD

TAPE OR ROD

INSTRUMENT NO.

TAPE NO.

WEATHER

CLEAR  
CLOUDY  
WINDY  
RAIN  
FAIR

SNOW  
HOT  
MODERATE  
COLD  
FOG

FIGURED BY

NOTES CHECKED BY

PLOTTED BY

FILE No. *98-P*

FLDR. No.


SHEET *1051*

DATE *11-16-1953*

Quad. No.

STATION	DIST.	ANGLE ° ' "	+	H. I. BEARING	VER: ANG. DIFF.	ELEVATION
---------	-------	----------------	---	------------------	--------------------	-----------

*Update*

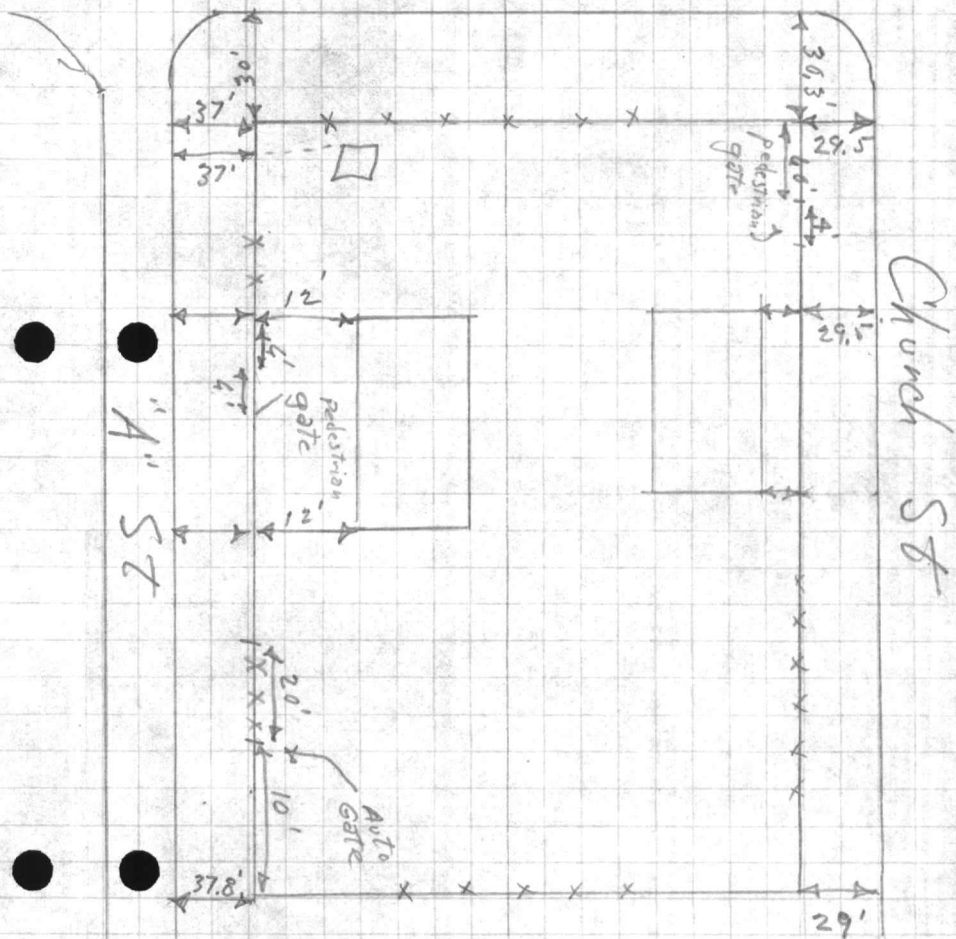



























**VALUABLE**

SUBJECT LOCATION A" C.I.  
WATER LINE "F" ST. TO "G" ST.

RETURN TO  
PUBLIC WORKS  
OFFICE  
CAMP LEJEUNE  
NORTH CAROLINA

8.15 0.85

FIELD PARTY  
DENNIS IN CHARGE  
INSTRUMENT \_\_\_\_\_  
NOTES \_\_\_\_\_  
TAPE READ \_\_\_\_\_  
TAPE OR ROD \_\_\_\_\_  
TAPE OR ROD \_\_\_\_\_  
INSTRUMENT NO. \_\_\_\_\_  
TAPE NO. \_\_\_\_\_

WEATHER  
CLEAR \_\_\_\_\_  
CLOUDY \_\_\_\_\_  
WINDY \_\_\_\_\_  
RAIN \_\_\_\_\_  
FAIR \_\_\_\_\_  
SNOW \_\_\_\_\_  
HOT \_\_\_\_\_  
MODERATE \_\_\_\_\_  
COLD \_\_\_\_\_  
FOG \_\_\_\_\_  
FIGURED BY \_\_\_\_\_  
NOTES CHECKED BY \_\_\_\_\_  
PLOTTED BY \_\_\_\_\_

FILE No. 98-P  
FLDR. No. \_\_\_\_\_  
SHEET 1 of 1  
DATE 10-13-14 1954

Quad. No. \_\_\_\_\_

STATION	DIST.	ANGLE ° ' "	H. I. BEARING	VER. ANG. DIFF.	ELEVATION
---------	-------	----------------	------------------	--------------------	-----------

#474

#460

12' →  
HYD. 4" X 4" X 415'  
VALVE  
POINT A' →  
4" X 4" TEE

"G" ST.

4" C.I.

15' → 40' → 2' → 13' →  
POINT B' →

POINT C' →  
POINT D' →  
33' →

E 4 TH. ST.

"F" ST.

8" X 8" CROSS

4" Valve  
5.5" X 4" Reducer

B.M.	437 2096	16.59	FLOOR BLDG. # T.C. 474
POINT A'	4 X 4' TEE TOP.		
POINT B'	TOP 4" C.I.	7.71	13.25
POINT C'	TOP 4" C.I.	8.14	12.82
POINT D'	TOP 4" C.I.	8.63	12.33
POINT E'	TOP 8" X 8" CROSS	9.80	11.16

Top of Pipe

30

5000

2500

7500

30

2350.00

55

~~146 day~~  
~~21/300~~  
~~21~~  
~~90~~

2280

90

75

200

Bennie

7-3862

**VALUABLE**

RETURN TO  
PUBLIC WORKS  
OFFICE  
CAMP LEJEUNE  
NORTH CAROLINA

SUBJECT

*Bm's proposed.  
Resu. AT water treatment plant.  
Camp Geiger*

FIELD PARTY

*E. Thie* IN CHARGE  
INSTRUMENT  
NOTES  
TAPE READ  
TAPE OR ROD  
TAPE OR ROD  
INSTRUMENT No.  
TAPE No.

WEATHER

CLEAR  
CLOUDY  
WINDY  
RAIN  
FAIR  
SNOW  
HOT  
MODERATE  
COLD  
FOG  
FIGURED BY  
NOTES CHECKED BY  
PLOTTED BY

FILE No. *98-P*


FLDR. No.

SHEET *1 of 1*


DATE *12/12* 19 *53*

Quad. No.

STATION	DIST.	ANGLE ° ' "	+	H. I. BEARING	VER. ANG. DIFF.	ELEVATION	
						21.53	Bm on pine
	3.67	25.20					
				H. 89	20.31		Bm on (P.P.) Transformers on top south pole
	3.90	24.21					
				3.49	20.72		Bm cor wall Bldg #501
	3.90	24.62					
				4.68	19.94		
	4.06	24.00					
				3.59	20.41		Spillo in pp. 7th st. + B st. tie Bm p.p.
					20.41		

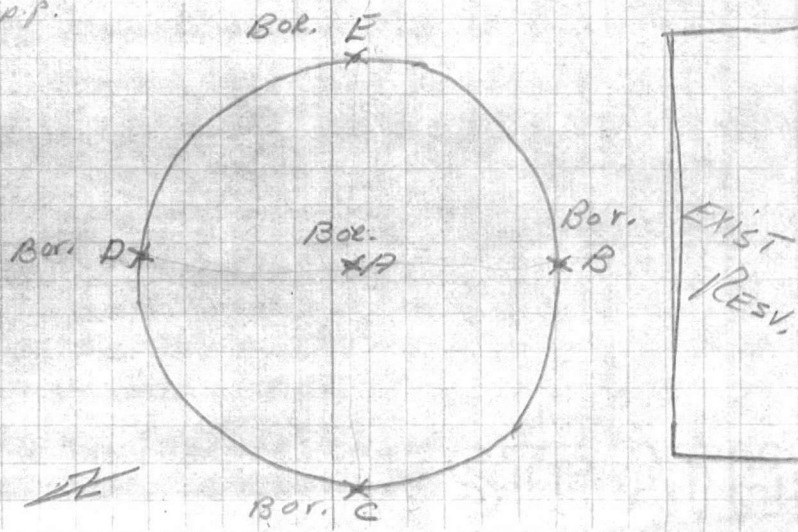

STATION  
DATE  
TIME  
STATION  
DATE  
TIME

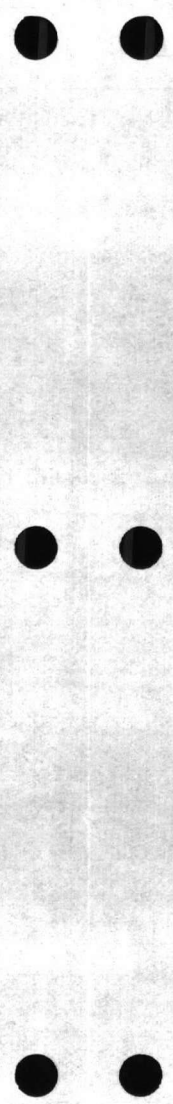

VALUABLE

SUBJECT

Test Borings

RETURN TO  
PUBLIC WORKS  
OFFICE  
CAMP LEJEUNE  
NORTH CAROLINA

Camp Geiger  
water treatment plant  
proposed. Res.

FIELD PARTY

Butler  
IN CHARGE  
INSTRUMENT  
NOTES  
TAPE READ  
TAPE OR ROD  
TAPE OR ROD  
INSTRUMENT No.  
TAPE No.

WEATHER

CLEAR  
CLOUDY  
WINDY  
RAIN  
FAIR  
SNOW  
HOT  
MODERATE  
COLD  
FOG

FILE No.

FLDR. No.

SHEET


DATE

193  
12/12 1953


Quad. No.

STATION	DIST.	ANGLE " "	+	H. I. BEARING	VER: ANG. DIFF.	ELEVATION
---------	-------	--------------	---	------------------	--------------------	-----------

Boring "A" Res. Center.  
ground elev. 19.34

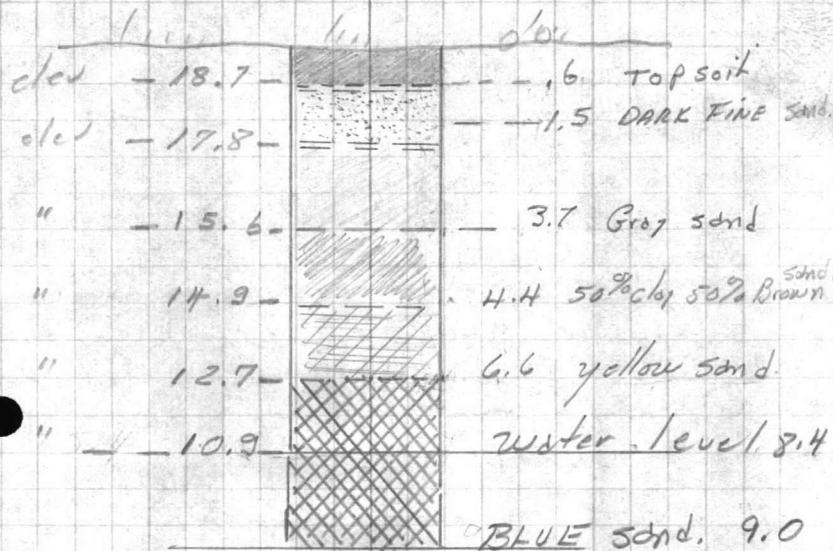

BORING "B" RES. EDGE.  
ground elev 19.54

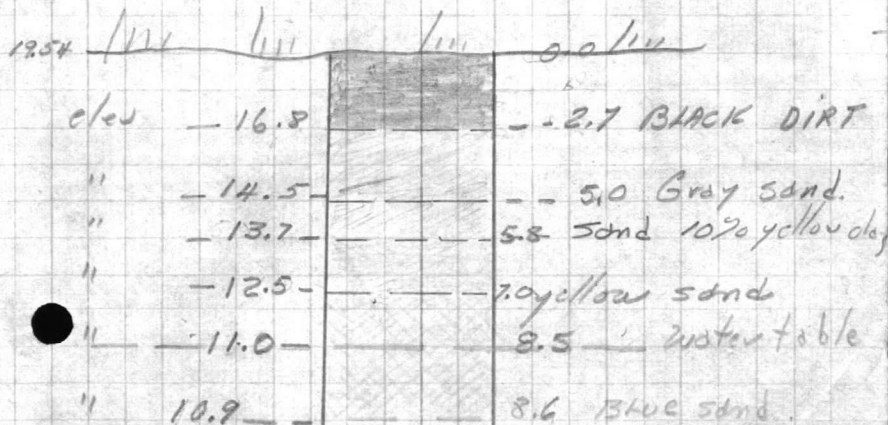



















VALUABLE

SUBJECT Location and Elevation of  
Utilities in vicinity of proposed storm  
sewer - Camp Geiger - North section  
3rd St.

Return To  
 Public Works  
 Office  
 Camp Lejeune  
 North Carolina

## FIELD PARTY

Murphy In Charge  
Cault Instrument  
Murphy Notes  
W. Betts Tape Read  
W. Betts Tape or Rod  
 \_\_\_\_\_ Tape or Rod  
 \_\_\_\_\_ Instrument No.  
 \_\_\_\_\_ Tape No.

## WEATHER

Clear  
 Cloudy  
 Windy  
 Rain  
 Fair

Snow  
 Hot  
 Moderate  
 Cold  
 Fog

FILE No. \_\_\_\_\_  
 Fldr. No. 98-P  
 Sheet 1 of 5  
 Date 2-18 1952

Figured By \_\_\_\_\_  
 Notes Checked By \_\_\_\_\_  
 Plotted By \_\_\_\_\_  
 Quad. No. \_\_\_\_\_

Station	Dist.	Angle " "	+	H. I. Bearing	Ver: Ang. Diff.	Elevation	
BM						19 9	E 3rd St. and "B" St
						4 74 24 04	
0700					X		Base line run on North edge of pavement of 3rd St. Sta. 0700 = prolongation of East side Bldg. #213 at intersection of pavement = 30.0'
+07					9 18	14 86	23.0' left 6" CI waterline (parallels 3rd St.)
+07					8 62	15 32	24.8' Right 6" CI line parallels "B" St
+07					8 82	15 12	39.2' Right 6" CI line parallels 3rd St
+40					5 00	19 04	40' Right power pole
+44					9 37	14 47	23' left 6" CI line parallels 3rd St
+59							8.6' left Fire hydrant
+59					8 90	15 14	16.1' left 6" CI line to Fire hyd.
3+19					7 01	17 03	16' left 6" CI line crossing 3rd St
+28.5					8 25	15 79	35' Right 6" CI line (above line on right side of rd.)
+58					5 80	18 24	40' Right power pole
FP							



VALUABLE

SUBJECT \_\_\_\_\_  
 \_\_\_\_\_  
 \_\_\_\_\_  
 \_\_\_\_\_

Return To  
 Public Works  
 Office  
 Camp Lejeune  
 North Carolina

3752

FIELD PARTY

\_\_\_\_\_ In Charge  
 \_\_\_\_\_ Instrument  
 \_\_\_\_\_ Notes  
 \_\_\_\_\_ Tape Read  
 \_\_\_\_\_ Tape or Rod  
 \_\_\_\_\_ Tape or Rod  
 \_\_\_\_\_ Instrument No.  
 \_\_\_\_\_ Tape No.

WEATHER

Clear  
 Cloudy  
 Windy  
 Rain  
 Fair

Snow  
 Hot  
 Moderate  
 Cold  
 Fog

FILE No. \_\_\_\_\_

Fldr. No. \_\_\_\_\_

Sheet 2025

Figured By \_\_\_\_\_

Notes Checked By \_\_\_\_\_

Plotted By \_\_\_\_\_

Date 2-18 1952

Quad. No. \_\_\_\_\_

Station	Dist.	Angle "	+	H. I. Bearing	Ver. Ang. Diff.	Elevation	
				24 04			
77						542 18 42	
				4 53	23 15		
3+52				854	14 41		16' left 6" CI line parallels "C" St.
3+52				789	15 26		26' left 6" CI line parallels 3rd St.
3+52				881	14 34		37' Right CI line parallels "C" St
+92 ✓				801	15 14		26' left CI line parallels 3rd St.
4+15				450	18 45		5' left power pole
+15				495	18 20		25' left power pole
+15				460	18 55		22' Right - power pole
+15				545	17 70		38' Right. power pole
4+29							10' left fire hyd.
+29				842	14 53		16' left 6" CI line to fire hyd
+31				476	18 39		25' left power pole
































VALUABLE

SUBJECT \_\_\_\_\_

Return To  
Public Works  
Office  
Camp Lejeune  
North Carolina

FIELD PARTY

\_\_\_\_ In Charge  
\_\_\_\_ Instrument  
\_\_\_\_ Notes  
\_\_\_\_ Tape Read  
\_\_\_\_ Tape or Rod  
\_\_\_\_ Tape or Rod  
\_\_\_\_ Instrument No.  
\_\_\_\_ Tape No.

WEATHER

Clear \_\_\_\_\_  
Cloudy \_\_\_\_\_  
Windy \_\_\_\_\_  
Rain \_\_\_\_\_  
Fair \_\_\_\_\_  
Snow \_\_\_\_\_  
Hot \_\_\_\_\_  
Moderate \_\_\_\_\_  
Cold \_\_\_\_\_  
Fog \_\_\_\_\_  
Figured By \_\_\_\_\_  
Notes Checked By \_\_\_\_\_  
Plotted By \_\_\_\_\_

FILE No. \_\_\_\_\_

Fldr. No. \_\_\_\_\_

Sheet 3095

Date 2-18 1952

Quad. No. \_\_\_\_\_

Station	Dist.	° Angle "	+	H. I. Bearing	Ver: Ang. Diff.	Elevation	
				23 15			
5+68				5 25	17 90		26' left - Guy wire
+88				5 22	17 93		26' left - power pole
6+70				6 26			17' left - Guy wire
6+70				5 05			26' left power pole
+98							10' left Fire hydr.
+98				9 53	13 62		14' left 6" CI line to fire hydr.
				5 97	17 18	(17.1)	2 3rd & "D" Sts.













































VALUABLE

SUBJECT \_\_\_\_\_  
 \_\_\_\_\_  
 \_\_\_\_\_  
 \_\_\_\_\_

Return To  
 Public Works  
 Office  
 Camp Lejeune  
 North Carolina

FIELD PARTY

\_\_\_\_\_ In Charge  
 \_\_\_\_\_ Instrument  
 \_\_\_\_\_ Notes  
 \_\_\_\_\_ Tape Read  
 \_\_\_\_\_ Tape or Rod  
 \_\_\_\_\_ Tape or Rod  
 \_\_\_\_\_ Instrument No.  
 \_\_\_\_\_ Tape No.

WEATHER

Clear  
 Cloudy  
 Windy  
 Rain  
 Fair

Snow  
 Hot  
 Moderate  
 Cold  
 Fog

FILE No. \_\_\_\_\_  
 Fldr. No. \_\_\_\_\_  
 Sheet 5085  
 Date 2-19 1952

Figured By \_\_\_\_\_  
 Notes Checked By \_\_\_\_\_  
 Plotted By \_\_\_\_\_  
 Quad. No. \_\_\_\_\_

Station	Dist.	° Angle "	+	H. I. Bearing	Ver: Ang. Diff.	Elevation	
				20 34			
10+45					5 00 15 34		58' Right Fire Hyd
+56					4 60 15 74		58' Right Water valve
+59					8 29 12 05		16' left 6" CI line-parallel's E" St
+59					8 50 11 84		38' Right 6" CI line-parallel's E" St.
+61					4 14 16 18		23' left power pole
+61					4 49 15 85		41' Right -power pole
11+46					9 41 10 73		15' left - 10" TC line
					5 57 14 77 (148)		13M 3rd. 4" Sts.









































**VALUABLE**

SUBJECT LOCATION WATER LINE  
WATER TREATING PLANT  
CAMP GEIGER

RETURN TO  
PUBLIC WORKS  
OFFICE  
CAMP LEJEUNE  
NORTH CAROLINA

FIELD PARTY

DENNIS IN CHARGE

INSTRUMENT

NOTES

TAPE READ

TAPE OR ROD

TAPE OR ROD

INSTRUMENT NO.

TAPE NO.

WEATHER

CLEAR

CLOUDY

WINDY

RAIN

FAIR

SNOW

HOT

MODERATE

COLD

FOG

FILE No. 98-P

FLDR. No. \_\_\_\_\_

SHEET 1021

DATE 4.21 1954

FIGURED BY \_\_\_\_\_

NOTES CHECKED BY \_\_\_\_\_

PLOTTED BY \_\_\_\_\_

Quad. No. \_\_\_\_\_

STATION	DIST.	ANGLE ° ' "	+	H. I. BEARING	VER: ANG. DIFF.	ELEVATION
---------	-------	----------------	---	------------------	--------------------	-----------

2 CHURCH ST.

WATER TREATING  
BLDG.

508

10.8'  
2" C.I.

14.4'

2" C.I.

2" C.I.

2" C.I.

9.5'

2'

2" C.I.

























**VALUABLE**

SUBJECT ELEV. WELL'S  
CAMP GEIGER AREA

RETURN TO  
PUBLIC WORKS  
OFFICE  
CAMP LEJEUNE  
NORTH CAROLINA


FIELD PARTY  
DENNIS IN CHARGE  
\_\_\_\_\_  
INSTRUMENT  
\_\_\_\_\_  
NOTES  
\_\_\_\_\_  
TAPE READ  
\_\_\_\_\_  
TAPE OR ROD  
\_\_\_\_\_  
TAPE OR ROD  
\_\_\_\_\_  
INSTRUMENT No. \_\_\_\_\_  
TAPE No. \_\_\_\_\_

WEATHER  
CLEAR \_\_\_\_\_  
CLOUDY \_\_\_\_\_  
WINDY \_\_\_\_\_  
RAIN \_\_\_\_\_  
FAIR \_\_\_\_\_  
SNOW \_\_\_\_\_  
HOT \_\_\_\_\_  
MODERATE \_\_\_\_\_  
COLD \_\_\_\_\_  
FOG \_\_\_\_\_  
FIGURED BY \_\_\_\_\_  
NOTES CHECKED BY \_\_\_\_\_  
PLOTTED BY \_\_\_\_\_

FILE No. 98-P  
FLDR. No. \_\_\_\_\_  
SHEET 1 of 1  
DATE 12-18-57

Quad. No. \_\_\_\_\_

STATION	DIST.	ANGLE " "	+	H. I. BEARING	VER: ANG. DIFF.	ELEVATION	
B.m.			2 92	38 65	✓	35 73	NAIL IN 18" PINE 200' EAST WELL # "L"
						2 68 35.97	✓ FL. ELEV. WELL # "L" = T.C. - 1000
B.m.			4 21	28.88	✓	24 67	SPIKE IN P.D. # ND-19
						5 00 23 88	✓ 14# FLOOR WELL # "J" T.C. 509
B.m.			4 73	37 76	✓	33 03	SPIKE IN 3 <sup>rd</sup> P.D. # NORTH WELL "M" ND-39
						4 01 33 75	✓ FLOOR WELL # "M" T.C. 1001
B.m.			2 43	24 20	✓	21 77	SPIKE IN P.D. ND-11
						3 67 20 53	✓ FLOOR WELL # "I" T.C. 202 ✓
B.m.			1 40	21 37	✓	19 97	MON. # 313
						- 1 39 19.98	✓ FLOOR - T.C. - 200 HOSTESS HOUSE

Post  
12-23-57  











**VALUABLE**

SUBJECT A. Elev Well # 604

Camp Geiger

RETURN TO  
PUBLIC WORKS  
OFFICE  
CAMP LEJEUNE  
NORTH CAROLINA

**FIELD PARTY**

\_\_\_\_\_  
IN CHARGE  
\_\_\_\_\_  
INSTRUMENT  
\_\_\_\_\_  
NOTES  
\_\_\_\_\_  
TAPE READ  
\_\_\_\_\_  
TAPE OR ROD  
\_\_\_\_\_  
TAPE OR ROD  
\_\_\_\_\_  
INSTRUMENT NO.  
\_\_\_\_\_  
TAPE NO.

**WEATHER**

CLEAR \_\_\_\_\_  
CLOUDY \_\_\_\_\_  
WINDY \_\_\_\_\_  
RAIN \_\_\_\_\_  
FAIR \_\_\_\_\_  
SNOW \_\_\_\_\_  
HOT \_\_\_\_\_  
MODERATE \_\_\_\_\_  
COLD \_\_\_\_\_  
FOG \_\_\_\_\_

FILE No. \_\_\_\_\_  
FLDR. No. \_\_\_\_\_  
SHEET 104  
DATE 12.19.57

FIGURED BY \_\_\_\_\_  
NOTES CHECKED BY \_\_\_\_\_  
PLOTTED BY \_\_\_\_\_  
Quad. No. \_\_\_\_\_

STATION	DIST.	ANGLE ° ' "	+	H. I. BEARING	VER: ANG. DIFF.	ELEVATION	
B-m.			4 75	29 42	✓	24 67	SPIKE IN P.D. ND-19
T.P.			3 28	30.70	✓	2 00 27 42	
T.P.			4 72	33.02	✓	2.40 28 30	
			3 57	33.09	✓	3.50 29.52	FLOOR WELL "K" # 604
T.P.			2 86	31.06	✓	4.89 28 20	
T.P.			2 11	29 52	✓	3 65 27.41	
					✓	4 84 24 68	SAME AS ABOVE




























**VALUABLE**

SUBJECT ELEC. WELL # Bldg.  
# 201  
Camp Geiger

RETURN TO  
 PUBLIC WORKS  
 OFFICE  
 CAMP LEJEUNE  
 NORTH CAROLINA

**FIELD PARTY**

\_\_\_\_\_  
 IN CHARGE  
 \_\_\_\_\_  
 INSTRUMENT  
 \_\_\_\_\_  
 NOTES  
 \_\_\_\_\_  
 TAPE READ  
 \_\_\_\_\_  
 TAPE OR ROD  
 \_\_\_\_\_  
 TAPE OR ROD  
 \_\_\_\_\_  
 INSTRUMENT NO.  
 \_\_\_\_\_  
 TAPE NO. \_\_\_\_\_

**WEATHER**

CLEAR \_\_\_\_\_  
 CLOUDY \_\_\_\_\_  
 WINDY \_\_\_\_\_  
 RAIN \_\_\_\_\_  
 FAIR \_\_\_\_\_  
 SNOW \_\_\_\_\_  
 HOT \_\_\_\_\_  
 MODERATE \_\_\_\_\_  
 COLD \_\_\_\_\_  
 FOG \_\_\_\_\_  
 FIGURED BY \_\_\_\_\_  
 NOTES CHECKED BY \_\_\_\_\_  
 PLOTTED BY \_\_\_\_\_

FILE No. \_\_\_\_\_  
 FLDR. No. \_\_\_\_\_  
 SHEET 1 of 1  
 DATE 12-19-57

Quad. No. \_\_\_\_\_

STATION	DIST.	ANGLE ° ' "	+	H. I. BEARING	VER: ANG. DIFF.	ELEVATION	
B.M.			298	24 75	✓	21.77	SPIKE IN PP ND-11 NEAR MAIN INTERANCE TO CAMP GEIGER
T.P.			212	19 78	✓	7.09 17.66	
T.P.			589	21 26	✓	4.41 15.37	FLOOR T.C. 201 "H"
			143	21 24	✓	1.45 <sup>19</sup> 20 81	
T.P.			109	20 23	✓	5.05 14.19	
T.P.			690	24 79	✓	2.34 17.89	SPIKE IN PP ND-11
B.M.					✓	3.05 21.74	









**VALUABLE**

RETURN TO  
PUBLIC WORKS  
OFFICE  
CAMP LEJEUNE  
NORTH CAROLINA

SUBJECT LINE 8 T.V.P.D.  
PROPOSE SIDE WALK  
EAST SIDE "A" ST.  
1ST. ST TO 11TH. ST.  
CAMP GEIGER

FIELD PARTY  
DENNIS IN CHARGE  
\_\_\_\_ INSTRUMENT  
\_\_\_\_ NOTES  
\_\_\_\_ TAPE READ  
\_\_\_\_ TAPE OR ROD  
\_\_\_\_ TAPE OR ROD  
\_\_\_\_ INSTRUMENT No.  
\_\_\_\_ TAPE No.

WEATHER  
CLEAR \_\_\_\_\_  
CLOUDY \_\_\_\_\_  
WINDY \_\_\_\_\_  
RAIN \_\_\_\_\_  
FAIR \_\_\_\_\_  
SNOW \_\_\_\_\_  
HOT \_\_\_\_\_  
MODERATE \_\_\_\_\_  
COLD \_\_\_\_\_  
FOG \_\_\_\_\_  
FIGURED BY \_\_\_\_\_  
NOTES CHECKED BY \_\_\_\_\_  
PLOTTED BY \_\_\_\_\_

FILE No. 98P  
FLDR. No. \_\_\_\_\_  
SHEET 10 of 13  
DATE 8-22-56

Quad. No. \_\_\_\_\_

STATION	DIST.	ANGLE ° ' "	+	H. I. BEARING	VER: ANG. DIFF.	ELEVATION
4+69	<u>57</u>	22'	LT.	POINT RAD.		
4+51	<u>14</u>	24.70'	LT.	POINT RAD.		
4+35	<u>13</u>			RAD. ON E		
4+22	<u>00</u>	3.15'	RT.	POINT RAD.		

2+36 57 13.40' LT. END 18" R.C.P.

2+33 89 Edge WALK

2+27 89 Edge WALK 6' CONC. WALK

2+24 92 13.40' LT. END 18" R.C.P.

0+44 60 3' RT. POINT RAD.

0+27 45 RAD. ON E

0+25 22 16.50' LT. END 18" C.M. PIPE 44' RT. END

0+11 00 27' LT. POINT RAD.

0+00 00 1<sup>ST</sup> ST. 14' Nt. of "A" ST.

⊕

1 ST.

ST.

18' C.M. O

14' ←

18" R.C.P.

"A" ST.








