

**VALUABLE**

SUBJECT

STAKE OUT FLORENCE

Rd.


RETURN TO  
PUBLIC WORKS  
OFFICE  
CAMP LEJEUNE  
NORTH CAROLINA

FIELD PARTY  
DENNIS IN CHARGE  
INSTRUMENT \_\_\_\_\_  
NOTES \_\_\_\_\_  
TAPE READ \_\_\_\_\_  
TAPE OR ROD \_\_\_\_\_  
TAPE OR ROD \_\_\_\_\_  
INSTRUMENT No. \_\_\_\_\_  
TAPE No. \_\_\_\_\_

WEATHER  
CLEAR \_\_\_\_\_  
CLOUDY \_\_\_\_\_  
WINDY \_\_\_\_\_  
RAIN \_\_\_\_\_  
FAIR \_\_\_\_\_  
SNOW \_\_\_\_\_  
HOT \_\_\_\_\_  
MODERATE \_\_\_\_\_  
COLD \_\_\_\_\_  
FOG \_\_\_\_\_  
FIGURED BY \_\_\_\_\_  
NOTES CHECKED BY \_\_\_\_\_  
PLOTTED BY \_\_\_\_\_

FILE No. 99-V  
FLDR. No. \_\_\_\_\_  
SHEET 108  
DATE 12.13.55

Quad. No. \_\_\_\_\_

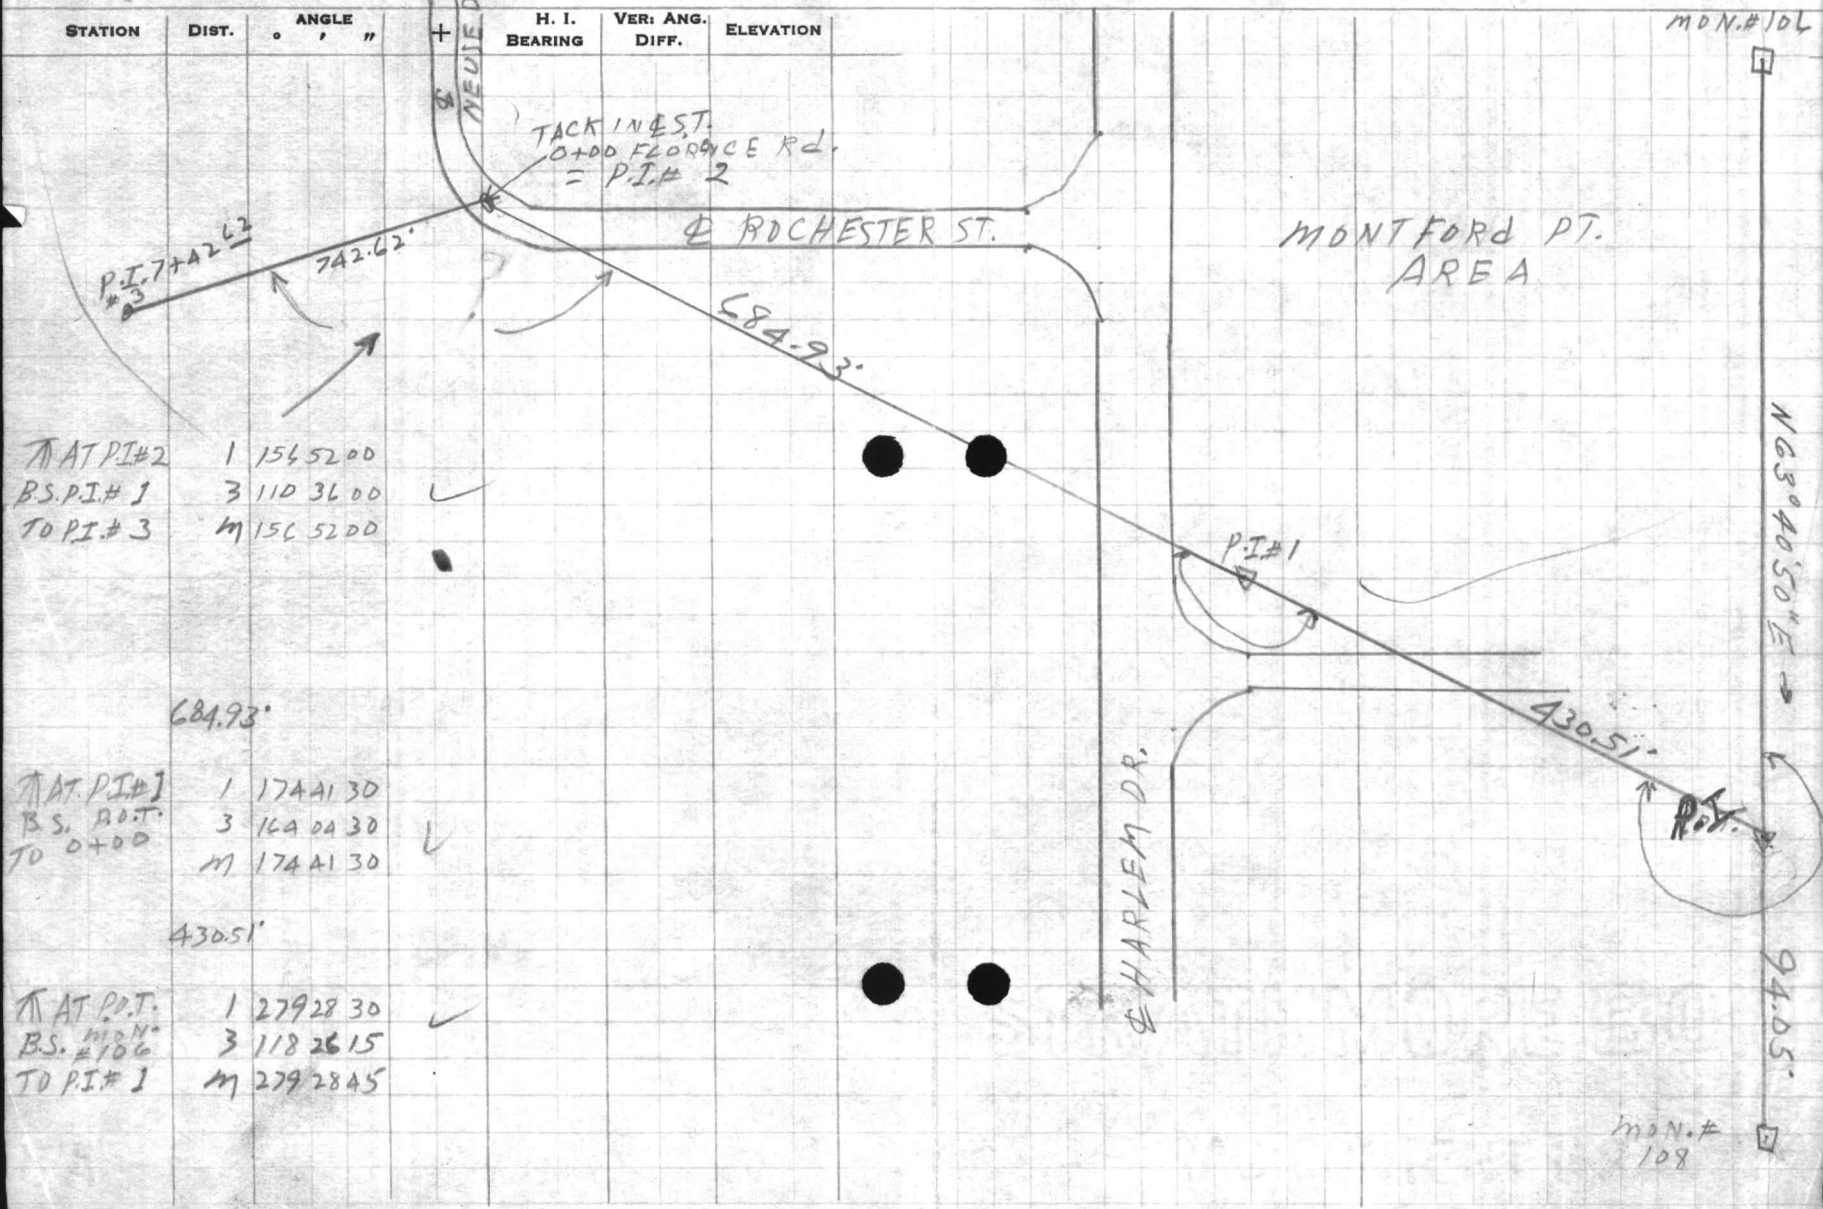

STATION	DIST.	ANGLE	H. I.	VER. ANG.	ELEVATION
		' "	BEARING	DIFF.	
AT P.I.#2	1	156 52 00			
B.S. P.I.# 1	3	110 36 00			
TO P.I.# 3	M	156 52 00			
684.93°					
AT P.I.#1	1	174 41 30			
B.S. P.O.T.	3	164 04 30			
TO 0+00	M	174 41 30			
430.51'					
AT P.O.T.	1	279 28 30			
B.S. #106	3	118 26 15			
TO P.I.# 1	M	279 28 45			

MON.#106

N 63° 40' 50" E  
94.05°

MON.#  
108









**VALUABLE**

SUBJECT \_\_\_\_\_

RETURN TO  
PUBLIC WORKS  
OFFICE  
CAMP LEJEUNE  
NORTH CAROLINA

**FIELD PARTY**

\_\_\_\_\_  
IN CHARGE  
\_\_\_\_\_  
INSTRUMENT  
\_\_\_\_\_  
NOTES  
\_\_\_\_\_  
TAPE READ  
\_\_\_\_\_  
TAPE OR ROD  
\_\_\_\_\_  
TAPE OR ROD  
\_\_\_\_\_  
STRUMENT No.  
\_\_\_\_\_  
TAPE No.

**WEATHER**

CLEAR \_\_\_\_\_  
CLOUDY \_\_\_\_\_  
WINDY \_\_\_\_\_  
RAIN \_\_\_\_\_  
FAIR \_\_\_\_\_  
SNOW \_\_\_\_\_  
HOT \_\_\_\_\_  
MODERATE \_\_\_\_\_  
COLD \_\_\_\_\_  
FOG \_\_\_\_\_  
FIGURED BY \_\_\_\_\_  
NOTES CHECKED BY \_\_\_\_\_  
PLOTTED BY \_\_\_\_\_

FILE No. \_\_\_\_\_


FLDR. No. \_\_\_\_\_

SHEET 1A of

DATE \_\_\_\_\_ 19\_\_

Quad. No. \_\_\_\_\_

STATION	DIST.	ANGLE	H. I. BEARING	VER. ANG. DIFF.	ELEVATION
<p>AT P.O.T. 0+34.08 = P.I. of Neuse + Rochester Rds. F.S. P.I. 7+42.62 TO NEUSE DR.</p>					
	①	95 17 45			
	②	190 35 30			
	③	95 17 45			
<p>AT P.O.T. 0+34.08 = P.I. F.S. NEUSE</p>					
					29.90' EDGE NEUSE DR.
					59.60 9.60' LT. PT. RAD. FLORENCE RD.
					77.60' NEUSE DR.
<p>AT P.O.T. 0+34.08 = P.I. B.S. ROCHESTER DR. TO P.I. 7+42.62</p>					
	①	161 04 45			
	②	322 09 30			
	③	161 04 45			
<p>AT P.O.T. 0+34.08 F.S. ROCHESTER DR.</p>					
					29.15' EDGE ROCHESTER DR.
					54.00' 8.20' RT. PT. RAD. FLORENCE Rd.
					80.40' ROCHESTER DR.

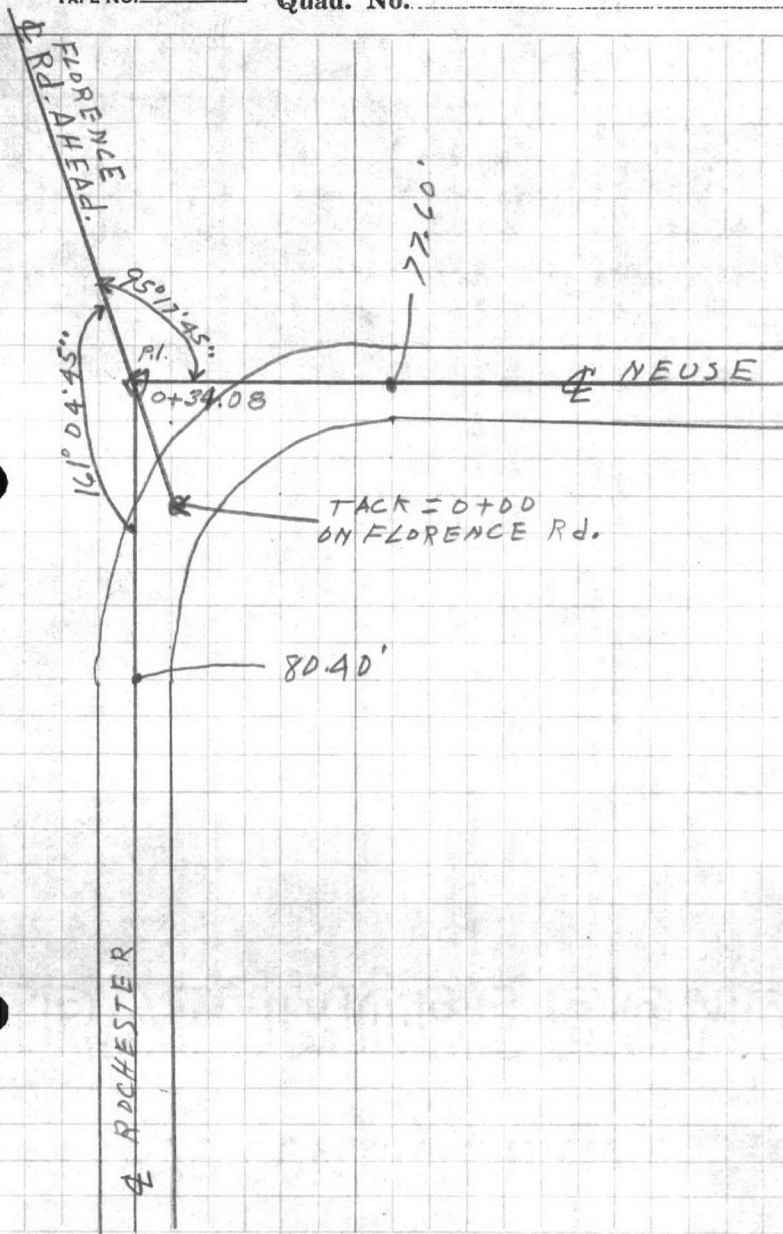


































**VALUABLE**

SUBJECT \_\_\_\_\_

RETURN TO  
PUBLIC WORKS  
OFFICE  
CAMP LEJEUNE  
NORTH CAROLINA

9.6  
11.6  
13.9  
13.9  
13.9  
13.9

**FIELD PARTY**

\_\_\_\_\_  
IN CHARGE  
\_\_\_\_\_  
INSTRUMENT  
\_\_\_\_\_  
NOTES  
\_\_\_\_\_  
TAPE READ  
\_\_\_\_\_  
TAPE OR ROD  
\_\_\_\_\_  
TAPE OR ROD  
\_\_\_\_\_  
INSTRUMENT NO.  
\_\_\_\_\_  
TAPE NO.

**WEATHER**

CLEAR  
CLOUDY  
WINDY  
RAIN  
FAIR  
SNOW  
HOT  
MODERATE  
COLD  
FOG  
FIGURED BY \_\_\_\_\_  
NOTES CHECKED BY \_\_\_\_\_  
PLOTTED BY \_\_\_\_\_

FILE No. \_\_\_\_\_

FLDR. No. \_\_\_\_\_

SHEET 2 of

DATE 12-13 1955

Quad. No. \_\_\_\_\_

STATION	DIST.	ANGLE	"	+	H. I. BEARING	VER. ANG. DIFF.	ELEVATION
---------	-------	-------	---	---	------------------	--------------------	-----------

AT P.I. 3 (1) 142 14 45 ✓  
BS. P.I. # 2 (2) 66 43 15  
TD P.I. # 4 (3) 142 14 25  
6+66<sup>40</sup> 11.60' RT. 11.60' H. COR. BRIDGE

4+78<sup>59</sup> 13.88' RT. COR. BRIDGE 9.83' LT. COR. BRIDGE

4+00 15' RT. E.R.D. 21' RT. W.L. 11' LT. E.R.D. 21' LT. W.L.

3+59 16' RT. GATE POST. 11.20' LT. GATE POST.

3+54<sup>20</sup> 10.90' LT. COR. # 2 GUARD HOUSE

3+50 10.90' LT. COR. # 1 GUARD HOUSE

3+38<sup>00</sup> 24' LT. P.P. # 1 MD 24

3+00 13' RT. E.R.D. 19' RT. W.L. 11' LT. E.R.D. 24' LT. W.L.


2+00 10' RT. E.R.D. 17' RT. W.L. 13' LT. E.R.D. 23' LT. W.L.

1+44 20.50' RT. P.P. # 1 MD 23

1+0 13' RT. E.R.D. 33' RT. W.L. 13' LT. E.R.D. 23' LT. W.L.

0+61 20' RT. E.R.D. 46' RT. COR. woods 14' LT. E.R.D. 26' LT. W.L.

0+34<sup>08</sup> P.O.T.  
0+14<sup>20</sup> E. ST.

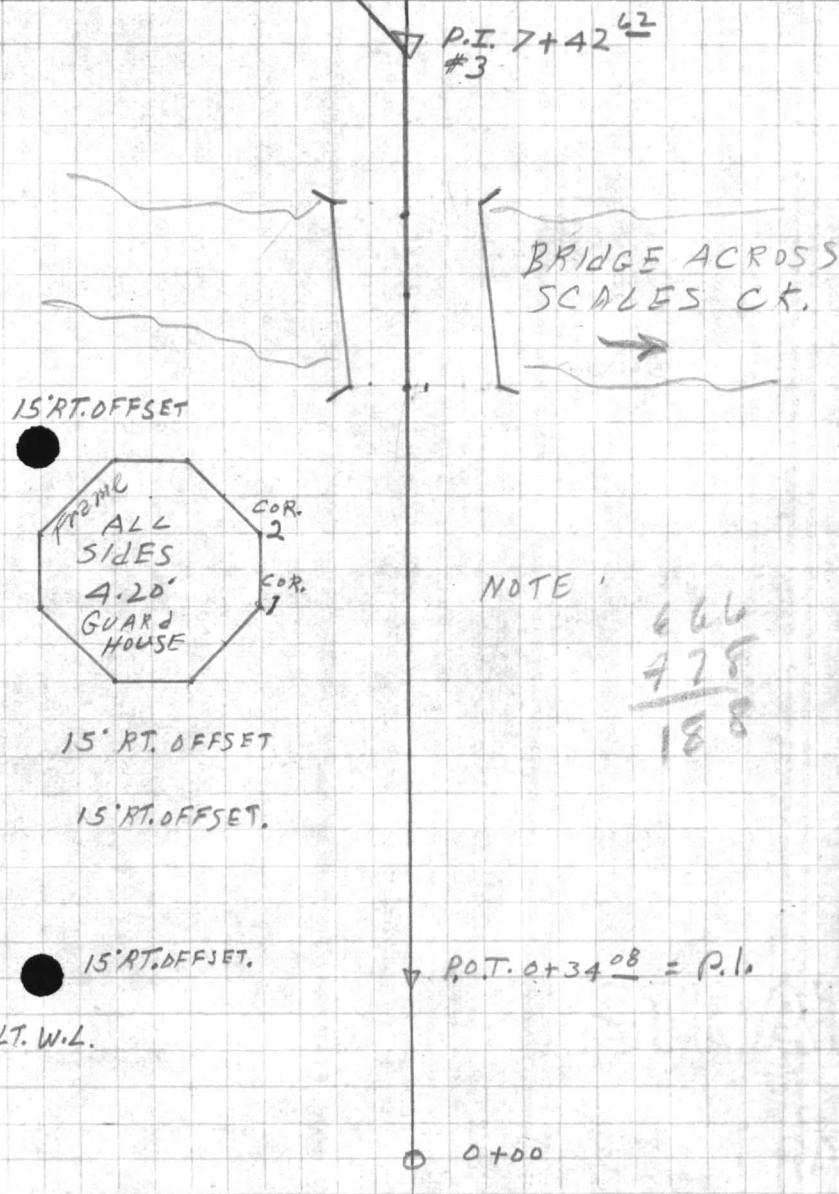

0+00


























**VALUABLE** SUBJECT \_\_\_\_\_

RETURN TO  
PUBLIC WORKS  
OFFICE  
CAMP LEJEUNE  
NORTH CAROLINA

**FIELD PARTY**

\_\_\_\_\_  
IN CHARGE  
\_\_\_\_\_  
INSTRUMENT  
\_\_\_\_\_  
NOTES  
\_\_\_\_\_  
TAPE READ  
\_\_\_\_\_  
TAPE OR ROD  
\_\_\_\_\_  
TAPE OR ROD  
\_\_\_\_\_  
INSTRUMENT No.  
\_\_\_\_\_  
TAPE No.

**WEATHER**

CLEAR  
CLOUDY  
WINDY  
RAIN  
FAIR

SNOW  
HOT  
MODERATE  
COLD  
FOG

FILE No. \_\_\_\_\_

FLDR. No. \_\_\_\_\_


SHEET 3 of

FIGURED BY \_\_\_\_\_ NOTES CHECKED BY \_\_\_\_\_

PLOTTED BY \_\_\_\_\_ DATE \_\_\_\_\_ 19\_\_


Quad. No. \_\_\_\_\_

STATION	DIST.	ANGLE " "	+	H. I. BEARING	VER. ANG. DIFF.	ELEVATION
15+0	12' RT. E. Rd.			11' LT. E. Rd.	12' LT. W.L.	12' LT. OFFSET
14+43	20' RT.			COR. WOODS.		
14+00	12' RT. E. Rd.			13' RT. W.L.	11' LT. E. Rd. 13' LT. W.L.	13' RT. OFFSET.
13+00	11' RT. E. Rd.			13' RT. W.L.	12' LT. E. Rd. 15' LT. W.L.	12' RT. OFFSET.
12+0	12' RT. E. Rd.			13' RT. W.L.	13' LT. E. Rd. 15' LT. W.L.	12' RT. OFFSET.
11+00	12' RT. E. Rd.			13' RT. W.L.	12' LT. E. Rd. 14' LT. W.L.	12' RT. OFFSET
10+84	122' LT.			FIRE H.X.D. 31' LT. WATER VALVE		12' RT. OFFSET
10+20	21' RT.			END WOOD COVERT.		
10+20	15' RT.			COR. WOODS		
10+10	13' RT. E. Rd.			12' LT. E. Rd.		2 CULVERT
9+98					31' LT. WOOD CULVERT	
9+0	17' RT. E. Rd.			9' LT. E. Rd.		25' RT. OFFSET
P.T. 8+16 <sup>26</sup>	18 5247					
8+00	16 5224			17' RT. E. Rd.	29' RT. W.L. 13' LT. E. Rd. 23' LT. W.L.	29' RT. OFFSET
7+75	13 4724					29' RT. OFFSET
7+50	10 4224					29' RT. OFFSET
7+25	7 3724					25' RT. OFFSET
7+00	4 3224			13' RT. E. Rd.	29' RT. W.L. 13' LT. E. Rd. 24' LT. W.L.	23' RT. OFFSET.
6+75	1 2724					
P.C. 6+63 <sup>18</sup>	0 00.00					

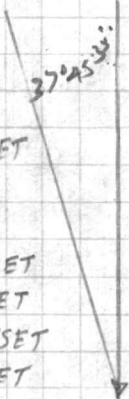

P.I. 7+42<sup>42</sup>  
3

Δ - 37° 45' 35" Lt.  
T - 79.43'  
D - 24.52'  
R - 232.27'  
E - 13.20'  
L - 153.07'

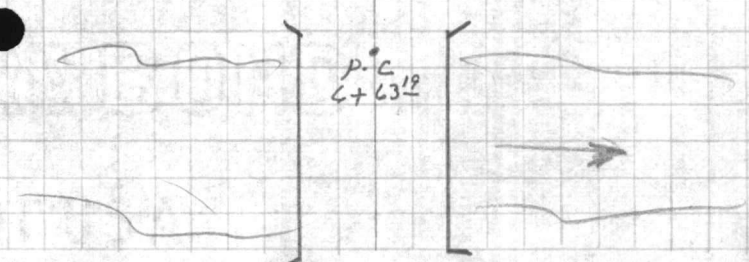





**VALUABLE**

SUBJECT \_\_\_\_\_

RETURN TO  
PUBLIC WORKS  
OFFICE  
CAMP LEJEUNE  
NORTH CAROLINA

**FIELD PARTY**

\_\_\_\_\_  
IN CHARGE  
\_\_\_\_\_  
INSTRUMENT  
\_\_\_\_\_  
NOTES  
\_\_\_\_\_  
TAPE READ  
\_\_\_\_\_  
TAPE OR ROD  
\_\_\_\_\_  
TAPE OR ROD  
\_\_\_\_\_  
INSTRUMENT NO.  
\_\_\_\_\_  
TAPE NO.

**WEATHER**

CLEAR  
CLOUDY  
WINDY  
RAIN  
FAIR  
SNOW  
HOT  
MODERATE  
COLD  
FOG

FILE No. \_\_\_\_\_

FLDR. No. \_\_\_\_\_

SHEET 3A

FIGURED BY \_\_\_\_\_

NOTES CHECKED BY \_\_\_\_\_

PLOTTED BY \_\_\_\_\_ DATE \_\_\_\_\_ 19\_\_

Quad. No. \_\_\_\_\_

STATION	DIST.	ANGLE	"	+	H. I. BEARING	VER: ANG. DIFF.	ELEVATION
STA. 13+0	1	266	57	30			
P.I. 18+15.9A	2	173	55	00			
TO COR. 'A'	1	266	57	30			
STA. 13+0							
STA. 13+0							
STA. 12+92.00							

P.I. 18+15.9A

EXISTING SEWER M.H.

89°58'

13+39.50

30.02'

'B'

99.36'

21.58'

SEWER LIFT STA. E-23

26.24'

STA. 13+00

10.18'

97.28'

19.78'

'A'

E 12° EARTH ROAD TO LIFT STA. E-23

STA. 12+92.00

STA. 13+0 1 266 57 30  
P.I. 18+15.9A 2 173 55 00  
TO COR. 'A' 1 266 57 30

STA. 13+0  
P.I. 18+15.9A  
TO COR. 'B' 1 282 13 45  
2 204 27 30  
1 282 13 45



**VALUABLE**

SUBJECT \_\_\_\_\_  
 \_\_\_\_\_  
 \_\_\_\_\_  
 RETURN TO  
 PUBLIC WORKS  
 OFFICE  
 CAMP LEJEUNE  
 NORTH CAROLINA

**FIELD PARTY**

\_\_\_\_\_  
 IN CHARGE  
 \_\_\_\_\_  
 INSTRUMENT  
 \_\_\_\_\_  
 NOTES  
 \_\_\_\_\_  
 TAPE READ  
 \_\_\_\_\_  
 TAPE OR ROD  
 \_\_\_\_\_  
 TAPE OR ROD  
 \_\_\_\_\_  
 INSTRUMENT NO.  
 \_\_\_\_\_  
 TAPE NO. \_\_\_\_\_


**WEATHER**

CLEAR \_\_\_\_\_  
 CLOUDY \_\_\_\_\_  
 WINDY \_\_\_\_\_  
 RAIN \_\_\_\_\_  
 FAIR \_\_\_\_\_  
 SNOW \_\_\_\_\_  
 HOT \_\_\_\_\_  
 MODERATE \_\_\_\_\_  
 COLD \_\_\_\_\_  
 FOG \_\_\_\_\_  
 FIGURED BY \_\_\_\_\_  
 NOTES CHECKED BY \_\_\_\_\_  
 PLOTTED BY \_\_\_\_\_

FILE No. \_\_\_\_\_  
 FLDR. No. \_\_\_\_\_  
 SHEET **3 "B" 4**  
 DATE \_\_\_\_\_ 19\_\_

Quad. No. \_\_\_\_\_

STATION	DIST.	ANGLE " "	+	H. I. BEARING	VER. ANG. DIFF.	ELEVATION
---------	-------	--------------	---	------------------	--------------------	-----------

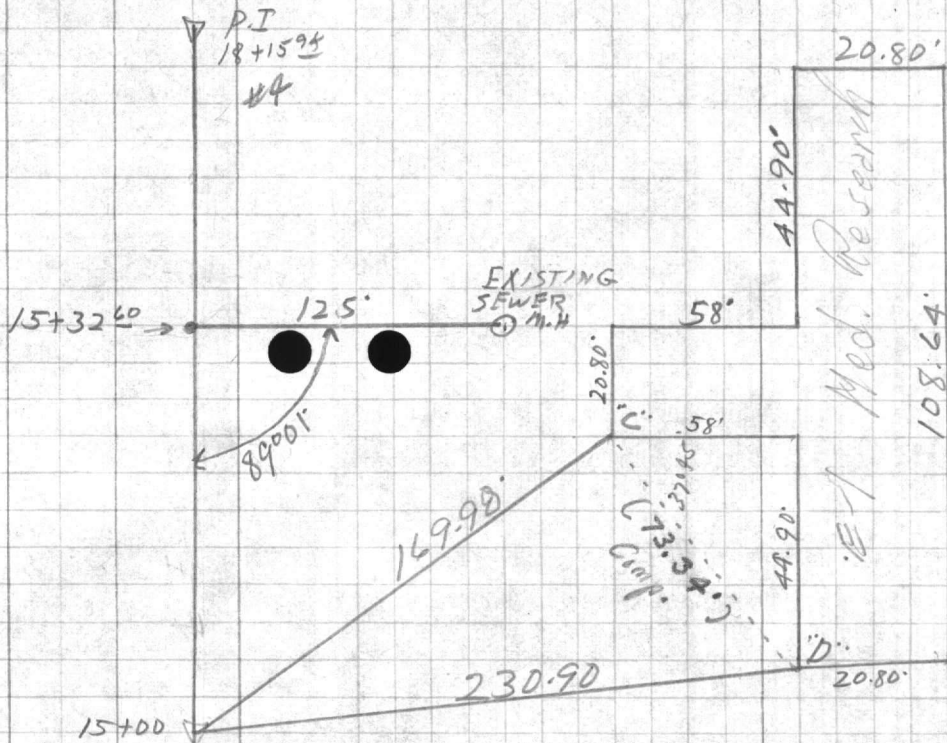

STA.  
 AT 15+0 1 88 00 45  
 F.S. P.I. 18+15.94 2 176 01 15  
 TO COR. 'C' M 88 00 35%

STA.  
 AT 15+0 1 99 55 00  
 F.S. P.I. 18+15.94 2 199 50 00  
 TO COR. 'D' M 99 55 00























































**VALUABLE**

SUBJECT \_\_\_\_\_

 RETURN TO  
 PUBLIC WORKS  
 OFFICE  
 CAMP LEJEUNE  
 NORTH CAROLINA

## FIELD PARTY

 \_\_\_\_\_ IN CHARGE  
 \_\_\_\_\_ INSTRUMENT  
 \_\_\_\_\_ NOTES  
 \_\_\_\_\_ TAPE READ  
 \_\_\_\_\_ TAPE OR ROD  
 \_\_\_\_\_ TAPE OR ROD  
 \_\_\_\_\_ INSTRUMENT No.  
 \_\_\_\_\_ TAPE No.

## WEATHER

 CLEAR  
 CLOUDY  
 WINDY  
 RAIN  
 FAIR

 SNOW  
 HOT  
 MODERATE  
 COLD  
 FOG

FILE No. \_\_\_\_\_

FLDR. No. \_\_\_\_\_

SHEET 4 of

FIGURED BY \_\_\_\_\_

NOTES CHECKED BY \_\_\_\_\_

PLOTTED BY \_\_\_\_\_

DATE \_\_\_\_\_ 19\_\_

Quad. No. \_\_\_\_\_

STATION	DIST.	ANGLE " "	+	H. I. BEARING	VER. ANG. DIFF.	ELEVATION
21+0	8' RT. E.R.D.	15' RT. W.L.		13' LT. E.R.D.	18' LT. W.L.	13' RT. OFFSET
20+0	8' RT. E.R.D.	13' RT. W.L.		13' LT. E.R.D.	18' LT. W.L.	13' RT. OFFSET
P.T. 19+4721		13 21 22 1/2				
19+00	11 03 00	11' RT. E.R.D.		16' RT. W.L.	16' RT. OFF	13' LT. E.R.D. 18' LT. W.L.
18+50	8 33 30					14' LT. OFFSET
18+00	6 04 00	12' RT. E.R.D.		18' RT. W.L.	18' RT. OFFSET	10' LT. E.R.D. 16' LT. W.L.
17+50	3 35 30					17' RT. OFFSET
17+00	1 06 00	11' RT. E.R.D.		23' RT. W.L.	17' RT. OFFSET	11' LT. E.R.D. 17' LT. W.L.
P.C. 16+7929	0 0 0					17' LT. OFFSET
P.I. 18+1599						
		$\Delta - 26^\circ 42' 45''$		LT.		
		E - 15.45'				
		D - 10'				
		R - 573.69'				
		T - 136.20'				
		L - 267.47'				
		DETL. 2.99' PER FT.				
16+04	51' LT. P.P. K45.			52.7' RT. P.P. K44		
16+0	10' RT. E.R.D.	15' RT. W.L.		12' LT. E.R.D.	14' LT. W.L.	13' RT. OFFSET
P.O.T. 15+5243		17' RT.		COR. WOODS		

P.T. 19+4721

26°42'45"

P.I. 18+1599  
#4

P.C. 16+7929






FIGURE NO.  
PLANT NO.  
TRAIL NO.

DATE  
TIME  
PLACE

**VALUABLE**

SUBJECT \_\_\_\_\_

RETURN TO  
PUBLIC WORKS  
OFFICE  
CAMP LEJEUNE  
NORTH CAROLINA

**FIELD PARTY**

\_\_\_\_\_  
IN CHARGE  
\_\_\_\_\_  
INSTRUMENT  
\_\_\_\_\_  
NOTES  
\_\_\_\_\_  
TAPE READ  
\_\_\_\_\_  
TAPE OR ROD  
\_\_\_\_\_  
TAPE OR ROD  
\_\_\_\_\_  
INSTRUMENT No.  
\_\_\_\_\_  
TAPE No.

+77

**WEATHER**

CLEAR  
CLOUDY  
WINDY  
RAIN  
FAIR

SNOW  
HOT  
MODERATE  
COLD  
FOG

FILE No. \_\_\_\_\_

FLDR. No. \_\_\_\_\_

SHEET 4 "A"


FIGURED BY \_\_\_\_\_

NOTES CHECKED BY \_\_\_\_\_

PLOTTED BY \_\_\_\_\_ DATE \_\_\_\_\_ 19\_\_

Quad. No. \_\_\_\_\_

STATION	DIST.	ANGLE " "	+	H. I. BEARING	VER. ANG. DIFF.	ELEVATION
---------	-------	--------------	---	------------------	--------------------	-----------

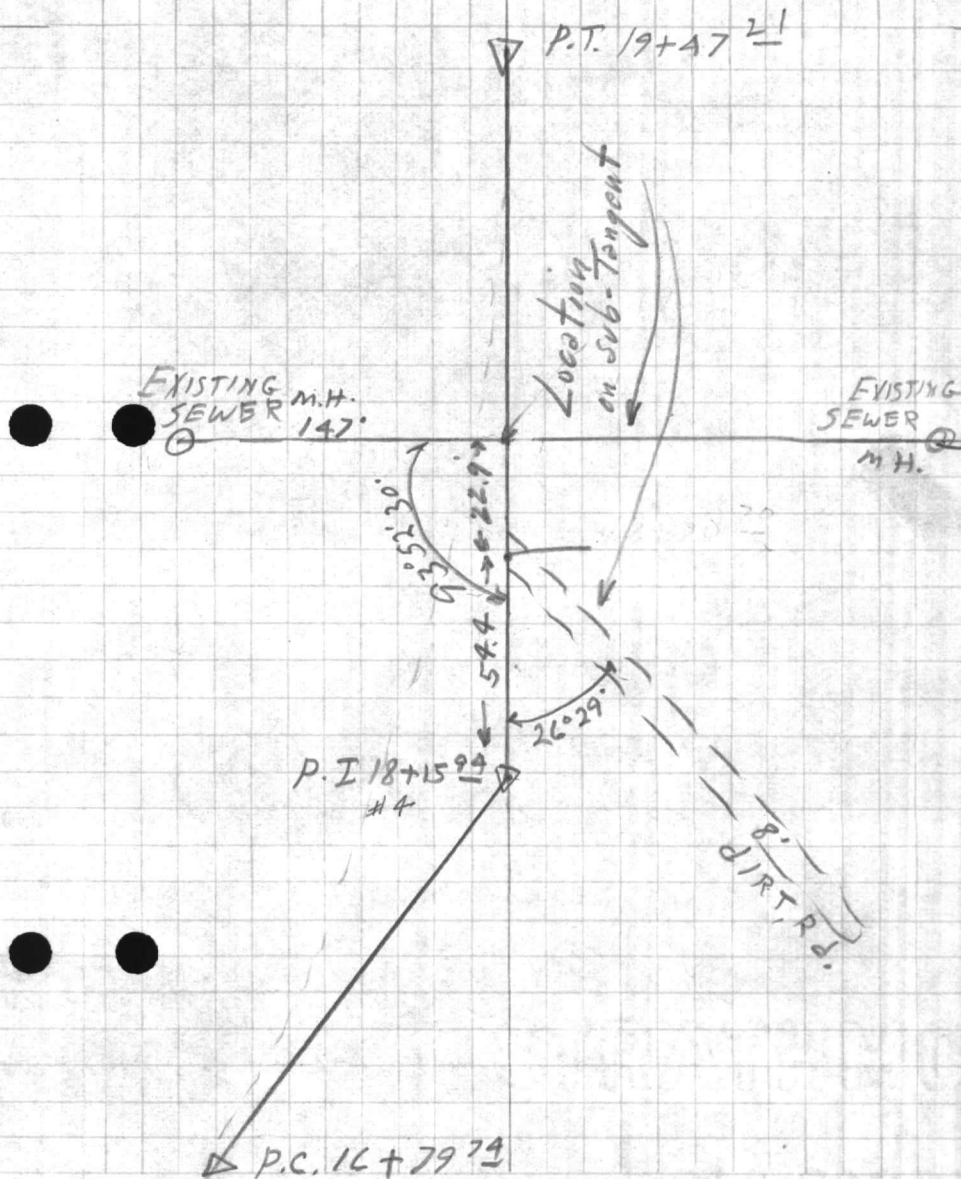



**VALUABLE**

SUBJECT \_\_\_\_\_

RETURN TO  
PUBLIC WORKS  
OFFICE  
CAMP LEJEUNE  
NORTH CAROLINA

**FIELD PARTY**

\_\_\_\_\_  
IN CHARGE  
\_\_\_\_\_  
INSTRUMENT  
\_\_\_\_\_  
NOTES  
\_\_\_\_\_  
TAPE READ  
\_\_\_\_\_  
TAPE OR ROD  
\_\_\_\_\_  
TAPE OR ROD  
\_\_\_\_\_  
INSTRUMENT No.  
\_\_\_\_\_  
TAPE No.

**WEATHER**

CLEAR  
CLOUDY  
WINDY  
RAIN  
FAIR

SNOW  
HOT  
MODERATE  
COLD  
FOG

FILE No. \_\_\_\_\_

FLDR. No. \_\_\_\_\_

SHEET A B


FIGURED BY \_\_\_\_\_

NOTES CHECKED BY \_\_\_\_\_

PLOTTED BY \_\_\_\_\_ DATE \_\_\_\_\_ 19\_\_

Quad. No. \_\_\_\_\_

STATION	DIST.	ANGLE ° ' "	+	H. I. BEARING	VER: ANG. DIFF.	ELEVATION
---------	-------	----------------	---	------------------	--------------------	-----------

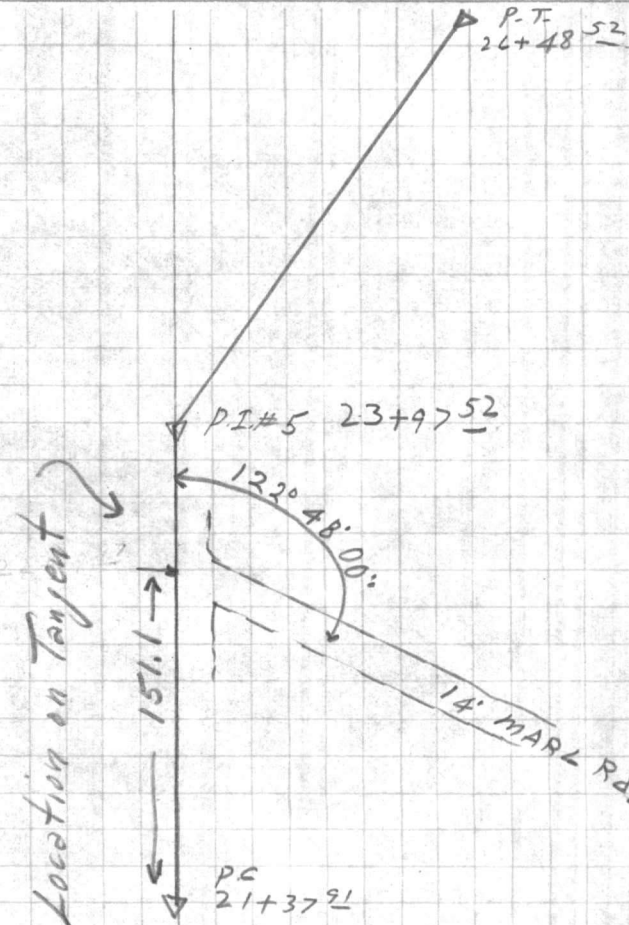

VALUABLE

RETURN TO  
PUBLIC WORKS  
OFFICE  
























**VALUABLE**

SUBJECT \_\_\_\_\_

RETURN TO  
PUBLIC WORKS  
OFFICE  
CAMP LEJEUNE  
NORTH CAROLINA

**FIELD PARTY**

\_\_\_\_\_  
IN CHARGE  
\_\_\_\_\_  
INSTRUMENT  
\_\_\_\_\_  
NOTES  
\_\_\_\_\_  
TAPE READ  
\_\_\_\_\_  
TAPE OR ROD  
\_\_\_\_\_  
TAPE OR ROD  
\_\_\_\_\_  
INSTRUMENT NO.  
\_\_\_\_\_  
TAPE NO.

**WEATHER**

CLEAR  
CLOUDY  
WINDY  
RAIN  
FAIR  
SNOW  
HOT  
MODERATE  
COLD  
FOG  
FIGURED BY \_\_\_\_\_  
NOTES CHECKED BY \_\_\_\_\_  
PLOTTED BY \_\_\_\_\_

FILE No. \_\_\_\_\_

FLDR. No. \_\_\_\_\_

SHEET 4<sup>c</sup> of

DATE \_\_\_\_\_ 19\_\_

Quad. No. \_\_\_\_\_

STATION	DIST.	ANGLE			+	H. I. BEARING	VER: ANG. DIFF.	ELEVATION
		°	'	"				
P.T. 26+48.52		12	44	8				
26+00		11	33	00				
25+50		10	18	00				
25+00		9	03	00				
24+50		7	48	00				
24+00		6	33	00				
23+50		5	18	00				
23+00		4	03	00				
22+50		2	48	00				
22+00		1	33	00				
21+50		0	18	00				
P.C. 21+37.9'		0	0	0				
$\Delta$ 25° 31' 20" <i>act.</i> D 5° R- 1146.28' T- 259.61' L- 510.41' E- 29.01' DEFI. PER FT. 1.5'								





**VALUABLE**

SUBJECT \_\_\_\_\_

 RETURN TO  
 PUBLIC WORKS  
 OFFICE  
 CAMP LEJEUNE  
 NORTH CAROLINA

## FIELD PARTY

 \_\_\_\_\_ IN CHARGE  
 \_\_\_\_\_ INSTRUMENT  
 \_\_\_\_\_ NOTES  
 \_\_\_\_\_ TAPE READ  
 \_\_\_\_\_ TAPE OR ROD  
 \_\_\_\_\_ TAPE OR ROD  
 \_\_\_\_\_ INSTRUMENT NO.  
 \_\_\_\_\_ TAPE NO.

## WEATHER

 CLEAR  
 CLOUDY  
 WINDY  
 RAIN  
 FAIR  
 SNOW  
 HOT  
 MODERATE  
 COLD  
 FOG

FILE No. \_\_\_\_\_

FLDR. No. \_\_\_\_\_


SHEET 5 of

FIGURED BY \_\_\_\_\_ NOTES CHECKED BY \_\_\_\_\_

PLOTTED BY \_\_\_\_\_ DATE \_\_\_\_\_ 19\_\_

Quad. No. \_\_\_\_\_

STATION	DIST.	ANGLE " "	+	H. I. BEARING	VER: ANG. DIFF.	ELEVATION
31+00	11' RT. E.Rd.	16' RT. W.L.			17' LT. E.Rd.	16' RT. OFFSET
30+88 <sup>52</sup>	24' LT. FIRE HYD				33' LT. WATER VALVE	
30+00	10' RT. E.Rd.	13' W.L.			16' LT. E.Rd.	13' RT. OFFSET
29+00	9' RT. E.Rd.	15' RT. W.L.			16' LT. E.Rd.	13' RT. OFFSET
28+00	8' RT. E.Rd.	20' RT. W.L.			17' LT. E.Rd.	13' RT. OFFSET
27+00	9' RT. E.Rd.	13' RT. W.L.			17' LT. E.Rd.	13' RT. OFFSET
P.T. 26+48 <sup>52</sup>						14' RT. OFFSET
26+00	8' RT. E.Rd.	13' RT. W.L.			18' LT. E.Rd.	13' RT. OFFSET
25+50						13' RT. OFFSET
25+00	10' RT. E.Rd.	20' RT. W.L.			13' LT. E.Rd.	18' LT. W.L.
24+50						15' RT. OFFSET
24+00	11' RT. E.Rd.	14' RT. W.L.			12' RT. E.Rd.	17' LT. W.L.
23+98 <sup>52</sup>	12' RT. EXD	18' R.C.P.			20' LT. EXD	18' R.C.P.
23+00	9' RT. E.Rd.	15' RT. W.L.			13' LT. E.Rd.	17' LT. W.L.
22+50						12' RT. OFFSET
22+00	7' RT. E.Rd.	17' RT. W.L.			12' LT. E.Rd.	20' LT. W.L.
21+50						13' RT. OFFSET
P.C. 21+37 <sup>21</sup>						14' RT. OFFSET

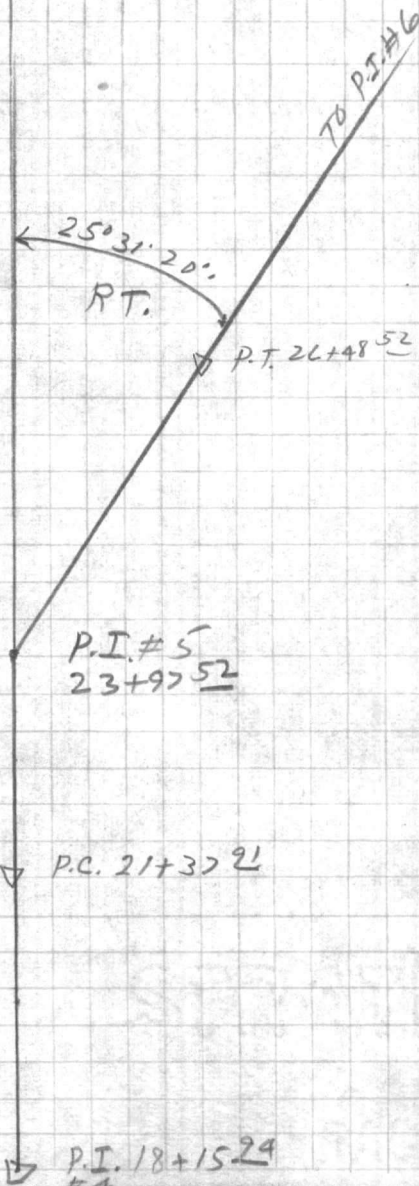

RETURN TO  
PUBLIC WORKS  
OFFICE  
CAMP LEWINE  
NORTH CAROLINA

VALUABLE SUBJECT

STATION Dist


ANGLE +

BOATING

H I  
Dist Elevation

FIELD PARTY  
WEATHER  
CLEAR  
WINDY  
RAIN  


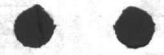









**VALUABLE**

SUBJECT \_\_\_\_\_

 RETURN TO  
 PUBLIC WORKS  
 OFFICE  
 CAMP LEJEUNE  
 NORTH CAROLINA

## FIELD PARTY

 \_\_\_\_\_ IN CHARGE  
 \_\_\_\_\_ INSTRUMENT  
 \_\_\_\_\_ NOTES  
 \_\_\_\_\_ TAPE READ  
 \_\_\_\_\_ TAPE OR ROD  
 \_\_\_\_\_ TAPE OR ROD  
 \_\_\_\_\_ INSTRUMENT NO.  
 \_\_\_\_\_ TAPE NO.

## WEATHER

 CLEAR  
 CLOUDY  
 WINDY  
 RAIN  
 FAIR  
 SNOW  
 HOT  
 MODERATE  
 COLD  
 FOG

FILE No. \_\_\_\_\_

FLDR. No. \_\_\_\_\_


SHEET 5 "B"

NOTES CHECKED BY \_\_\_\_\_

PLOTTED BY \_\_\_\_\_ DATE \_\_\_\_\_ 19\_\_

Quad. No. \_\_\_\_\_

STATION	DIST.	ANGLE " "	+	H. I. BEARING	VER. ANG. DIFF.	ELEVATION
AT POT 32+53 <sup>28</sup>		99				27 00
F.S. P.I. 37+05 <sup>42</sup>		198				54 00
TO COR. "A"		99				27 00
COR. "B"		93				45 15
		187				30 30
		93				45 15
TO R. Rd.		119				59 00

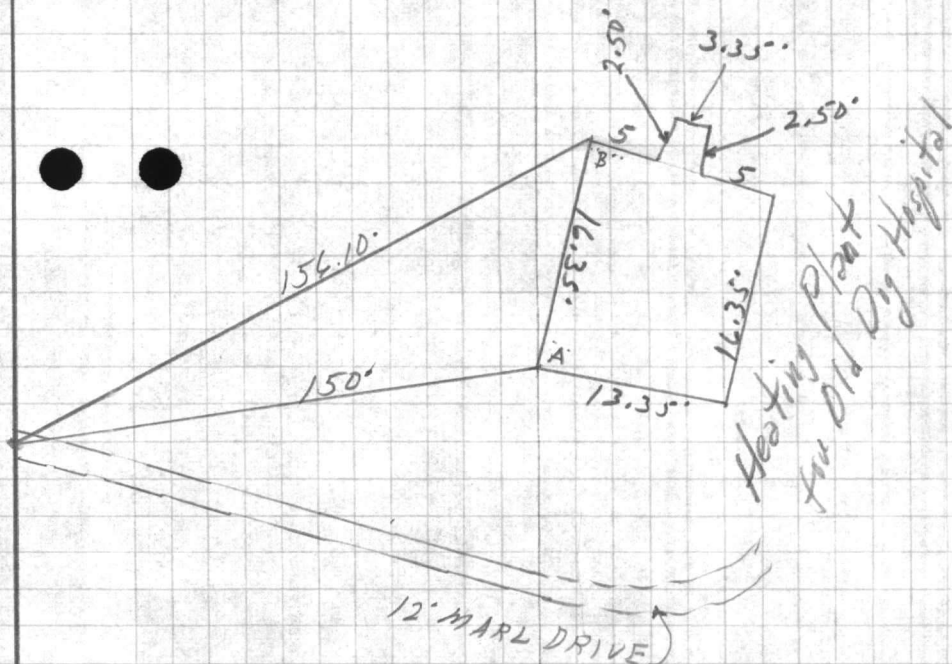

VALUABLE SUBJECTS  
RETURN TO  
RURAL WORKS  
OFFICE  
CAMP LEJUNE  
NORTH CAROLINA

STATION DIST ANGLE


BEARING

H. I. V. 100  
FEET AND  
ELEVATION

FIELD PARTY  



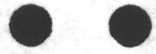

**VALUABLE**

SUBJECT \_\_\_\_\_

RETURN TO  
PUBLIC WORKS  
OFFICE  
CAMP LEJEUNE  
NORTH CAROLINA

**FIELD PARTY**

\_\_\_\_\_  
IN CHARGE  
\_\_\_\_\_  
INSTRUMENT  
\_\_\_\_\_  
NOTES  
\_\_\_\_\_  
TAPE READ  
\_\_\_\_\_  
TAPE OR ROD  
\_\_\_\_\_  
TAPE OR ROD  
\_\_\_\_\_  
INSTRUMENT NO.  
\_\_\_\_\_  
TAPE NO.

**WEATHER**

CLEAR  
CLOUDY  
WINDY  
RAIN  
FAIR  
SNOW  
HOT  
MODERATE  
COLD  
FOG  
FIGURED BY \_\_\_\_\_  
NOTES CHECKED BY \_\_\_\_\_  
PLOTTED BY \_\_\_\_\_

FILE No. \_\_\_\_\_

FLDR. No. \_\_\_\_\_

SHEET

5<sup>00</sup>

DATE

19

Quad. No. \_\_\_\_\_

STATION	DIST.	ANGLE	"	+	H. I. BEARING	VER. ANG. DIFF.	ELEVATION
---------	-------	-------	---	---	------------------	--------------------	-----------

P.T. 34+25 <sup>44</sup>	3	28	5				
34+0	3	07	3				
35+50	2	25	55				
35+00	1	43	8				
34+50	1	02	05				
34+0	0	20	3				
P.C. 33+75 <sup>29</sup>	0	0	0				

∇ 6° 57'


D 2° 47' +

T- 125'

R- 2058.49'

LA- 249.7'

DETL. 835 PER. FT.

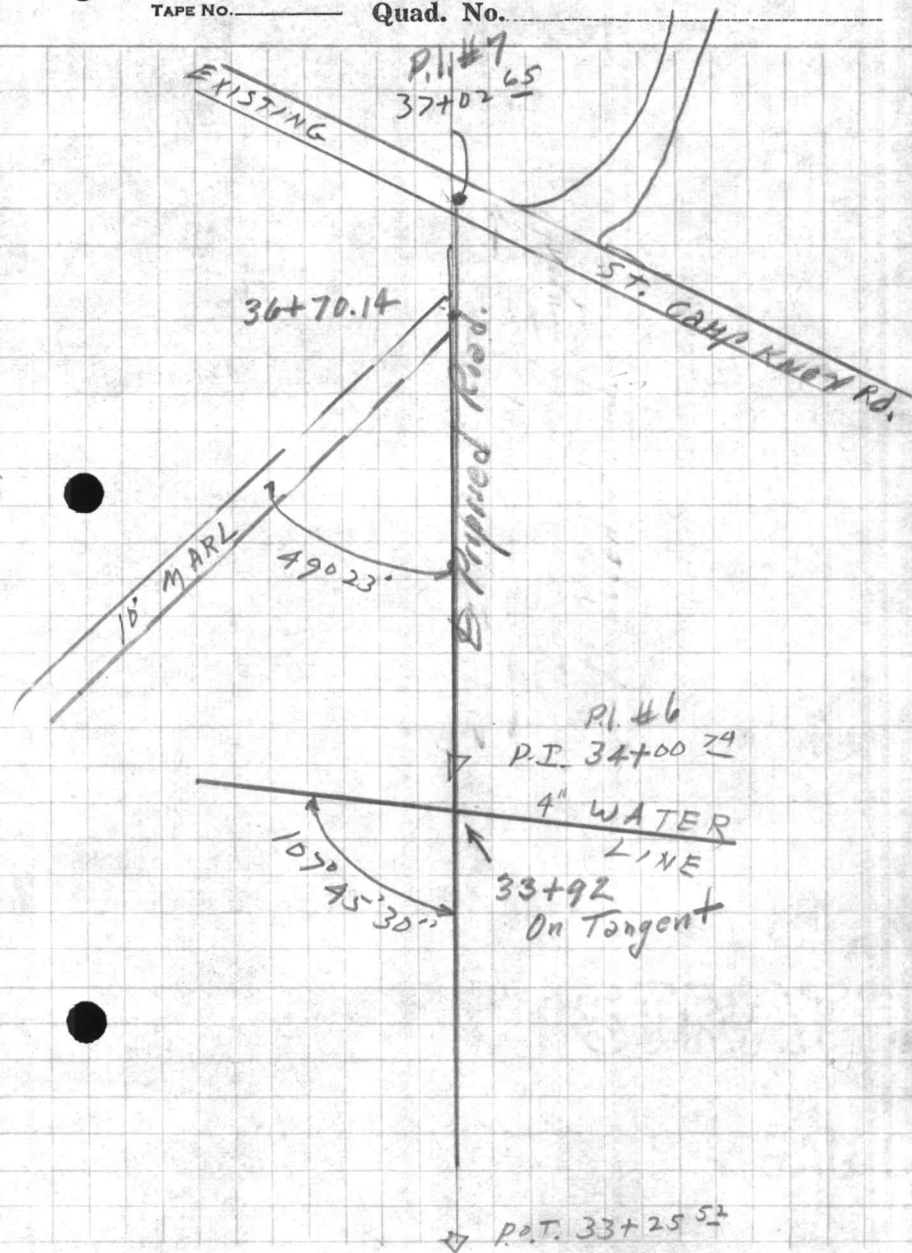

∇ P.O.T. 33+25<sup>52</sup>





**VALUABLE**

SUBJECT \_\_\_\_\_

 RETURN TO  
 PUBLIC WORKS  
 OFFICE  
 CAMP LEJEUNE  
 NORTH CAROLINA

## FIELD PARTY

 \_\_\_\_\_ IN CHARGE  
 \_\_\_\_\_ INSTRUMENT  
 \_\_\_\_\_ NOTES  
 \_\_\_\_\_ TAPE READ  
 \_\_\_\_\_ TAPE OR ROD  
 \_\_\_\_\_ TAPE OR ROD  
 \_\_\_\_\_ INSTRUMENT NO.  
 \_\_\_\_\_ TAPE NO.

## WEATHER

 CLEAR \_\_\_\_\_  
 CLOUDY \_\_\_\_\_  
 WINDY \_\_\_\_\_  
 RAIN \_\_\_\_\_  
 FAIR \_\_\_\_\_  
 SNOW \_\_\_\_\_  
 HOT \_\_\_\_\_  
 MODERATE \_\_\_\_\_  
 COLD \_\_\_\_\_  
 FOG \_\_\_\_\_

FILE No. \_\_\_\_\_

FLDR. No. \_\_\_\_\_

SHEET 6 of

NOTES CHECKED BY \_\_\_\_\_

PLOTTED BY \_\_\_\_\_

DATE \_\_\_\_\_ 19\_\_

Quad. No. 1

STATION	DIST.	ANGLE " +	H. I. BEARING	VER. ANG. DIFF.	ELEVATION
STA. 36+76 <sup>00</sup>		75°	LT. P.P. K-27		
37+22 <sup>65</sup>		∅	EXISTING ST. CAMP KNOX TRAILER PARK		
37+12			E. STREET		
37+06			10' RT. E. STREET	22.20' LT. END	30' R.C.P.
36+76 <sup>00</sup>			8' RT. E. Rd.	23' RT. END. 30" R.C.P.	
36+67'			39.50' LT. E. END	18" R.C.P.	
36+50			6' RT. E. Rd.	20' LT. E. Rd.	10' RT. OFFSET
P.T. 36+25 <sup>44</sup>			7' RT. E. Rd.	12' RT. W.L.	12' RT. OFFSET
36+05'				19' LT. E. Rd.	
36+00			10' RT. E. Rd.	21' RT. W.L.	14' RT. OFFSET
35+94 <sup>50</sup>			20.50' RT.	P.P. K-28	
35+50			15' RT. E. Rd.	9' LT. E. Rd.	20' RT. OFFSET
35+00			18' RT. E. Rd.	27' LT. W.L.	23' RT. OFFSET
34+80			27' RT. WATER VALVE		
34+20			24' RT. FIRE HYD.		
34+50					21' RT. OFF
34+00			13' RT. E. Rd.	20' RT. W.L.	18' RT. OFF
P.C. 33+75 <sup>74</sup>				11' LT. E. Rd.	
33+00			12' RT. E. Rd.	17' RT. W.L.	15' RT. OFFSET
32+00			11' RT. E. Rd.	16' RT. W.L.	14' RT. OFFSET

 FLORENCE  
 Rd.
37+22<sup>65</sup>

CAMP KNOX Rd.

P.T. 36+25<sup>44</sup>

6° 57' 00"

P.L. 46

35+00<sup>74</sup>P.C. 33+75<sup>74</sup>

1 25

P.O.T. 33+25<sup>52</sup>P.O.T. 32+53<sup>28</sup>



**VALUABLE**

SUBJECT \_\_\_\_\_

RETURN TO  
PUBLIC WORKS  
OFFICE  
CAMP LEJEUNE  
NORTH CAROLINA

**FIELD PARTY**

\_\_\_\_\_  
IN CHARGE  
\_\_\_\_\_  
INSTRUMENT  
\_\_\_\_\_  
NOTES  
\_\_\_\_\_  
TAPE READ  
\_\_\_\_\_  
TAPE OR ROD  
\_\_\_\_\_  
TAPE OR ROD  
\_\_\_\_\_  
INSTRUMENT No.  
\_\_\_\_\_  
TAPE No.

**WEATHER**

CLEAR  
CLOUDY  
WINDY  
RAIN  
FAIR  
SNOW  
HOT  
MODERATE  
COLD  
FOG

FILE No. \_\_\_\_\_

FLDR. No. \_\_\_\_\_


SHEET 7 of 7

FIGURED BY \_\_\_\_\_

NOTES CHECKED BY \_\_\_\_\_

PLOTTED BY \_\_\_\_\_ DATE \_\_\_\_\_ 19\_\_

Quad. No. \_\_\_\_\_

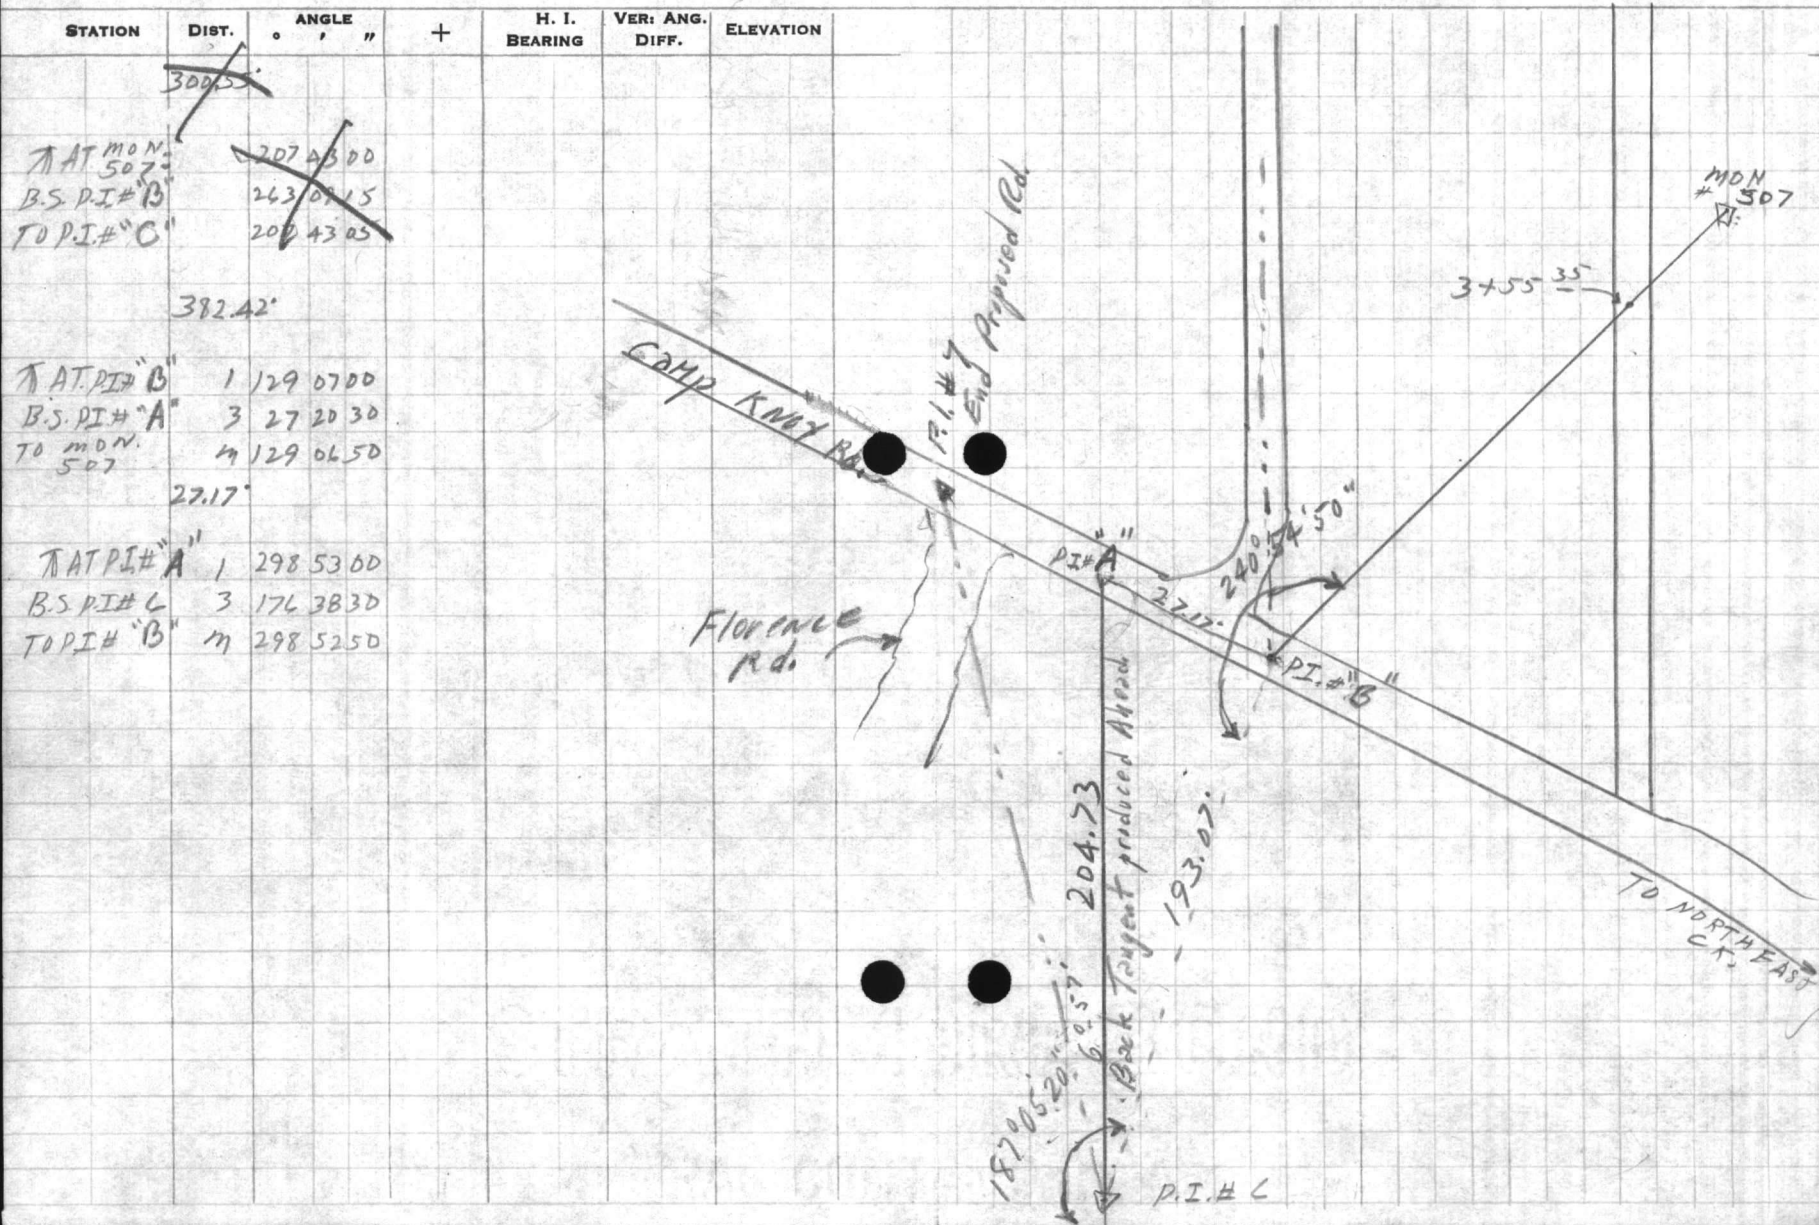

















**VALUABLE**

SUBJECT \_\_\_\_\_

 RETURN TO  
 PUBLIC WORKS  
 OFFICE  
 CAMP LEJEUNE  
 NORTH CAROLINA

## FIELD PARTY

 \_\_\_\_\_ IN CHARGE  
 \_\_\_\_\_ INSTRUMENT  
 \_\_\_\_\_ NOTES  
 \_\_\_\_\_ TAPE READ  
 \_\_\_\_\_ TAPE OR ROD  
 \_\_\_\_\_ TAPE OR ROD  
 \_\_\_\_\_ INSTRUMENT No.  
 \_\_\_\_\_ TAPE No.

## WEATHER

 CLEAR  
 CLOUDY  
 WINDY  
 RAIN  
 FAIR  
 SNOW  
 HOT  
 MODERATE  
 COLD  
 FOG

FILE No. \_\_\_\_\_

FLDR. No. \_\_\_\_\_

SHEET 2A of

NOTES CHECKED BY \_\_\_\_\_

PLOTTED BY \_\_\_\_\_ DATE \_\_\_\_\_ 19\_\_

Quad. No. \_\_\_\_\_

STATION	DIST.	ANGLE " "	+	H. I. BEARING	VER. ANG. DIFF.	ELEVATION
AT P.I. 35+00 79	1	173	03	00		
BS P.O.T. 33+25 52	3	158	09	00		
TO P.I.	19	173	03	00		

END OF WORK  
 HERE  
 P.I. #7  
 Camp Knot Rd.  
 Florence Rd.  
 P.I. "A"  
 TRAVERSE  
 P.I. "B"  
 P.I. 35+00 79  
 P.I. #6  
 P.O.T. 33+25 52

VALUABLE  
RETURN TO  
PUBLIC WORKS  
OFFICE  
CAMP LEVINE  
NORTH CAROLINA











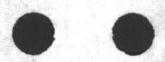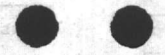

**VALUABLE**

SUBJECT \_\_\_\_\_

RETURN TO  
PUBLIC WORKS  
OFFICE  
CAMP LEJEUNE  
NORTH CAROLINA

## FIELD PARTY

 \_\_\_\_\_ IN CHARGE  
 \_\_\_\_\_ INSTRUMENT  
 \_\_\_\_\_ NOTES  
 \_\_\_\_\_ TAPE READ  
 \_\_\_\_\_ TAPE OR ROD  
 \_\_\_\_\_ TAPE OR ROD  
 \_\_\_\_\_ INSTRUMENT No.  
 \_\_\_\_\_ TAPE No.

## WEATHER

 CLEAR  
 CLOUDY  
 WINDY  
 RAIN  
 FAIR

 SNOW  
 HOT  
 MODERATE  
 COLD  
 FOG

FILE No. \_\_\_\_\_

FLDR. No. \_\_\_\_\_

SHEET 7 "B"

NOTES CHECKED BY \_\_\_\_\_

FIGURED BY \_\_\_\_\_ DATE \_\_\_\_\_ 19\_\_\_\_

PLOTTED BY \_\_\_\_\_ Quad. No. \_\_\_\_\_

STATION	DIST.	ANGLE " "	+	H. I. BEARING	VER. ANG. DIFF.	ELEVATION
---------	-------	--------------	---	------------------	--------------------	-----------


1+19	10.20	RT. E. STREET		10.20	LT. E. STREET	
------	-------	---------------	--	-------	---------------	--

0+44.50	6.80	RT. E. STRE		12.80	LT	
---------	------	-------------	--	-------	----	--

0+31.50	3.20	RT. E. STREET		19.60	LT. E. STREET	
---------	------	---------------	--	-------	---------------	--

0+16'	8'	RT. E. STREET		42'	LT. PT. RAD.	
-------	----	---------------	--	-----	--------------	--

0+09.50		E. STREET		18.50	RT. PT. RAD.	
---------	--	-----------	--	-------	--------------	--

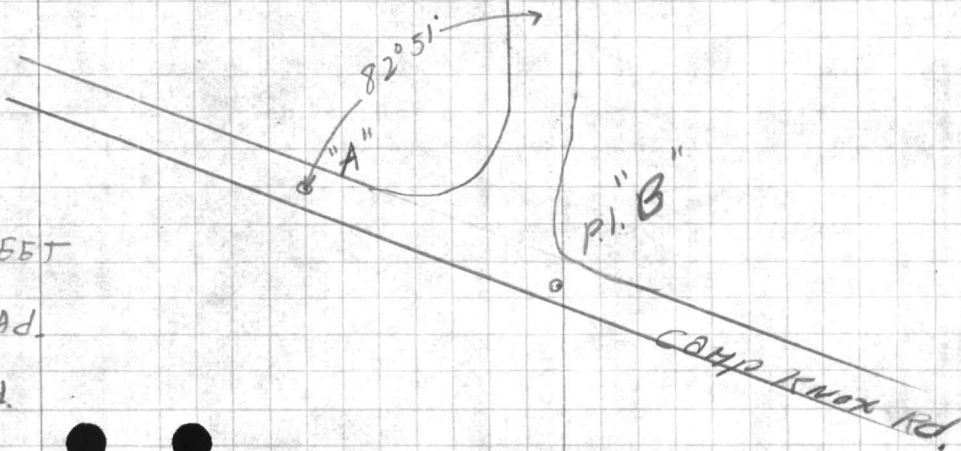

RETURN TO  
PUBLIC WORKS  
OFFICE  
























**VALUABLE**

SUBJECT \_\_\_\_\_

 RETURN TO  
 PUBLIC WORKS  
 OFFICE  
 CAMP LEJEUNE  
 NORTH CAROLINA

## FIELD PARTY

 \_\_\_\_\_ IN CHARGE  
 \_\_\_\_\_ INSTRUMENT  
 \_\_\_\_\_ NOTES  
 \_\_\_\_\_ TAPE READ  
 \_\_\_\_\_ TAPE OR ROD  
 \_\_\_\_\_ TAPE OR ROD  
 \_\_\_\_\_ INSTRUMENT No.  
 \_\_\_\_\_ TAPE No.

## WEATHER

 CLEAR  
 CLOUDY  
 WINDY  
 RAIN  
 FAIR  
 SNOW  
 HOT  
 MODERATE  
 COLD  
 FOG

FILE No. \_\_\_\_\_


FLDR. No. \_\_\_\_\_

SHEET 8 of

DATE \_\_\_\_\_ 19\_\_

Quad. No. \_\_\_\_\_

STATION	DIST.	ANGLE " "	+	H. I. BEARING	VER. ANG. DIFF.	ELEVATION
KAT MON. 507 B.S. PI#B TO POINT 'A'	117.25	325	32	30		
POINT 'B'	292.65	322	48	00		
POINT 'C'	377.83	133	24	00		

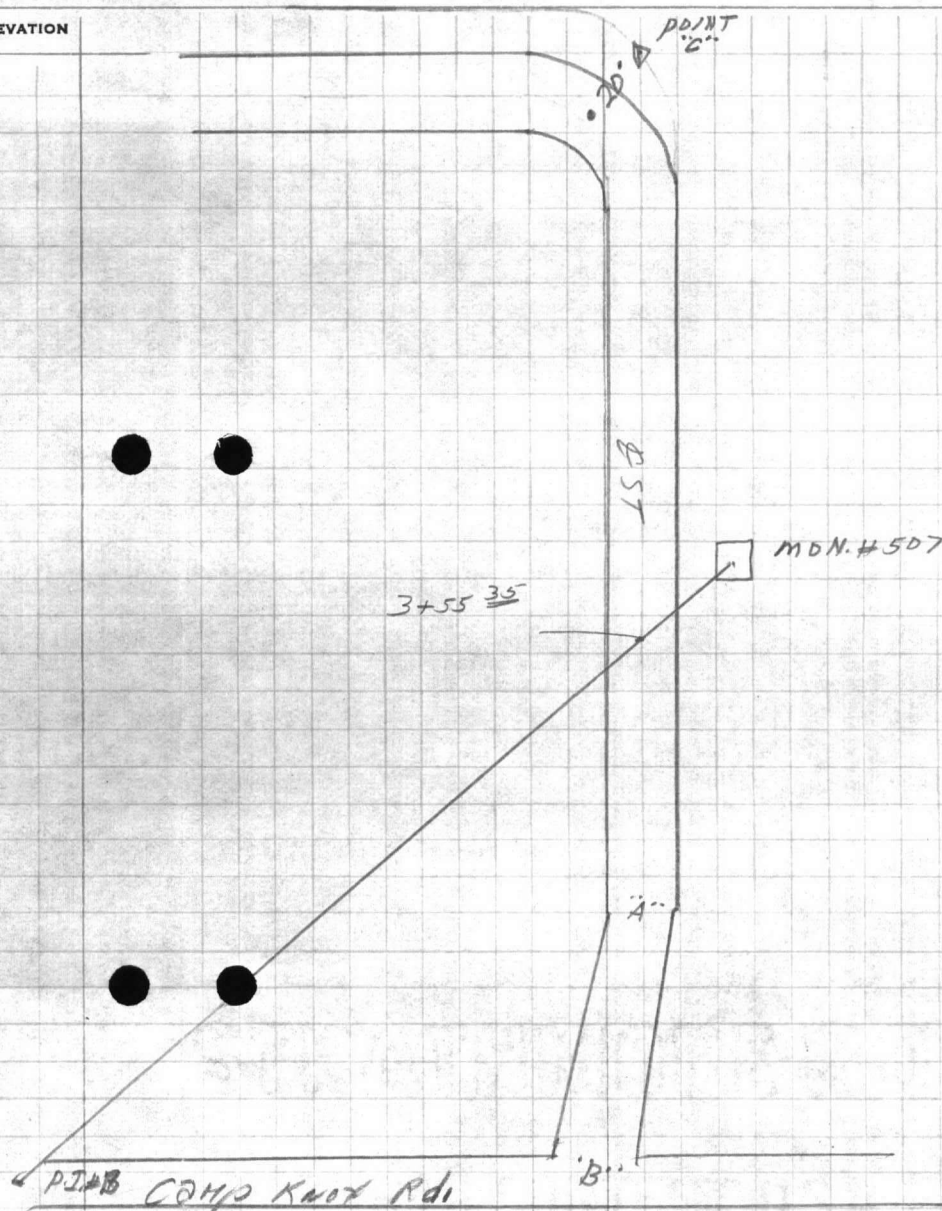
















**VALUABLE**

RETURN TO  
PUBLIC WORKS  
OFFICE  
CAMP LEJEUNE  
NORTH CAROLINA


SUBJECT TRAVERSE TIE  
FLORENCE Rd.  
CAMP KNOX AREA

FIELD PARTY  
DENNIS IN CHARGE  
\_\_\_\_ INSTRUMENT  
\_\_\_\_ NOTES  
\_\_\_\_ TAPE READ  
\_\_\_\_ TAPE OR ROD  
\_\_\_\_ TAPE OR ROD  
\_\_\_\_ INSTRUMENT No.  
\_\_\_\_ TAPE No.

WEATHER  
CLEAR \_\_\_\_\_ SNOW \_\_\_\_\_  
CLOUDY \_\_\_\_\_ HOT \_\_\_\_\_  
WINDY \_\_\_\_\_ MODERATE \_\_\_\_\_  
RAIN \_\_\_\_\_ COLD \_\_\_\_\_  
FAIR \_\_\_\_\_ FOG \_\_\_\_\_  
FIGURED BY \_\_\_\_\_ SHEET 101  
NOTES CHECKED BY \_\_\_\_\_ DATE 12.27 1955  
PLOTTED BY \_\_\_\_\_  
Quad. No. \_\_\_\_\_

STATION	DIST.	ANGLE ° ' "	+	H. I. BEARING	VER. ANG. DIFF.	ELEVATION
AT MON. 507	1	140	15			
B.S. P.I.#'B'	3	60	40			
TO MON. 505	1	140	00			

CAMP KNOT Rd.  
Florence Rd. →

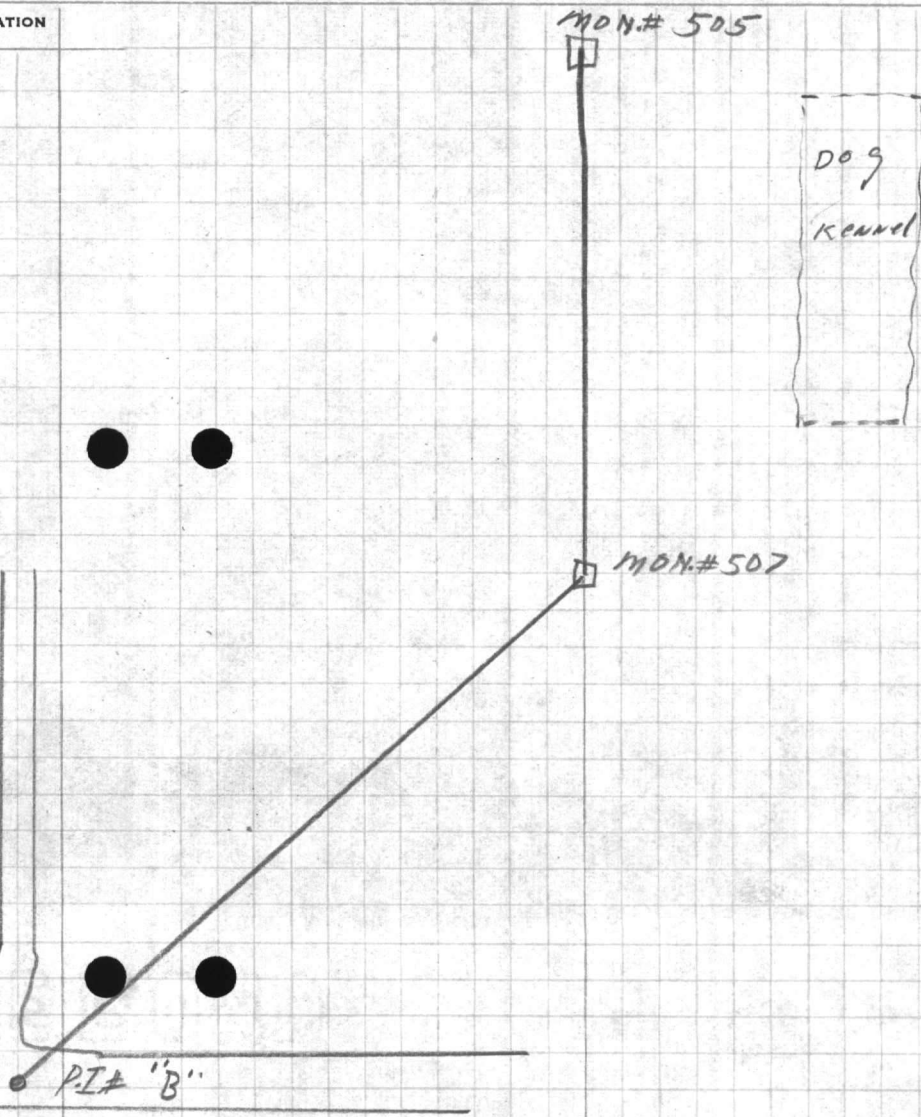







**VALUABLE**

SUBJECT \_\_\_\_\_  
\_\_\_\_\_  
\_\_\_\_\_  
\_\_\_\_\_  
\_\_\_\_\_  
\_\_\_\_\_

RETURN TO  
PUBLIC WORKS  
OFFICE  
CAMP LEJEUNE  
NORTH CAROLINA

**FIELD PARTY**

\_\_\_\_\_  
IN CHARGE  
\_\_\_\_\_  
INSTRUMENT  
\_\_\_\_\_  
NOTES  
\_\_\_\_\_  
TAPE READ  
\_\_\_\_\_  
TAPE OR ROD  
\_\_\_\_\_  
TAPE OR ROD  
\_\_\_\_\_  
INSTRUMENT NO.  
\_\_\_\_\_  
TAPE NO.

**WEATHER**

CLEAR  
CLOUDY  
WINDY  
RAIN  
FAIR  
SNOW  
HOT  
MODERATE  
COLD  
FOG  
FIGURED BY \_\_\_\_\_  
NOTES CHECKED BY \_\_\_\_\_  
PLOTTED BY \_\_\_\_\_

FILE No. \_\_\_\_\_  
FLDR. No. \_\_\_\_\_  
SHEET 9 of 9  
DATE \_\_\_\_\_ 19\_\_


Quad. No. \_\_\_\_\_

STATION	DIST.	ANGLE " "	+	H. I. BEARING	VER. ANG. DIFF.	ELEVATION
---------	-------	--------------	---	------------------	--------------------	-----------

*No. 10*

~~371.00'~~

~~T.A.T.P. #0 1 126 37 00  
 BS. MON. #507 = 9 3 19 38 30  
 TO MON. # "Camp" M 176 32 50  
 = P.I. #11~~

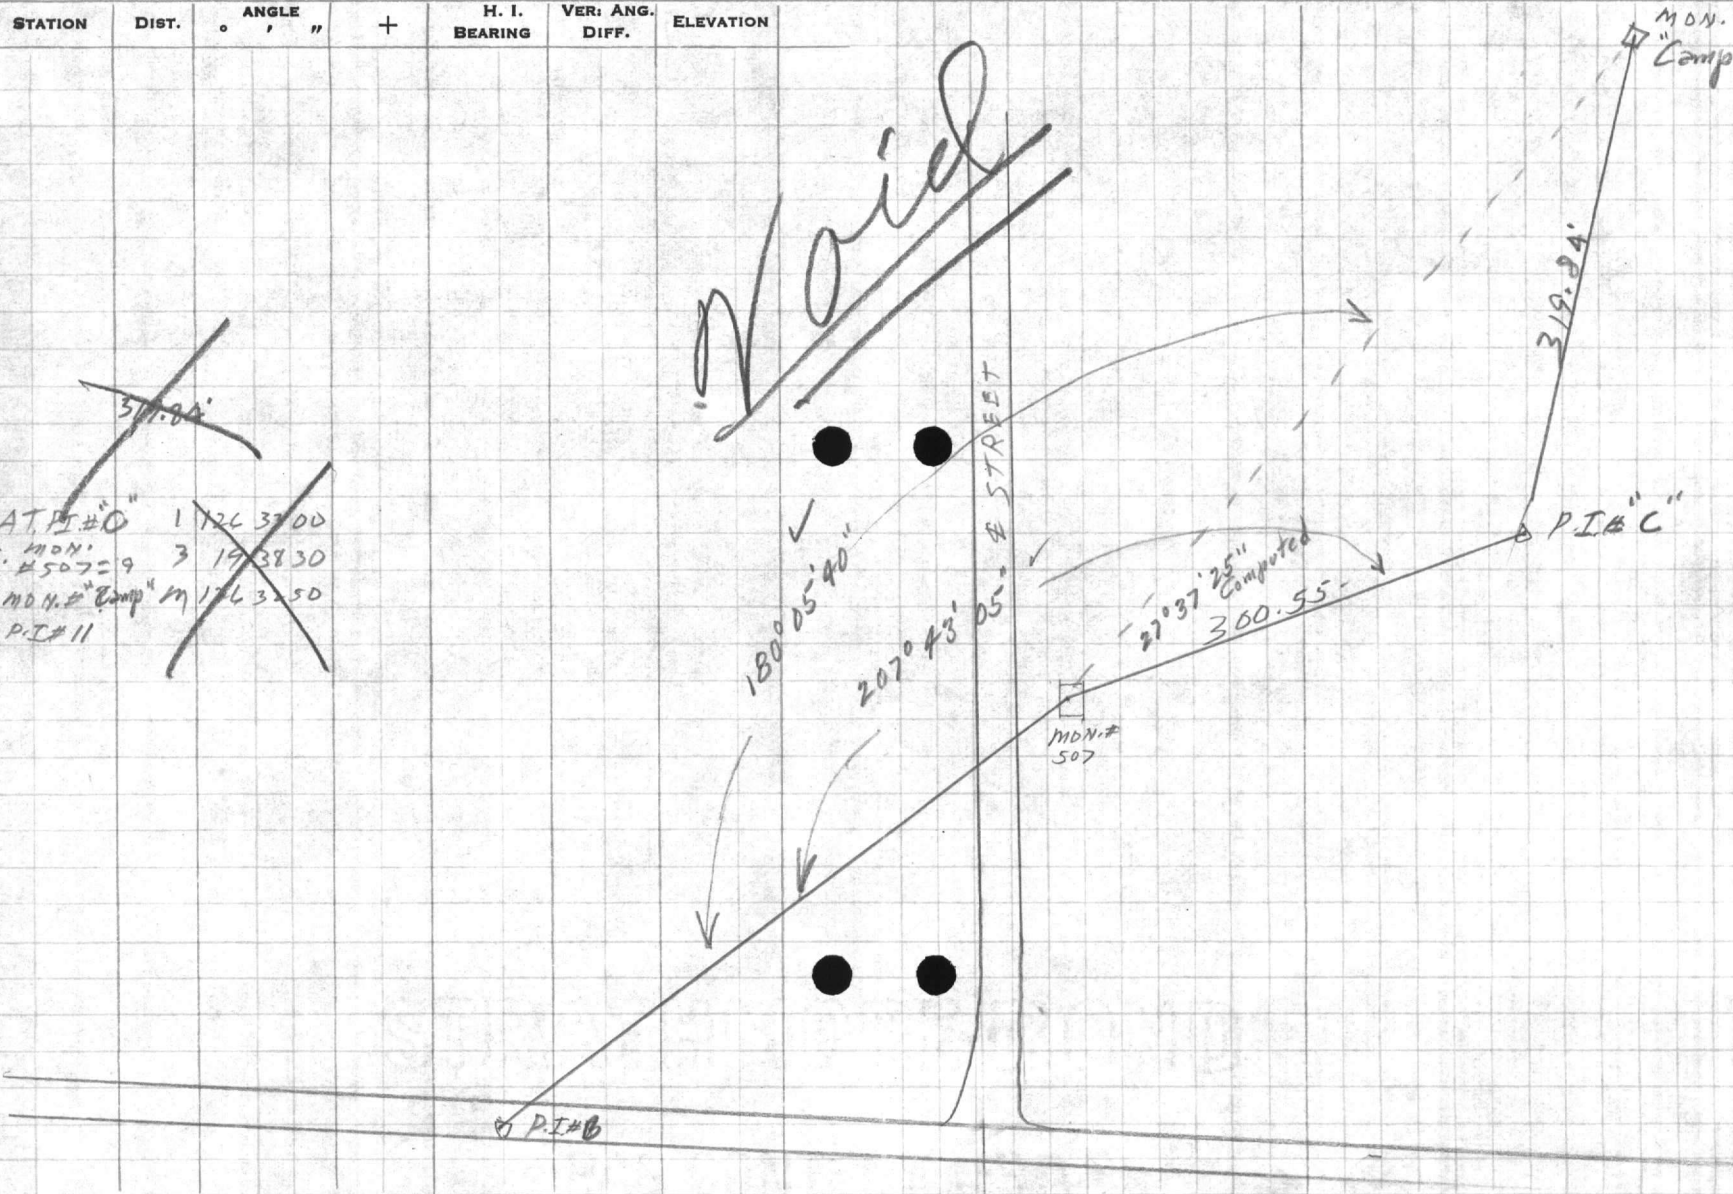



PUBLIC WORKS DEPARTMENT  
Camp Lejeune, North Carolina  
Survey Department

File 99-U  
Quadrangle \_\_\_\_\_  
Date \_\_\_\_\_  
Sheet \_\_\_\_\_ of \_\_\_\_\_

Traverse Computation  
Description

*Connecting Road - Camp Knox to Montford Point*

Station	Distance	Bearing	Cosine	Sine	Latitude	Departure	Y Coordinate North	X Coordinate East
Mon U.S.M.C. # 108		563°40'50" W					362,527.23	2,479,257.05
P.I. # Along Mon. Target	94.05	563-40-50 W	4433754	8963360	41.70	<sup>.32</sup> 04304.02	362,485.53	2,479,172.73
P.I. #1 =	430.51	516-50-36 E	9571006	2897557	412.04 <sup>.02</sup> - .02	<sup>.71</sup> 124.74 <sup>.03</sup>	362,073.51	2,479,297.44
P.I. #2 = 0+00 Rd. Align-	684.93	522-09-18 E	9261671	3771135	634.36 <sup>.31</sup> - .05	<sup>.23</sup> 258.30 <sup>.07</sup>	361,439.20	2,479,555.67
P.I. #3 = 7+42.62	742.62	545-17-29 E	7035015	7106938	522.43 <sup>.40</sup> - .03	<sup>.63</sup> 527.78 <sup>.15</sup>	360,916.80	2,480,083.30
P.I. #4 = 18+15.94	1079.11	583-03-16 E	1209261	9926615	130.77 <sup>.48</sup> - .01	<sup>.89</sup> 1071.79 <sup>.30</sup>	360,786.32	2,481,154.19
P.I. #5 = 23+97.52	586.51	N70-13-48 E	3382452	9410580	198.38 <sup>.39</sup> + .01	<sup>.79</sup> 551.97 <sup>.15</sup>	360,984.71	2,481,705.98
P.F. #6 = 35+00.74	1111.83	584-15-04 E	1001688	9949705	111.37 <sup>.36</sup> - .01	<sup>.93</sup> 1105.44 <sup>.31</sup>	360,873.35	2,482,811.91
P.F. "B" <small>intersection of camp Knox Rd. and Exist. St. to N.H. Trailer Park</small>	193.07	577-09-55 E	2221394	9750149	42.89	<sup>.20</sup> 188.25 <sup>.05</sup>	360,830.46	2,483,000.11
MON. #507	382.42	516-15-17 E	9600268	2799081	367.43 <sup>.11</sup> - .02	<sup>.01</sup> 107.04 <sup>.03</sup>	360,463.35	2,483,107.12
TO MON. #505		555-57-29 E						
		55-55-45			-2262.41 + 198.38	+3935.48 - 84.30	360,463.20	2,483,108.23
					-2064.03	+3851.18	-0.15	+ 1.11

Error 0°1'44"  
Adjusted

Adjusted







59.5  
3  
178.5

27.5  
32.5  
139.5  
178.5  
265.5  
381.5


