

VALUABLE

RETURN TO
PUBLIC WORKS
OFFICE
CAMP LEJEUNE
NORTH CAROLINA

SUBJECT

New Water Line
Location, Montford Pt.

"A"

FIELD PARTY
DENNIS IN CHARGE
____ INSTRUMENT
____ NOTES
____ TAPE READ
____ TAPE OR ROD
____ TAPE OR ROD
____ INSTRUMENT NO.
____ TAPE NO.

WEATHER
CLEAR CLOUDY
WINDY
RAIN
FAIR
SNOW
HOT
MODERATE
COLD
FOG
FIGURED BY _____
NOTES CHECKED BY _____
PLOTTED BY _____

FILE No. 984


FLDR. No. _____

SHEET 104

DATE 10-25-1955

Quad. No. _____

STATION	DIST.	ANGLE ° ' "	+	H. I. BEARING	VER. ANG. DIFF.	ELEVATION
AT P.I.# 2	1	270 00 00				
B.S. P.I.# 1	3	90 00 15				
TOP P.I.# 3	m	270 00 05				
3+69 ⁸⁵				E 5' MARL WALK		
AT P.I.# 1	①	90 02 00				
B.S. P.I.# 2	②	270 05 30				
TOP P.I.# 2	m	90 01 50				
3+44 ⁵⁰				4.90' RT. OVERHEAD STEAM		
2+81 ⁶⁰				5' RT. OVERHEAD "		
2+79 ⁵⁰				8' RT. OVERHEAD STEAM POLE		
2+75 ⁵⁰				E 6' MARL WALK		
2+69 ⁴⁵				7' LT. COR. M-130		
2+06 ⁸⁰				7' LT. COR. M-130		
1+38 ⁸				E OVERHEAD POWER LINE		
1+26				5.20' COR. BRICK FIRE PLACE		
1+07 ⁰⁰				10.50 RT. OVERHEAD STEAM POLE		
1+07 ⁰⁰				7.70 LT. OVERHEAD STEAM POLE		
0+81 ⁶⁰				EDGE PAVEMENT.		
0+38 ⁸⁵				EDGE PAVEMENT.		

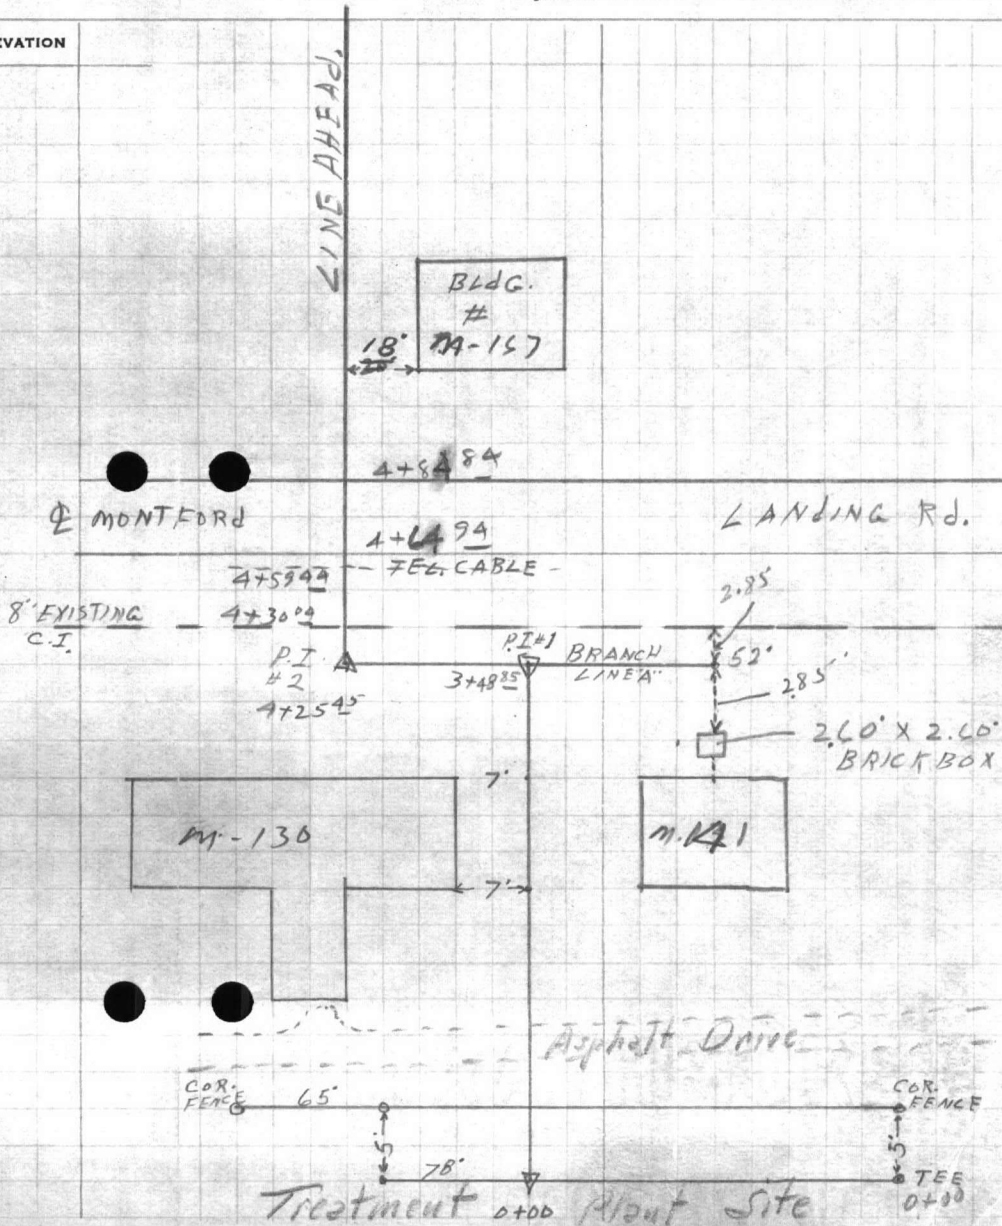

RECEIVED
OFFICE
NOV 10 1954

STATION

NOV 10 1954

FILE NO.
DATE
TIME
PLACE

RECEIVED
OFFICE
NOV 10 1954

NOV 10 1954



VALUABLE

SUBJECT _____

RETURN TO
PUBLIC WORKS
OFFICE
CAMP LEJEUNE
NORTH CAROLINA

FIELD PARTY

IN CHARGE

INSTRUMENT

NOTES

TAPE READ

TAPE OR ROD

TAPE OR ROD

INSTRUMENT No.

TAPE No.

WEATHER

CLEAR

CLOUDY

WINDY

RAIN

FAIR

SNOW

HOT

MODERATE

COLD

FOG


FILE No. _____

FLDR. No. _____

SHEET 208

FIGURED BY _____
NOTES CHECKED BY _____
PLOTTED BY _____ DATE _____ 19__

STATION	DIST	ANGLE	H. I. BEARING	VER. ANG. DIFF.	ELEVATION
11+34 ⁸⁰	4:20	RT	6" PINE		
11+30 ⁰⁰	2'	LT	12" PINE		
11+19 ³⁰	3.90'	LT.	12" PINE		
10+79 ⁵⁰	8'	RT.	14" PINE		
10+76 ⁰⁰	3'	RT.	14" PINE		
10+39 ⁵⁰	7'	RT.	20" GUM.		
10+37 ⁵⁰	12.50'	LT.	20" PINE		
10+20 ²⁰	20'	RT.	COR. M-412		
10+07 ⁴⁰			6' C' MARL WALK		
9+80 ⁸⁵			EDGE ST.		
9+62 ⁸⁰			EDGE ST.		
9+37 ⁴⁰	2.50'	LT.	END 8" TERR	PIPE	
9+31 ⁴⁰	2.40'	LT.	END 8" TERR	PIPE	
9+21 ²⁰	20'	RT.	COR. m-406		
8+00 ⁵⁰	20'	RT.	COR. m-406		
7+90 ³⁰	8.40'	RT.			
7+90 ³⁰	10.40'	LT.	OVERHEAD STEAM PIPE		
7+82 ²⁰			END 8" TERR	PIPE	
7+82 ⁵⁰			END 8" TERR	PIPE	
7+12 ⁵⁰	7'	LT.	14" PINE		
6+95 ²⁰	10.50'	LT.	14" PINE		
6+50 ²⁰	5'	RT.	16" PINE		
6+10 ³⁰	1.50'	LT.	10" PINE		
5+97 ⁶⁵	18'		COR. m-147		
5+65 ⁶⁵	18'		COR. m-167		
5+37	11'	RT.	14" GUM.		
5+28	11'	RT.	14" PINE		
5+14	20'	RT.	TEL. POWER POLE		

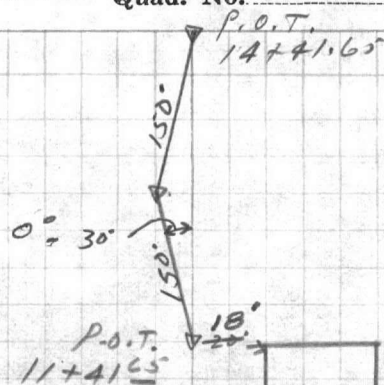

11+41.6










VALUABLE

SUBJECT _____

RETURN TO
PUBLIC WORKS
OFFICE
CAMP LEJEUNE
NORTH CAROLINA

FIELD PARTY

IN CHARGE

INSTRUMENT

NOTES

TAPE READ

TAPE OR ROD

TAPE OR ROD

INSTRUMENT NO.

TAPE NO.

WEATHER

CLEAR
CLOUDY
WINDY
RAIN
FAIR

SNOW
HOT
MODERATE
COLD
FOG

FILE No. _____

FLDR. No. _____

SHEET 3 of


FIGURED BY _____

NOTES CHECKED BY _____

PLOTTED BY _____ DATE _____ 19__

Quad. No. _____

STATION	DIST.	ANGLE ° ' "	+	H. I. BEARING	VER: ANG. DIFF.	ELEVATION
13+93 ⁸⁰		05'		LT END 18" PIPE		
13+85'		⊕ 10'		WOODS RD.		
13+61 ⁰⁰		9' RT.		15" PINE		
13+12		5' LT		5' GUMS		
13+03'		8.50' RT.		10" GUM		
12+93 ⁵⁰		20" GUM		⊕		
12+66 ⁵⁰		7' RT.		8" GUM.		
12+63 ⁰⁰		4.50' RT.		12" GUM.		
12+03 ⁵⁰		6' LT.		14" PINE		
11+97 ⁴⁵				WOOD LINE		
11+89 ⁰⁵		⊕ 10'		WOOD RD.		
11+61 ⁵⁵		11.50' RT.		OVERHEAD STEAM		
11+61 ⁶⁵		6.50' LT.				
11+44 ^{'5}		3' LT.		14" PINE		

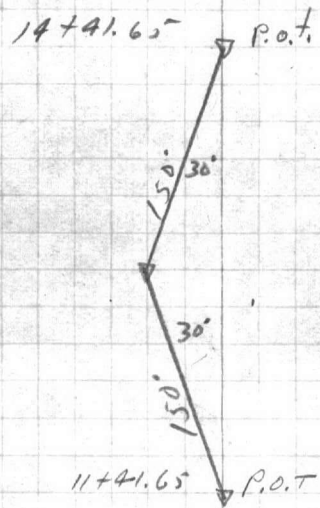

VALUABLE

SUBJECT _____

RETURN TO
PUBLIC WORKS
OFFICE
CAMP LEJEUNE
NORTH CAROLINA

FIELD PARTY

IN CHARGE

INSTRUMENT

NOTES

TAPE READ

TAPE OR ROD

TAPE OR ROD

INSTRUMENT No. _____

TAPE No. _____

WEATHER

CLEAR
CLOUDY
WINDY
RAIN
FAIR
SNOW
HOT
MODERATE
COLD
FOG
FIGURED BY _____
NOTES CHECKED BY _____
PLOTTED BY _____

FILE No. _____

FLDR. No. _____

SHEET 4 of

DATE _____ 19__

Quad. No. _____

STATION	DIST.	ANGLE ° ' "	+	H. I. BEARING	VER: ANG. DIFF.	ELEVATION
17+62		12' RT.		300 gal. Fuel Tank		
17+55		18' LT		10" PINE		
17+55		7' RT.		10" PINE		
17+45		12' RT.		Clothes line pole		
17+21		12' RT.		Clothes line pole		
17+00						
16+52		3' RT.		22" PINE		
16+24 ⁵⁰		3' LT		12" OAK		
16+19		3.20' LT.		8" S WOOD		
16+15 ⁵⁹		9' RT.		10" OAK		
16+00		5.50' ^{RT.} 8"		TWIN OAKS		
15+82 ⁸⁰		5.30' RT		7" OAK		
15+80 ⁰⁰		1' LT		10" GUM		
15+73 ⁵⁰		2' RT		12" OAK		
15+65 ³⁰		6' RT.		16" OAK		
15+42 ⁰⁰		18' RT.		COR M-423		
15+32		5' LT.		8" PINE		
15+09 ⁰⁰		7' LT.		10" PINE		
15+02 ⁵⁰		4' RT.		12" PINE		
14+77 ⁶⁵		6.50' LT.		10" PINE		
14+72 ⁰⁰		3' RT.		20" PINE		
14+21 ⁵⁰		18' RT.		COR. M-423		
14+18 ⁸⁰		3' LT.		18" PINE		
14+12'		2' RT.		15" PINE		

14+41⁶⁵

150'

M-423













 

VALUABLE

SUBJECT _____

 RETURN TO
 PUBLIC WORKS
 OFFICE
 CAMP LEJEUNE
 NORTH CAROLINA

126

FIELD PARTY

 _____ IN CHARGE
 _____ INSTRUMENT
 _____ NOTES
 _____ TAPE READ
 _____ TAPE OR ROD
 _____ TAPE OR ROD
 _____ INSTRUMENT No. _____
 _____ TAPE No. _____

WEATHER

 _____ CLEAR
 _____ CLOUDY
 _____ WINDY
 _____ RAIN
 _____ FAIR
 _____ SNOW
 _____ HOT
 _____ MODERATE
 _____ COLD
 _____ FOG

FILE No. _____

FLDR. No. _____


FIGURED BY _____ SHEET 5 of

NOTES CHECKED BY _____

PLOTTED BY _____ DATE 11/4 19__

Quad. No. _____

STATION	DIST.	ANGLE ° ' "	+	H. I. BEARING	VER: ANG. DIFF.	ELEVATION
20+35						(4" T.C. P 6' Lt) (Water valve 17' Lt)
20+34						14" Pine 15' Rt.
20+32						18" Pine 2' Lt.
20+27						Water M.H. 17' Lt.
20+22						End Bldg # 605 18' Rt.
20+15						Cor. Well House 10' Lt.
20+08						Power Cable - 9' Lt. 4" Cable Mh
20+02						Cor. Well House # M-626 10' Lt.
20+0						
19+95						Guy Wire 9' Lt.
19+88						20" Pine 1' Lt.
19+82						Power pole T.M.B. #16 7' Lt. + Cor Woods
19+62						14" Pine 2.5' Lt.
19+40						20" Pine 8' Rt.
19+36						Clothes Line pole 10' Rt.
19+06						6' Lt Cor. Thick Underbrush
19+01						18' Rt Cor. Bldg.
19+00						Clothes Line ^{po. 10} 10' Rt.
+98						18" Pine 2'
+81						Transformer power pole #1 M.B. 15 8' Lt.
+62						Guy Wire 10' Lt.
+44						24" Pine 8' Lt.
+32						14" Pine 10' Rt.
+28						14" pine 8' Lt.
18+16						24" Mettle pipe 12' Rt. 8' Lt to End p.p.
18+09						10" Pine 8' Lt.
18+00						
17+81						20" Pine 15' Lt.
17+74						10" Pine 3' Rt.
17+62						10" pine 15' Lt.

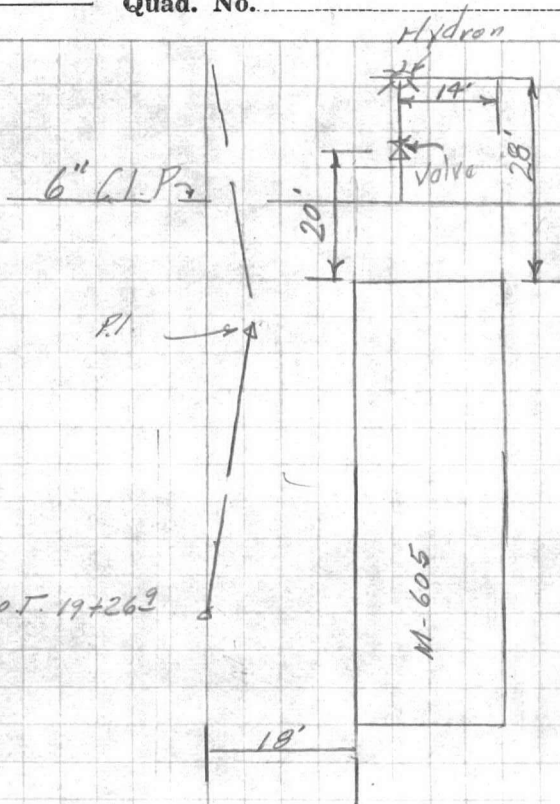

WATER




















VALUABLE

SUBJECT _____

RETURN TO
PUBLIC WORKS
OFFICE
CAMP LEJEUNE
NORTH CAROLINA

FIELD PARTY

IN CHARGE

INSTRUMENT

NOTES

TAPE READ

TAPE OR ROD

TAPE OR ROD

INSTRUMENT No.

TAPE No.

WEATHER

CLEAR _____
CLOUDY _____
WINDY _____
RAIN _____
FAIR _____

SNOW _____
HOT _____
MODERATE _____
COLD _____
FOG _____

FILE No. _____

FLDR. No. _____


FIGURED BY _____ SHEET 6 of

NOTES CHECKED BY _____

PLOTTED BY _____ DATE 11/4 1955

Quad. No. _____

STATION	DIST.	ANGLE " "	+	H. I. BEARING	VER. ANG. DIFF.	ELEVATION
28+39		15" Pine	11' Rt.			
28+26		9' Rd	Guy Wire			
28+02.3		2 Steam	4 Lt Steam pole	16' Rt. Steam pole		
28+00		22.3	Edge Rd.			
27+46		24"	Oak 10' Rt.			
26+74		15"	Pine 17' Rt.			
26+06		24"	Oak 13' Rt.			
25+38		20"	Oak 10' Rt.			
25+11		18"	Oak 17' Rt.			
24+56		10"	Oak 15' Rt.			
24+22.5		End Bldg # 617	18' Rt.			
24+11		14"	Oak 3' Lt.			
24+00						
23+75		24"	Oak 1' Lt.			
23+26		14"	Gum 7' Rt.			
23+21		12"	Pine 15' Lt.			
23+01.5		Cor Bldg # 617	18' Rt.			
22+93		14"	Pine 6' Rt.			
22+63		20"	Pine 9' Rt.			
22+42.5		Cor Bldg # 610	18' Rt.			
22+36		18"	Pine on E			
22+08		14"	Pine 3' Rt.			
22+0						
21+70		18"	Pine 3' Rt.			
21+21.5		Cor Bldg # 610	18' Rt.			
21+13		18"	Gum 10' Rt.			
20+96		21' Lt	to End 18" R.C.P			
20+80		Edge	Pavement			
20+60		Edge	Pavement			
20+39		9' Lt	End 18" R.C.P.			
20+38		6"	Water on E			

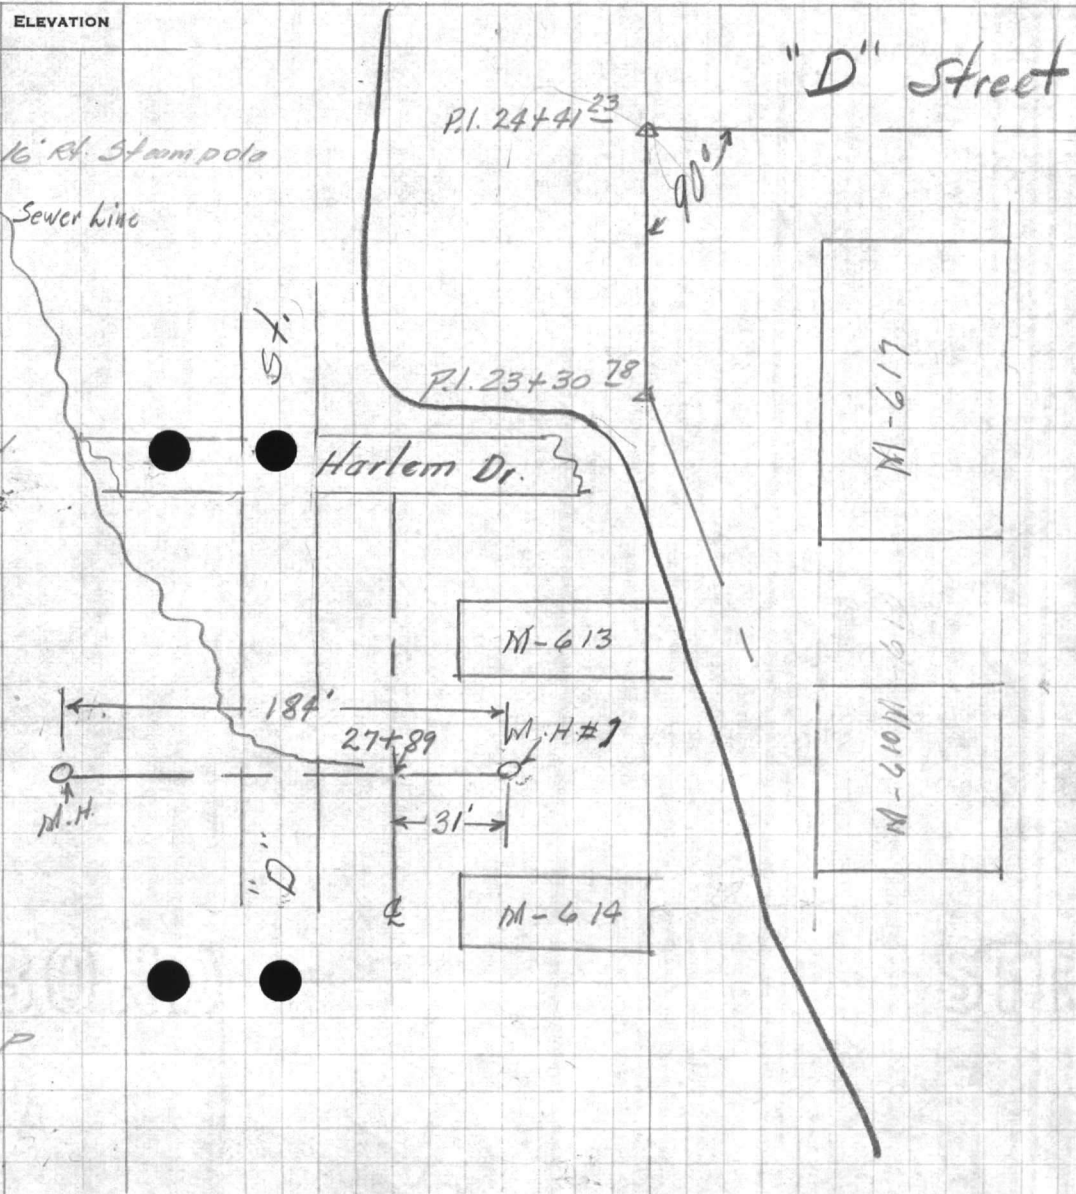

VALUABLE

SUBJECT _____

RETURN TO
 PUBLIC WORKS
 OFFICE
 CAMP LEJEUNE
 NORTH CAROLINA

FIELD PARTY

 IN CHARGE

 INSTRUMENT

 NOTES

 TAPE READ

 TAPE OR ROD

 TAPE OR ROD

 INSTRUMENT NO.


 TAPE NO. _____

WEATHER

CLEAR _____
 CLOUDY _____
 WINDY _____
 RAIN _____
 FAIR _____
 SNOW _____
 HOT _____
 MODERATE _____
 COLD _____
 FOG _____

FILE No. _____
 FLDR. No. _____
 SHEET 70f
 DATE _____ 19__

Quad. No. _____

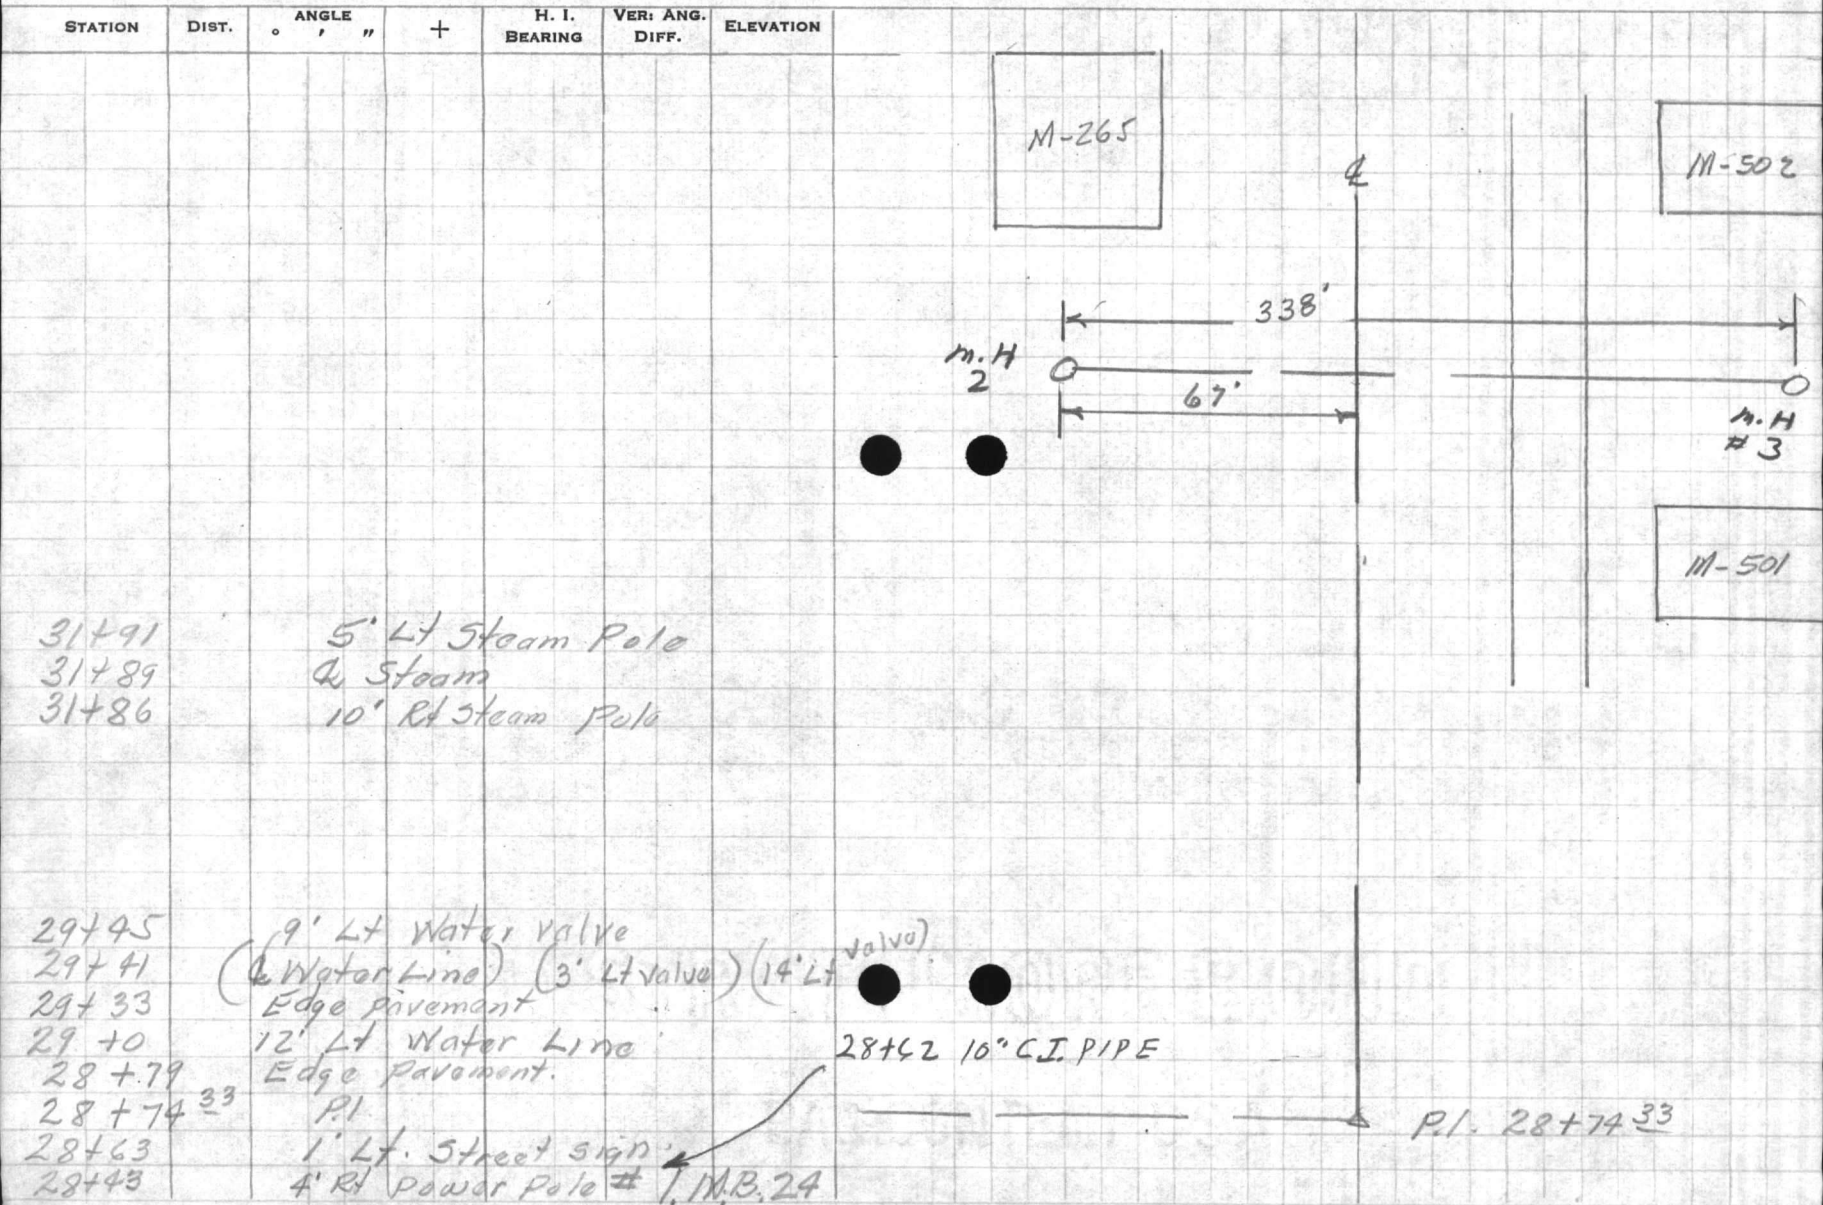

VALUABLE

SUBJECT Sewer M.H. Elev.
Water Treatment Facilities
Mountford Point
Line 'A'

RETURN TO
PUBLIC WORKS
OFFICE
CAMP LEJEUNE
NORTH CAROLINA

FIELD PARTY

IN CHARGE
INSTRUMENT
NOTES
TAPE READ
TAPE OR ROD
TAPE OR ROD
INSTRUMENT NO.
TAPE NO.


WEATHER

CLEAR
CLOUDY
WINDY
RAIN
FAIR
SNOW
HOT
MODERATE
COLD
FOG

FILE No. 95 Y
FLDR. No.
SHEET 6A
DATE 19

Quad. No.

STATION DIST. ANGLE H. I. VER. ANG. ELEVATION
" " + BEARING DIFF.

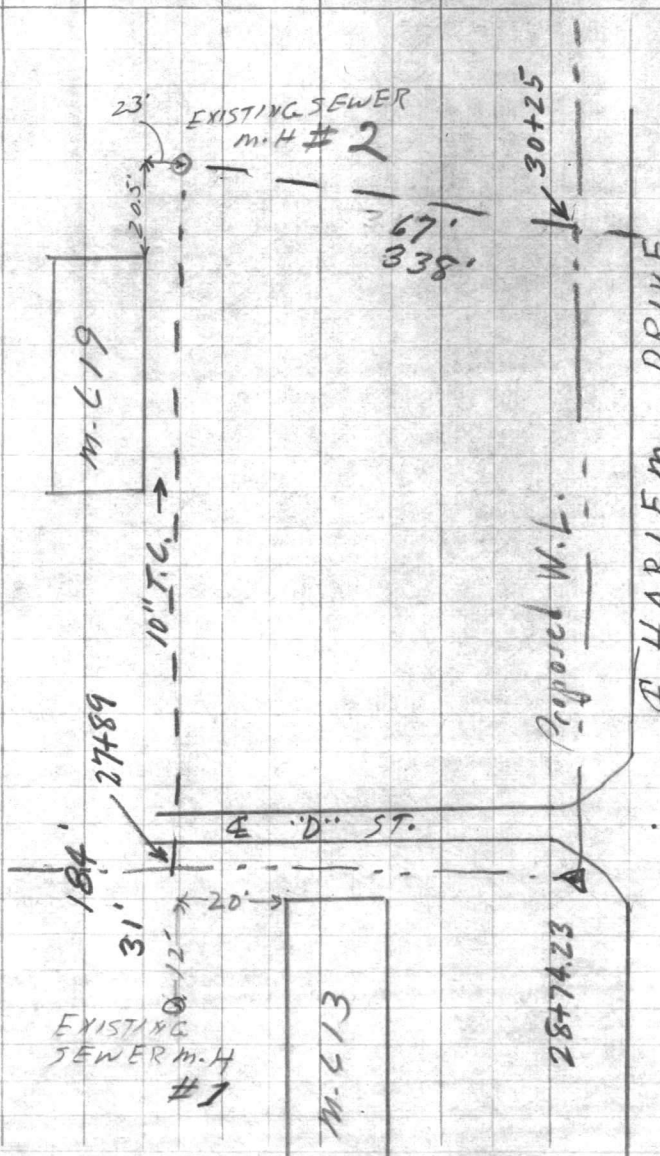

M.H. #2
H.I. 23.15
10.40
12.75

- 10.36 10" PIPE
- 10.40 12" PIPE

12" T.C. → 20.11
4.25
24.78
12.70
12.04

EXISTING SEWER M.H. #3

M.H. #3
H.I. 24.76
- 12.70 12" PIPE

23.16
H.I. 24.25 - 9.90 = 13.26
M.H. #1 10" PIPE OUTLET

Requires checking

VALUABLE

SUBJECT

Fl. Elev. Bldg. M-625

Heating Plant

RETURN TO
PUBLIC WORKS
OFFICE
CAMP LEJEUNE
NORTH CAROLINA

FIELD PARTY

IN CHARGE

INSTRUMENT

NOTES

TAPE READ

TAPE OR ROD

TAPE OR ROD

INSTRUMENT NO.

TAPE NO.

WEATHER

CLEAR
CLOUDY
WINDY
RAIN
FAIR
SNOW
HOT
MODERATE
COLD
FOG

FILE No. _____

FLDR. No. _____

SHEET *1 of*

NOTES CHECKED BY _____

PLOTTED BY _____

DATE _____ 19__

Quad. No. _____

STATION	DIST.	ANGLE ° ' "	+	H. I. BEARING	VER. ANG. DIFF.	ELEVATION	
<i>B.m.</i>				<i>493 25 04</i>		<i>20 11</i>	<i>T.P. AT 29+00 TACK IN PAVEMENT</i>
				<i>460 20 44</i>			<i>FL - M - 625</i>
				<i>932 15.72</i>			<i>TOP 10X10" TEE at Service to Bldg. # M-625</i>
							<i>END OF PROPOSED WATER LINE.</i>

VALUABLE

RETURN TO
PUBLIC WORKS
OFFICE
CAMP LEJEUNE
NORTH CAROLINA

SUBJECT

*Water Line Location
Montford Point*

FIELD PARTY

____ IN CHARGE
____ INSTRUMENT
____ NOTES
____ TAPE READ
____ TAPE OR ROD
____ TAPE OR ROD
____ INSTRUMENT NO.
____ TAPE NO.

WEATHER

CLEAR
CLOUDY
WINDY
RAIN
FAIR

SNOW
HOT
MODERATE
COLD
FOG

FIGURED BY _____

NOTES CHECKED BY _____

PLOTTED BY _____

FILE No. _____

F.L.D.R. No. _____

SHEET

6 B

DATE

11-4 1955

Quad. No. _____

STATION	DIST.	ANGLE ° ' "	+	H. I. BEARING	VER. ANG. DIFF.	ELEVATION
---------	-------	----------------	---	------------------	--------------------	-----------

P.I. 24+41.23

24+22.55

P.O.T.
23+30.78

Bldg.

617

Bldg.

610

P.O.T.
21+30.79











VALUABLE

SUBJECT Water Line Location
Montford Pt.

RETURN TO
PUBLIC WORKS
OFFICE
CAMP LEJEUNE
NORTH CAROLINA

FIELD PARTY

____ IN CHARGE
____ INSTRUMENT
____ NOTES
____ TAPE READ
____ TAPE OR ROD
____ TAPE OR ROD
____ INSTRUMENT NO.
____ TAPE NO.

WEATHER

CLEAR
CLOUDY
WINDY
RAIN
FAIR
SNOW
HOT
MODERATE
COLD
FOG

FILE No. _____

FLDR. No. _____

SHEET # 7A

DATE 11-4 1955

Quad. No. _____

28 74.33
20.62
100.00
74.33

STATION	DIST.	ANGLE ° ' "	+	H. I. BEARING	VER. ANG. DIFF.	ELEVATION
---------	-------	----------------	---	------------------	--------------------	-----------

sta. 29+0 tack in street
① P.I. 28+74.33

28+47.71

Bldg. # 613

← 18.68 → Bldg. # 614










VALUABLE

RETURN TO
PUBLIC WORKS
OFFICE
CAMP LEJEUNE
NORTH CAROLINA

SUBJECT LINE & PROFILE - T.D.P.D.
DN BRANCH 'A' NEAR
WELL M-141

FIELD PARTY
DENNIS IN CHARGE
____ INSTRUMENT
____ NOTES
____ TAPE READ
____ TAPE OR ROD
____ TAPE OR ROD
____ INSTRUMENT NO.
____ TAPE NO.

WEATHER
CLEAR _____ SNOW _____
CLOUDY _____ HOT _____
WINDY _____ MODERATE _____
RAIN _____ COLD _____
FAIR _____ FOG _____
FIGURED BY _____
NOTES CHECKED BY _____
PLOTTED BY _____

FILE No. _____
FLDR. No. _____
SHEET 2A of 10
DATE _____ 19__


Quad. No. _____

STATION	DIST.	ANGLE ' "	+	H. I. BEARING	VER: ANG. DIFF.	ELEVATION
				24 11		
0+52					49 21.2	GROUND SHOT
0+52	2.85'	LT.			8.87	8XL" TEE
					8.73	17.38
0+6250	7.25'	RT. COR.				
0+52	P.I.	6" W.L.				from Well # M-141
0+ 48.50 ^{49.2}	7.25'	RT. COR.				
0+4A	11.50'	RT. POLE # 1MA, J				
0+41	8.50'	LT. GUY WIRE				

49 21.2 GROUND SHOT
~~8.87~~
8.73 → 17.38

3+48.85
P.I. #1

8XL" TEE
8" C.I.

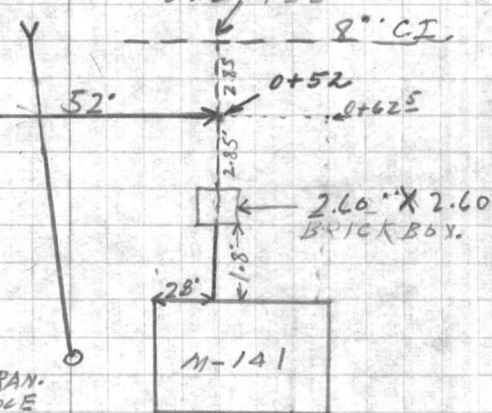

52.0	2.6
2.8	2.85
49.2	1.8
	7.25

VALUABLE

SUBJECT _____

RETURN TO
 PUBLIC WORKS
 OFFICE
 CAMP LEJEUNE
 NORTH CAROLINA

FIELD PARTY

 IN CHARGE

 INSTRUMENT

 NOTES

 TAPE READ

 TAPE OR ROD

 TAPE OR ROD

 INSTRUMENT NO. _____
 TAPE NO. _____

WEATHER

CLEAR _____
 CLOUDY _____
 WINDY _____
 RAIN _____
 FAIR _____
 SNOW _____
 HOT _____
 MODERATE _____
 COLD _____
 FOG _____

FILE No. _____

FLDR. No. _____

FIGURED BY _____ SHEET 10f

NOTES CHECKED BY _____

PLOTTED BY _____ DATE _____ 19__

Quad. No. _____

STATION	DIST.	ANGLE ' "	+	H. I. BEARING	VER. ANG. DIFF.	ELEVATION	
B. m.						20 11	TACK AT STA. 29+00
24+98				4.11	24.22		
25+05 ^S				Inv.	6.56		8.5' Lt. ^{to} end 10" C.I.P. Under Marl Walk.
25+85 ^S					6.50		" " " " " " " "
25+92 ^S					6.39		7' " " 6" " " " "
26+72 ^S					6.47		" " " " " " " "
26+81 ^o					6.46		6.8' " " " " " " " "
26+98					6.30		" " " " " " " "
26+98					6.13		1' Rt. ^{to} " 8' of 6" C.I.P. Under marl walk
26+98					5.99		Inlet end.
27+73					6.52		7' Lt. end 6" C.I.P. Under marl walk
27+81 ^S					6.37		" " " " " " " "
27+84					6.18		0.5' Rt. ^{to} end 8' of 6" C.I.P. Under marl walk
27+84					6.01		Inlet end 6" C.I.P. " " "
28+25 ^S					5.87		8' Lt. to end 6" C.I.P. Under marl walk
28+33					5.85		" " " " " " " "

$$\begin{array}{r} 568 \\ 88 \\ \hline 656 \end{array}$$

$$\begin{array}{r} 589 \\ 5 \\ \hline 639 \end{array}$$

$$\begin{array}{r} 597 \\ 5 \\ \hline 647 \end{array}$$

$$\begin{array}{r} 580 \\ 5 \\ \hline 630 \end{array}$$

$$\begin{array}{r} 568 \\ 5 \\ \hline 618 \end{array}$$

$$\begin{array}{r} 586 \\ 5 \\ \hline 646 \end{array}$$

$$\begin{array}{r} 563 \\ 5 \\ \hline 613 \end{array}$$

$$\begin{array}{r} 587 \\ 5 \\ \hline 637 \end{array}$$

$$\begin{array}{r} 535 \\ 5 \\ \hline 685 \end{array}$$

$$\begin{array}{r} 557 \\ 5 \\ \hline 607 \end{array}$$

$$\begin{array}{r} 537 \\ 5 \\ \hline 687 \end{array}$$

$$\begin{array}{r} 549 \\ 5 \\ \hline 599 \end{array}$$


VALUABLE

SUBJECT _____

RETURN TO
 PUBLIC WORKS
 OFFICE
 CAMP LEJEUNE
 NORTH CAROLINA

FIELD PARTY

 IN CHARGE

 INSTRUMENT

 NOTES

 TAPE READ

 TAPE OR ROD

 TAPE OR ROD

 INSTRUMENT NO. _____
 TAPE NO. _____

WEATHER

CLEAR
 CLOUDY
 WINDY
 RAIN
 FAIR

SNOW
 HOT
 MODERATE
 COLD
 FOG

FILE No. _____
 FLDR. No. _____
 SHEET 2 of _____
 DATE _____ 19____
 Quad. No. 265

STATION	DIST.	ANGLE " "	H. I. BEARING	VER. ANG. DIFF.	ELEVATION	
28+66			24.22	5.58		10' Rt. to Inlet end 6" C.I.P.
B.M.				4.11	20.11	TACK STA. 29+00
B.M.			5.35	24.25	18.90	On transformer pole N.E. Cor. ^{Bldg} M-265
32+65 ⁵⁰				8.71	13.54	Top 10" C.I. Water Line
B.M.				5.35	18.90	
B.M.			5.46	5.2		Top hub p.l. Sta. 24+41 ²³
				5.21		4" drain ^{Lt.} from well house # M-626
				6.32		Inlet. Inv. 15" R.C.P. ^{Lt. Mar} Under walk to well house
				6.46		outlet " " " " " " " "
B.M.				5.46		

VALUABLE

RETURN TO
PUBLIC WORKS
OFFICE
CAMP LEJEUNE
NORTH CAROLINA

SUBJECT PROFILE ON PROPOSED
WATER LINE

Line A

FIELD PARTY
DENNIS IN CHARGE
INSTRUMENT _____
NOTES _____
TAPE READ _____
TAPE OR ROD _____
TAPE OR ROD _____
INSTRUMENT NO. _____
TAPE NO. _____

WEATHER
CLEAR _____
CLOUDY _____
WINDY _____
RAIN _____
FAIR _____
SNOW _____
HOT _____
MODERATE _____
COLD _____
FOG _____
FIGURED BY _____
NOTES CHECKED BY _____
PLOTTED BY _____

FILE No. 984
FLDR. No. _____
SHEET 10 of 10
DATE 11-2 1955

Quad. No. _____

STATION	DIST.	ANGLE " "	+	H. I. BEARING	VER: ANG. DIFF.	ELEVATION	
B.m.			4.25	26.11		21.86	NAIL IN OVERHEAD STEAM POLE S. E. M-129.
0+00					4.9	21.2	HUB 5' INSIDE FENCE LINE
0+17					4.5	21.6	BANK
0+27					8.5	17.6	DITCH
0+30					7.3	18.8	
0+34					5.4	20.7	B. BANK
0+38 ⁸⁵	Edge Asphalt				5.15	20.96	EDGE PARKING + Drive
0+81 ⁶⁰	" "				4.95	21.16	EDGE PARKING + Drive
0+92					5.2	20.9	
1+00					4.8	21.3	
1+07					4.8	21.3	GROUND UNDER STEAM LINES
1+07					+ 8.80	34.91	OVER HEAD STEAM LINES
1+50					4.9	21.2	
2+0					4.8	21.3	
2+50					4.7	21.4	
2+98 ⁵⁰					4.81	21.3	12" SEWER LINE
"					13.18		Inv. " " "
3+00					4.8	21.3	

Cont. Sheet # 2

SECTION 1
SECTION 2
VALUABLE

SUBJECT _____

RETURN TO
PUBLIC WORKS
OFFICE
CAMP LEJEUNE
NORTH CAROLINA

FIELD PARTY

IN CHARGE

INSTRUMENT

NOTES

TAPE READ

TAPE OR ROD

TAPE OR ROD

INSTRUMENT NO.

TAPE NO.

WEATHER

CLEAR

CLOUDY

WINDY

RAIN

RAIN

FAIR

SNOW

HOT


MODERATE

COLD

FOG

FILE No. _____
FLDR. No. _____
SHEET 1 "A"
DATE _____ 19____

Quad. No. _____

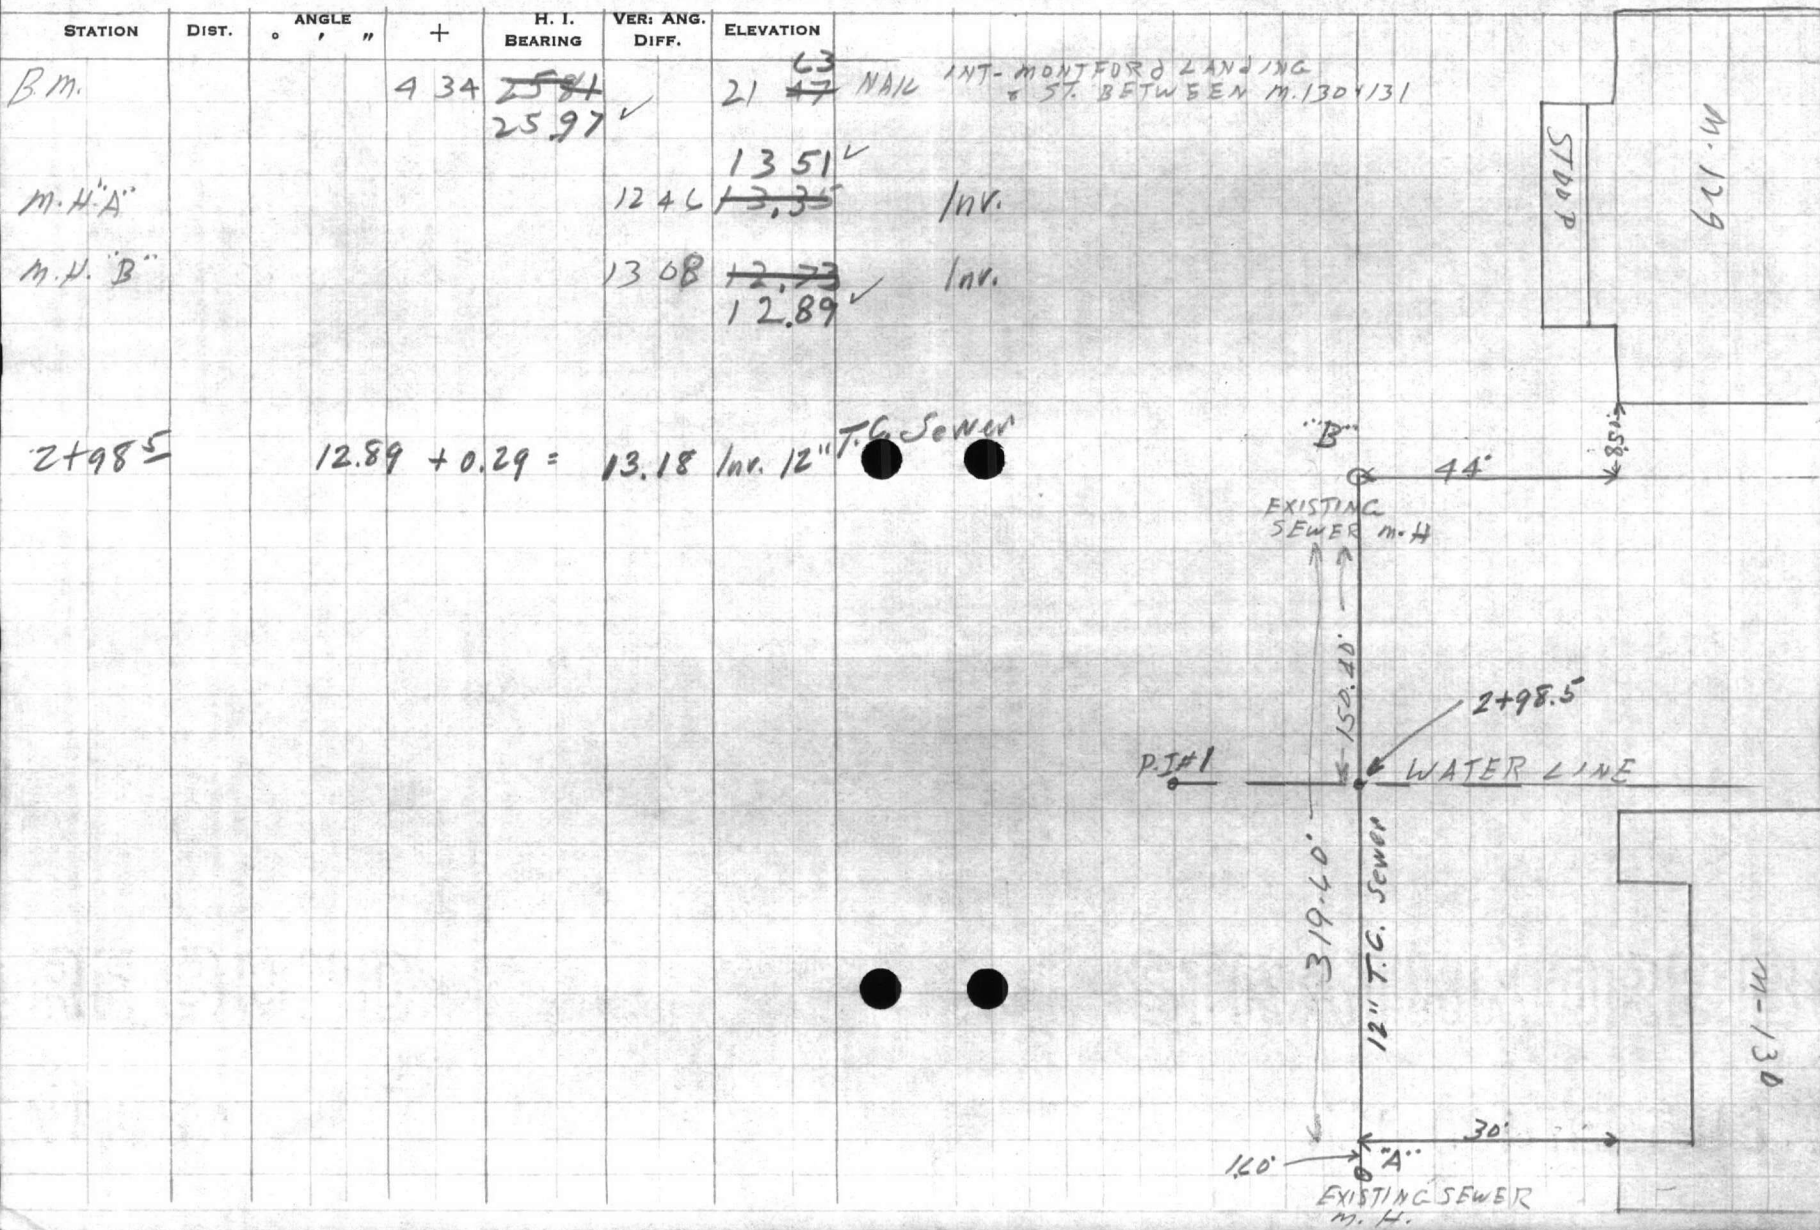

VALUABLE

SUBJECT _____

 RETURN TO
 PUBLIC WORKS
 OFFICE
 CAMP LEJEUNE
 NORTH CAROLINA

FIELD PARTY

 _____ IN CHARGE
 _____ INSTRUMENT
 _____ NOTES
 _____ TAPE READ
 _____ TAPE OR ROD
 _____ TAPE OR ROD
 _____ INSTRUMENT NO.
 _____ TAPE NO.

WEATHER

 CLEAR
 CLOUDY
 WINDY
 RAIN
 FAIR
 SNOW
 HOT
 MODERATE
 COLD
 FOG

FILE No. _____

FLDR. No. _____

SHEET 2 of 10

FIGURED BY _____ NOTES CHECKED BY _____

PLOTTED BY _____ DATE _____ 19__

Quad. No. _____

STATION	DIST.	ANGLE " "	+	H. I. BEARING	VER. ANG. DIFF.	ELEVATION	
3+48.85	PT			24.11 ✓	5.1	21.0	
T.P.				363 ✓	5.00	21.11 ✓	
4+0				24.74	3.5	21.2	
4+25.45	PI H2				3.6	21.1	
4+30.04					3.6	21.1	GROUND
4+36.09	Top 8" W.L.				8.50 8.54	16.24	WATER LINE 8"
4+43					3.8	20.9	BANK
4+47					5.4	19.3	DITCH
4+49					5.4	19.3	DITCH
4+56					3.3	21.4	BANK
4+59.44					3.17	21.5	GROUND LINE
4+59.49	Top Cable				6.43 6.29	18.45	UNDER TEL. CABLE
4+64.99	Edge Asphalt				2.93	21.81	EDGE ST.
4+84.89	" "				3.13	21.61	EDGE ST.
4+92					3.5	21.2	BANK
5+00					4.5	20.2	Cont. Sheet #3




























VALUABLE

SUBJECT _____

RETURN TO
PUBLIC WORKS
OFFICE
CAMP LEJEUNE
NORTH CAROLINA

FIELD PARTY

IN CHARGE

INSTRUMENT

NOTES

TAPE READ

TAPE OR ROD

TAPE OR ROD

INSTRUMENT No.

TAPE No.

WEATHER

CLEAR
CLOUDY
WINDY
RAIN
FAIR

SNOW
HOT
MODERATE
COLD
FOG

FILE No. _____

FLDR. No. _____

SHEET 30 of 10

FIGURED BY _____

NOTES CHECKED BY _____

PLOTTED BY _____

DATE _____ 19__

Quad. No. _____

STATION	DIST.	ANGLE ° ' "	+	H. I. BEARING	VER: ANG. DIFF.	ELEVATION	
				24.74	✓		
5+02				5 5		19.2	DITCH
5+09				4 0		20.7	BANK
5+21				4 06		20.6	GROUND AT 10" WATER LINE
5+21		Top		9.33 9.45		15.41	10" WATER LINE
5+59				4.25		20.5	GROUND AT POWER CABLE
5+59				-7.54	7.68	17.20	UNDER GROUND POWER CABLE
6+00				4.2		20.5	
6+50				5.3		19.4	
7+00				5.5		19.2	
7+50				5.4		19.3	
7+82 ⁵⁰				5.55		19.19	INLET 8" T.C. PIPE
7+88 ²⁹				5.58		19.16	OUTLET 8" T.C. PIPE
7+90 ³⁰				5.4		19.3	GROUND AT OVERHEAD STEAM PIPES
7+90 ²⁰		Under-side		+ 9 82		34.56	OVERHEAD STEAM PIPES
8+00				5 3		19.4	
8+50				5 2		19.5	
9+00				5 0		19.7	






VALUABLE

SUBJECT _____

RETURN TO
PUBLIC WORKS
OFFICE
CAMP LEJEUNE
NORTH CAROLINA

FIELD PARTY

IN CHARGE

INSTRUMENT

NOTES

TAPE READ

TAPE OR ROD

TAPE OR ROD

INSTRUMENT No. _____

TAPE No. _____

WEATHER

CLEAR

CLOUDY

WINDY

RAIN

FAIR

SNOW

HOT

MODERATE

COLD

FOG
FIGURED BY _____
NOTES CHECKED BY _____
PLOTTED BY _____

FILE No. _____

FLDR. No. _____

SHEET 9 of 10

DATE _____ 19__

Quad. No. _____

STATION	DIST.	ANGLE ° ' "	+	H. I. BEARING	VER: ANG. DIFF.	ELEVATION	
				2474 ✓	5.55 ✓	19.19	INLET 8"
9+31 ⁴⁰					5.55	19.19	T.C. PIPE
9+37 ⁴⁰					5.69	19.05	OUTLET 8"
T.P.			303 ✓	2376 ✓	4.01 ✓	20.73	T.C. PIPE
9+44					3.3	20.5	BANK
9+48					4.7	19.1	DITCH
9+52					3.3	20.5	BANK
9+62 ⁸⁰					3.22	20.54	EDGE ST.
9+80 ⁸⁵					3.24	20.52	EDGE ST.
9+92					3.3	20.5	BANK
9+95					5.0	18.8	DITCH
10+00					3.3	20.5	BANK
10+50					3.5	20.3	
11+00					3.9	19.9	
11+41 ⁴⁵ POT.					4.3	19.5	
11+50					4.4	19.4	

? Location

VALUABLE

SUBJECT _____

RETURN TO
PUBLIC WORKS
OFFICE
CAMP LEJEUNE
NORTH CAROLINA

FIELD PARTY

IN CHARGE

INSTRUMENT

NOTES

TAPE READ

TAPE OR ROD

TAPE OR ROD

INSTRUMENT No.

TAPE No.

WEATHER

CLEAR
CLOUDY
WINDY
RAIN
FAIR

SNOW
HOT
MODERATE
COLD
FOG

FILE No. _____

FLDR. No. _____

SHEET 5 of 10

FIGURED BY _____

NOTES CHECKED BY _____

PLOTTED BY _____ DATE _____ 19__

Quad. No. _____

STATION	DIST.	ANGLE			H. I. BEARING	VER. ANG. DIFF.	ELEVATION		
		°	'	"					
					23 76 ✓				
11+61 45					4 8	19.0		GROUND	
11+61 45					+10 74	34.50		OVERHEAD STEAM PIPES	
12+00					5 3	18.5		EDGE WOODS,	
12+50					7 0	16.8			
12+65					7 9	15.9			
13+00					8.1	15.7			
13+42					8.1	15.7			
13+62					5 3	18.5			
13+90					5 1	18.7		BANK	
13+94					7 10	16.66 17.04		INLET 18" METTLE PIPE ?	
13+98					4 6	19.2		BANK	
14+00					4.4	19.4			
T.P.					1 47	21 ✓ 22 94	3 29	20.47	
14+41 45	POT.				1.6	20.3			
14+50	P.T.				1.8	20.1			
15+00					1 6	20.3			

VALUABLE

SUBJECT _____

RETURN TO
PUBLIC WORKS
OFFICE
CAMP LEJEUNE
NORTH CAROLINA

FIELD PARTY

IN CHARGE

INSTRUMENT

NOTES

TAPE READ

TAPE OR ROD

TAPE OR ROD

INSTRUMENT NO.

TAPE NO.

WEATHER

CLEAR
CLOUDY
WINDY
RAIN
FAIR

SNOW
HOT
MODERATE
COLD
FOG

FILE No. _____

FLDR. No. _____

FIGURED BY _____ SHEET 6 of 10

NOTES CHECKED BY _____

PLOTTED BY _____ DATE _____ 19__

Quad. No. _____

STATION	DIST.	ANGLE ° ' "	+	H. I. BEARING	VER. ANG. DIFF.	ELEVATION	
				21 22.94			
15+50					2.2	19.7	
15+41					1.6	20.3	
16+00					3.8	18.1	
16+50					5.1	16.8	
17+00					4.3	15.6	
17+50					5.8	16.1	
18+00					6.1	15.8	
18+16					8.62	13.32	
18+16					8.84	13.10	
18+50					5.9	16.0	
19+00					3.8	18.1	
T.P.				478	23.294	19.00	
				24 78			
POT. 19+27					5.2	18.6	
19+50					4.5	19.3	
20+00					3.7	20.1	
20+08					3.55	20.2	
20+08				Top	4.35	19.43	

INLET
OUTLET 24" PIPE ? Location

GROUND
UNDER GROUND POWER CABLE

VALUABLE

SUBJECT _____

RETURN TO
PUBLIC WORKS
OFFICE
CAMP LEJEUNE
NORTH CAROLINA

FIELD PARTY

IN CHARGE

INSTRUMENT

NOTES

TAPE READ

TAPE OR ROD

TAPE OR ROD

INSTRUMENT NO.

TAPE NO.

WEATHER

CLEAR
CLOUDY
WINDY
RAIN
FAIR

SNOW
HOT
MODERATE
COLD
FOG

FILE No. _____

FLDR. No. _____

FIGURED BY _____ SHEET 7 of 10

NOTES CHECKED BY _____

PLOTTED BY _____ DATE _____ 19__

Quad. No. _____

STATION	DIST.	ANGLE ° ' "	+	H. I. BEARING	VER. ANG. DIFF.	ELEVATION	
				23 24.78			
20+33					3 5	20.3	BANK
20+38					4 80	19.0	GROUND.
20+38				Top	8 20	15.58	6" C.I. WATER LINE
20+41					5 9	17.9	DITCH
20+44					4 6	19.2	BANK
20+60					4 09	19.69	EDGE ST.
20+80					4 09	19.69	EDGE ST.
20+87					4 5	19.3	BANK
20+94					5 7	18.1	DITCH BANK
20+945 ^D					6 5	17.3	DITCH
20+97 ⁰⁰					6 6	17.2	DITCH
20+975 ⁰					5 7	18.1	DITCH BANK
21+00					5 1	18.7	
21+03					4 7	19.1	BANK
21+50					4 8	19.0	
22+00					4 9	18.9	




VALUABLE

SUBJECT _____

RETURN TO
 PUBLIC WORKS
 OFFICE
 CAMP LEJEUNE
 NORTH CAROLINA

FIELD PARTY

 IN CHARGE

 INSTRUMENT

 NOTES

 TAPE READ

 TAPE OR ROD

 TAPE OR ROD

 INSTRUMENT No. _____
 TAPE No. _____

WEATHER

CLEAR
 CLOUDY
 WINDY
 RAIN
 FAIR

SNOW
 HOT
 MODERATE
 COLD
 FOG

FILE No. _____

FLDR. No. _____

SHEET 8 of 10

FIGURED BY _____

NOTES CHECKED BY _____

PLOTTED BY _____

DATE _____ 19__

Quad. No. _____

STATION	DIST.	ANGLE " "	+	H. I. BEARING	VER: ANG. DIFF.	ELEVATION
				24.87 23.78	✓	
22+50					4.8	19.0
23+00					4.9	18.9
23+30	28 P.O.T.				4.4	19.4
23+50					4.3	19.5
24+00					4.3	19.5
24+38					4.4	19.4
24+41	23 P.J.				5.1	18.7 ✓
T.P.			4 AL	23.16 ✓ 24.75	5.08	18.70 19.79
24+50					4.4	18.8
25+00					3.9	19.3
25+50					3.8	19.4
26+00					4.3	18.9
26+50					4.0	19.2
27+00					4.2	19.0
27+50					3.9	19.3

VALUABLE

SUBJECT _____

RETURN TO
 PUBLIC WORKS
 OFFICE
 CAMP LEJEUNE
 NORTH CAROLINA

FIELD PARTY

 IN CHARGE

 INSTRUMENT

 NOTES

 TAPE READ

 TAPE OR ROD

 TAPE OR ROD

 INSTRUMENT NO. _____
 TAPE NO. _____

WEATHER

CLEAR _____
 CLOUDY _____
 WINDY _____
 RAIN _____
 FAIR _____
 SNOW _____
 HOT _____
 MODERATE _____
 COLD _____
 FOG _____
 FIGURED BY _____
 NOTES CHECKED BY _____
 PLOTTED BY _____


FILE No. _____
 FLDR. No. _____
 SHEET 9 of 10
 DATE _____ 19__

Quad. No. _____

STATION	DIST.	ANGLE ° ' "	+	H. I. BEARING	VER. ANG. DIFF.	ELEVATION	
27+89				23.16		13.26	Invert 10" T.C. Sewer
28+00				24.25	3 9	19.3	
28+55					3 4	19.8	BANK
28+60					4 8	18.4	DITCH
28+60					4 85	18.31	1' RT. 8" T.C. PIPE
28+62					3 60	19.6	BANK
28+62					6 70	16.46	TOP 10" C.I. WATER LINE
28+74 ²³	DI.				3 4	19.8	
28+79					3 35	19.81	EDGE ST.
29+00					3 07	20.09	
T.P.			3 04	23.15 24.24	3 05	20.11 21.20	
29+33					3 20	19.96	EDGE ST.
29+41					3 32	19.8	GROUND
29+41					7 07	16.08	TOP 8" C.I. WATER LINE
29+50					3 5	19.6	
30+00					4 7	18.4	



 

VALUABLE

SUBJECT _____

RETURN TO
 PUBLIC WORKS
 OFFICE
 CAMP LEJEUNE
 NORTH CAROLINA

FIELD PARTY

 IN CHARGE

 INSTRUMENT

 NOTES

 TAPE READ

 TAPE OR ROD

 TAPE OR ROD

 INSTRUMENT NO. _____
 TAPE NO. _____

WEATHER

CLEAR
 CLOUDY
 WINDY
 RAIN
 FAIR

SNOW
 HOT
 MODERATE
 COLD
 FOG

FILE No. _____
 FLDR. No. _____
 SHEET 10 of 10
 DATE _____ 19__

FIGURED BY _____
 NOTES CHECKED BY _____
 PLOTTED BY _____
 Quad. No. _____

STATION	DIST.	ANGLE ° ' "	+	H. I. BEARING	VER. ANG. DIFF.	ELEVATION	
				24.24 23.15	✓		
30+25					4.5	18.6	SEWER LINE
"						12.61	Invert 12" T.C. Sewer.
30+50					4 4	18.7	
31+00					3 9	19.2	
31+50					3 9	19.2	
32+00					4.5	18.6	
32+43						15.72	Top of Tee at service to Heating Plant.
32+53 ⁵⁰					4.9	18.2	
32+65 ⁵⁰					3 9	19.2	END LINE
B.M.					4 20	20.11 18.95	18.90° POWER POLE NEAR HEATING PLANT

Ground
 Inv.

12' Lt.

Ground











VALUABLE

RETURN TO
PUBLIC WORKS
OFFICE
CAMP LEJEUNE
NORTH CAROLINA

SUBJECT

add in fo.
Montford H. Raw water
line "A"

FIELD PARTY

IN CHARGE

INSTRUMENT

NOTES

TAPE READ

TAPE OR ROD

TAPE OR ROD

INSTRUMENT NO.

TAPE NO.

WEATHER

CLEAR
CLOUDY
WINDY
RAIN
FAIR
SNOW
HOT
MODERATE
COLD
FOG

FILE No. *98Y*

F.LDR. No. _____

FIGURED BY _____

SHEET _____

NOTES CHECKED BY _____

PLOTTED BY _____

DATE _____

19 _____

Quad. No. _____

STATION	DIST.	ANGLE ° ' "	+	H. I. BEARING	VER. ANG. DIFF.	ELEVATION	
<i>T.P.</i>				<i>5 02 24 30</i>		<i>21 28</i>	<i>ON M.H. # 2</i>
						<i>934 14.4</i>	<i>ON TOP ? CROSS</i>
<i>A+55' -</i>				<i>54' LT. 10"</i>		<i>58' LT. VALVE</i>	<i>42' LT. HYD.</i>
<i>STA. 5+21²⁰</i>				<i>54' LT. 10x10 TEE ?</i>		<i>10x10x8</i>	
				<i>57⁵⁰ LT. UNDER GROUND POWER CABLE</i>			
							<i>8" line to well</i>
							<i>Level. at conduit 21.2</i>
							<i>Top. " 19.2</i>

VALUABLE

RETURN TO
PUBLIC WORKS
OFFICE
CAMP LEJEUNE
NORTH CAROLINA


SUBJECT STAKED OUT PROPOSED
10" RAW WATER LINE
Treated

FIELD PARTY
DENNIS IN CHARGE
____ INSTRUMENT
____ NOTES
____ TAPE READ
____ TAPE OR ROD
____ TAPE OR ROD
____ INSTRUMENT No.
____ TAPE No.

WEATHER
CLEAR CLOUDY
WINDY RAIN
FAIR SNOW
HOT MODERATE
COLD FOG
FIGURED BY _____
NOTES CHECKED BY _____
PLOTTED BY _____

FILE No. 984
FLDR. No. _____
SHEET 1 of 3
DATE 11-28 1955

Quad. No. _____

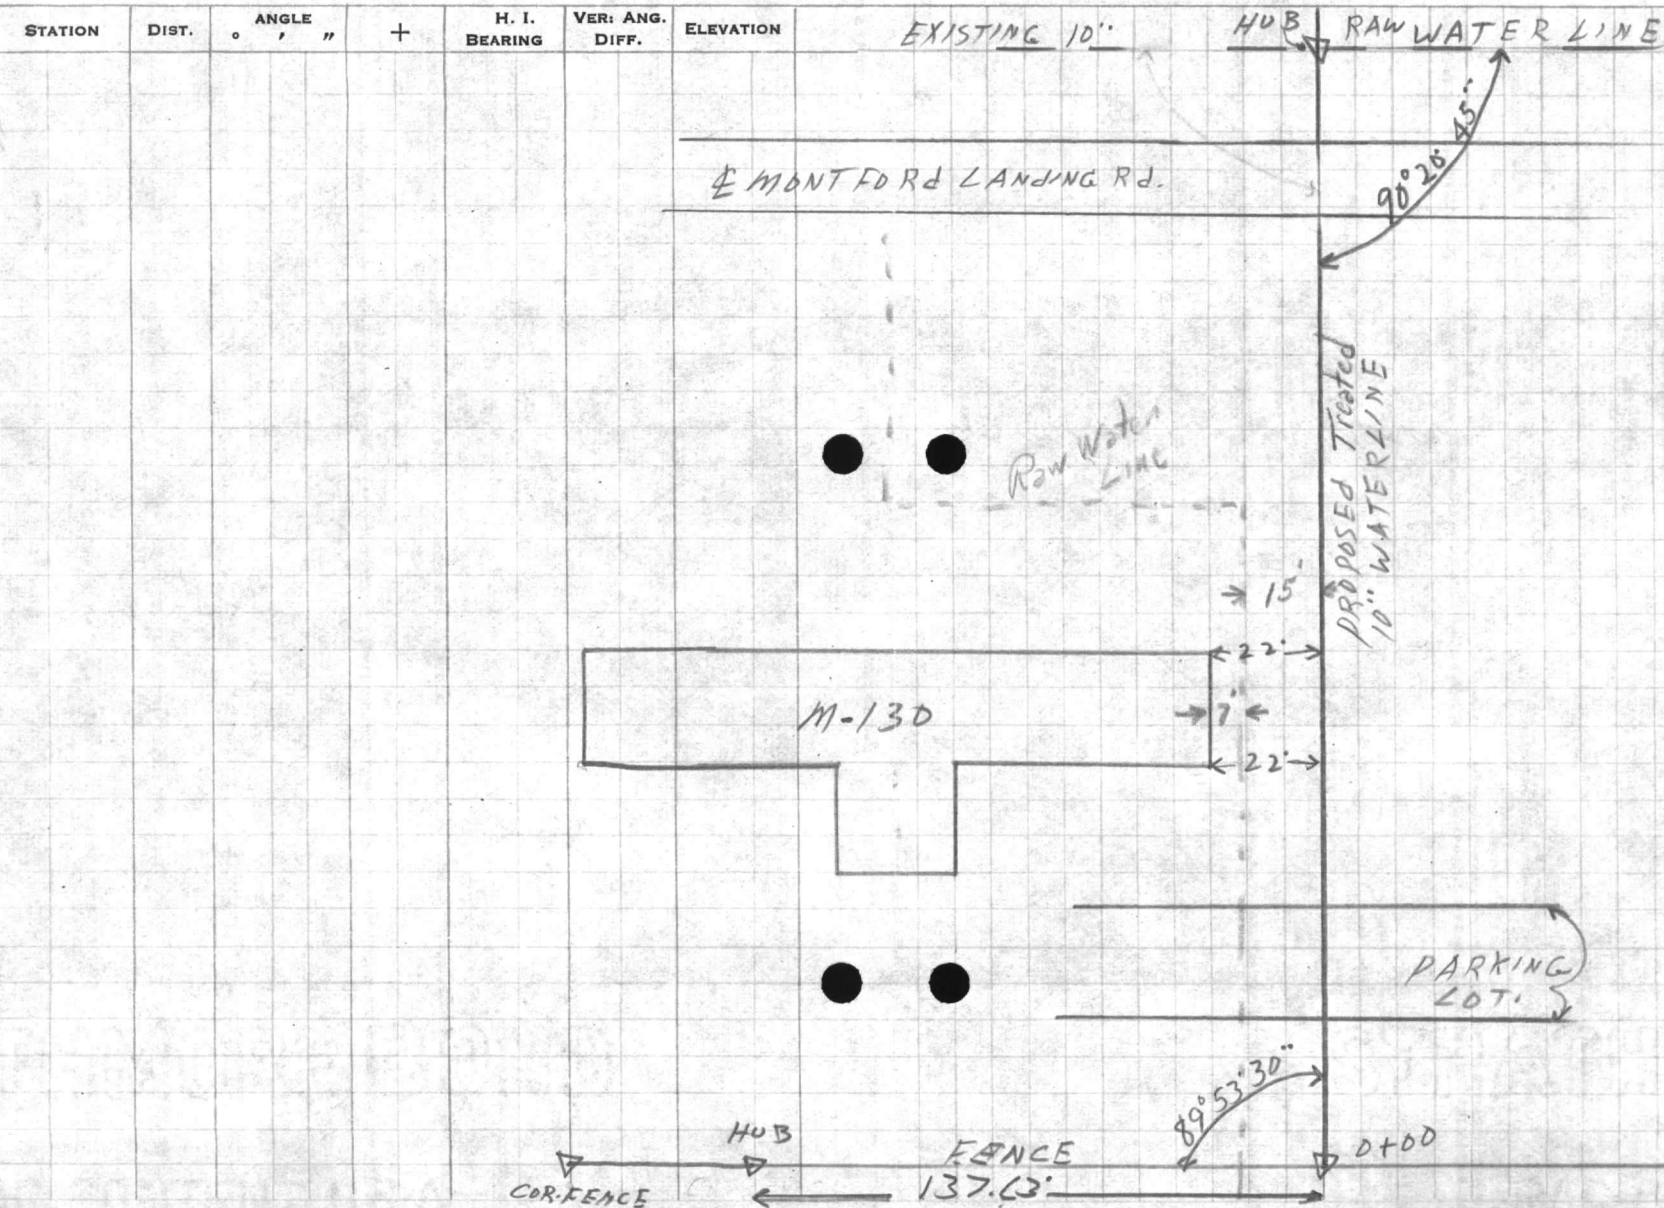









VALUABLE

SUBJECT _____

RETURN TO
PUBLIC WORKS
OFFICE
CAMP LEJEUNE
NORTH CAROLINA

FIELD PARTY

IN CHARGE

INSTRUMENT

NOTES

TAPE READ

TAPE OR ROD

TAPE OR ROD

INSTRUMENT NO.

TAPE NO.

WEATHER

CLEAR
CLOUDY
WINDY
RAIN
FAIR

SNOW
HOT
MODERATE
COLD
FOG

FILE No. _____

FLDR. No. _____

SHEET 2 of 3

FIGURED BY _____

NOTES CHECKED BY _____

PLOTTED BY _____ DATE _____ 19__

Quad. No. _____

STATION	DIST.	ANGLE " "	+	H. I. BEARING	VER. ANG. DIFF.	ELEVATION
4+36 ³⁰						TOP 10" RAW WATER LINE ✓
4+32 ¹⁰						13.80' RT. POWER POLE #1M 13
4+29 ³⁰						10.30' LT. STEAM POLE
4+05 ¹⁰						EDGE MONTFORD LA
3+83 ³⁰						EDGE MONTFORD LANDING RD.
3+45 ⁴⁰						⊕ 8" WATER LINE
3+08 ⁰⁰						7' LT. 20" PINE
2+74 ¹⁵						6.70 RT. 7.20' LT. STEAM POLES
2+68 ⁸⁰						⊕ C' MARL WALK.
2+64 ⁴⁵						22' LT. COR. WING M-130
2+01 ⁸⁴						22' LT. COR. WING M-130
1+33 ⁸⁰						10' RT. 16" PINE
1+12						10' RT. 16" PINE
1+02						4.40 LT. 13.40' RT. STEAM POLES
0+76 ³⁰						EDGE PARKING
0+33 ⁶⁰						EDGE PARKING
0+05						14' RT. Guy Wire from Pole Appx 34' Rt.

3+78⁰⁰ UNDERGROUND TEL. CABLE































































































































VALUABLE

SUBJECT Steam Pole Location

RETURN TO
PUBLIC WORKS
OFFICE
CAMP LEJEUNE
NORTH CAROLINA

Montford Point

FIELD PARTY

____ IN CHARGE
____ INSTRUMENT
____ NOTES
____ TAPE READ
____ TAPE OR ROD
____ TAPE OR ROD
____ INSTRUMENT NO.
____ TAPE NO.

WEATHER

CLEAR
CLOUDY
WINDY
RAIN
FAIR
SNOW
HOT
MODERATE
COLD
FOG

FILE No. _____

FLDR. No. _____


SHEET 3 of 3

FIGURED BY _____

NOTES CHECKED BY _____

PLOTTED BY _____ DATE _____ 19__

Quad. No. _____

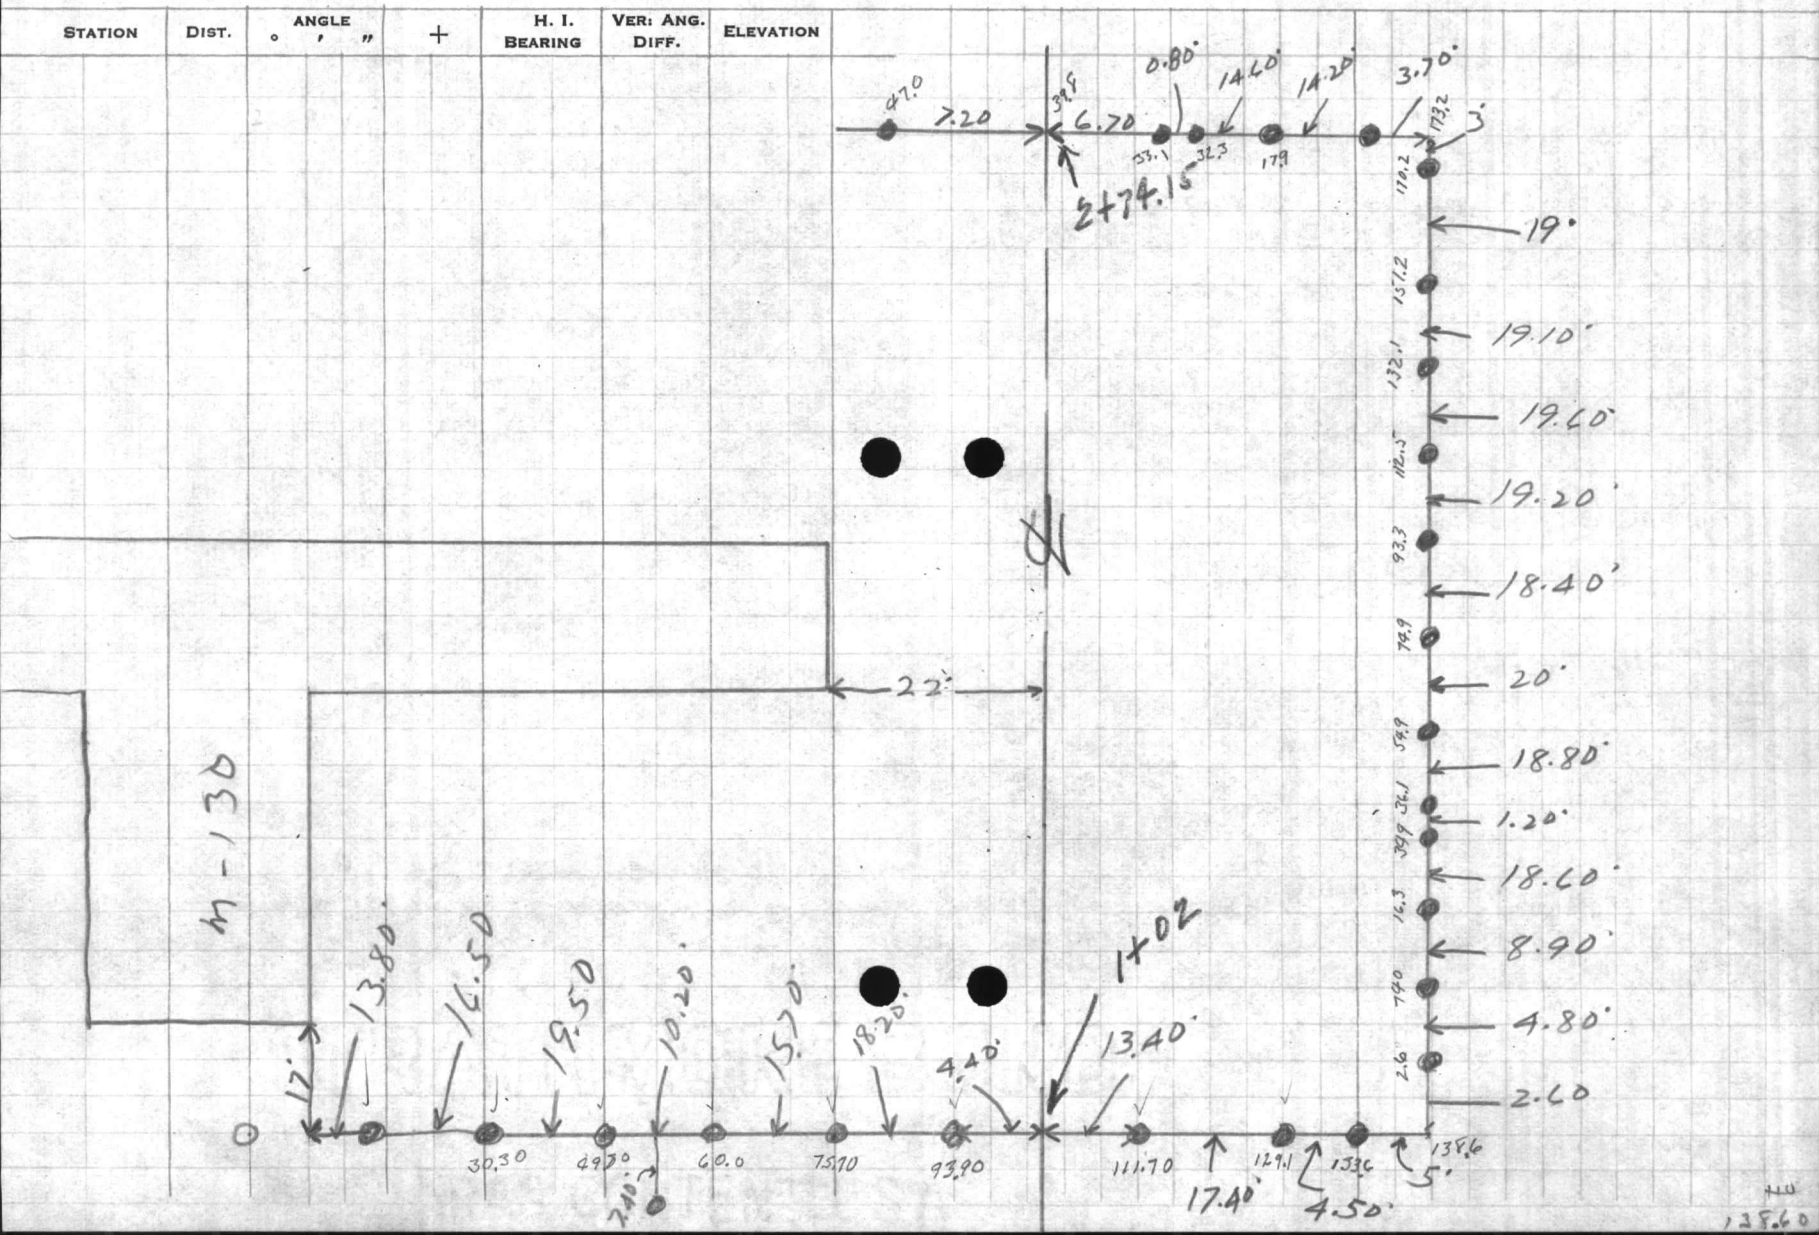

VALUABLE

RETURN TO
PUBLIC WORKS
OFFICE
CAMP LEJEUNE
NORTH CAROLINA

SUBJECT

*Bldg. Locations for Ties
to Construction Lay-out of Water
Treatment Plant at Montford Point.*

FIELD PARTY

IN CHARGE

INSTRUMENT

NOTES

TAPE READ

TAPE OR ROD

TAPE OR ROD

STRUMENT NO.

TAPE NO.

WEATHER


CLEAR
CLOUDY
WINDY
RAIN
FAIR
SNOW
HOT
MODERATE
COLD
FOG

FILE No. *98-Y*
FLDR. No. _____
SHEET _____
DATE _____ 19__

Quad. No. _____

STATION	DIST.	ANGLE ° ' "	H. I. BEARING	VER: ANG. DIFF.	ELEVATION
---------	-------	----------------	------------------	--------------------	-----------

Water Treatment Plant Site

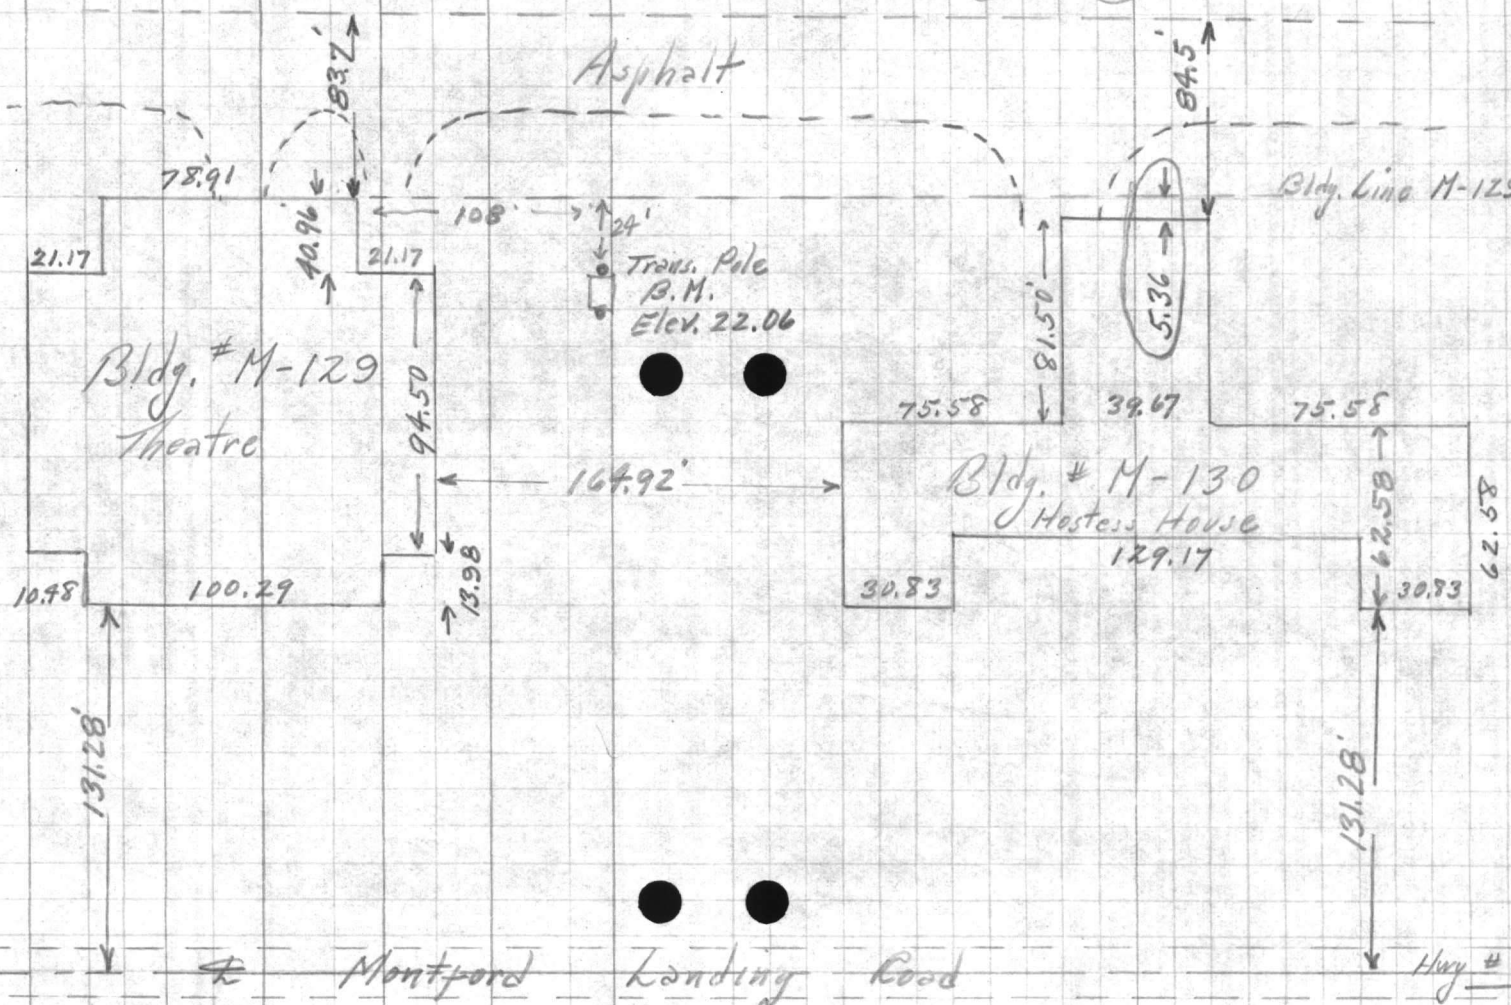

VALUABLE

SUBJECT Location for bearings ^{(10'}
Softening Plant Montford Point


RETURN TO
PUBLIC WORKS
OFFICE
CAMP LEJEUNE
NORTH CAROLINA

(Dis is) Morton IN CHARGE
INSTRUMENT _____
NOTES _____
TAPE READ _____
TAPE OR ROD _____
TAPE OR ROD _____
INSTRUMENT NO. _____
TAPE NO. _____

WEATHER
CLEAR _____
CLOUDY _____
WINDY _____
RAIN _____
FAIR _____
SNOW _____
HOT _____
MODERATE _____
COLD _____
FOG _____
FIGURED BY _____
NOTES CHECKED BY _____
PLOTTED BY _____
FILL No. 98-Y
FLDR. No. _____
SHEET 1 of 4
DATE 5/26 1954

Quad. No. _____

STATION	DIST.	ANGLE ° ' "	+	H. I. BEARING	VER: ANG. DIFF.	ELEVATION
---------	-------	----------------	---	------------------	--------------------	-----------

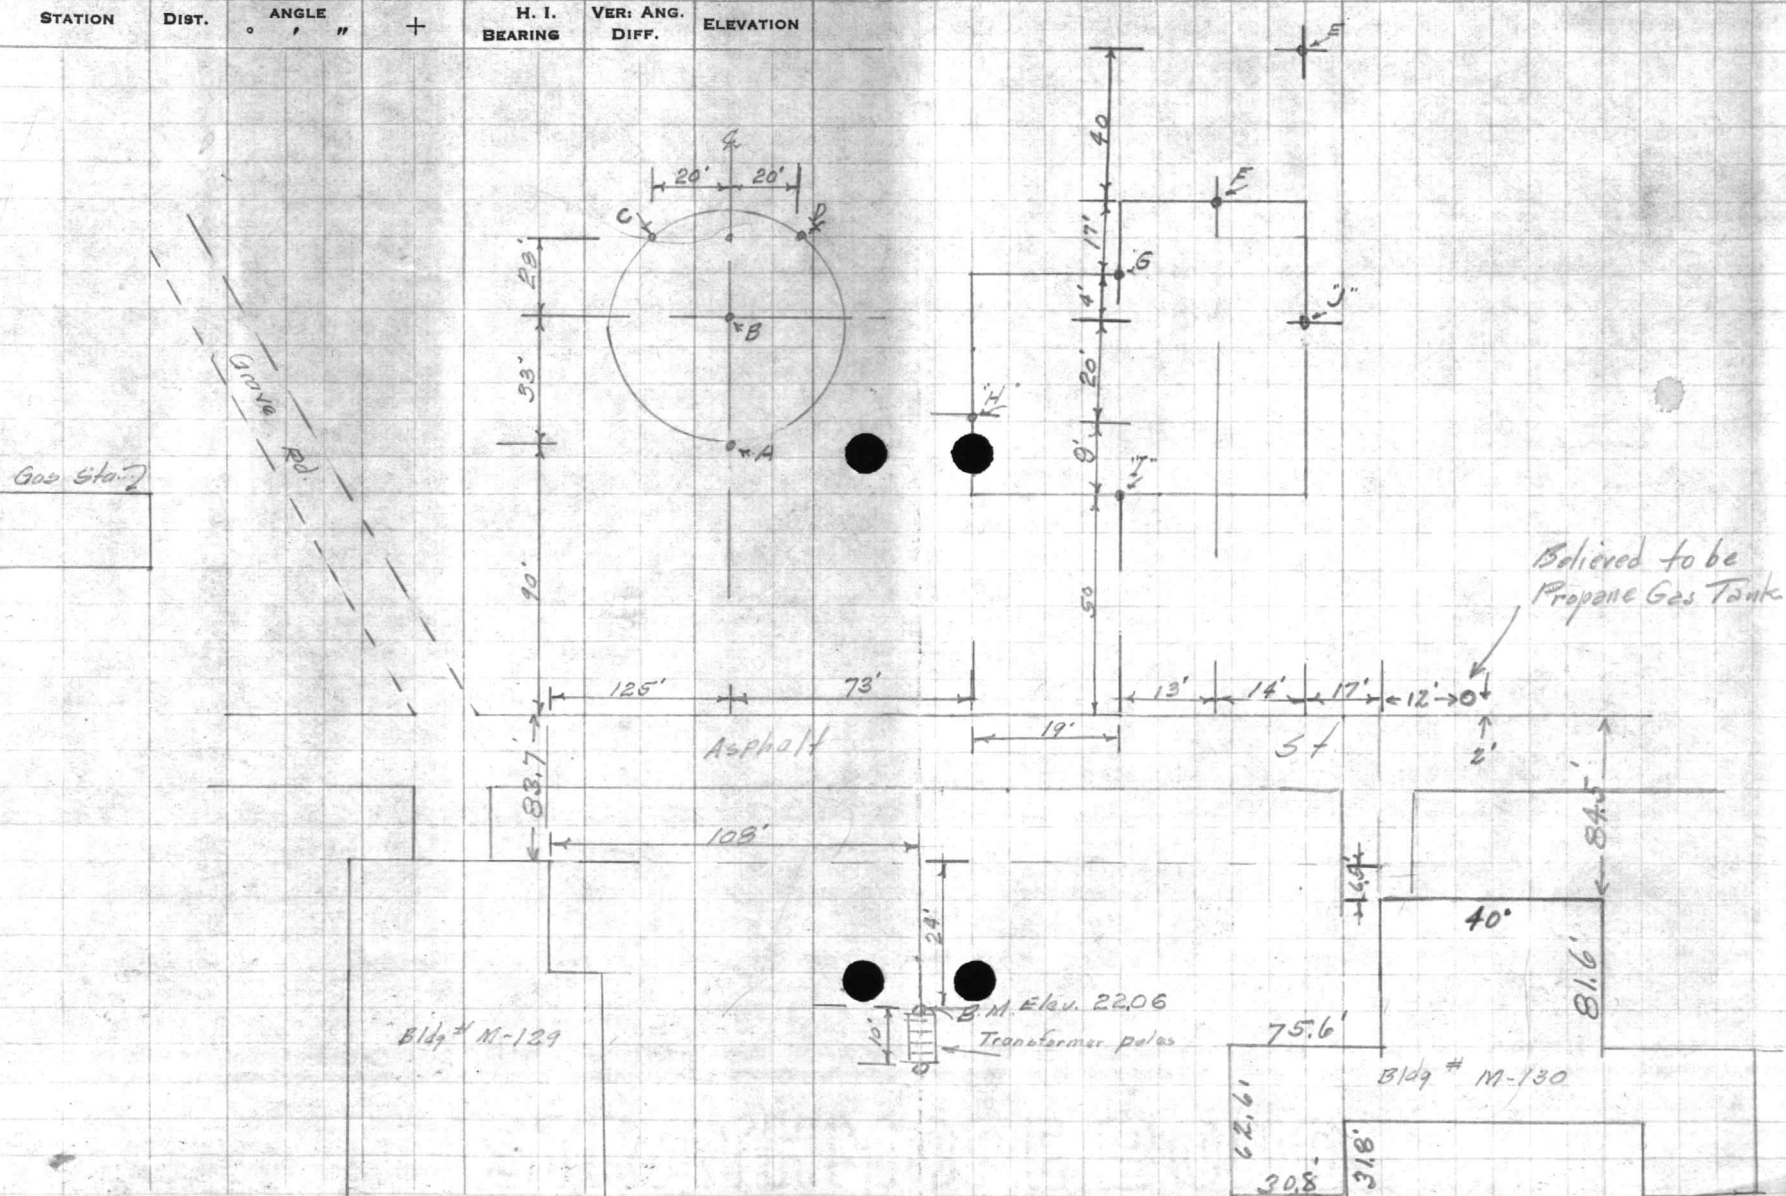

2
 50
 9
 20
 14
 17
 40
 150

1950
 1951
VALUABLE

SUBJECT Bench Elev for Water
Softening Plant Monitor Pt

RETURN TO
 PUBLIC WORKS
 OFFICE
 CAMP LEJEUNE
 NORTH CAROLINA

FIELD PARTY

Morton IN CHARGE
 _____ INSTRUMENT
 _____ NOTES
 _____ TAPE READ
 _____ TAPE OR ROD
 _____ TAPE OR ROD
 _____ INSTRUMENT NO.
 _____ TAPE NO.

WEATHER

CLEAR
 CLOUDY
 WINDY
 RAIN
 FAIR

SNOW
 HOT
 MODERATE
 COLD
 FOG

FILE No. _____
 FLDR. No. _____
 SHEET 2 of 4
 DATE 5/26 1954

FIGURED BY _____
 NOTES CHECKED BY _____
 PLOTTED BY _____
 Quad. No. _____

STATION	DIST.	ANGLE		+	H. I. BEARING	VER: ANG. DIFF.	ELEVATION	
		°	' "					
B.M.				3.75	25.61		21.06	spike in 2nd Steam Pole South Drive
B.M.						3.55	22.06	West Transformer Pole Between Bldgs. #129 and 130
				3.74	25.80			
B.M.						3.94	21.86	(21.06)
B.M.				3.55				

WILLIAMS

SUBJECT

STATION

DIR

TRAINING

DATE

WILLIAMS

RECORDS

DEPARTMENT

NOTES

TAPES

TAPES

TAPES

TAPES

WILLIAMS

RECORDS

DEPARTMENT

NOTES

TAPES

TAPES

TAPES

TAPES



VALUABLE

SUBJECT Elevs. on bearings for
water softening plant at
Montford Point.

RETURN TO
 PUBLIC WORKS
 OFFICE
 CAMP LEJEUNE
 NORTH CAROLINA

FIELD PARTY

 IN CHARGE

 INSTRUMENT

 NOTES

 TAPE READ

 TAPE OR ROD

 TAPE OR ROD

 INSTRUMENT NO. _____
 TAPE NO. _____

WEATHER

CLEAR _____
 CLOUDY _____
 WINDY _____
 RAIN _____
 FAIR _____
 SNOW _____
 HOT _____
 MODERATE _____
 COLD _____
 FOG _____

FILE No. _____
 FLDR. No. _____
 SHEET 3 of 4
 DATE 5/26 1954
 FIGURED BY _____
 NOTES CHECKED BY _____
 PLOTTED BY _____

Quad. No. _____

STATION	DIST.	ANGLE ° ' "	+	H. I. BEARING	VER. ANG. DIFF.	ELEVATION	
B.M.			3.55	25.61		22.06	on transformer pole between Bldg's 139 and 130
Bor. "A"					5.2	20.4	
" B"					5.4	20.2	
T.P.					4.66	20.95	
			3.94	24.89			
Bor "C"					4.5	20.4	
" D					4.7	20.2	
T.P.					3.94	20.95	
			4.90	25.85			
B.M.					3.79	22.06	(22.06)
			4.07	26.13			
Bor "I"					5.1	21.0	
T.P.					4.59	21.54	
			3.47	25.01			
Bor "H"					4.7	20. ³ 5	
" G"					4.5	20.5	
" J"					5.3	19.7	
" F"					4.5	20.5 20.5	

VALUABLE



















































VALUABLE

SUBJECT _____

RETURN TO
 PUBLIC WORKS
 OFFICE
 CAMP LEJEUNE
 NORTH CAROLINA

FIELD PARTY

 IN CHARGE

 INSTRUMENT

 NOTES

 TAPE READ

 TAPE OR ROD

 TAPE OR ROD

 INSTRUMENT NO. _____
 TAPE NO. _____

WEATHER

CLEAR _____
 CLOUDY _____
 WINDY _____
 RAIN _____
 FAIR _____
 SNOW _____
 HOT _____
 MODERATE _____
 COLD _____
 FOG _____

FILE No. _____
 FLDR. No. _____
 SHEET 4 of 4
 DATE 5/26 1954

FIGURED BY _____
 NOTES CHECKED BY _____
 PLOTTED BY _____
 Quad. No. _____

STATION	DIST.	ANGLE			H. I.	VER. ANG.	ELEVATION
		°	'	"	BEARING	DIFF.	
					25.01		
T.P.						3.58	21.43
					3.04	24.47	
Bar "E"						4.9	19.6
T.P.						3.47	21.00
					4.83	25.83	
B.M.						3.78	22.05

(22.06)

VALUABLE



























VALUABLE

SUBJECT Test Soil Borings

Water Treatment Plant
Montford Point

RETURN TO
PUBLIC WORKS
OFFICE
CAMP LEJEUNE
NORTH CAROLINA

FIELD PARTY

Morton IN CHARGE
____ INSTRUMENT
____ NOTES
____ TAPE READ
____ TAPE OR ROD
____ TAPE OR ROD
____ INSTRUMENT NO.
____ TAPE NO.

WEATHER

CLEAR
CLOUDY
WINDY
RAIN
FAIR

SNOW
HOT
MODERATE
COLD
FOG

FILE No. _____

FLDR. No. _____

SHEET # 1 of 4

DATE 6/4/1954


FIGURED BY _____

NOTES CHECKED BY _____

PLOTTED BY _____

Quad. No. _____

STATION	DIST.	ANGLE		+	H. I. BEARING	VER: ANG. DIFF.	ELEVATION
		°	"				

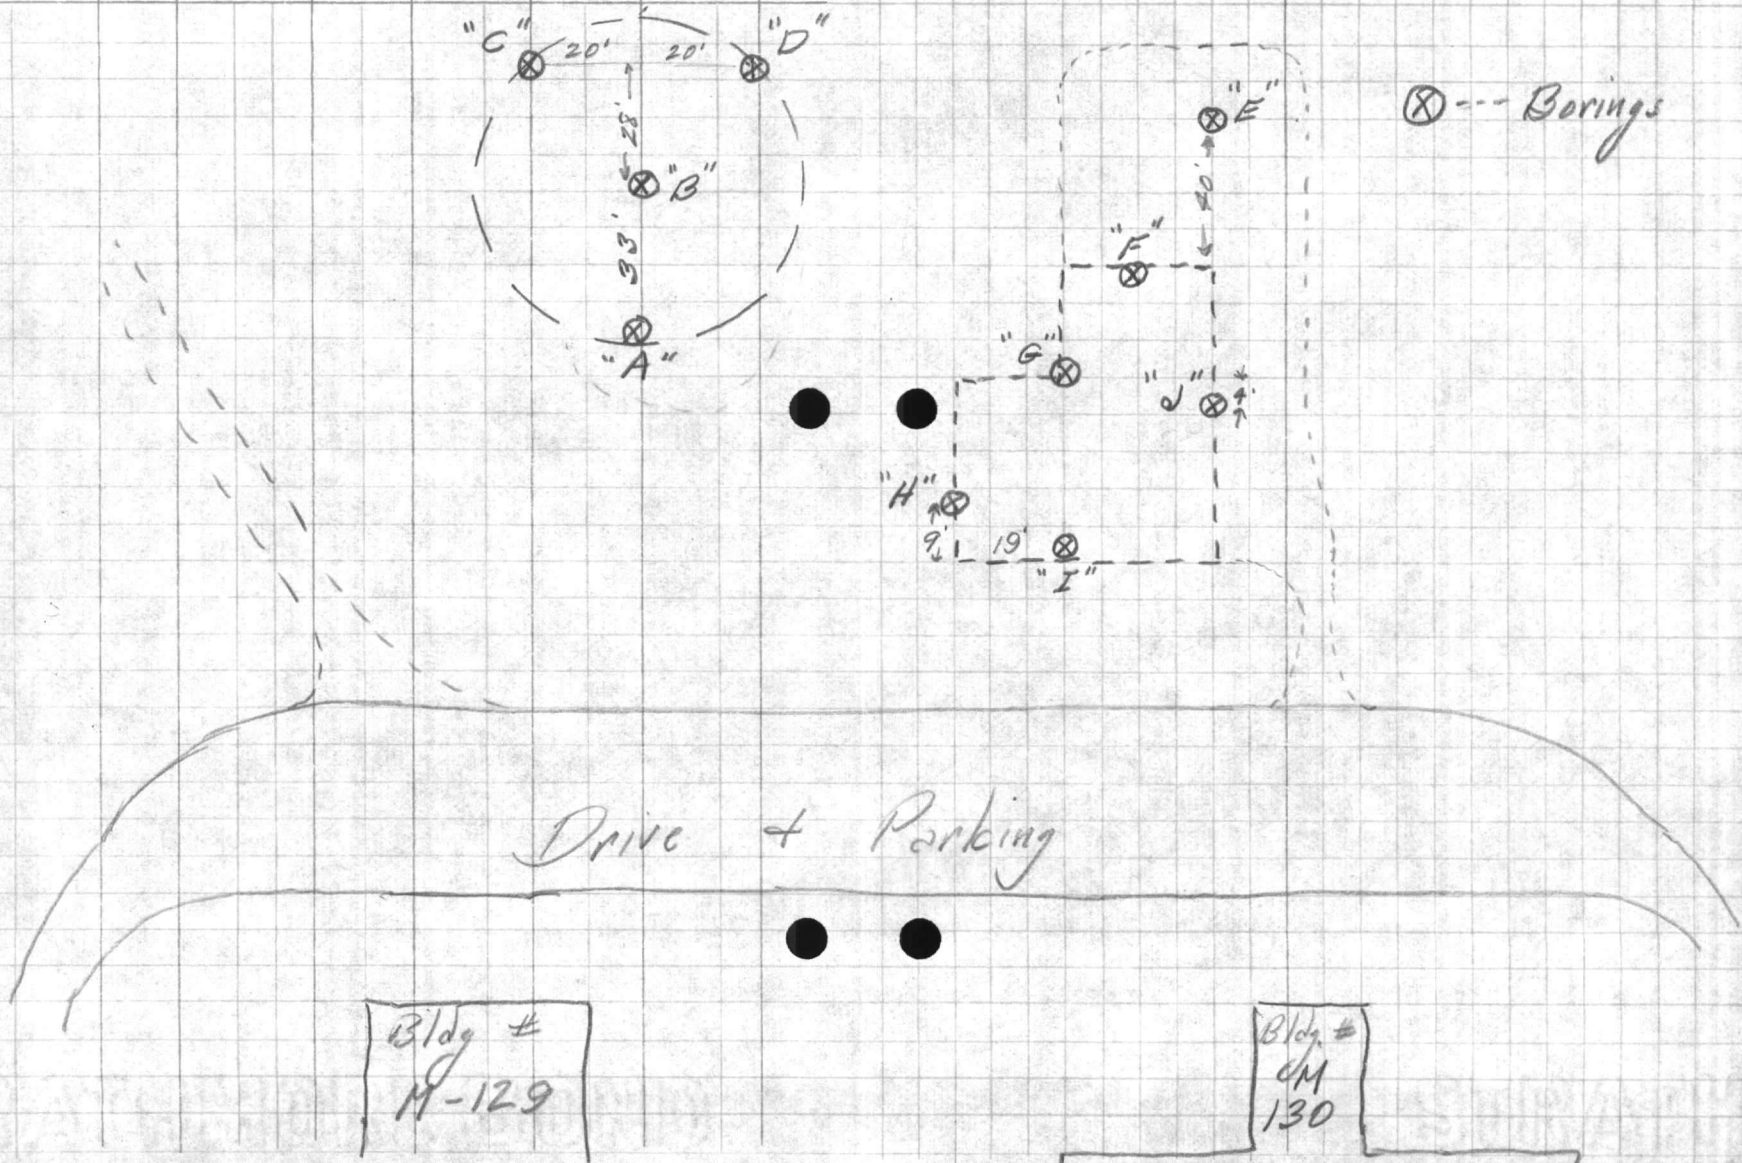





















































VALUABLE

SUBJECT TEST BORING FOR
PROPOSED WATER
TREATING PLANT AT
MONTFORT PT.

RETURN TO
PUBLIC WORKS
OFFICE
CAMP LEJEUNE
NORTH CAROLINA

FIELD PARTY

DENNIS IN CHARGE
INSTRUMENT
NOTES
TAPE READ
TAPE OR ROD
TAPE OR ROD
INSTRUMENT NO.
TAPE NO.


WEATHER

CLEAR
CLOUDY
WINDY
RAIN
FAIR
SNOW
HOT
MODERATE
COLD
FOG
FIGURED BY
NOTES CHECKED BY
PLOTTED BY

FILE No.
FLDR. No.
SHEET 314 A
DATE 6-7 1954

Quad. No.

STATION	DIST.	ANGLE " "	H. I. BEARING	VER. ANG. DIFF.	ELEVATION	
BORING # "I"						GROUND -1.0' TOP SOIL ✓ GREY SAND ✓ 100% -7.0' --- YELLOW CLAY 90% -9.0' GREY SAND WATER TABLE -9.0' -10.0' --- 10% STILL IN SAME AT -10.0'
BORING # "H"						GROUND -1.0' TOP SOIL ✓ GREY SAND ← 100% -4.0' --- YELLOW CLAY ✓ 90% -8.5' --- WATER TABLE -8.5' GREY SAND 10% -10.0' --- STILL IN SAME AT -10.0'
BORING # "G"						GROUND -1.0' TOP SOIL ✓ GREY SAND 100% -4.0' --- YELLOW CLAY ✓ 90% GREY SAND 10% -10.0' --- STILL IN SAME AT -10.0' NO WATER TABLE

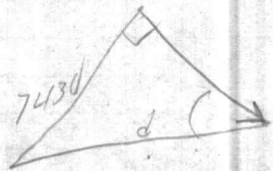

$$\sin \approx$$

VALUABLE

SUBJECT _____

 RETURN TO
 PUBLIC WORKS
 OFFICE
 CAMP LEJEUNE
 NORTH CAROLINA

FIELD PARTY

 _____ IN CHARGE
 _____ INSTRUMENT
 _____ NOTES
 _____ TAPE READ
 _____ TAPE OR ROD
 _____ TAPE OR ROD
 _____ INSTRUMENT NO.
 _____ TAPE NO.

WEATHER

 CLEAR
 CLOUDY
 WINDY
 RAIN
 FAIR
 SNOW
 HOT
 MODERATE
 COLD
 FOG

FILE No. _____

FLDR. No. _____

SHEET 4 of 4

DATE _____ 19__

Quad. No. _____

STATION	DIST.	ANGLE ° ' "	+	H. I. BEARING	VER. ANG. DIFF.	ELEVATION
---------	-------	----------------	---	------------------	--------------------	-----------

BORING # "F"

GROUND	
- 1.0' TOP SOIL	
GREY SAND	100%
- 4.0' -----	
YELLOW CLAY	90%
GREY SAND	10%
- 10.0' NO WATER	STILL IN SAME AT - 10.0'

BORING # "E"

GROUND	
- 1.0' TOP SOIL	
GREY SAND	100%
- 4.1' -----	
YELLOW CLAY	90%
GREY SAND	10%
- 10.0' NO WATER	STILL IN SAME AT - 10.0'

BORING # "J"

GROUND	
- 1.0' TOP SOIL	
GREY SAND	100%
- 3.8' -----	
YELLOW CLAY	90%
GREY SAND	10%
- 10.0' NO WATER	STILL IN SAME AT - 10.0'






























9.37
 5.73
 15.10
 5.20

15.10 9.90
 5.20 2.24
 9.90 12.14
 2.24
 12.14

891
 1095
 1986

19.42
 11.14
 8.26
 9.90 8.058

10.24
 5.73
 16.00
 5.20

10.80
 2.24
 13.04
 4.40
 8.64

1214
 Bridge 440
 774

VALUABLE

SUBJECT WATER LINE LOCATION AND Elevation, Also construction
B.M. FOR SEWER CONNECTION TO Proposed service station

RETURN TO
PUBLIC WORKS
OFFICE
CAMP LEJEUNE
NORTH CAROLINA

FIELD PARTY

Kellum IN CHARGE
 _____ INSTRUMENT
 _____ NOTES
 _____ TAPE READ
 _____ TAPE OR ROD
 _____ TAPE OR ROD
 _____ INSTRUMENT NO.
 _____ TAPE NO.

WEATHER

CLEAR
CLOUDY
WINDY
RAIN
FAIR

SNOW
HOT
MODERATE
COLD
FOG

FILE No. 987
 FLDR. No. _____
 SHEET 1-071
 DATE 6-18-1953

Quad. No. _____

STATION	DIST.	ANGLE " "	+	H. I. BEARING	VER. ANG. DIFF.	ELEVATION
---------	-------	--------------	---	------------------	--------------------	-----------

STATION	DIST.	ANGLE " "	+	H. I. BEARING	VER. ANG. DIFF.	ELEVATION
						← TO MC. #29 Matford Landings Rd.
B.M.						19.99
		5.84		25.83		MON. #106
T.P.					4.50	21.33
		4.34		25.67		
Top 3" C.I. water pipe					9.26	16.41
B.M. (T.P.)					3.80	21.87
		3.72		25.59		21.88 ^{Adjusted}
						21.86
T.P.					4.42	21.17
		4.90		26.07		
B.M.					6.06	20.01
						19.99

MON. #106

M-129

spike in 4th steam pole south of paved drive ON south side of Bldg. #129

53'

8.8'

3" C.I. WATER

11




VALUABLE

RETURN TO
PUBLIC WORKS
OFFICE
CAMP LEJEUNE
NORTH CAROLINA

SUBJECT

*Location of Flood
light Poles Bucket Bldg #
129*

FIELD PARTY

C. W. K.
IN CHARGE
INSTRUMENT
NOTES
TAPE READ
TAPE OR ROD
TAPE OR ROD
INSTRUMENT NO.
TAPE NO.

WEATHER

CLEAR
CLOUDY
WINDY
RAIN
FAIR
SNOW
HOT
MODERATE
COLD
FOG

FILE No. _____

FLDR. No. _____

SHEET *1021*

DATE *6-5* 19 *33*


FIGURED BY _____

NOTES CHECKED BY _____

PLOTTED BY _____

Quad. No. _____

STATION	DIST.	ANGLE ° ' "	+	H. I. BEARING	VER: ANG. DIFF.	ELEVATION
---------	-------	----------------	---	------------------	--------------------	-----------

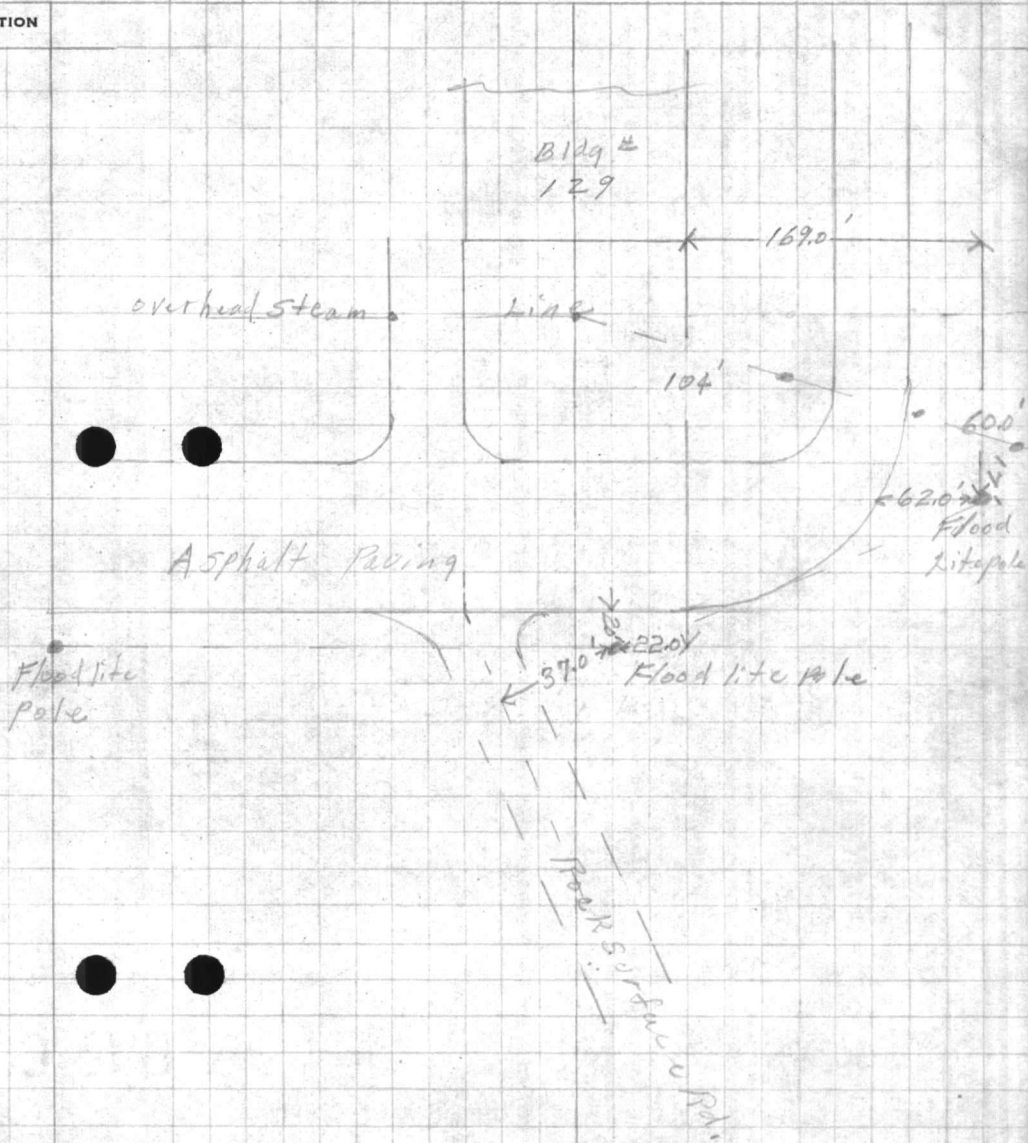













VALUABLERETURN TO
PUBLIC WORKS
OFFICE
CAMP LEJEUNE
NORTH CAROLINA

SUBJECT

Location of sewage
near M-129 Montford Rd

FIELD PARTY

Caulk
IN CHARGE
INSTRUMENT
NOTES
TAPE READ
TAPE OR ROD
TAPE OR ROD
INSTRUMENT NO.
TAPE NO.

WEATHER

CLEAR
CLOUDY
WINDY
RAIN
FAIR
SNOW
HOT
MODERATE
COLD
FOG

FILE No.


FLDR. No.

SHEET

DATE 6-15 1953

Quad. No.

STATION	DIST.	ANGLE ° ' "	+	H. I. BEARING	VER: ANG. DIFF.	ELEVATION
T.B.M.			4.42			21.39
				25.81		
0-45	26' walk		4.42			21.39
0-80			4.8			21.0
0-80	6" 58" Y		11.20			14.61
-1+00			4.6			21.2
-1+63	2' walk		4.28			21.53
-2+00			4.4			21.4
-2+29	M.H. Top		4.25			21.56
	invert 8' etc.		12.60			13.21
T.B.M.			4.41			21.40 (21.39)

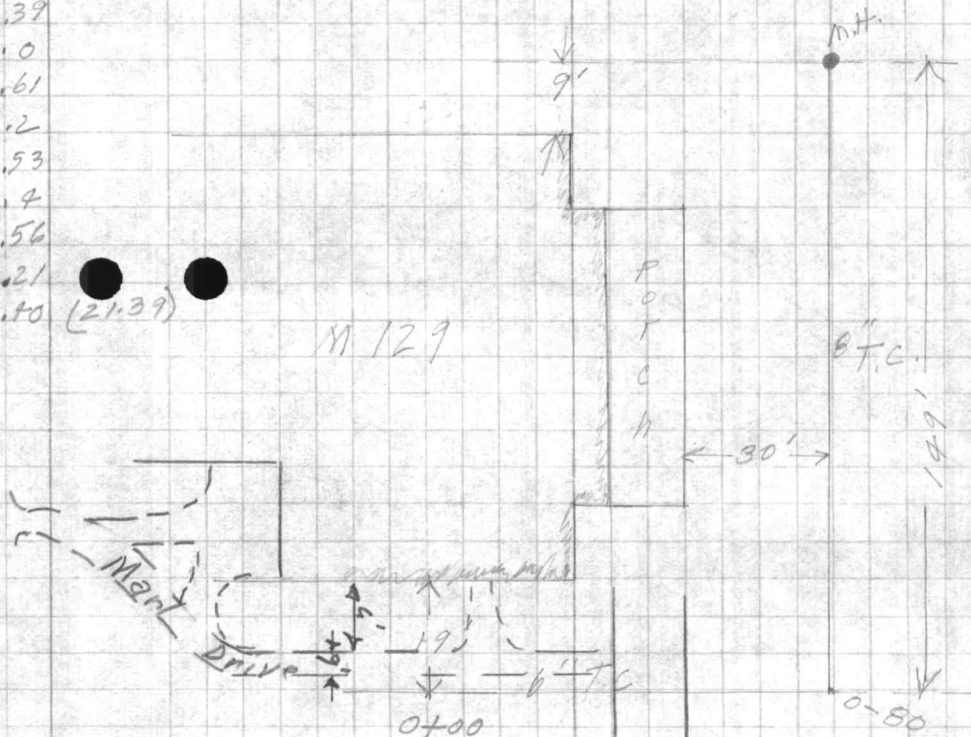19.61
22
13.78

VALUABLE

RETURN TO
PUBLIC WORKS
OFFICE
CAMP LEJEUNE
NORTH CAROLINA

SUBJECT Location of existing
sewer & water lines proposed
extension

FIELD PARTY

Cook IN CHARGE
INSTRUMENT
NOTES
TAPE READ
TAPE OR ROD
TAPE OR ROD
INSTRUMENT NO.
TAPE NO.


WEATHER

CLEAR SNOW
CLOUDY HOT
WINDY MODERATE
RAIN COLD
FAIR FOG
FIGURED BY
NOTES CHECKED BY
PLOTTED BY

FILE No. _____
FLDR. No. _____
SHEET 1 of
DATE 6-12 1957

Quad. No. _____

STATION	DIST.	ANGLE " "	+	H. I. BEARING	VER. ANG. DIFF.	ELEVATION
B.M. Mon #106			5.92			19.99
				25.91		
TP			4.25	25.64	4.52	21.39
0+00					4.6	21.0
0+00	Top of 6" T.C.				9.33	16.31
0+00	House service				7.13	18.51
0+50					4.9	20.7
1+00					5.0	20.6
1+06	Bank				5.0	20.6
1+09	Top 3" water col.				8.02	17.62
1+15	Ditch				6.0	19.6
1+23	Bank				4.8	20.8
1+25.5	5' stem 1+37 stem pole					
1+41	Edge Pave.				4.86	20.78
1+82	" "				5.27	20.37
1+89	Ditch				6.4	19.2
1+95	Bank				5.6	20.0
2+00	woods line					
2+25					5.8	19.8
TP			4.50		4.25	21.39
				25.89		
B.M. Mon #106					5.90	19.99

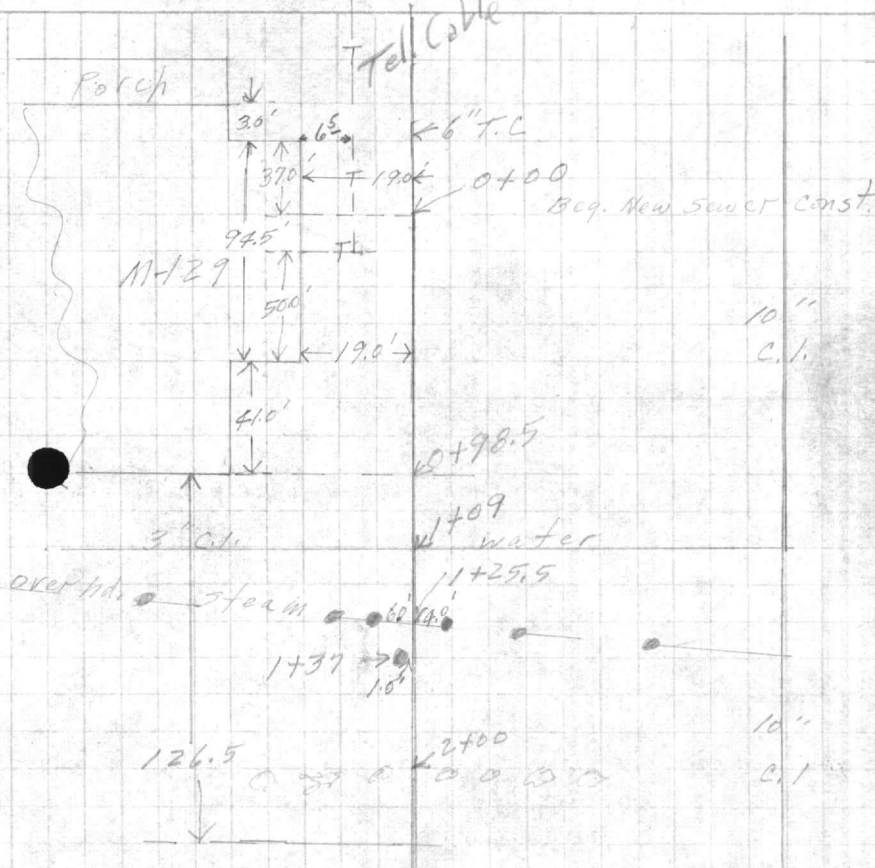


13.36
68

14.04
5

14.54

1.70
4

.680

16.31
5

16.81

17.0
1

16.7

1.13
6

17.83
6

18.43

2.25
5

1.125

VALUABLE

SUBJECT Location of Paving
around Bldg #127
Montford Bldg.

RETURN TO
 PUBLIC WORKS
 OFFICE
 CAMP LEJEUNE
 NORTH CAROLINA

FIELD PARTY

Caulk IN CHARGE
 _____ INSTRUMENT
 _____ NOTES
 _____ TAPE READ
 _____ TAPE OR ROD
 _____ TAPE OR ROD
 _____ INSTRUMENT No.
 _____ TAPE No.


WEATHER

CLEAR
 CLOUDY
 WINDY
 RAIN
 FAIR
 SNOW
 HOT
 MODERATE
 COLD
 FOG
 FIGURED BY _____
 NOTES CHECKED BY _____
 PLOTTED BY _____

FILE No. _____
 FLDR. No. _____
 SHEET 10 of 1
 DATE 6-23 1953

Quad. No. _____

STATION	DIST.	ANGLE ° ' "	+	H. I. BEARING	VER. ANG. DIFF.	ELEVATION
3767	110'			Rt. End outer Rad.		
3750	34'			Rt. Edge Pave		
3723	40'			Rt. End inner Rad.		
3716	4'			Beq. outer Rad.		
3716				Steam line (overhead)		
3700	20'			Beq. Rad. on Rt.		
2795	1'			Lt. End Rad. Edge Pave		
2780	32'			End Working Lt.		
2774	180'			Bldg Line		
2768				End Parking on Rt.		
1735	132'			Bldg #127 Rt. 17' Edge Pave Rt. 34' Lt. Edge Pave		
0769	25'			Beq. Parking on Lt. 25' Lt. Ed Rt. 35' Edge Pave		
0744				Beq. Parking on Rt.		
0732	18'			Lt. Edge Pave		
0732	17'			Rt. Edge Pave		
0711				Edge Rad.		

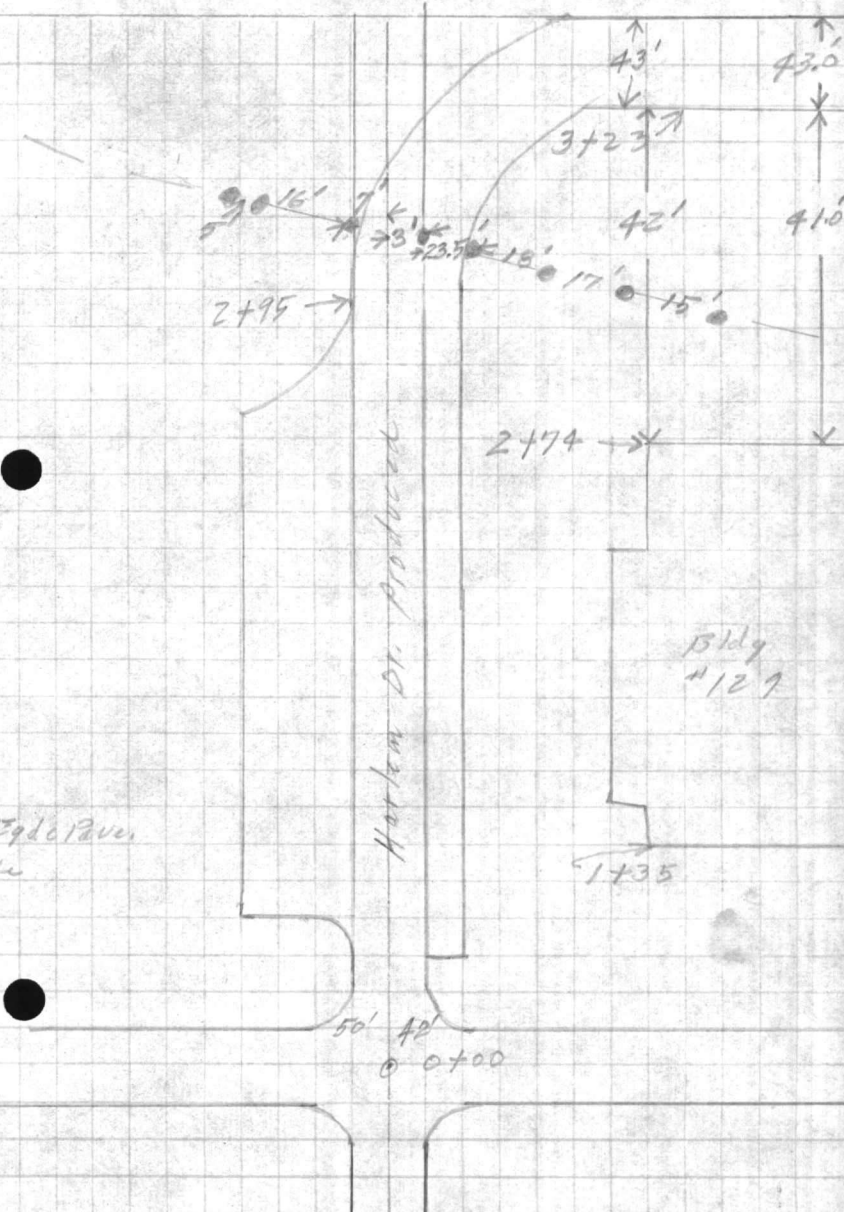

RECEIVED
POST OFFICE
DANF. STATION
NORTH CAROLINA

STATION DIST.

ANGLE

CARRIAGE

ST. DIST.

STATION

FIELD PARTY
IN CHARGE
INSTRUMENT
NOTES
TAPES HEAD
TAPES OR NOO
SERIAL NO.
TAPES

WEATHER
CLEAR
CLOUDY
WINDY
RAIN
FOG
THUNDER
HAIL
SNOW
ICE

FILE NO.

DATE

FILE NO.

VALUABLE

SUBJECT BENCH LEVELS TO
WELL # M. 24AReturn To
Public Works
Office
Camp Lejeune
North Carolina

FIELD PARTY

In Charge DENNIS
Instrument CAULK
Notes
PATRICK Tape Read
Tape or Rod
Tape or Rod
Instrument No.
Tape No.

WEATHER

Clear
Cloudy
Windy
Rain
Fair
Snow
Hot
Moderate
Cold
FogFILE No. 98 Y

Fldr. No. _____

Sheet 10 F 2Date 10-25 1951Figured By _____
Notes Checked By _____
Plotted By _____
Quad. No. _____

Station	Dist.	Angle " +	H. I. Bearing	Ver: Ang. Diff.	Elevation
B.M.		1.73	22.73		21.00
T.P.				6.57	16.16
		11.35	27.51		
T.P.				9.07	18.44
		1.67	20.11		
T.P.				4.93	15.18
		6.72	21.90		
T.P.				7.93	13.97
		7.63	21.60		
T.P.				3.77	17.83
		6.49	24.32		
T.P.				A 75	19.57
		0.37	19.94		
T.P.				1.12	18.82
		5.82	24.64		
T.P.				4.65	19.99

Return to
Public Works
Office
Camp Lejeune
New Carolina

SUBJECT

Station
Dist.
Altitude
M. I.
Longitude
Latitude
Elevation

FIELD PARTY
Instrument
Notes
Type of Road
Type of Road
Type of Road
Type of Road

WEATHER
Clear
Snow
Fog
Rain
Light
Thunder
Notes Checked By
Plotted By
Date

FILE NO.

FILE NO.

FILE NO.

FILE NO.

FILE NO.



VALUABLE

SUBJECT _____

Return To
Public Works
Office
Camp Lejeune
North Carolina

FIELD PARTY

_____ In Charge
_____ Instrument
_____ Notes
_____ Tape Read
_____ Tape or Rod
_____ Tape or Rod
_____ Instrument No.
_____ Tape No.

WEATHER

Clear
Cloudy
Windy
Rain
Fair

Snow
Hot
Moderate
Cold
Fog

FILE No. _____

Fldr. No. _____

Sheet 2 DF 2

Date _____ 19__

Figured By _____

Notes Checked By _____

Plotted By _____

Quad. No. _____

Station	Dist.	Angle ° ' "	+	H. I. Bearing	Ver: Ang. Diff.	Elevation
				3.94 23.93		19.99
FLOOR WELL # M. 2AA				4.16 23.83		19.77
T.P.				3.99 24.17		19.84
T.P.				3.87 24.17		20.30
T.P.				5.50 25.80		24.21
T.P.				2.73 26.94		22.25
T.P.				2.82 25.07		21.97
T.P.				4.63 20.44		22.50
				5.39 25.83		22.50
				3.86 21.97		22.50
				3.73 25.70		22.50
FLOOR BLDG. M. 131				3.21 22.49		22.50

VALUABLE
Return to
Public Works
Office
Camp Lejeune
North Carolina































VALUABLE

SUBJECT Spot elevations for
proposed Trailer Park
Monticord Point

Return To
 Public Works
 Office
 Camp Lejeune
 North Carolina

FIELD PARTY
Murphy In Charge
Pedgett Instrument
 Notes
 Tape Read
 Tape or Rod
 Instrument No.
 Tape No.

WEATHER
 Clear
 Cloudy
 Windy
 Rain
 Fair
 Snow
 Hot
 Moderate
 Cold
 Fog
 Figured By
 Checked By
 Plotted By

FILE No. 98-4
 Fldr. No. _____
 Sheet 2052
 Date Oct. 17 1957

Quad. No. _____

Station	Dist.	Angle	H. I. Bearing	Ver: Ang. Diff.	Elevation
BM					19.77
					48724.64
					36820.96

VALUABLE

RETURN TO
PUBLIC WORKS
OFFICE
CAMP LEJEUNE
NORTH CAROLINA

SUBJECT

Ditch Profile
Water softening plant
Montford Point

FIELD PARTY

DENNS IN CHARGE

INSTRUMENT

NOTES

TAPE READ

TAPE OR ROD

TAPE OR ROD

INSTRUMENT No.

TAPE No.

WEATHER

CLEAR
CLOUDY
WINDY
RAIN
FAIR

SNOW
HOT
MODERATE
COLD
FOG

FILE No. 984

FLDR. No.

SHEET 1 of 2

FIGURED BY

NOTES CHECKED BY


PLOTTED BY

DATE 8-18-55

Quad. No.

STATION	DIST.	ANGLE " "	+	H. I. BEARING	VER: ANG. DIFF.	ELEVATION
---------	-------	--------------	---	------------------	--------------------	-----------

E MONTFORD LANDING RD

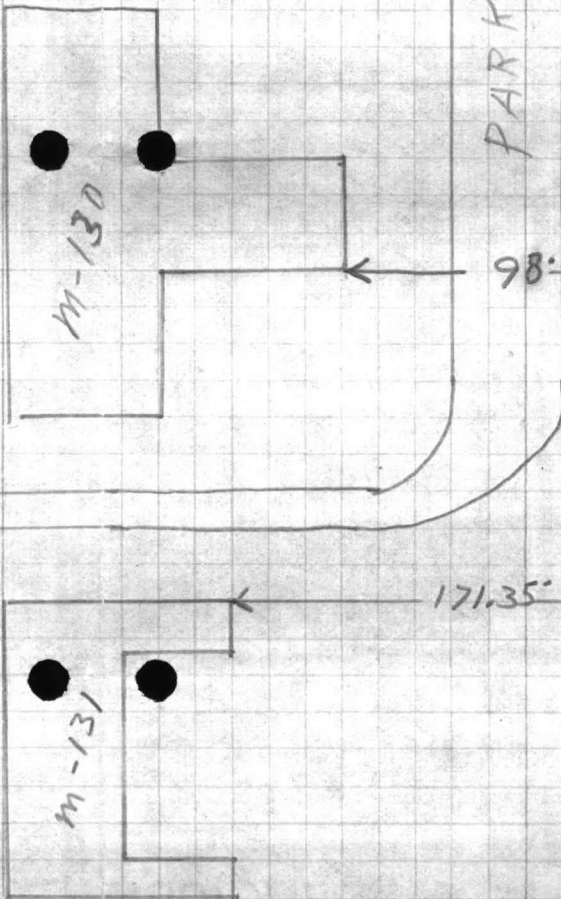

M-130

M-131

PARKING

DITCH

98'

171.35'

POINT A


186.15'

POINT B




FIELD PARTY
CLEAR
WINDY
TAPING

WEATHER
CLEAR
WINDY
TAPING

FIELD NO.
DATE



VALUABLE

SUBJECT _____

RETURN TO
PUBLIC WORKS
OFFICE
CAMP LEJEUNE
NORTH CAROLINA

FIELD PARTY

IN CHARGE

INSTRUMENT

NOTES

TAPE READ

TAPE OR ROD

TAPE OR ROD

INSTRUMENT NO.

TAPE NO.


WEATHER

CLEAR
CLOUDY
WINDY
RAIN
FAIR
SNOW
HOT
MODERATE
COLD
FOG

FILE No. _____
FLDR. No. _____
SHEET 2 of 2
DATE _____ 19__

FIGURED BY _____
NOTES CHECKED BY _____
PLOTTED BY _____
Quad. No. _____

STATION	DIST.	ANGLE			H. I.	VER. ANG.	ELEVATION
		°	'	"	BEARING	DIFF.	

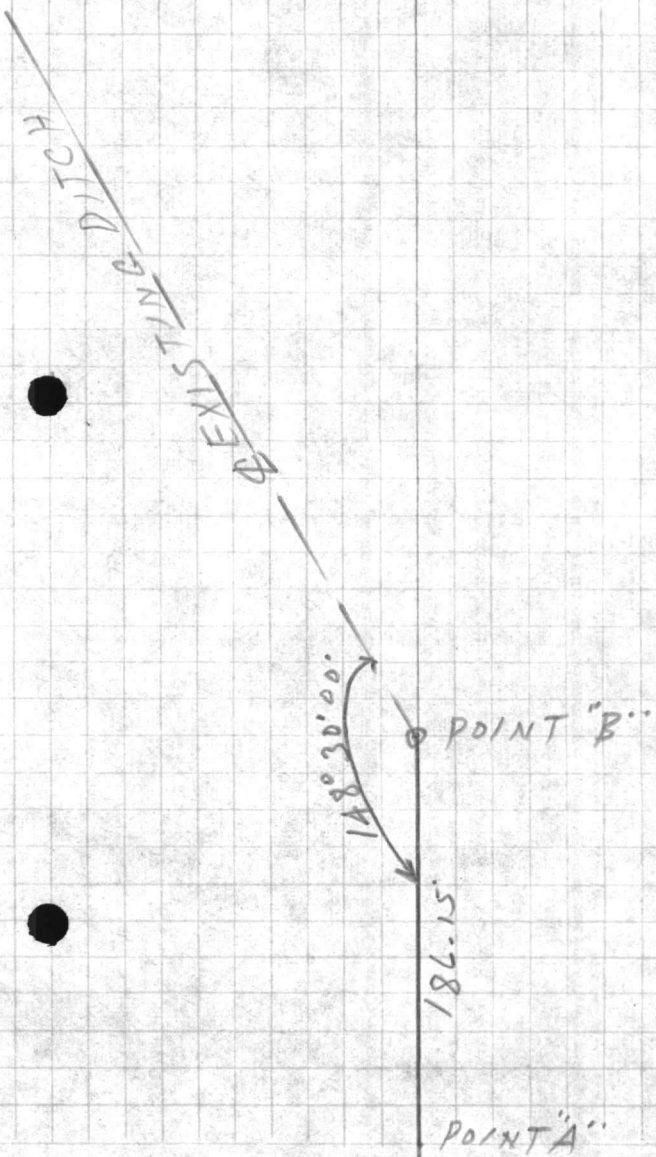

VALUABLE

RETURN TO






VALUABLE

SUBJECT _____

RETURN TO
 PUBLIC WORKS
 OFFICE
 CAMP LEJEUNE
 NORTH CAROLINA

FIELD PARTY

 IN CHARGE

 INSTRUMENT

 NOTES

 TAPE READ

 TAPE OR ROD

 TAPE OR ROD

 INSTRUMENT No. _____
 TAPE No. _____

WEATHER

CLEAR
 CLOUDY
 WINDY
 RAIN
 FAIR

SNOW
 HOT
 MODERATE
 COLD
 FOG

FILE No. _____
 FLDR. No. _____
 SHEET 204
 DATE _____ 19__

Quad. No. _____

STATION	DIST.	ANGLE ° ' "	+	H. I. BEARING	VER: ANG. DIFF.	ELEVATION		
8+00				20.7 20.7 20.1	77	12.4	LT.	RT.
9+0					78	12.3		
T.P.		4.12		20.27 20.33 20.3	3.94	16.15		
10+00					8.3	12.0		
11+00					8.7	11.6		
11+28								
12+00		10° BEND TO RT.			9.0	11.3	40° BEND TO RIGHT	
T.P.		4.69		20.40 20.50 20.4	4.56	15.71		
13+00					9.5	10.9		
14+00					9.9	10.5		
15+00					10.5	99.9		
16+00					11.5	8.8		

W.L. B D B W.L.
 10 2 2 2 8
 4.1 4.9 7.7 4.7 4.5
 16.0 15.2 12.4 13.4 15.6

30° BEND TO LEFT

40° BEND TO RIGHT

W.L. B B W.L.
 8 3 3 8
 5.1 4.4 9.0 4.4 5.3
 15.2 13.9 11.3 13.9 15.0

W.L. B B W.L.
 10 3 3 9
 6.2 7.2 7.1 6.0
 14.2 13.2 13.3 14.4



NO. 100
DATE
PLACE
NAME

Division

and

H. H.

1950

DATE

W. C. HARTY

IN CHARGE

STATION

NOTE

STATION

TYPE OF

STATION

TYPE OF

V. LATHR

IN CHARGE

STATION

NOTE

STATION

TYPE OF

STATION

TYPE OF


































VALUABLE

SUBJECT _____

RETURN TO
 PUBLIC WORKS
 OFFICE
 CAMP LEJEUNE
 NORTH CAROLINA

FIELD PARTY

 IN CHARGE

 INSTRUMENT

 NOTES

 TAPE READ

 TAPE OR ROD

 INSTRUMENT NO.

 TAPE NO. _____

WEATHER

CLEAR _____
 CLOUDY _____
 WINDY _____
 RAIN _____
 FAIR _____
 SNOW _____
 HOT _____
 MODERATE _____
 COLD _____
 FOG _____

FILE No. _____
 FLDR. No. _____
 SHEET 308
 DATE _____ 19__

FIGURED BY _____
 NOTES CHECKED BY _____
 PLOTTED BY _____
 Quad. No. _____

STATION	DIST.	ANGLE ° ' "	+	H. I. BEARING	VER. ANG. DIFF.	ELEVATION
				20 50		15
T.P.	5 01			14 4 25	16	35
				21.25		34
T.P.	4 01			35 4.82	16	44
				20.45		01
T.P.	5 46			47 3.34	17	44
				22.57		30
T.P.	3.98			28 2.17	20	40
				24 38		63
B.M.				2.65	21.72	

INT. MONTFORD LANDING -
 INTERFERENCE TO PARKING LOT
 BACK BLDG. M-131







































VALUABLE

SUBJECT _____

RETURN TO
 PUBLIC WORKS
 OFFICE
 CAMP LEJEUNE
 NORTH CAROLINA

FIELD PARTY

 IN CHARGE

 INSTRUMENT

 NOTES

 TAPE READ

 TAPE OR ROD

 TAPE OR ROD

 INSTRUMENT No. _____
 TAPE No. _____

WEATHER

CLEAR _____
 CLOUDY _____
 WINDY _____
 RAIN _____
 FAIR _____
 SNOW _____
 HOT _____
 MODERATE _____
 COLD _____
 FOG _____

FILE No. _____
 FLDR. No. _____
 SHEET 20f
 DATE _____ 19__

Quad. No. _____

STATION	DIST.	ANGLE " "	+	H. I. BEARING	VER. ANG. DIFF.	ELEVATION
2+36	<u>65</u>					
2+32						
2+26'						
2+10 ³⁵						
2+10						
2+10						
1+99 ⁰⁰						
1+96'						
1+82 ²⁰						
1+77						
1+74						
1+68						
1+55						
1+24						
1+13						

TOP 10" RAW WATER LINE

10.80' LT. WATER VALVE

3' LT. COR. WOOD.

24' LT. COR. GAS. STA.

4' LT. WOOD LINE

3' RT. GUY WIRE

7' LT. POWER POLE I.M.J 5

WOOD LINE

24' LT. COR. GAS. STA.

2' LT. COR. MARL

14' RT. COR. WOOD

MARL ON E

EDGE RD.

EDGE RD.

WOOD LINE























































































VALUABLE

SUBJECT STAKEOUT PROPOSED
WATER LINE MONTFORD PT.

RETURN TO
PUBLIC WORKS
OFFICE
CAMP LEJEUNE
NORTH CAROLINA

Line "B"

FIELD PARTY
DENNIS IN CHARGE

INSTRUMENT

NOTES

TAPE READ

TAPE OR ROD

TAPE OR ROD

INSTRUMENT NO. _____
TAPE NO. _____

WEATHER
CLEAR SNOW
CLOUDY HOT
WINDY MODERATE
RAIN COLD
FAIR FOG
FIGURED BY _____
NOTES CHECKED BY _____
PLOTTED BY _____


FILE No. 98-Y
FLDR. No. _____
SHEET 10 of 2
DATE 9-21-55

Quad. No. _____

STATION	DIST.	ANGLE ° ' "	+	H. I. BEARING	VER. ANG. DIFF.	ELEVATION
---------	-------	----------------	---	------------------	--------------------	-----------

* AT P.I. 5 1 236 02 10
 B.S. 0+00 3
 TO P.I. 'A' M

* AT 0+00 90 00 00
 B.S. COR.
 TO P.I. 'A'

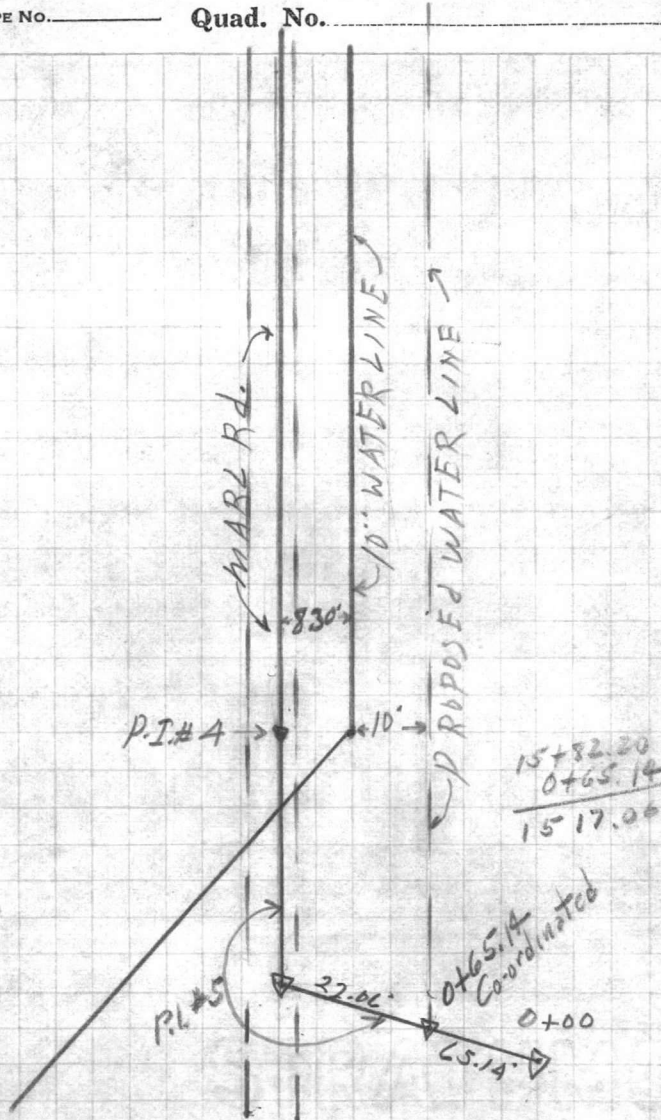

$15+82.20$
 $0+65.14$
 \hline
 $15+17.06$

65.14
 22.06
 \hline
 87.20




VALUABLE

SUBJECT Line B

RETURN TO
PUBLIC WORKS
OFFICE
CAMP LEJEUNE
NORTH CAROLINA

FIELD PARTY

____ IN CHARGE
____ INSTRUMENT
____ NOTES
____ TAPE READ
____ TAPE OR ROD
____ TAPE OR ROD
____ INSTRUMENT No.
____ TAPE No.

WEATHER

CLEAR
CLOUDY
WINDY
RAIN
FAIR

SNOW
HOT
MODERATE
COLD
FOG

FILE No. _____

FLDR. No. _____

SHEET 2 of 2

FIGURED BY _____

NOTES CHECKED BY _____

PLOTTED BY _____ DATE _____ 19__


Quad. No. _____


STATION	DIST.	ANGLE ° ' "	+	H. I. BEARING	VER. ANG. DIFF.	ELEVATION
---------	-------	----------------	---	------------------	--------------------	-----------

NOTE
4' RT. FROM STA. 19+66.70
TO END 45° BEND UP TO
WELL # M-243

AT BEND 168 07 00
B.S. 14+82.20
TO STA. 19+66.20

17+76	6.50' LT. 6" WATER LINE					
16+09.50	10.3' LT. 6" WATER LINE					
15+80	ON TOP 6" WATER LINE				-4.80	
15+79'	2.6' LT. WATER VALVE					
15+78'	6' LT. 6x6" CROSS					
15+74'	5' LT. 6" BEND					
15+72'	7' LT. 10" WATER LINE					

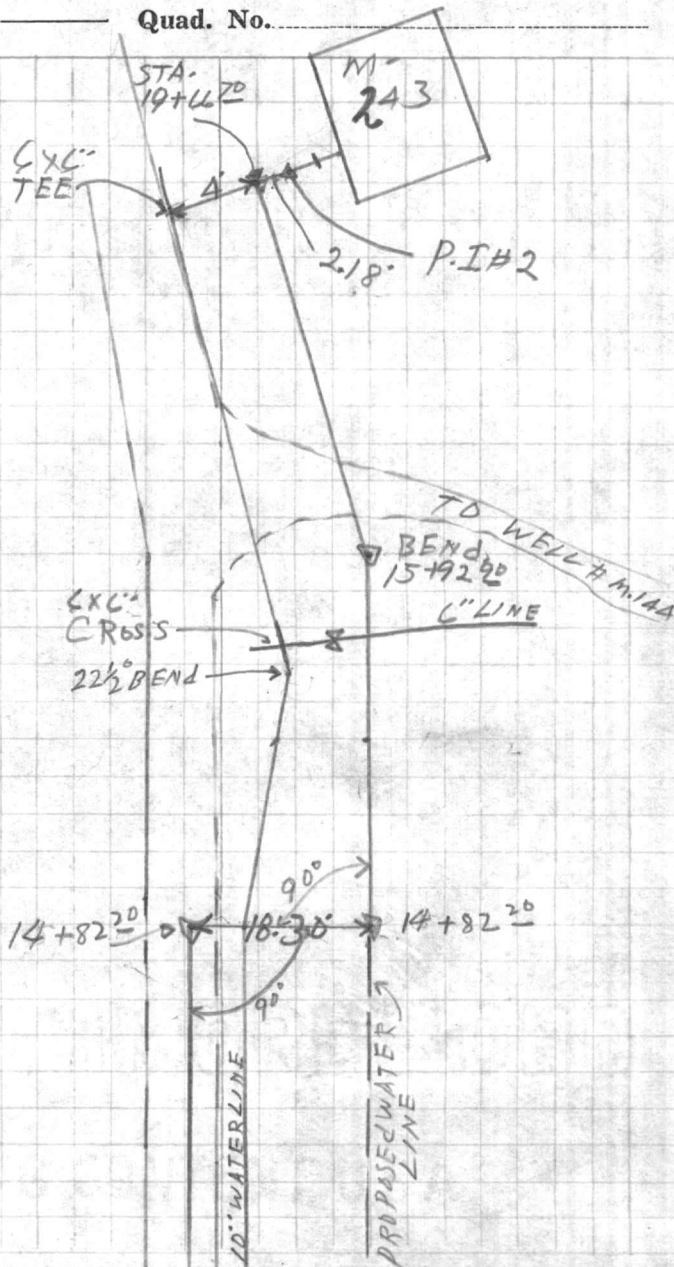

 

VALUABLE

SUBJECT

Line B

RETURN TO
PUBLIC WORKS
OFFICE
CAMP LEJEUNE
NORTH CAROLINA

FIELD PARTY

IN CHARGE

INSTRUMENT

NOTES

TAPE READ

TAPE OR ROD

TAPE OR ROD

INSTRUMENT NO.

TAPE NO.

WEATHER

CLEAR
CLOUDY
WINDY
RAIN
FAIR

SNOW
HOT
MODERATE
COLD
FOG

FILE No. _____

FLDR. No. _____

FIGURED BY _____

SHEET

NOTES CHECKED BY _____

PLOTTED BY _____

DATE

104
9-21-55

Quad. No. _____

STATION	DIST.	ANGLE ° ' "	+	H. I. BEARING	VER: ANG. DIFF.	ELEVATION	
B.M				289 24.75		21.86	SPIKE IN
0+00					4.0	20.7	
0+65.14					4.3	20.4	BEND.
1+0					3.9	20.8	
2+0					4.1	20.6	
3+0					4.4	20.3	
4+00					5.0	19.7	
T.P.		5 44		25 88	4.31	20.44	
					9.3	16.6	ON TOP 10" WATER LINE AT 4+00
5+0					5.3	20.6	
6+0					5.3	20.6	
7+0					3.4	22.5	
8+0					3.8	22.1	
					9.2	16.7	TOP ON 10" WATER LINE AT 8+63"
9+00					3.9	22.0	

WAS ABLE

TO
PUBLIC
OFFICE
NORTH CAROLINA

NOT TO
BE
REPRODUCED



VALUABLE

SUBJECT

B

RETURN TO
PUBLIC WORKS
OFFICE
CAMP LEJEUNE
NORTH CAROLINA

FIELD PARTY

IN CHARGE

INSTRUMENT

NOTES

TAPE READ

TAPE OR ROD

TAPE OR ROD

INSTRUMENT NO.

TAPE NO.

WEATHER

CLEAR
CLOUDY
WINDY
RAIN
FAIR

SNOW
HOT
MODERATE
COLD
FOG

FILE No. _____

FLDR. No. _____

SHEET

204

NOTES CHECKED BY _____

PLOTTED BY _____

DATE

19

Quad. No. _____

STATION	DIST.	ANGLE " "	+	H. I. BEARING	VER: ANG. DIFF.	ELEVATION	
T.P.				25 88			
			3.89	26.66	3 11	22 77	
9+80					4 7	22 0	BANK
9+83					4 2	20 5	DITCH
9+93					4 1	20 6	DITCH
9+94					4 8	21 9	BANK
10+00					4.2	22 5	
11+00					4 2	22 5	
12+00					4 5	22 2	
1.					9 2	17 5	ON TOP 10" WATER LINE 12+50'
13+00					4.9	21 8	
14+00					3.8	22 9	
14+82 ²⁰					3 8	22 9	
15+00					3.1	23 6	
T.P.			3.11		1.99	24.67	
				27.78			








VALUABLE

SUBJECT

B

RETURN TO
PUBLIC WORKS
OFFICE
CAMP LEJEUNE
NORTH CAROLINA

FIELD PARTY

____ IN CHARGE
____ INSTRUMENT
____ NOTES
____ TAPE READ
____ TAPE OR ROD
____ TAPE OR ROD
____ INSTRUMENT No.
____ TAPE No.

WEATHER

CLEAR
CLOUDY
WINDY
RAIN
RAINF
FAIR

SNOW
HOT
MODERATE
COLD
FOG

FILE No. _____

FLDR. No. _____

SHEET

3 of 3

FIGURED BY _____

NOTES CHECKED BY _____

PLOTTED BY _____

DATE

19__

Quad. No. _____

STATION	DIST.	ANGLE ° ' "	+	H. I. BEARING	VER. ANG. DIFF.	ELEVATION	
				2778			
				8.6	19 2		ON CXC" CROSS STA-15+78
				8.7	19 1		ON TOP C" WATER LINE 15+80
15+92	90			3.6	24 2		BEND
14+00				4.7	23 1		B.M. 24.22
17+0				5.0	22 8 ✓		3.02
17+50				6.2	21 6 ✓		27.24 - 4.5
18+00				5.5	22 3 ✓		8.02 8.71 22.7
19+00				4.3	23 5 ✓		19.22 18.53 - 4.9
19+66	70			4.8	23 0		8.60 22.3
				10.5	17 3		18.64 - 3.7
							56 23.5
B.M.				3.56	24.22	24.15	18.08

Checked
6/14/56

INV.

END LINE.
TOP CXC" TEE

42" OAK INTER. MARL RD. - FARTH RD.
TO WELL # 244








































127-21












































VALUABLE

SUBJECT _____

RETURN TO
 PUBLIC WORKS
 OFFICE
 CAMP LEJEUNE
 NORTH CAROLINA

FIELD PARTY

 IN CHARGE

 INSTRUMENT

 NOTES

 TAPE READ

 TAPE OR ROD

 TAPE OR ROD

 INSTRUMENT NO. _____
 TAPE NO. _____

WEATHER

CLEAR _____
 CLOUDY _____
 WINDY _____
 RAIN _____
 FAIR _____
 SNOW _____
 HOT _____
 MODERATE _____
 COLD _____
 FOG _____
 FIGURED BY _____
 NOTES CHECKED BY _____
 PLOTTED BY _____

FILE No. _____
 FLDR. No. _____
 SHEET 1A
 DATE _____ 19__

Quad. No. _____

STATION	DIST.	ANGLE ° ' "	+	H. I. BEARING	VER: ANG. DIFF.	ELEVATION
B.S. P.I. #1						
ATPI #2						
TO COR. A	44 28			COR. m-243		
COR. B	133 38			COR. m-243		
93	342 47 00			P.P. 2-m-21		
120	215 34 30			P.P. 2-m-20		
306	201 39 30			P.P. 2-m-19		
295	210 42 30			GUY POLE 2-m-19.5		
ATPI 3						
B.S. P.I. 2						
35	53 02			RAD. ✓		
64	77 57			P.T. ✓		
79	70 31			P.T. ✓		
142	87 50			P.P. 2-m-18 ✓		
63	26 19			RAD. ✓		
36	82 35			TOP 6" C.I. ✓		
30	123 55			WOOD LINE ✓		
12	88 28			WATER VALVE ✓		
9	88 28			6x6 CROSS ✓		
10	65 18			WATER VALVE ✓		
4	97 06			WATER VALVE ✓		
34	248 01 30			TOP 6" WATER LINE ✓		
17	159 43 00			TOP 10" WATER LINE ✓		
50	172 45			WOOD LINE ✓		
95	185 50			TOP 10" WATER LINE ✓		

















VALUABLE

SUBJECT _____

RETURN TO
PUBLIC WORKS
OFFICE
CAMP LEJEUNE
NORTH CAROLINA

FIELD PARTY

 _____ IN CHARGE
 _____ INSTRUMENT
 _____ NOTES
 _____ TAPE READ
 _____ TAPE OR ROD
 _____ TAPE OR ROD
 _____ INSTRUMENT NO.
 _____ TAPE NO.

WEATHER

 CLEAR
 CLOUDY
 WINDY
 RAIN
 FAIR
 SNOW
 HOT
 MODERATE
 COLD
 FOG

FILE No. _____

FLDR. No. _____

SHEET 2 of


FIGURED BY _____

NOTES CHECKED BY _____

PLOTTED BY _____ DATE _____ 19__

Quad. No. _____

STATION	DIST.	ANGLE ' "	+	H. I. BEARING	VER: ANG. DIFF.	ELEVATION
5+90		10' DITCH 90° TO Rd.				
3+00	10'	LT. WOOD LINE ✓				
3+00	8'	LT. DITCH				
3+00	5.50'	LT 10" WATER LINE ✓				
AT P.I.#3	1	189 0515				
B.S. P.I.#2	3	207 1545				
TOP. I.#4	17	189 0515				
P.I.#3	ON LT. EDGE Rd.					
3+00	14'	LT ✓				
3+00	15'	RT. EDGE Rd. ✓				
1+90	1.50'	LT. 6" C.I. WATERLINE ✓				
1+30	30'	LT. COR. WOODS ✓				
1+00	EDGE	24' WIDE ✓				
0+60	16'	LT. COR. WOODS ✓				
AT P.I.#2	1	195 5100				
B.S. P.I.#1	3	227 3300				
TOP. I.#3	17	195 5100				

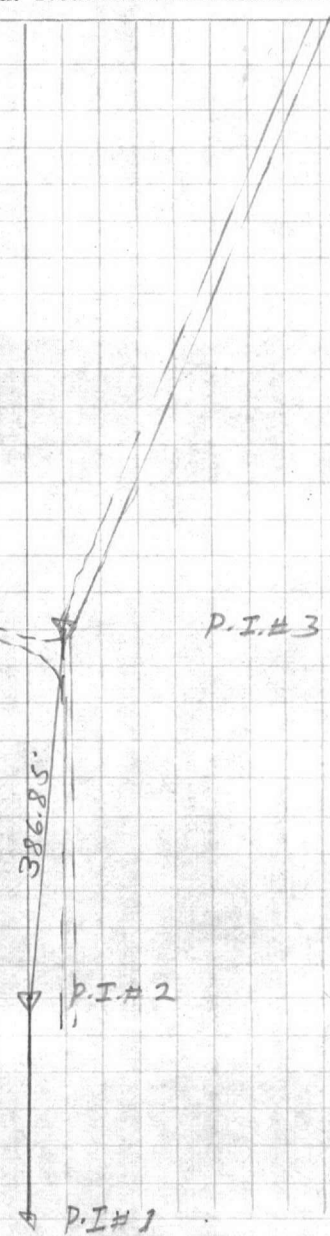 ←
 EARTH RD. TO
 WELL HOUSE #244


VALUABLE

SUBJECT

Line A

RETURN TO
PUBLIC WORKS
OFFICE
CAMP LEJEUNE
NORTH CAROLINA

FIELD PARTY

IN CHARGE _____
INSTRUMENT _____
NOTES _____
TAPE READ _____
TAPE OR ROD _____
TAPE OR ROD _____
INSTRUMENT No. _____
TAPE No. _____

WEATHER

CLEAR _____
CLOUDY _____
WINDY _____
RAIN _____
FAIR _____
SNOW _____
HOT _____
MODERATE _____
COLD _____
FOG _____

FILE No. _____

FLDR. No. _____

FIGURED BY _____

SHEET 1 of 1

NOTES CHECKED BY _____

PLOTTED BY _____

DATE _____ 19__

Quad. No. _____

STATION	DIST.	ANGLE ° ' "	+	H. I. BEARING	VER. ANG. DIFF.	ELEVATION
AT STAP IS = 0+77 ⁴⁵ ON WATER LINE						
B.S. P.I. # 4						
75	3	25 00	✓			
80	346	05 00	✓			
118	345	48 00				
146	328	43 60				
126	330	48				
87	338	57	✓			
80	336	29	✓			
81	332	44				
71	333	09				
103	326	22				
65	329	19	✓			
55	319	45				
98	317	41				
125	314	18				
151	312	48				
157	299	39				
120	304	00 00				
100	304	00 00				
44	293	56				
31	275	10				
38	267	57				
36	245	56				
36	223	21				
46	175	45				

EDGE RD. ✓

EDGE RD. ✓

COR. WOODS ✓

16" WATER LINE ✓

POWER POLE ✓

GAS TANK. ✓

GAS TANK ✓

COR. PAVEMENT ✓

GAS TANK. ✓

COR. BLDG. ✓

GAS TANK. ✓

AIR & WATER TANK ✓


COR. BLDG. ✓

COR. BLDG. ✓

COR. PAVING. ✓

EDGE PAVEMENT ✓

'A' } ISLAND.
'B' }

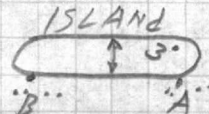

EDGE PAVEMENT ✓

POWER POLE ✓

EDGE PAVEMENT ✓

EDGE PAVEMENT END MARL Rd. ✓

EDGE PAVEMENT ✓

END MARL Rd. ✓






VALUABLE

SUBJECT _____

RETURN TO
PUBLIC WORKS
OFFICE
CAMP LEJEUNE
NORTH CAROLINA

FIELD PARTY

IN CHARGE

INSTRUMENT

NOTES

TAPE READ

TAPE OR ROD

TAPE OR ROD

INSTRUMENT NO.

TAPE NO.

WEATHER

CLEAR
CLOUDY
WINDY
RAIN
FAIR
SNOW
HOT
MODERATE
COLD
FOG

FILE No. _____


FLDR. No. _____

SHEET 104

DATE 9-20 1955

FIGURED BY _____
NOTES CHECKED BY _____
PLOTTED BY _____
Quad. No. _____

STATION	DIST.	ANGLE	"	+	H. I. BEARING	VER: ANG. DIFF.	ELEVATION
---------	-------	-------	---	---	------------------	--------------------	-----------

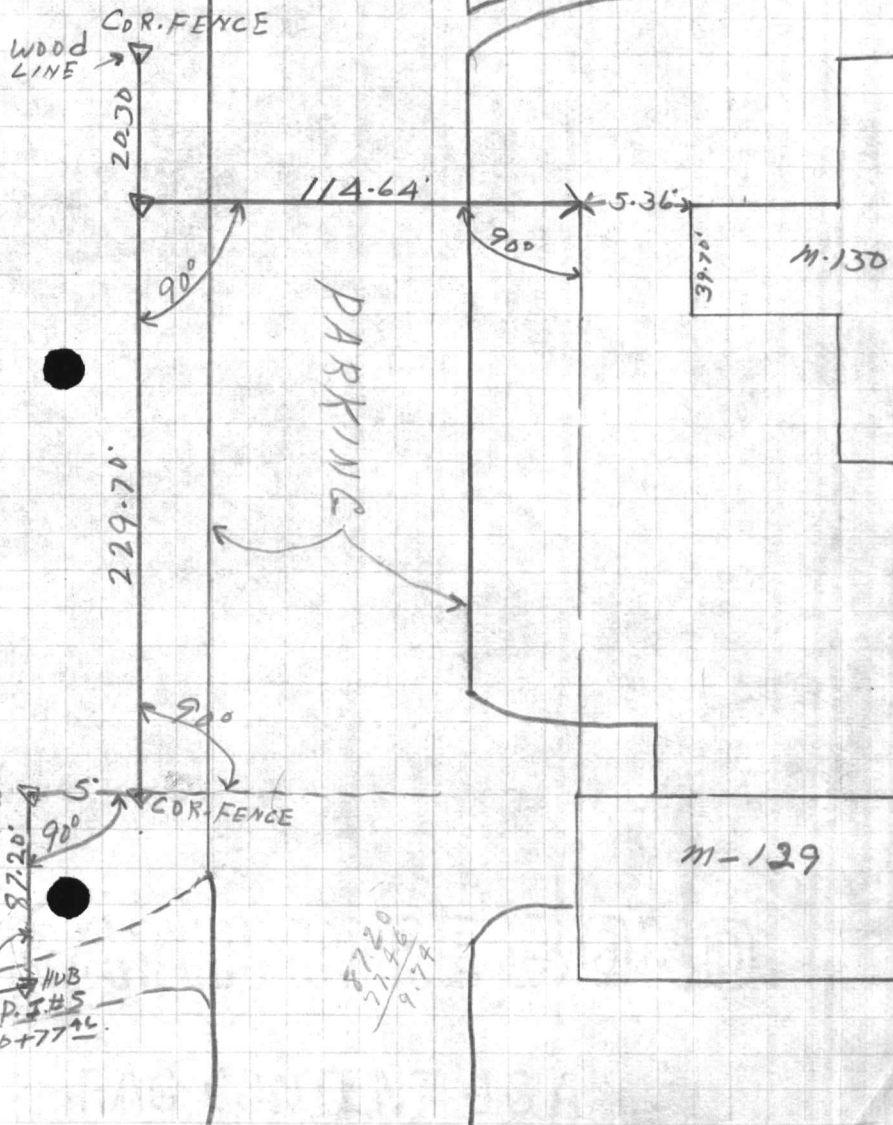

MAT P.I.#5 1235750
 = 0+7746
 B.S. P.I.#4
 TO POINT
 D+DD WATER

MAT P.I.#4 11795000
 B.S. P.I.#3 31793000
 TO P.I.#5 = 11795000
 0+7746

12305750

87.20
 71.26
 9.94

New Water Line
 10" WATER LINE EX.
 MARL Rd.

VALUABLE

SUBJECT _____

RETURN TO
 PUBLIC WORKS
 OFFICE
 CAMP LEJEUNE
 NORTH CAROLINA

FIELD PARTY

 IN CHARGE

 INSTRUMENT

 NOTES

 TAPE READ

 TAPE OR ROD

 TAPE OR ROD

 INSTRUMENT NO.

 TAPE NO. _____

WEATHER

CLEAR _____
 CLOUDY _____
 WINDY _____
 RAIN _____
 FAIR _____
 SNOW _____
 HOT _____
 MODERATE _____
 COLD _____
 FOG _____

FILE No. _____
 FLDR. No. _____
 SHEET 21
 DATE _____ 19__

FIGURED BY _____
 NOTES CHECKED BY _____
 PLOTTED BY _____
 Quad. No. _____

STATION	DIST.	ANGLE " "	+	H. I. BEARING	VER: ANG. DIFF.	ELEVATION
---------	-------	--------------	---	------------------	--------------------	-----------

100 14048
 130 16558

148 12809

95 29459

88 28650

95 28229

134 28547

137 29133

125 29705

25 4254

75 1270000

END 18' R-C.P.
 END 18' R-C.P.

FLOOD LIGHT POLE ✓

CORNER PAVEMENT ✓

RAD. PAVEMENT ✓

COR. PAVEMENT ✓

COR. 11 ✓

RAD. 11 ✓

COR. PAVEMENT ✓

COR. WOOD ✓

COR. WOOD ✓

389 59 60
 236 02 10
 123 57 50

112











VALUABLE

SUBJECT _____

RETURN TO
PUBLIC WORKS
OFFICE
CAMP LEJEUNE
NORTH CAROLINA

FIELD PARTY

 _____ IN CHARGE
 _____ INSTRUMENT
 _____ NOTES
 _____ TAPE READ
 _____ TAPE OR ROD
 _____ TAPE OR ROD
 _____ INSTRUMENT NO.
 _____ TAPE NO.

WEATHER

 CLEAR SNOW
 CLOUDY HOT
 WINDY MODERATE
 RAIN COLD
 FAIR FOG

FILE No. _____

FLDR. No. _____

SHEET 1 of 1

NOTES CHECKED BY _____

PLOTTED BY _____ DATE 9-14 1955

Quad. No. _____

STATION	DIST.	ANGLE			+	H. I. BEARING	VER: ANG. DIFF.	ELEVATION
		°	'	"				
ATPI#3								
BS.PIH2								
	79	243	10	00				
	83	81	35	00				
	190	100	41	00				
	156	100	41	00				
	228	100	41	00				
	142	79	32	00				
	280	48	14	00				

 TOP. 6" C.I.
 TOP. 6" C.I.
 TOP. 6" C.I.
 EDGE. RD.
 EDGE. RD.

COR. WOOD.

COR. WOOD.

VALUABLE

SUBJECT _____

RETURN TO
PUBLIC WORKS
OFFICE
CAMP LEJEUNE
NORTH CAROLINA

FIELD PARTY

 _____ IN CHARGE
 _____ INSTRUMENT
 _____ NOTES
 _____ TAPE READ
 _____ TAPE OR ROD
 _____ TAPE OR ROD
 _____ INSTRUMENT NO.
 _____ TAPE NO.

WEATHER

 CLEAR
 CLOUDY
 WINDY
 RAIN
 FAIR
 SNOW
 HOT
 MODERATE
 COLD
 FOG

FILE No. _____

FLDR. No. _____

SHEET _____

NOTES CHECKED BY _____


PLOTTED BY _____ DATE _____ 19__

Quad. No. _____

STATION	DIST.	ANGLE ° ' "	+	H. I. BEARING	VER: ANG. DIFF.	ELEVATION	
AT.P.I#3 B.S.P.I#2							
	17	25817 00					22 1/2° BEND C" WATER LINE
	10	11350 00					22 1/2° BEND C" & 10" WATER
	82	8153 00					33 1/3° BEND C" WATER LINE
	30	1130 00					CURVE C" WATER LINE



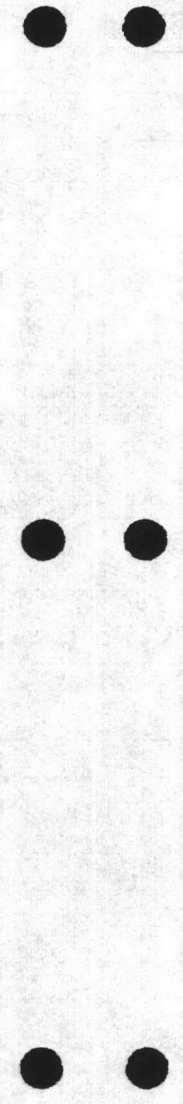


VALUABLE

RETURN TO
PUBLIC WORKS
OFFICE
CAMP LEJEUNE
NORTH CAROLINA

SUBJECT ELEV. STEAM &
CONDENSATE NEAR
M-130 MONTFORD PT.


FIELD PARTY
DENNIS IN CHARGE
INSTRUMENT
NOTES
TAPE READ
TAPE OR ROD
TAPE OR ROD
STRUMENT No.
TAPE No.

WEATHER
CLEAR
CLOUDY
WINDY
RAIN
FAIR
SNOW
HOT
MODERATE
COLD
FOG
FIGURED BY
NOTES CHECKED BY
PLOTTED BY

FILE No. _____
FLDR. No. _____
SHEET 10 of 1
DATE 12-8 1955

Quad. No. _____

STATION	DIST.	ANGLE ' "	+	H. I. BEARING	VER. ANG. DIFF.	ELEVATION
Bm.			4.18	^{26.} 25.04		21.86
# 1 } # 1 }	GROUND. Φ STEAM				- 4.77 + 9.25	21.3 35.29
# 1 } # 1 }	Φ CONDENSATE GROUND				+ 9.15 - 4.9	35.19 21.1
# 2 } # 2 }	GROUND Φ STEAM				- 4.6 + 9.04	21.4 35.08
# 2 } # 2 }	GROUND Φ CONDENSATE				- 4.7 + 9.04	21.3 35.08
# 3 } # 3 } # 3 } # 3 }	Φ CONDENSATE GROUND Φ STEAM GROUND				+ 8.85 - 4.6 + 8.85 - 4.7	34.89 21.4 34.89 21.3

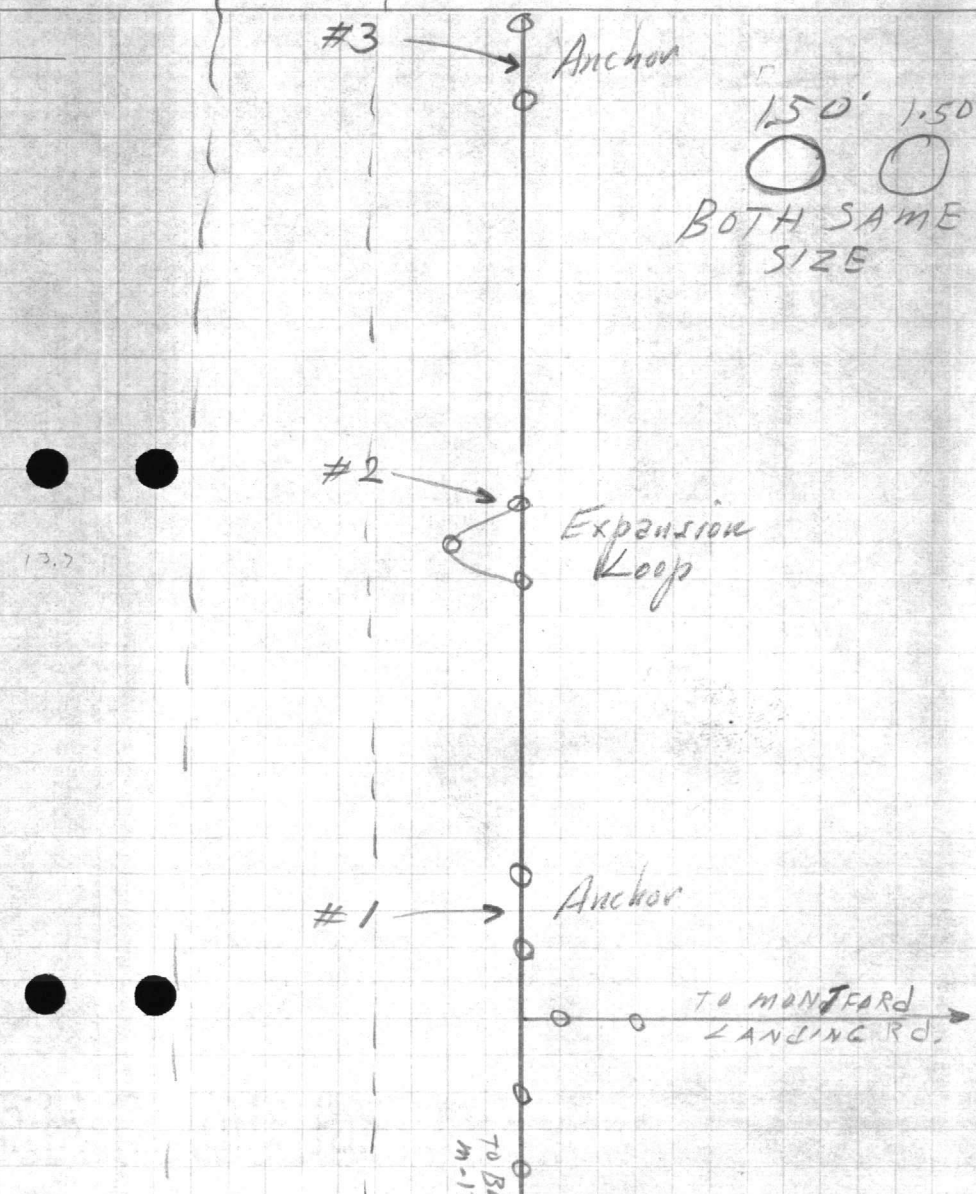


STATION DIST. ANGLE
ELEVATION
OFF. BEARING

118.5
22.5
96.0




VALUABLE
 RETURN TO
 PUBLIC WORKS
 OFFICE
 CAMP LEJEUNE
 NORTH CAROLINA

SUBJECT

*Profile on Proposed
 Steam Line to Water Tr. Plant*

FIELD PARTY

 _____ IN CHARGE
 _____ INSTRUMENT
 _____ NOTES
 _____ TAPE READ
 _____ TAPE OR ROD
 _____ TAPE OR ROD

WEATHER

 _____ CLEAR
 _____ CLOUDY
 _____ WINDY
 _____ RAIN
 _____ FAIR
 _____ SNOW
 _____ HOT
 _____ MODERATE
 _____ COLD
 _____ FOG

FILE No. _____

FLDR. No. _____

SHEET

1 of

DATE

12-8 1955


INSTRUMENT No. _____

TAPE No. _____

Quad. No. _____

STATION	DIST.	ANGLE " "	+	H. I. BEARING	VER: ANG. DIFF.	ELEVATION
B.M.			418	2604		21.86
0+01.5 0+00					4.6	21.4
0+12 13.5					4.8	21.2
0+22 23.5					4.9	21.1
0+25 27					4.80	21.24
0+50 51.5					4.81	21.23
0+68 70					5.06	20.98
0+74 76					5.3	20.7
0+78 79.50					6.9	19.1
0+81 83					8.2	17.8
0+87 88.50					6.8	19.2
0+93 94.50					5.6	20.4
1+00 01.5					4.9	21.1
1+10 11.5					4.5	21.5
1+17 18.5					4.9	21.1
B.M.					4.18	21.86

At crossing of ~~Red~~ 13.0 ft. Clearance from Red. Surface to underside of Helcor.

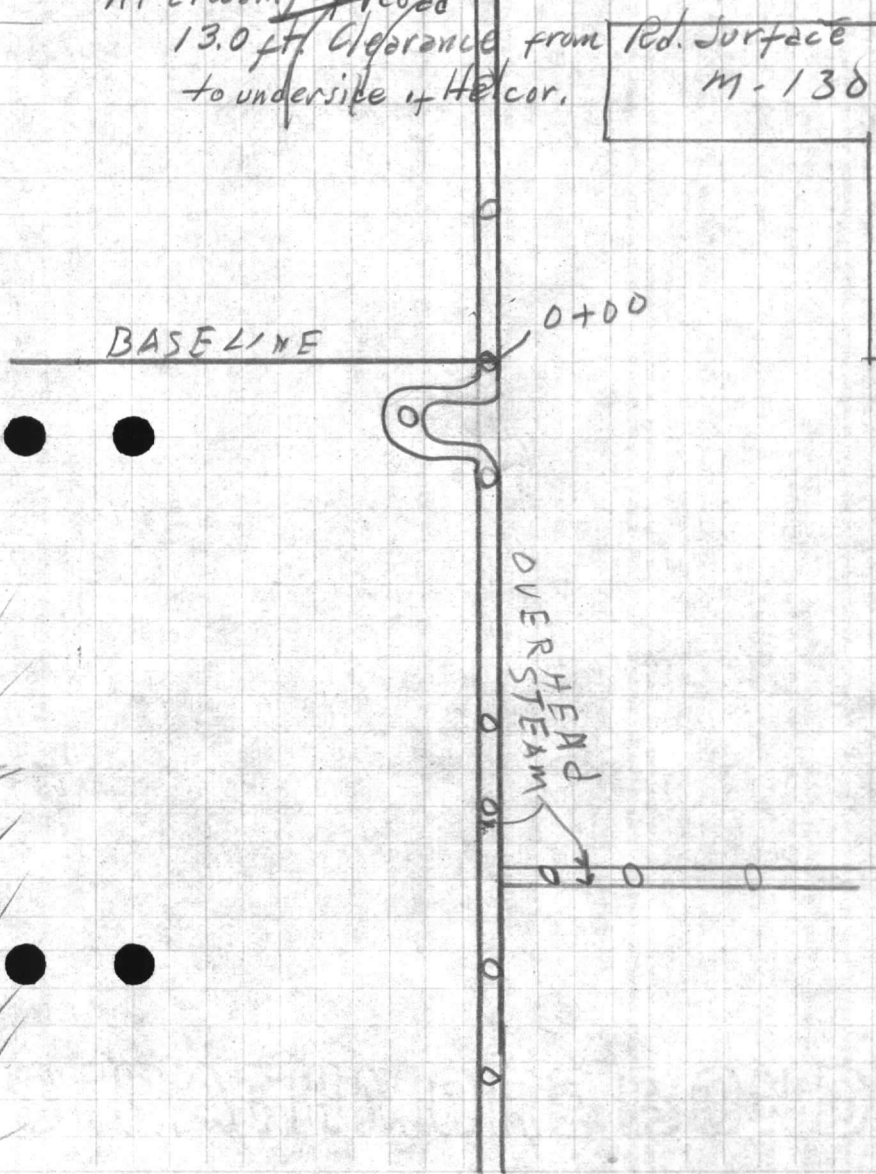




























