

VALUABLE

SUBJECT Profile & topog. on
Proposed connecting
Water Line

RETURN TO
 PUBLIC WORKS
 OFFICE
 CAMP LEJEUNE
 NORTH CAROLINA

FIELD PARTY
Kellum IN CHARGE
 _____ INSTRUMENT
 _____ NOTES
 _____ TAPE READ
 _____ TAPE OR ROD
 _____ TAPE OR ROD
 _____ INSTRUMENT No.
 _____ TAPE No.

WEATHER
 CLEAR _____ SNOW _____
 CLOUDY _____ HOT _____
 WINDY _____ MODERATE _____
 RAIN _____ COLD _____
 FAIR _____ FOG _____
 FIGURED BY _____
 NOTES CHECKED BY _____
 PLOTTED BY _____

FILE No. 99-M
 FLDR. No. _____
 SHEET 1-07
 DATE 12-10 1958

Quad. No. _____

STATION	DIST.	ANGLE " "	+	H. I. BEARING	VER: ANG. DIFF.	ELEVATION
B.M.				(19.9)		16.30
		3.59		19.89	✓	
0+0	Ground				3.2	16.7
0+16					2.7	17.2
0+50					3.8	16.1
0+92	9' Lft.					tele pole
1+0					4.7	15.2
1+50					5.5	14.4
2+0					5.9	14.0
2+50					6.1	13.8
2+88					5.6	14.3
2+91					6.0	13.9
2+94					5.3	14.6
3+0					5.5	14.4
3+50					4.8	15.1
3+77						
P.I. 3+86.66					4.4	15.5
4+0	← 4+14				4.4	15.5
4+50	4" Water				1.8	15.1
4+94					5.5	14.4
4+98					7.9	12.0
5+0	10' Ct. Abandoned 18" Pipe				8.2	11.7
5+03					7.7	12.2
5+07					6.0	13.9
5+50	5+65 10' Ct. Abandoned 18" Pipe				6.5	13.4
6+0					7.6	12.3
P.I. 6+10.62					7.6	12.3
6+50					7.6	12.3
7+0					6.8	13.1
7+50					6.5	13.4
7+72						

Spike in tele. pole 9' Lft. of 92

Bank
 Ditch
 BANK

11' Rt. 8" Pipe

11.1 - Top of 4" C.L. Water

BANK
 in ditch
 & ditch
 in ditch
 BANK

5757 over head power pole

5789 32' Lft. P.P.K-27

11' Rt. Top of Rd. ditch back slope

4' Rt. Shrub

STATION
DATE
TIME
OFFICER
REMARKS

STATION
DATE
TIME
OFFICER
REMARKS

VALUABLE

SUBJECT Profile of topog-
contd.

RETURN TO
PUBLIC WORKS
OFFICE
CAMP LEJEUNE
NORTH CAROLINA

FIELD PARTY

IN CHARGE _____
INSTRUMENT _____
NOTES _____
TAPE READ _____
TAPE OR ROD _____
TAPE OR ROD _____
INSTRUMENT NO. _____
TAPE NO. _____

WEATHER

CLEAR _____ SNOW _____
CLOUDY _____ HOT _____
WINDY _____ MODERATE _____
RAIN _____ COLD _____
FAIR _____ FOG _____
FIGURED BY _____
NOTES CHECKED BY _____
PLOTTED BY _____

FILE No. _____
FLDR. No. _____
SHEET 2 of
DATE 12-10 1958

Quad. No. _____

STATION	DIST.	ANGLE ° ' "	+	H. I. BEARING	VER. ANG. DIFF.	ELEVATION	
7+75				19.89 ✓ (19.9)			28' Lft. P.P. K-26
8+0					5.9	14.0	
T.P.					4.67	15.22 ✓	
8+47				5.89 21.11 ✓ (21.1)			4' Lft. End of Hedge
8+50					6.7	14.4	
8+60							7' Lft. Hedge
8+73							22' Lft. Hedge - 58' Lft. End Hedge
8+81							7' Rt. Shrub
8+90					6.3	14.8	
8+97					5.6	15.5	
8+99					5.5	15.6	Edge asphalt street
9+0					5.5	15.6	
9+19					5.3	15.8	Edge st.
9+21					5.3	15.8	
9+25					5.8	15.3	17' Lft. Angle Power Pole K-25 overhead Tele. & Power line
9+28							6' Rt. shrub
9+32							10.5' Rt. shrub - 16' Rt. Back slope
9+38							4" Water line
9+40				IN DITCH 19' Rt.	8.4	12.7	TOP
9+50					5.5	15.6	
9+91				IN DITCH 20' Rt.	7.55	13.56	TOP 6" same Water line
10+0					5.1	16.0	
10+50					4.9	16.2	
10+56							63' Lft. P.P. K-24
10+97							7' Rt. shrub
11+0					4.7	16.4	9' Rt. "
11+06							7' Rt. "
11+50					3.9	17.2	
12+0					2.0	18.1	13' Rt. Back slope


























VALUABLE

SUBJECT

Profile # T9209,
contd.RETURN TO
PUBLIC WORKS
OFFICE
CAMP LEJEUNE
NORTH CAROLINA

FIELD PARTY

 _____ IN CHARGE
 _____ INSTRUMENT
 _____ NOTES
 _____ TAPE READ
 _____ TAPE OR ROD
 _____ TAPE OR ROD
 _____ INSTRUMENT NO.
 _____ TAPE NO.

WEATHER

 CLEAR _____ SNOW _____
 CLOUDY _____ HOT _____
 WINDY _____ MODERATE _____
 RAIN _____ COLD _____
 FAIR _____ FOG _____
 FIGURED BY _____
 NOTES CHECKED BY _____
 PLOTTED BY _____

FILE No. _____

FLDR. No. _____

SHEET

3-0f

DATE

12-10 1958

Quad. No. _____

STATION	DIST.	ANGLE ° ' "	+	H. I. BEARING	VER. ANG. DIFF.	ELEVATION	
12+50				21.11 ✓ (21.1)	2.3	18.8	
12+58							9' RT. shrub
P.I. 12	68.22				2.1	19.0	
12+0					1.7	19.4	
13+31					1.0	20.1	
13+50					1.1	20.0	
13+58					1.4	19.7	
13+64					2.7	18.4	Rd. Ditch
13+69					1.2	19.9	shoulder
13+76					0.7	20.4	Edge Marl Drive
13+85					0.8	20.3	" " "
13+96					0.8	20.3	
14+0					1.3	19.8	
T.P.					0.28	20.83 ✓	
14+04			4.42 ✓	25.25 ✓ (25.3)	6.6	18.7	Ditch
14+11					5.8	19.5	BANK
14+37							overhead tele. line
14+43							16' RT. Tele. pole
14+50					4.8	20.5	
14+64							overhead tele. line 35' RT. P.P. & tele
14+82							overhead power line
15+0					4.5	20.8	15' Lft. 18" Sweet Gum
15+08							8' Lft. 12" Pine
15+19							27' RT. 20" Pine - 32' RT. Back slope
15+25					4.6	20.7	BANK - 4' Lft. 20" Sweet Gum
15+28							21' Lft. Street Light Pole - EA-2
15+32					6.0	19.3	DITCH
15+40					4.5	20.8	BANK - 4.5' RT. 24" Pine









VALUABLE

SUBJECT

Profile & topog. cont'd.

RETURN TO
PUBLIC WORKS
OFFICE
CAMP LEJEUNE
NORTH CAROLINA

FIELD PARTY

 _____ IN CHARGE
 _____ INSTRUMENT
 _____ NOTES
 _____ TAPE READ
 _____ TAPE OR ROD
 _____ TAPE OR ROD
 _____ INSTRUMENT NO.
 _____ TAPE NO.

WEATHER

 CLEAR _____ SNOW _____
 CLOUDY _____ HOT _____
 WINDY _____ MODERATE _____
 RAIN _____ COLD _____
 FAIR _____ FOG _____
 FIGURED BY _____
 NOTES CHECKED BY _____
 PLOTTED BY _____

FILE No. _____

FLDR. No. _____

SHEET

4-07

DATE

12-10-58

Quad. No. _____

STATION	DIST.	ANGLE ° ' "	+	H. I. BEARING	VER: ANG. DIFF.	ELEVATION
---------	-------	----------------	---	------------------	--------------------	-----------

15746				25.25 (25.3)	✓ 4.7	20.6
15748					4.7	20.6
15750					4.9	20.4
15787					5.0	20.3
15790					6.2	19.1
15797					5.1	20.2
1670					4.7	20.6
P.I 16+15734						

B.M.					2.37	22.88
------	--	--	--	--	------	-------

22.90

B.M.				20424 ⁹² 44		22 ⁸⁸ 90
------	--	--	--	--------------------------------------	--	-----------------------------------

16+1934				(14.9)	4.5	20.4
---------	--	--	--	--------	-----	------

16+2834					6.1	18.8
---------	--	--	--	--	-----	------

16+3834					3.8	21.1
---------	--	--	--	--	-----	------

16+4934					3.14	21.76
---------	--	--	--	--	------	-------

16+7000					3.18	21.74
---------	--	--	--	--	------	-------

16+79					3.7	21.2
-------	--	--	--	--	-----	------

16+88					5.3	19.6
-------	--	--	--	--	-----	------

16+94					3.4	21.5
-------	--	--	--	--	-----	------

Edge asphalt parking lot
13' Rtl. corr parking lotEdge asphalt drive
Bank
Ditch
Bank

MON. #504

MON. #504

B.

D

B

EDGE RD.

EDGE RD.

B

D

B

120
 3) 217-20
 72-26-40

151-57-00
 3
 453-42
 360
 95-42

288-52-30
 360
 3) 648
 216-17-30

179-50-30

179-50-30

179-46-
 260
 3) 539 166 60
 179-55-20





VALUABLE

SUBJECT

Water Line Profile
contd.RETURN TO
PUBLIC WORKS
OFFICE
CAMP LEJEUNE
NORTH CAROLINA5.1

FIELD PARTY

IN CHARGE

INSTRUMENT

NOTES

TAPE READ

TAPE OR ROD

TAPE OR ROD

INSTRUMENT No.

TAPE No.

WEATHER

CLEAR _____ SNOW _____
CLOUDY _____ HOT _____
WINDY _____ MODERATE _____
RAIN _____ COLD _____
FAIR _____ FOG _____
FIGURED BY _____
NOTES CHECKED BY _____
PLOTTED BY _____

FILE No. _____

FLDR. No. _____

SHEET

54

DATE

12-19-58

Quad. No. _____

STATION	DIST.	ANGLE ° ' "	+	H. I. BEARING	VER: ANG. DIFF.	ELEVATION	
17+00				24.74 ⁹² (24.9)	3.9	21.0	
17+04							8.50' LT. 15" PINE
17+13							48' LT. COR. WOODS
17+13							7.50' RT. 6" DOGWOOD.
17+13							14' RT. 18" GUM.
17+15							7.50' RT. 4" DOGWOOD.
17+30					4.8	20.1	
17+30							9' LT. 9" OAK
17+46							7' LT. CLUSTER 3" DOGWOODS
17+48							8' RT. 6" DOGWOOD
17+50					5.1	19.8	
17+58							6' LT. ① 12" POPLAR. ① 10" POPLAR ① 4" POPLAR
17+64							6" BAY ON E
17+71							3' RT. 2 4" DOGWOODS
17+83							WOODS LINE
17+83					5.6	19.3	
18+00					5.7	19.2	
18+50					6.0	18.9	
18+50							20' LT. E DITCH
18+73							7' LT. E DITCH
19+00					5.8	19.1	
19+00							9' LT. E 2'x2' DITCH
T-P.					5.02	19. ⁹⁰ 19.72	
				206 21. ⁹⁶ 98			






VALUABLE

SUBJECT _____

 RETURN TO
 PUBLIC WORKS
 OFFICE
 CAMP LEJEUNE
 NORTH CAROLINA

FIELD PARTY

 _____ IN CHARGE
 _____ INSTRUMENT
 _____ NOTES
 _____ TAPE READ
 _____ TAPE OR ROD
 _____ TAPE OR ROD
 _____ INSTRUMENT NO.
 _____ TAPE NO.

WEATHER

 CLEAR SNOW
 CLOUDY HOT
 WINDY MODERATE
 RAIN COLD
 FAIR FOG

FILE No. _____

FLDR. No. _____

SHEET 6 of

DATE _____ 19__

Quad. No. _____

STATION	DIST.	ANGLE		+	H. I. BEARING	VER. ANG. DIFF.	ELEVATION	
		°	' "					
19+50					21.96 <u>22.0</u>	2.9	19.1	
20+00						2.7	19.3	23' LT. & 2'x2' DITCH
20+50						3.4	18.6	15' LT. & 2'x2' DITCH
20+80						3.8	18.2	
21+00						2.9	19.1	
21+04						3.6	18.4	BANK 2'x2' DITCH
21+05						5.4	16.6	DITCH
21+10						5.4	16.6	DITCH
21+13						4.1	17.9	BANK 2'x2' DITCH
21+27								7' RT. & 2'x2' DITCH
21+50						4.4	17.6	
21+71								7' RT. END 2'x2' DITCH
22+00						4.8	17.2	
22+50						4.8	17.2	
23+00						4.6	17.4	





































VALUABLE
 SUBJECT _____

 RETURN TO
 PUBLIC WORKS
 OFFICE
 CAMP LEJEUNE
 NORTH CAROLINA

FIELD PARTY

 _____ IN CHARGE
 _____ INSTRUMENT
 _____ NOTES
 _____ TAPE READ
 _____ TAPE OR ROD
 _____ TAPE OR ROD
 _____ INSTRUMENT NO.
 _____ TAPE NO.

WEATHER

 CLEAR
 CLOUDY
 WINDY
 RAIN
 FAIR
 SNOW
 HOT
 MODERATE
 COLD
 FOG

FILE No. _____

FLDR. No. _____

SHEET 7af

NOTES CHECKED BY _____

PLOTTED BY _____ DATE 12-19-58

Quad. No. _____

STATION	DIST.	ANGLE			+	H. I. BEARING	VER: ANG. DIFF.	ELEVATION
		°	'	"				
23+37					21 ⁹⁶ <u>22.0</u>	4 8	17.2	
23+50						5 7	16.3	
23+59						6 7	15.3	
24+00						9 3	12.7	
24+22	<u>88</u>				P.I. #5	9 9	12.1	
T.P.						9 7 ²⁰ 6	12.27	
24+57					3.07 <u>15.3</u>	4.5	10.8	
+97						2.7	12.6	
25+						3.4	11.9	
+04						3.4	11.9	
+08						3.5	11.8	
+11						2.3	13.0	
+30						1.1	14.2	
+43						2.0	13.3	
+49						4.5	10.8	
+54						5.0	10.3	
+57						2.2	13.1	
+60						2.2	13.1	
+63						5.1	10.2	
+75						6.1	9.2	

P.I. #5

ON HUB P.I. #5

Edge opening ← 90° ±

12' Rd.

Edge woods

15	6	0	15
6.8	2.3	1.1	0.7
8.5	13.0	14.2	14.6

22	7	0	14	25
11.2	7.9	6.1	5.5	8.7
4.1	7.4	9.2	9.8	6.6


















































































VALUABLE

SUBJECT

*Profile cont'd.*RETURN TO
PUBLIC WORKS
OFFICE
CAMP LEJEUNE
NORTH CAROLINA

FIELD PARTY

IN CHARGE

INSTRUMENT

NOTES

TAPE READ

TAPE OR ROD

INSTRUMENT NO.

TAPE NO.

WEATHER

CLEAR SNOW
CLOUDY HOT
WINDY MODERATE
RAIN COLD
FAIR FOG

FILE No. _____

FLDR. No. _____

SHEET

8-07

DATE


12-19-58

Quad. No. _____

STATION	DIST.	ANGLE ° ' "	+	H. I. BEARING	VER: ANG. DIFF.	ELEVATION
25+ 84				151.29 <u>151.3</u>	8.6	6.7
+92					13.5	1.8
+98					12.4	1.9
+99					17.8	0.5
26+0					14.8	0.5
+06					14.0	1.3
26+13	R MAIN RUN				14.9	0.4
26+17					15.0	0.3
+17					14.0	1.3
+21					13.0	2.3
+27					9.9	5.4
+32						
+39					9.7	5.6
+63					7.0	8.3
27+0					6.7	8.6
27+23					6.0	9.3
+50					5.2	10.1
+71					6.0	9.3
+93					4.6	10.7
T.P.						.94
					.15	2.33
					8.21	21.77

Edge FRENCHMANSCREEK

0.0

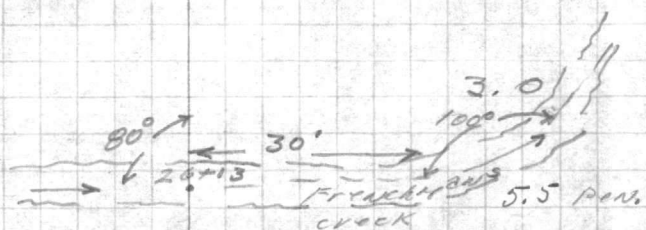Edge creek
NOTE: Large trees on dyke

3.0

10	5	0	5	13
13.8	9.3	8.9	9.5	12.1
1.5	6.0	6.4	5.8	3.2

17	4	0	3	16
12.7	6.7	6.7	7.1	13.0
2.16	8.6	8.6	8.2	2.3

*1=10' H.V.**penetration*

35-26
35-30
35-32
35-36





VALUABLE

SUBJECT Profile contd.

RETURN TO
PUBLIC WORKS
OFFICE
CAMP LEJEUNE
NORTH CAROLINA

FIELD PARTY

____ IN CHARGE
____ INSTRUMENT
____ NOTES
____ TAPE READ
____ TAPE OR ROD
____ TAPE OR ROD
____ INSTRUMENT NO.
____ TAPE NO.

WEATHER

CLEAR _____ SNOW _____
CLOUDY _____ HOT _____
WINDY _____ MODERATE _____
RAIN _____ COLD _____
FAIR _____ FOG _____
FIGURED BY _____
NOTES CHECKED BY _____
PLOTTED BY _____


FILE No. _____
FLDR. No. _____
SHEET 9-04
DATE 12-19 1958

Quad. No. _____

STATION	DIST.	ANGLE " "	+	H. I. BEARING	VER: ANG. DIFF.	ELEVATION
28+0		END of DYK		21.15 21.17 <u>21.2</u>	8.9	12.3
28+0B					3.9	17.3
28+28					3.6	17.6
P.I. 28+42.88					4.2	17.0
T.B.M. on #46					4.98	16.17
				6.93 ¹⁰ 23.12 <u>23.1</u>		
29+0					6.9	16.2
+50					7.2	15.9
30+					7.0	16.1
+50					5.0	18.1
31+					4.0	19.1
+50					4.8	18.3
32+					4.8	18.3
+50					4.3	18.8
+74					5.2	17.9
+85					6.4	16.7
+97.30 P.O.T.					5.9	17.2
33+					6.4	16.7
+17					7.2	15.9
+50					10.6	12.5
+67					10.9	12.2
34+					9.7	13.48
T.P.					8.72	14.78
B.M.				5.49 ⁸⁷ 19.89	5.39	14.50

20 9 0 5 10
13.3 9.6 8.9 8.8 5.2
7.9 11.6 12.3 12.4 16.0

up line from P.I. 28+

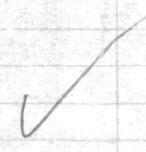

(14.55) M.W. # 514


























25700.00
 90.31
 34719.69

160-

EXTRACTION

VALUABLE

SUBJECT

*Profile contd.*RETURN TO
PUBLIC WORKS
OFFICE
CAMP LEJEUNE
NORTH CAROLINA

FIELD PARTY

 _____ IN CHARGE
 _____ INSTRUMENT
 _____ NOTES
 _____ TAPE READ
 _____ TAPE OR ROD
 _____ TAPE OR ROD
 _____ INSTRUMENT NO.
 _____ TAPE NO.

WEATHER

 CLEAR
 CLOUDY
 WINDY
 RAIN
 FAIR
 SNOW
 HOT
 MODERATE
 COLD
 FOG

FILE No. _____

FLDR. No. _____

SHEET

10 of

DATE

12-19-58

Quad. No. _____

STATION	DIST.	ANGLE ° ' "	+	H. I. BEARING	VER. ANG. DIFF.	ELEVATION
B.M.						14.55 ✓
			5.74	20.29 ✓		
P.I. 24+19.69				20.3	5.6	14.7
34+29					2.2	15.1
+34					6.6	13.7
+40					6.4	13.9
+41					5.7	14.6
+47					2.9	14.4
+55					2.6	14.7
+68					5.9	14.4
+71					5.8	14.5
+75					7.0	13.3
+79					6.2	14.1
+83					3.4	16.9
35+					4.8	15.5
+50					5.1	15.2
+70					4.7	15.6
+78					2.4	16.9
36+					4.0	16.3
P.I. 26+09.46					4.5	15.8
36+28					4.8	15.5
+50						
36+53		35' Rt. cor. House # 3528				
36+76					2.3	18.0
+89					1.3	19.0
37+0		18' Rt. cor. House # 3526				

MON. # 514

Edge of clearing

Edge of Green House Road } Road 90°
E " " " " } TO LIND

Edge " " " " }

Edge woods & BANK

Edge of clearing (yard)

 20 7 0 10
 8.0 5.1 3.3 1.9
 12.3 15.2 17.0 18.4

 20 10 0 3 10
 8.6 4.7 1.6 0.5 0.0
 11.7 15.6 18.7 19.8 20.3






VALUABLE

SUBJECT

Profile contd.

RETURN TO
PUBLIC WORKS
OFFICE
CAMP LEJEUNE
NORTH CAROLINA

FIELD PARTY

 _____ IN CHARGE
 _____ INSTRUMENT
 _____ NOTES
 _____ TAPE READ
 _____ TAPE OR ROD
 _____ TAPE OR ROD
 _____ INSTRUMENT NO.
 _____ TAPE NO.

WEATHER

 CLEAR
 CLOUDY
 WINDY
 RAIN
 FAIR
 SNOW
 HOT
 MODERATE
 COLD
 FOG
 FIGURED BY _____
 NOTES CHECKED BY _____
 PLOTTED BY _____

FILE No. _____

FLDR. No. _____

SHEET

11-07

DATE

12-19 1958

Quad. No. _____

STATION	DIST.	ANGLE ° ' "	+	H. I. BEARING	VER. ANG. DIFF.	ELEVATION
---------	-------	----------------	---	------------------	--------------------	-----------

20.29 ✓

20.3

37+50

1.9 18.4

37+67.7 12' Rt. 1/2" planted tree

26' Rt. cor. House # 3526

~~P.F. 37+73.76~~

T.P.

6.13 23.68 ✓ 2.74 17.55 ✓

P.Z. 37+73.76

23.7

20	9	0	10	18
11.4	8.0	6.2	4.1	3.1
12.3	15.7	17.5	19.6	20.6

37+89

5.3 18.4

38+0

4.4 19.3 ✓

+17

5.3 18.4

+38

5.5 18.2

+50

4.9 18.8

+75

4.3 19.4

+87

39+

4.3 19.4

+50

4.2 19.5

40+

3.5 20.2

+30

2.6 21.1

P.I. 40+56.46

2.2 21.5

T.B.M.

2.23 21.45 ✓

ON HUB P.F. 40+50.46

20	8	0	6	18
9.0	6.7	5.0	3.8	3.0
14.7	17.0	18.7	19.9	20.7











VALUABLESUBJECT Profile & Topog. - water
LineRETURN TO
PUBLIC WORKS
OFFICE
CAMP LEJEUNE
NORTH CAROLINA

FIELD PARTY

IN CHARGE

INSTRUMENT

NOTES

TAPE READ

TAPE OR ROD

TAPE OR ROD

INSTRUMENT NO.

TAPE NO.

WEATHER

CLEAR
CLOUDY
WINDY
RAIN
FAIR
SNOW
HOT
MODERATE
COLD
FOG
FIGURED BY _____
NOTES CHECKED BY _____
PLOTTED BY _____

FILE No. _____

FLDR. No. _____

SHEET 12-0fDATE 12-22-58

Quad. No. _____

STATION	DIST.	ANGLE ° ' "	+	H. I. BEARING	VER. ANG. DIFF.	ELEVATION
T.B.M.						21.45 ✓
			5.51	26.96 ✓		
40+68		22' Lft.		END of 15" R.C.P.		
40+77				(27.0)	9.15	17.81
40+95	28' Rt.			cor. House #		3510
41+					4.9	22.1
+50					4.3	22.7
+73	4' Lft.			1" Planted tree		
+92	18.5' Rt.			cor. House #		3508
+2+					3.8	23.2
+30	22' Rt.			cor. House #		3506
+50					4.3	22.7
+75					5.0	22.0
43+					6.1	20.9
P.I. 43+26.00					7.5	19.5
43+50					6.5	20.5
+75					5.2	21.8
44+					4.7	22.3
+50					3.6	23.4
45+					3.3	23.7
+50					3.3	23.7
46+					3.3	23.7
+44	2' Lft.			shrub		
+51					3.6	23.4
+65	9' Rt.			shrub		
+70	6' Rt.			"		

ON HUB P.I. 40+56.46

TOP of 15" R.C.P.17.8
- 1.4
16.4 Invert

8' Lft. shrub







VALUABLE

SUBJECT

Profile cont'd.

RETURN TO
PUBLIC WORKS
OFFICE
CAMP LEJEUNE
NORTH CAROLINA

FIELD PARTY

 _____ IN CHARGE
 _____ INSTRUMENT
 _____ NOTES
 _____ TAPE READ
 _____ TAPE OR ROD
 _____ TAPE OR ROD
 _____ INSTRUMENT NO.
 _____ TAPE NO.

WEATHER

 CLEAR
 CLOUDY
 WINDY
 RAIN
 FAIR
 SNOW
 HOT
 MODERATE
 COLD
 FOG

FILE No. _____

FLDR. No. _____

FIGURED BY _____

SHEET 12 of

NOTES CHECKED BY _____


DATE 12-22-58

PLOTTED BY _____

Quad. No. _____

STATION	DIST.	ANGLE		H. I. BEARING	VER. ANG. DIFF.	ELEVATION
		°	"			
			+	26.96 ✓		
46+74.5				8.4' Rt. cor. House # 3445		
+81				7' Lft. 3" Mimosas tree		
+86				8.5' Rt. Guy Anchor		
+91				10' Rt. "		
+96.5				8.7' Lft. cor. House # 3225		
47+				4.5' 22.5'		
+04				15' Rt. Power pole		
+12.5				3' Rt. Shrub Row End		
+17				Shrub		
+32				7' Lft. End of Shrub Row		
+50				5.2 21.8		
+69				5.2 21.8		
+73				5.2 21.8		
+75				5.7 21.3		
47+95				invert 15.3 11.7		
48+0				5.2 21.8		
Bolt	48+12.65			5.2 21.8		
B.M.				2.33 24.63 ✓		
				(24.65)		

Edge of 4' side walk
 " " " " " " 1.2' Lft. End of 2' x 3' D.I.
 Edge of asphalt street
 8' Lft. sewer man hole

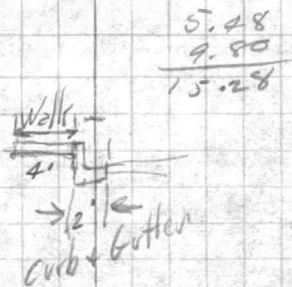

2nd inside edge
of 6" Curb.

ON Fire Hyd. Print House # 3220

4800'

N 50° E
 N 51° E
 N 50° 45' E
 100 49
 ————
 40 11 74
 1390 498















VALUABLE

SUBJECT SEWER LOC.
TOWNSHIP TERRACE

RETURN TO
PUBLIC WORKS
OFFICE
CAMP LEJEUNE
NORTH CAROLINA

FIELD PARTY

____ IN CHARGE
____ INSTRUMENT
____ NOTES
____ TAPE READ
____ TAPE OR ROD
____ TAPE OR ROD
____ INSTRUMENT NO.
____ TAPE NO.

WEATHER

CLEAR
CLOUDY
WINDY
RAIN
FAIR
SNOW
HOT
MODERATE
COLD
FOG

FILE No. _____
FLDR. No. _____
SHEET 1-0 F
DATE 1-2 1959

Quad. No. _____

STATION	DIST.	ANGLE			H. I. BEARING	VER. ANG. DIFF.	ELEVATION
		°	'	"			
45+79.20					- 2.8		
43+12					- 6.65		

8" C.I.
FORCE MAIN
T.C.
8" SEWER

23.5
- 2.8

20.7

20.2
6.7

13.5

○

















































VALUABLE

RETURN TO
PUBLIC WORKS
OFFICE
CAMP LEJEUNE
NORTH CAROLINA

SUBJECT LOCATION SEWER
LINE ON PROPOSED
WATERLINE CAMP KNOX
TO TARAUA TERRACE


FIELD PARTY
DENNIS IN CHARGE
____ INSTRUMENT
____ NOTES
____ TAPE READ
____ TAPE OR ROD
____ TAPE OR ROD
____ INSTRUMENT No.
____ TAPE No.

WEATHER
CLEAR SNOW
CLOUDY HOT
WINDY MODERATE
RAIN COLD
FAIR FOG
FIGURED BY _____
NOTES CHECKED BY _____
PLOTTED BY _____

FILE No. _____
FLDR. No. _____
SHEET 1 of 2
DATE 1-5-59

Quad. No. _____

STATION	DIST.	ANGLE ° ' "	+	H. I. BEARING	VER. ANG. DIFF.	ELEVATION
---------	-------	----------------	---	------------------	--------------------	-----------

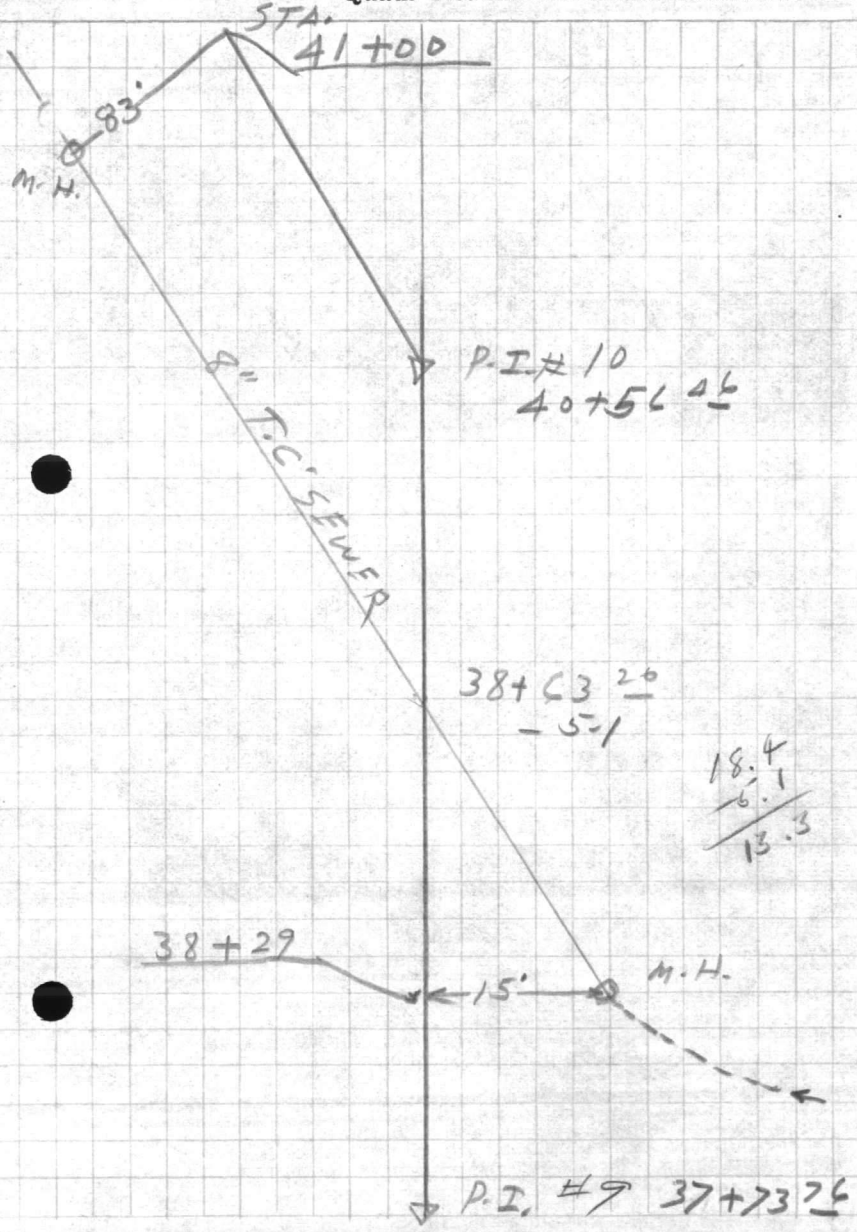





VALUABLE

SUBJECT _____

RETURN TO
PUBLIC WORKS
OFFICE
CAMP LEJEUNE
NORTH CAROLINA

FIELD PARTY

IN CHARGE

INSTRUMENT

NOTES

TAPE READ

TAPE OR ROD

TAPE OR ROD

INSTRUMENT No.

TAPE No. _____

WEATHER

CLEAR
CLOUDY
WINDY
RAIN
FAIR
SNOW
HOT
MODERATE
COLD
FOG

FILE No. _____

FLDR. No. _____

SHEET 2 of

FIGURED BY _____


NOTES CHECKED BY _____

PLOTTED BY _____

DATE _____ 19__

Quad. No. _____

STATION	DIST.	ANGLE			H. I. BEARING	VER: ANG. DIFF.	ELEVATION
		°	'	"			

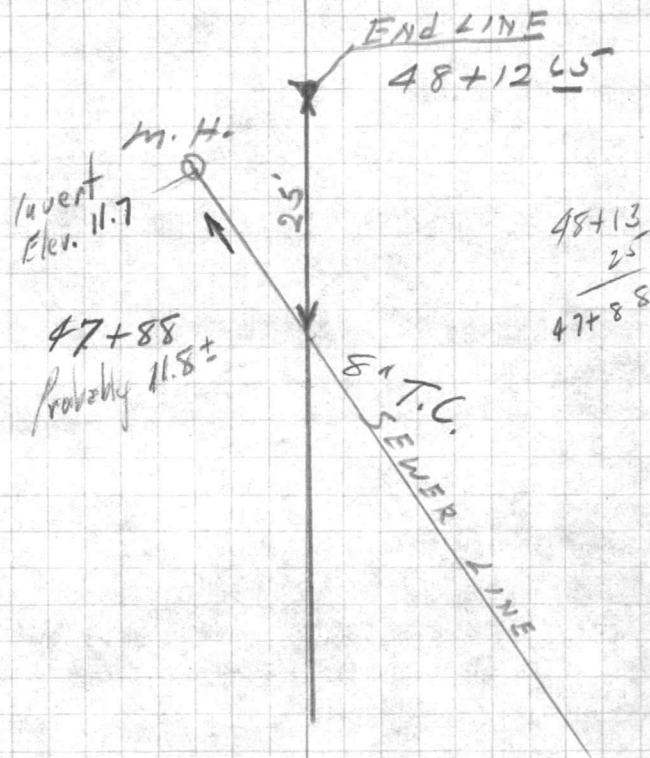






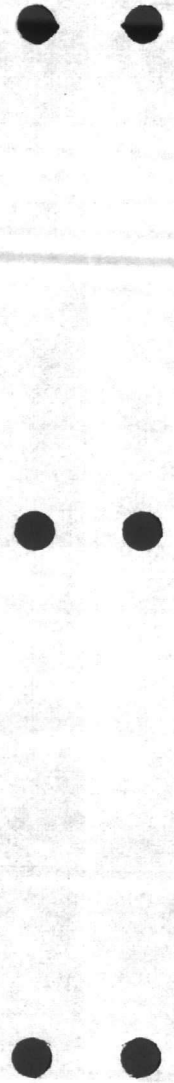

VALUABLE

SUBJECT LOCATION: HOUSES
NEAR D. I. S' 8, 9, AND 10
PROPOSED WATER LINE
CAMP KNOX & TARAWATERRACK

RETURN TO
 PUBLIC WORKS
 OFFICE
 CAMP LEJEUNE
 NORTH CAROLINA

FIELD PARTY
DFENNIS IN CHARGE
 _____ INSTRUMENT
 _____ NOTES
 _____ TAPE READ
 _____ TAPE OR ROD
 _____ TAPE OR ROD
 _____ INSTRUMENT NO.
 _____ TAPE NO.

WEATHER
 CLEAR _____ SNOW _____
 CLOUDY _____ HOT _____
 WINDY _____ MODERATE _____
 RAIN _____ COLD _____
 FAIR _____ FOG _____
 FIGURED BY _____
 NOTES CHECKED BY _____
 PLOTTED BY _____

FILE No. _____
 FLDR. No. _____
 SHEET 1 of 1
 DATE 1-5-59

Quad. No. _____

STATION	DIST.	ANGLE ° ' "	+	H. I. BEARING	VER: ANG. DIFF.	ELEVATION
AT 10		40+56.46				
B.S. 9		37+73.76				
TO A	42	250 59 30				
B	66	278 05 00				
A	89	285 39 00				
B	118	295 48 30				
A	138	302 38 00				
B	171	323 24 00				
A	186	326 26 06				
B	191	335 37 30				
A	212	347 09 00				
B	241	353 03 00				
AT 39+00						
B.S. PI 10						
TO	276	51 16 30				
	184	127 32				
AT 9		37+73.76				
B.S. 10		40+56.46				
TO A	27	84 50 00				
B	77	139 07 00				
AT 8						
B.S. 9						
A	55	40 32 00				
B	81	89 38				


HOUSE # 3512

HOUSE # 3514

HOUSE # 3516
HOUSE # 3518

HOUSE # 3520

HOUSE # 3522

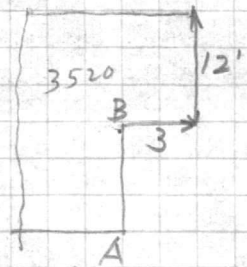INTERSECTION ST.
& CIRCLEHOUSE # 3524
HOUSE # 3526HOUSE # 3528
3530









VALUABLE

SUBJECT Camp Hook
Control for water line

RETURN TO
 PUBLIC WORKS
 OFFICE
 CAMP LEJEUNE
 NORTH CAROLINA

FIELD PARTY

____ IN CHARGE
 ____ INSTRUMENT
 ____ NOTES
 ____ TAPE READ
 ____ TAPE OR ROD
 ____ TAPE OR ROD
 ____ INSTRUMENT NO.
 ____ TAPE NO.

WEATHER

CLEAR
 CLOUDY
 WINDY
 RAIN
 FAIR
 SNOW
 HOT
 MODERATE
 COLD
 FOG
 FIGURED BY _____
 NOTES CHECKED BY _____
 PLOTTED BY _____

FILE No. 99-M
 FLDR. No. _____
 SHEET _____
 DATE 12-10 1958


Quad. No. _____

STATION	DIST.	ANGLE ° ' "	+	H. I. BEARING	VER: ANG. DIFF.	ELEVATION
---------	-------	----------------	---	------------------	--------------------	-----------

400820
 2
 80' 16' 40"

MON. #504 1-104°46'00"
 3-314°18'15"
 MEAN-104°46'05"

586-03-37 W
 75-13-55
 510 49-42 W

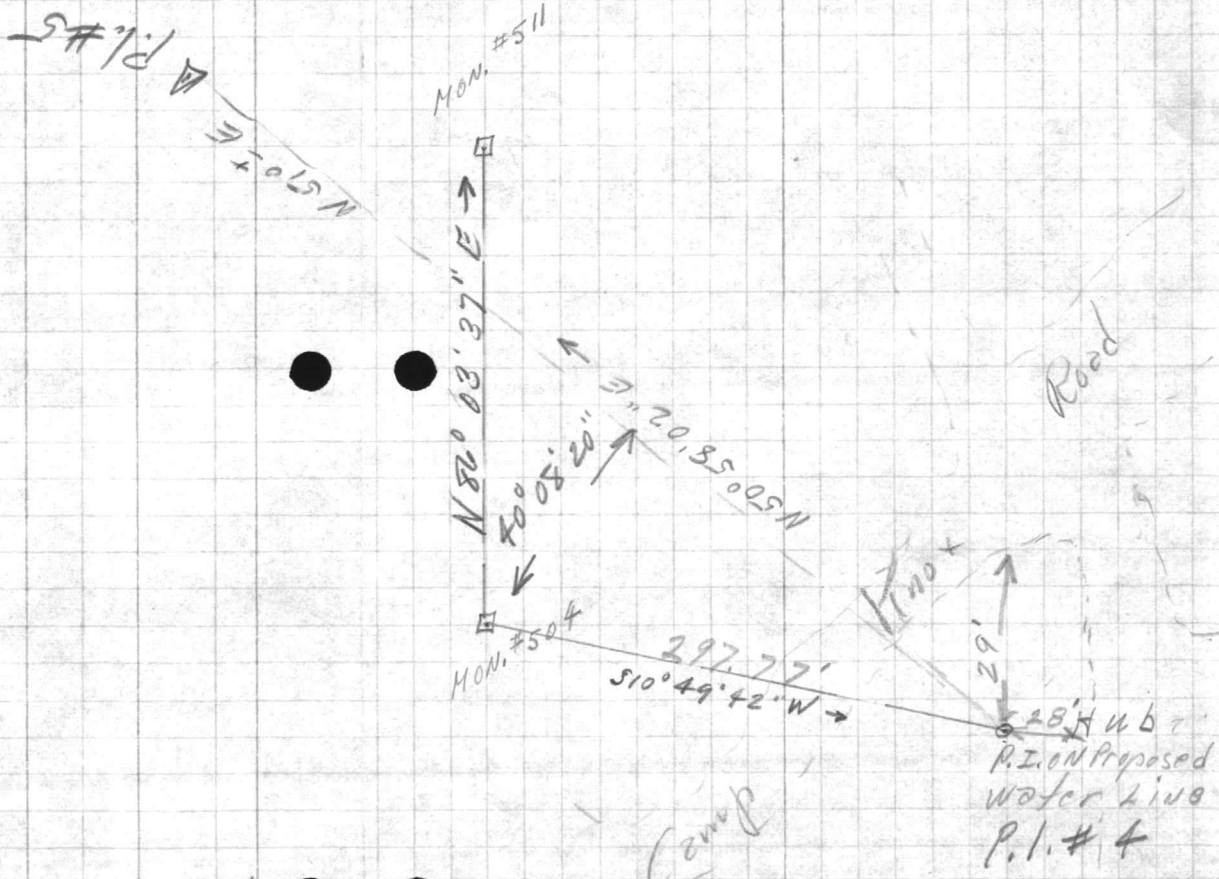




















VALUABLE

SUBJECT Proposed connecting
Water Line from camp
KNOX TO TOLAWA TORRAC

RETURN TO
PUBLIC WORKS
OFFICE
CAMP LEJEUNE
NORTH CAROLINA

FIELD PARTY

____ IN CHARGE
____ INSTRUMENT
____ NOTES
____ TAPE READ
____ TAPE OR ROD
____ TAPE OR ROD
____ INSTRUMENT NO.
____ TAPE NO.

WEATHER

CLEAR _____ SNOW _____
CLOUDY _____ HOT _____
WINDY _____ MODERATE _____
RAIN _____ COLD _____
FAIR _____ FOG _____
FIGURED BY _____
NOTES CHECKED BY _____
PLOTTED BY _____


FILE No. _____

FLDR. No. _____

SHEET 1-0f

DATE 12-10-1958

Quad. No. _____

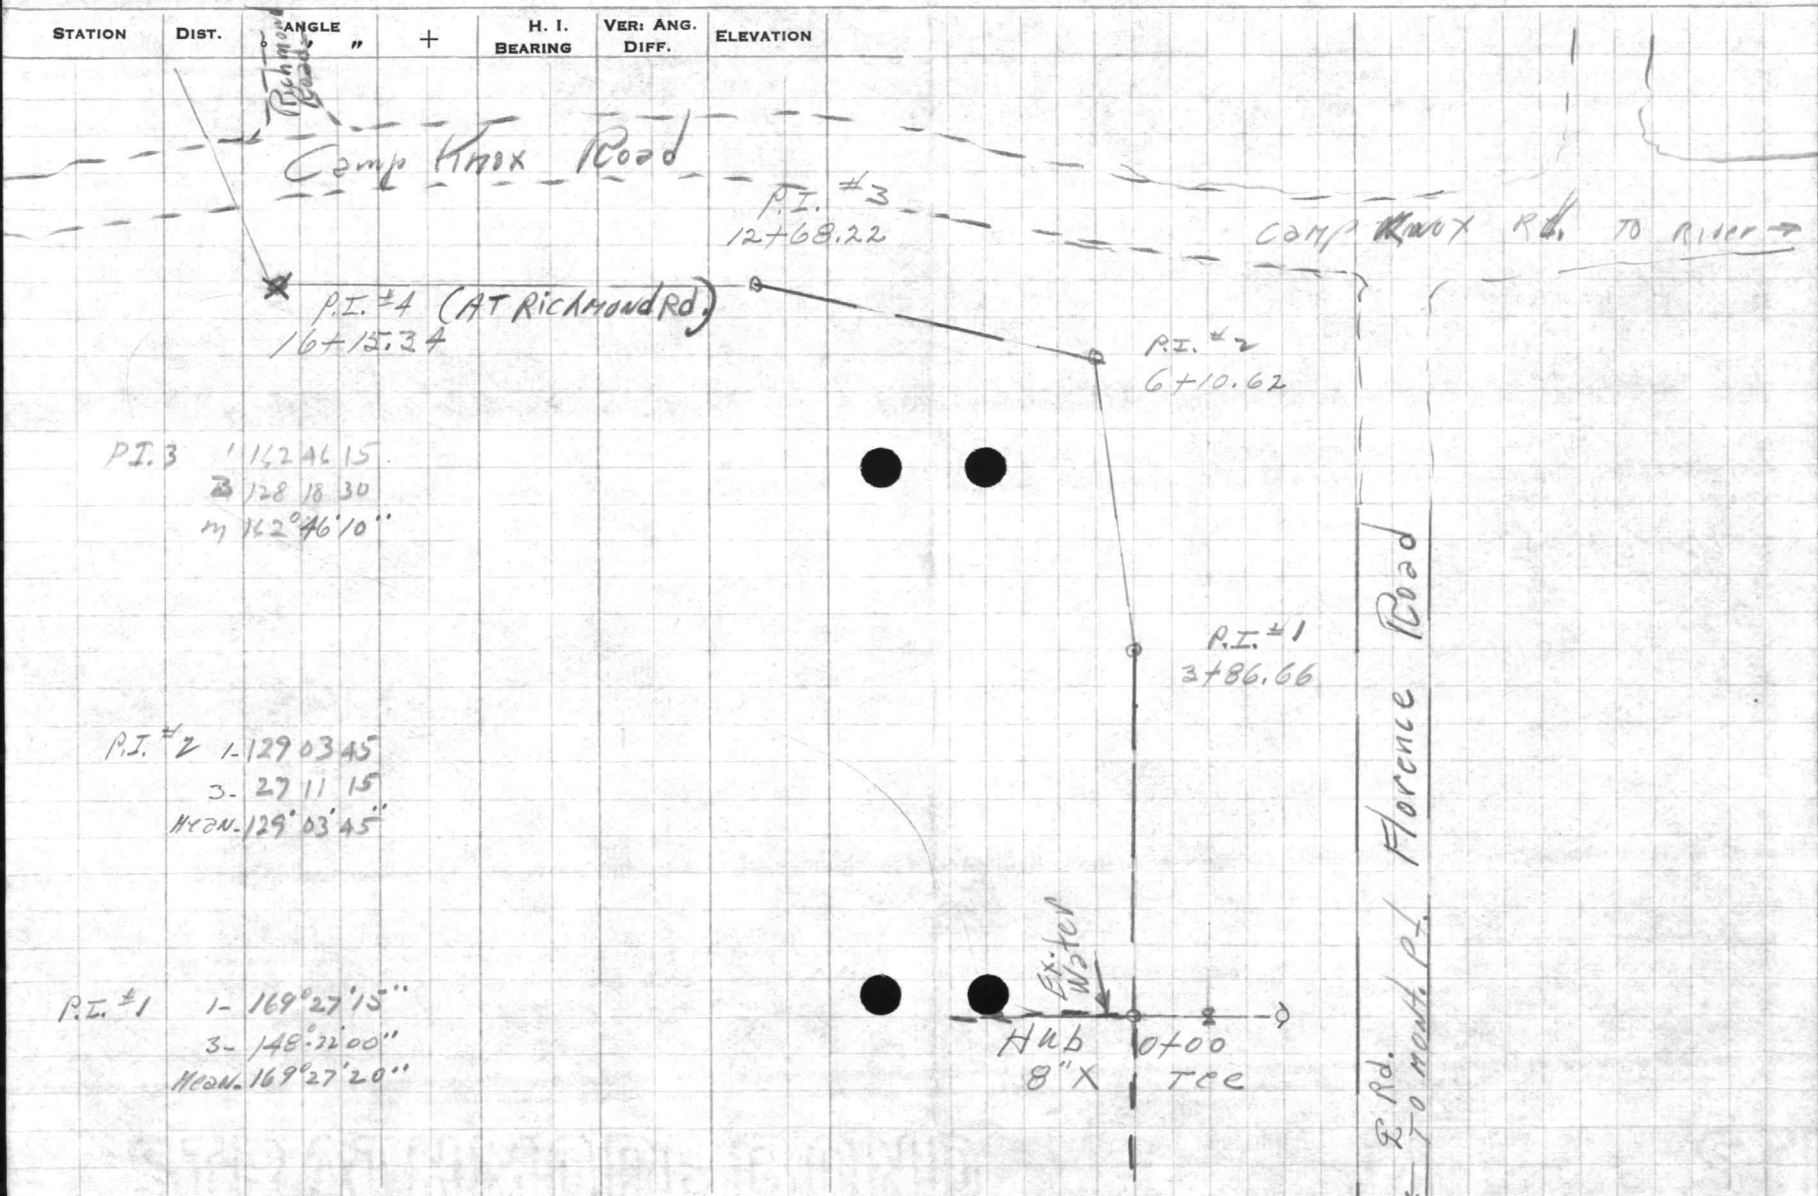

$$\begin{array}{r} 138 \\ 126 \\ \hline 12 \\ 162^{\circ} 46' 15'' \end{array}$$

$$\begin{array}{r} 3 \\ 488' 18'' 45'' \\ \hline 350 \\ 128' 18'' 45'' \\ \textcircled{3} 128' 18'' 30'' \end{array}$$

$$\begin{array}{r} 129^{\circ} 03' 45'' \\ 3 \end{array}$$

$$\begin{array}{r} 387' 11'' 15'' \\ \hline 350 \\ 27^{\circ} 11' 15'' \end{array}$$

VALUABLE

SUBJECT _____

RETURN TO
PUBLIC WORKS
OFFICE
CAMP LEJEUNE
NORTH CAROLINA

FIELD PARTY

IN CHARGE

INSTRUMENT

NOTES

TAPE READ

TAPE OR ROD

TAPE OR ROD

INSTRUMENT No.

TAPE No. _____

WEATHER

CLEAR
CLOUDY
WINDY
RAIN
FAIR
SNOW
HOT
MODERATE
COLD
FOG

FILE No. _____
FLDR. No. _____
SHEET 1-A
DATE _____ 19__

Quad. No. _____

STATION	DIST.	ANGLE			H. I. BEARING	VER. ANG. DIFF.	ELEVATION
		°	'	"			

P.I. 24+22.88

Mon. #504

40°08'20"

P.O.T. 22+83.10

P.I. 4

AT 4	1	213	20	00
3	3	230	00	00
5	17	218	20	00








EXHIBIT NO.

DATE RECEIVED

TYPE OF CASE

TYPE OF TEST

EXHIBIT NO.

DATE RECEIVED

LABORATORY

IN CHARGE

EXHIBIT NO.

DATE RECEIVED

TYPE OF CASE

TYPE OF TEST

EXHIBIT NO.

DATE RECEIVED

LABORATORY

IN CHARGE

EXHIBIT NO.

DATE RECEIVED

TYPE OF CASE

TYPE OF TEST

EXHIBIT NO.

DATE RECEIVED

VALUABLE

SUBJECT _____

RETURN TO
PUBLIC WORKS
OFFICE
CAMP LEJEUNE
NORTH CAROLINA

FIELD PARTY

IN CHARGE

INSTRUMENT

NOTES

TAPE READ

TAPE OR ROD

TAPE OR ROD

INSTRUMENT No.

TAPE No. _____

WEATHER

CLEAR
CLOUDY
WINDY
RAIN
FAIR
SNOW
HOT
MODERATE
COLD
FOG
FIGURED BY _____
NOTES CHECKED BY _____
PLOTTED BY _____

FILE No. _____
FLDR. No. _____
SHEET 1-B
DATE _____ 19__

Quad. No. _____

STATION	DIST.	ANGLE ° ' "	+	H. I. BEARING	VER: ANG. DIFF.	ELEVATION
						P.I. 34 + 19.69
P.O.T.		32 + 97	30			P.O.S. 32 + 97 30
ATC	1	141	30	00		
5	2	283	00	00		
7	4	141	30	00		
						P.I. 46 28 + 42.88
AT5	1	220	50	00		
	2	81	40	00		
	M	220	50	00		
						P.I. 45 24 + 22.80

VEHICLE

SUBJECT

SECTION TO
REGISTRATION
OFFICE
NORTH CAROLINA

STATION

DATE

WEIGHT
LOADING DATA

ELEVATION

WELL NO.

DATE

DEPTH

DIAMETER

TYPE

LOCATION

OWNER

STATUS

IN CHARGE

APPROVED

DATE

TIME

REMARKS



VEHICLE REGISTRATION

VALUABLE

SUBJECT

Water Line - Proposed
 from Camp Knox T.O.
 Tarawa Terrace
 cont'd.

RETURN TO
 PUBLIC WORKS
 OFFICE
 CAMP LEJEUNE
 NORTH CAROLINA

FIELD PARTY

____ IN CHARGE
 ____ INSTRUMENT
 ____ NOTES
 ____ TAPE READ
 ____ TAPE OR ROD
 ____ TAPE OR ROD
 ____ INSTRUMENT NO.
 ____ TAPE NO.

WEATHER

CLEAR SNOW
 CLOUDY HOT
 WINDY MODERATE
 RAIN COLD
 FAIR FOG
 FIGURED BY _____
 NOTES CHECKED BY _____
 PLOTTED BY _____

FILE No. _____

FLDR. No. _____

SHEET 1-C

DATE 12-19 1958

Quad. No. _____

STATION	DIST.	ANGLE ° ' "	+	H. I. BEARING	VER: ANG. DIFF.	ELEVATION
---------	-------	----------------	---	------------------	--------------------	-----------

P.I. 9
 37+73.76
 1-207°20'30"
 3-262°01'45"
 MEAN 207°20'35"

P.I. 8
 36+09.46
 1-191°44'15"
 3-215°12'30"
 MEAN 191°44'10"

P.I. 7
 34+17.09
 1-160°14'00"
 3-120°42'30"
 MEAN 160°14'10"

P.I. 10
 40+56.46

P.I. 9
 37+73.76

P.I. 8
 36+09.46

P.I. 7
 34+19.69

P.O.T.
 32+97.30

TO Green House
 dirt Rd.

160-14-00

191-44-15
3

575-12-45
360

~~160-13-30
3~~

~~480
360~~

120

407-20-30
3

622-01-30
360

262-01-45

215-12-00

STATIONARY

VALUABLE

SUBJECT Water Line cont'd.

RETURN TO
PUBLIC WORKS
OFFICE
CAMP LEJEUNE
NORTH CAROLINA

FIELD PARTY

IN CHARGE _____
INSTRUMENT _____
NOTES _____
TAPE READ _____
TAPE OR ROD _____
TAPE OR ROD _____
INSTRUMENT NO. _____
TAPE NO. _____


WEATHER

CLEAR _____ SNOW _____
CLOUDY _____ HOT _____
WINDY _____ MODERATE _____
RAIN _____ COLD _____
FAIR _____ FOG _____

FILE No. _____
FLDR. No. _____
SHEET _____
DATE 12-22-56

Quad. No. _____

STATION	DIST.	ANGLE		+	H. I. BEARING	VER: ANG. DIFF.	ELEVATION
		°	"				
P.I. #5?		1-	179°55'30"				
		3-	179°46'00"				
		MEAN	179°55'20"				
Bolt in		1-	72°26'30"				
P.V.M.		3-	217°20'00"				
48+12.65		MEAN	72°26'40"				
P.I. #11		1-	216°17'45"				
43+26.00		3-	288°52'30"				
		MEAN	216°17'30"				
P.I. #10		1-	151°54'00"				
40+56.46		3-	95°42'00"				
		MEAN	151°54'00"				

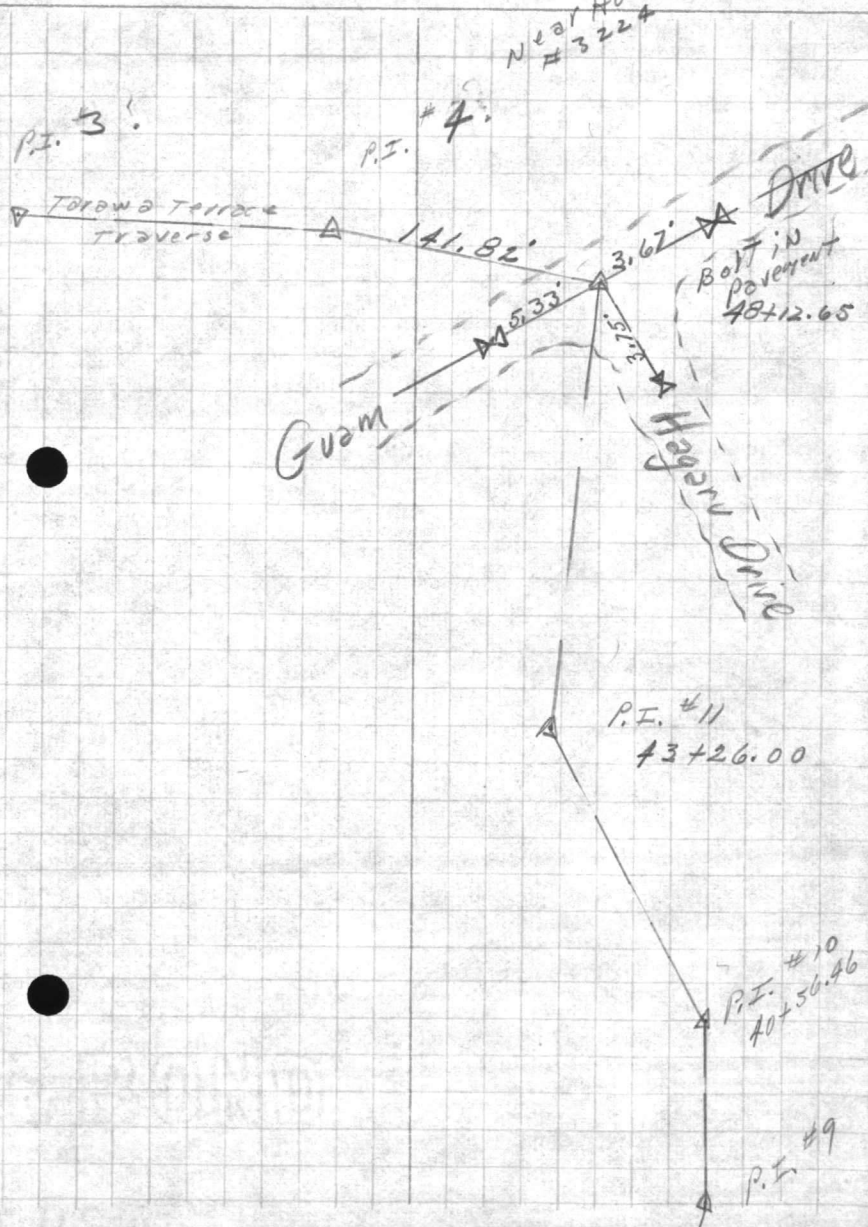

VALUABLE

RETURNED
PUBLIC WORKS
OFFICE






























PUBLIC WORKS DEPARTMENT
Camp Lejeune, North Carolina
Survey Department

File 99-M
Quadrangle 98-99
Date _____
Sheet 1 of 2

Traverse Computation
Description

Connecting Water Line, Camp Knox to Trawa Terrace

Station	Distance	Bearing	Cosine	Sine	Latitude	Departure	Y Coordinate North	X Coordinate East
Mon. # 504		S 86° 03' 37" W	from Mon. # 511				362,088.02	2,483,551.50
P.I. # 4 16+15.34 P.I. on Proposed Water Line	297.77	S 70° 49' 42" W	982194	187867	292.47	55.94	361,795.55	2,483,495.56
P.I. # 3 12+68.22	347.12	S 17-38-02 W	9530117	3029336	330.81	105.15	361,464.74	2,483,390.41
P.I. # 2 6+10.62	657.60	S 34-51-52 W	8205068	5716368	539.57	375.91	360,925.17	2,483,014.50
P.I. # 1 3+86.66	223.96	S 85-48-07 W	0732043	9973170	16.39	223.36	360,908.78	2,482,791.14
0+00	386.66	N 83-39-13 W	1105390	9938718	42.74	384.29	360,951.52	2,482,406.85
P.I. # 4 16+15.34		N 17-38-02 E	from P.I. # 3				361,795.55	2,483,495.56
P.I. # 5 24+22.88	807.54	N 50-58-02 E	6297649	7767858	508.56	627.29	362,304.11	2,484,122.85
P.I. # 6 28+42.88	420.00	S 88-11-58 E	0314204	9995063	13.20	419.79	362,290.91	2,484,542.64
P.I. # 7 34+19.69	576.81	N 53-18-02 E	5976174	8017814	344.71	462.48	362,635.62	2,485,005.12
P.I. # 8 36+09.46	189.77	N 33-32-12 E	8335324	5524705	158.18	104.84	362,793.80	2,485,109.96
P.I. # 9 37+73.76	164.30	N 45-16-22 E	7037323	7104652	115.62	116.73	362,909.42	2,485,226.69

908
4

PUBLIC WORKS DEPARTMENT
Survey Department

Station	Distance	Bearing	Course	Angle	Latitude	Departure	Coordinates North	Coordinates East

Description

Title
No.
Date
Sheet

X Coordinates
East

Coordinates
North