

Top of Pier to Bottom of Tank Capacity 115.0' <sup>99-5</sup>  
From Plan ~~29'~~  
Wrong

Top of Pier to Overflow  
144.0'

250,000 Gal. Elev. Tank.

$$\begin{array}{r} 27.08 \text{ Elev.} \\ 144 \\ \hline \end{array}$$


$$\begin{array}{r} 173 \\ 27 \\ \hline 146 \end{array}$$

$$\begin{array}{r} 173 \\ 27 \\ \hline 146 \end{array}$$

171.08 Elevation of

Overflow of Tarzuz Terrace Tank

Used 173' from  
Mr. Barker's Info.

 

**VALUABLE**

RETURN TO  
PUBLIC WORKS  
OFFICE  
CAMP LEJEUNE  
NORTH CAROLINA

SUBJECT

*B.M. and Elevations on  
Piers and Pedestal of Water Tank  
at Tarawa Terrace*

FIELD PARTY

*Dennis* IN CHARGE  
INSTRUMENT  
NOTES  
TAPE READ  
TAPE OR ROD  
TAPE OR ROD  
INSTRUMENT No.  
TAPE No.

WEATHER

CLEAR  
CLOUDY  
WINDY  
RAIN  
FAIR  
SNOW  
HOT  
MODERATE  
COLD  
FOG

FILE No. *99-5*

FLDR. No. \_\_\_\_\_

SHEET \_\_\_\_\_

DATE *9/1/1958*

FIGURED BY \_\_\_\_\_

NOTES CHECKED BY \_\_\_\_\_

PLOTTED BY \_\_\_\_\_

Quad. No. *231*

STATION	DIST.	ANGLE ° ' "	+	H. I. BEARING	VER. ANG. DIFF.	ELEVATION
				<del>27.26</del>		25.41
	3.96			29.37		
1				2.26		
2				2.26		
3				2.27		
4				2.28		
5				2.27		
6				2.28		
7				2.29		
8				2.31		
				<i>27.10 Average</i>		
				<i>27.08</i>		
				<i>27.06</i>		

*On curb across street from  
House # 2747 at joint in curb near  
end of sidewalk at Return nearest  
Water Tank.*

*1  
2  
3  
4  
5  
6  
7  
8*  
} Piers


*B.M. on Pedestal  
Manhole Top.*

*2.27*

*27.10 Average*

*27.08*

*Water Tank Standpipe*

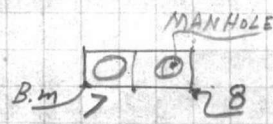

*TO HIGHWAY # 24*  
*BOUGAINVILLE DRIVE*

*2747*

*2778*

*2769*

VALUABLE

RETURN TO  


















COOL

RAIN

DRY

WEATHER

SHEET

113 210



VALUABLE

SUBJECT Tie Point Topop at  
Tarawa Terrace Water Tank

RETURN TO  
PUBLIC WORKS  
OFFICE  
CAMP LEJEUNE  
NORTH CAROLINA

FIELD PARTY

Dillon IN CHARGE  
INSTRUMENT  
NOTES  
TAPE READ  
TAPE OR ROD  
TAPE OR ROD  
INSTRUMENT NO.  
TAPE NO.


WEATHER

CLEAR SNOW  
CLOUDY HOT  
WINDY MODERATE  
RAIN COLD  
FAIR FOG  
FIGURED BY  
NOTES CHECKED BY  
PLOTTED BY

FILE No. 99-5  
FLDR. No.  
SHEET #1 of 1  
DATE 8/3/1961

Quad. No. \_\_\_\_\_

STATION	DIST.	ANGLE		+	H. I. BEARING	VER. ANG. DIFF.	ELEVATION
		°	"				
"HUB" #1	1-	168°	01'30"				
	3-	144°	04'15"				
		MEAN	168°01'25"				
		Temp 92°					
		3 (144-04-15)					
		48-01-25					
		121					
		3 (212-09-15)					
		70-43-05					
HON. #154	1-	70°	46'30"				
	3-	212°	09'15"				
		MEAN	70°46'25"				
		HON. #155					
		AT TWO JMD BLVD. & HANCOCK ST.					

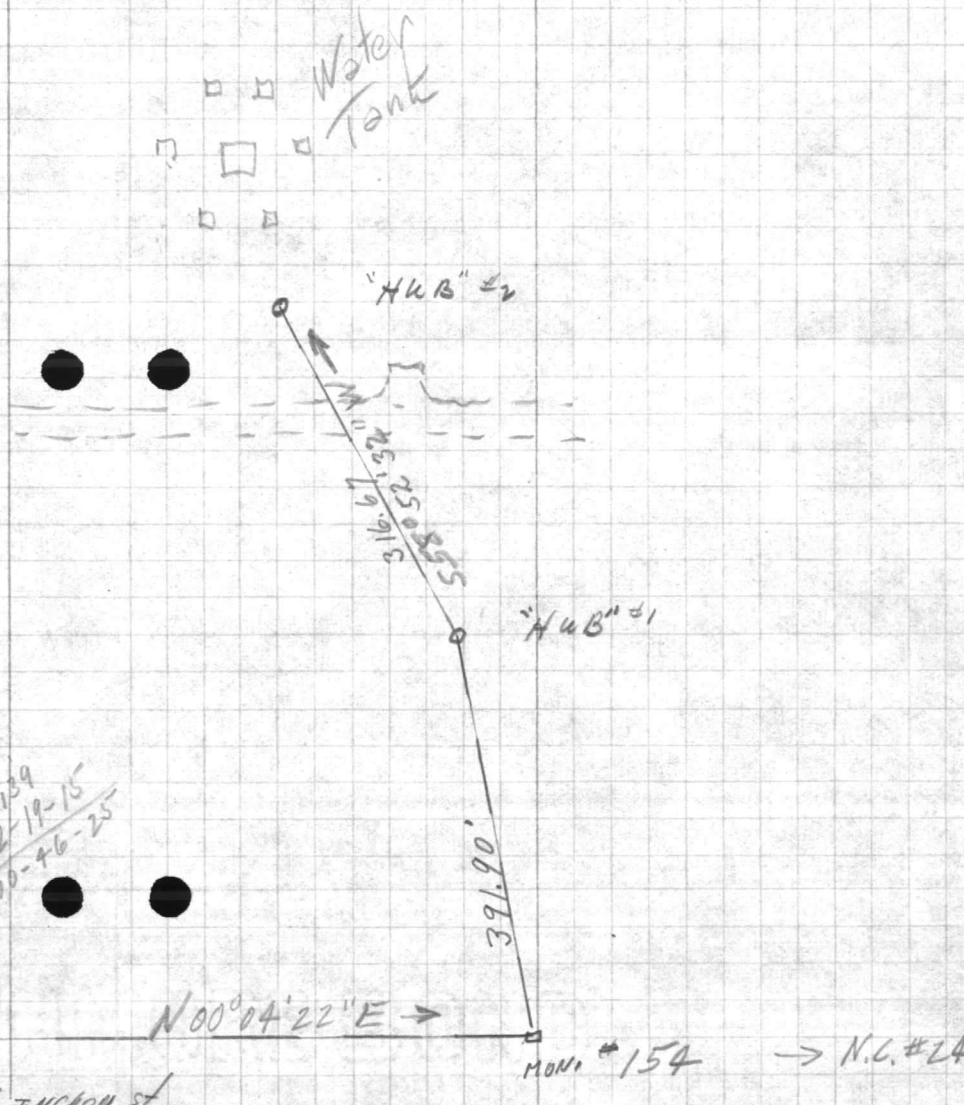

VALLEBAIA

SUBJECT

STATION  
DIST  
BEARING  
ELEVATION

STATION DIST BEARING ELEVATION

168-01-30  
140-04-15<sup>75</sup>  
300  
3)504  
168-01-25





PUBLIC WORKS DEPARTMENT  
 Camp Letour, North Carolina  
 Survey Department

11

Traverse Description

Station	Distance	Bearing	Course	Angle	Latitude	Departure	Coordinates
1							East
2							North
3							
4							
File  
 Quadrangle  
 Date  
 Sheet



**VALUABLE**

SUBJECT TRIANGULATION for  
COORDINATE of Tarawa  
TERRACE ELEVATED WATER  
TANK


RETURN TO  
PUBLIC WORKS  
OFFICE  
CAMP LEJEUNE  
NORTH CAROLINA

FIELD PARTY  
Hellum IN CHARGE  
INSTRUMENT \_\_\_\_\_  
NOTES \_\_\_\_\_  
TAPE READ \_\_\_\_\_  
TAPE OR ROD \_\_\_\_\_  
TAPE OR ROD \_\_\_\_\_  
INSTRUMENT No. \_\_\_\_\_  
TAPE No. \_\_\_\_\_

WEATHER  
CLEAR \_\_\_\_\_ SNOW \_\_\_\_\_  
CLOUDY \_\_\_\_\_ HOT \_\_\_\_\_  
WINDY \_\_\_\_\_ MODERATE \_\_\_\_\_  
RAIN \_\_\_\_\_ COLD \_\_\_\_\_  
FAIR \_\_\_\_\_ FOG \_\_\_\_\_  
FIGURED BY \_\_\_\_\_ SHEET 1-0-1  
NOTES CHECKED BY \_\_\_\_\_ DATE 10-2 19 58  
PLOTTED BY \_\_\_\_\_

FILE No. 99-5  
FLDR. No. \_\_\_\_\_  
DATE 10-2 19 58

Quad. No. \_\_\_\_\_

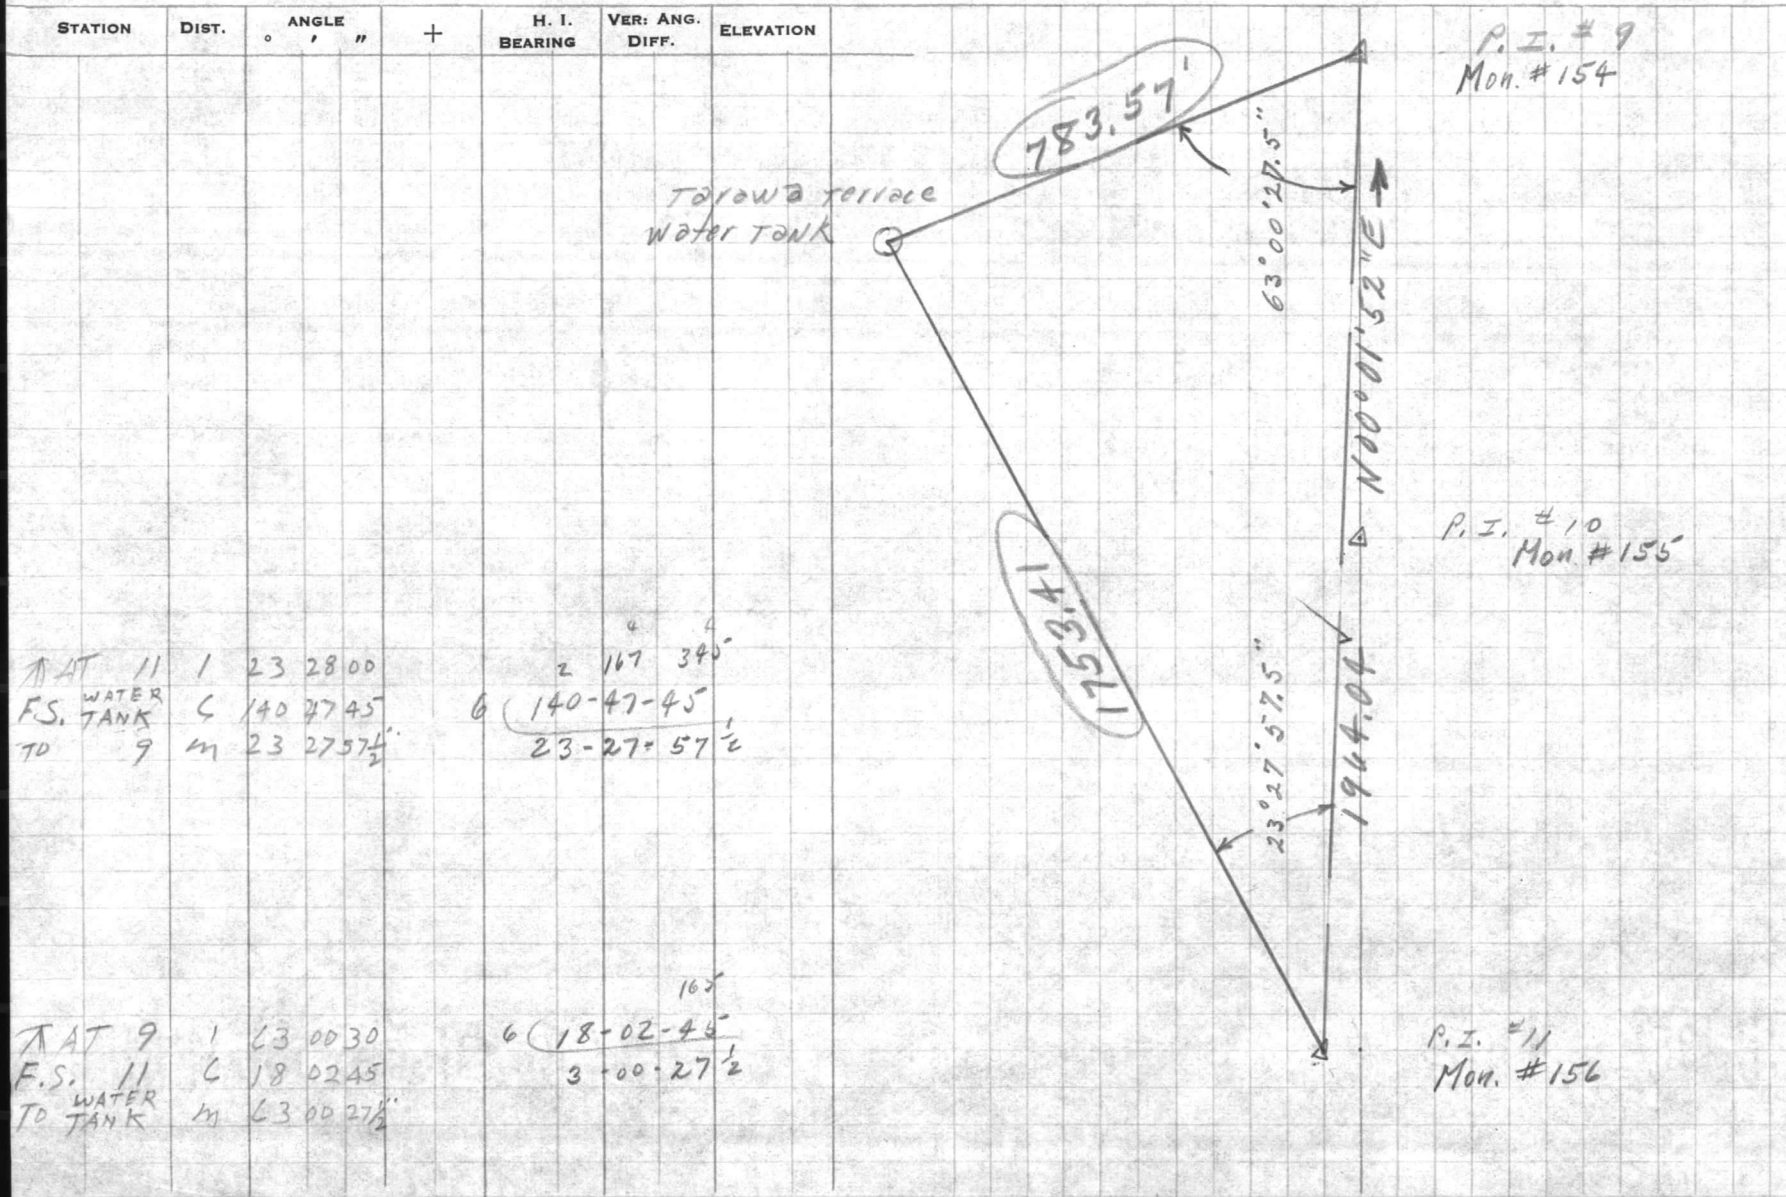
















































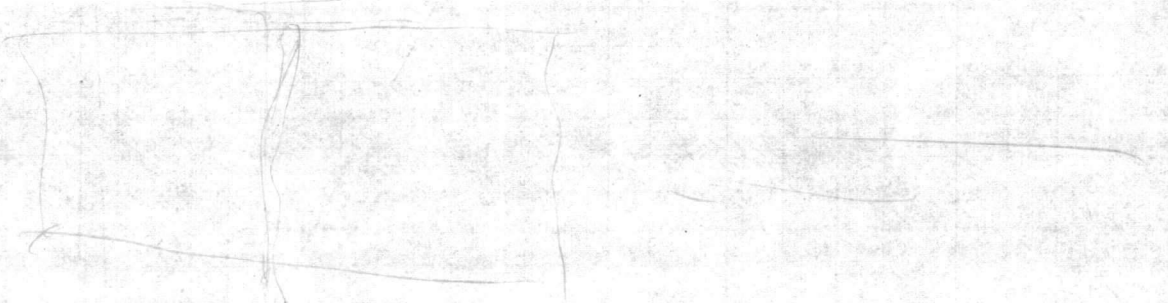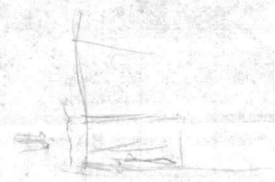





PUBLIC WORKS DEPARTMENT  
Camp Wajana, North Carolina  
Survey Department

Survey Corporation  
No. 1000

Station	Distance	Bearing	Course	Angle	Latitude	Departure	X Coordinate	Y Coordinate

No. 1000  
Date  
Sheet

**VALUABLE**

RETURN TO  
PUBLIC WORKS  
OFFICE  
CAMP LEJEUNE  
NORTH CAROLINA

SUBJECT

Elev. at T.T. Water Plant

**FIELD PARTY**

\_\_\_\_ IN CHARGE  
\_\_\_\_ INSTRUMENT  
\_\_\_\_ NOTES  
\_\_\_\_ TAPE READ  
\_\_\_\_ TAPE OR ROD  
\_\_\_\_ TAPE OR ROD  
\_\_\_\_ INSTRUMENT NO.  
\_\_\_\_ TAPE NO.

**WEATHER**

CLEAR  
CLOUDY  
WINDY  
RAIN  
FAIR

SNOW  
HOT  
MODERATE  
COLD  
FOG

FILE No. 99-5

FLDR. No. \_\_\_\_\_

FIGURED BY \_\_\_\_\_ SHEET \_\_\_\_\_


NOTES CHECKED BY \_\_\_\_\_

PLOTTED BY \_\_\_\_\_

DATE 8/9/19 62

Quad. No. \_\_\_\_\_

STATION	DIST.	ANGLE " +	H. I. BEARING	VER. ANG. DIFF.	ELEVATION
Ref. Elev.		0.78	25.09		24.31
				5.0	
				5.1	
				6.1	
				6.1	
Cor. Bldg.				5.9	19.2
M.H. stoop				5.7	19.4
Concr. slab				5.9	19.2
				5.1	20.0
				19.8	
	5.3	17.8			
				19.2	
				19.4	
				19.2	
				19.0	
				1.4	
				18"	

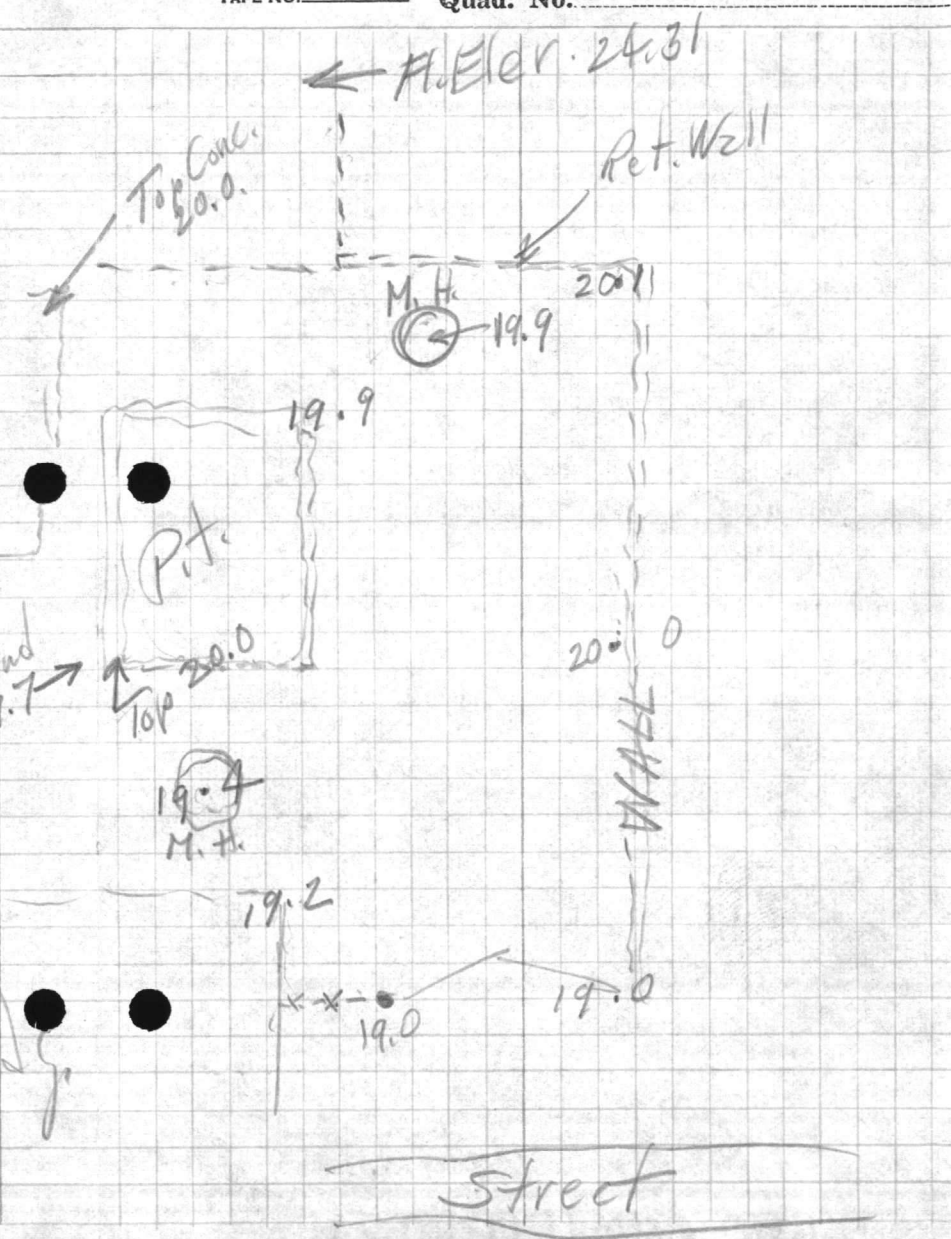






