

VALUABLE

SUBJECT Existing 6" C.I. water
Main location parallel with 9th
St. in Tent camp #2

Return To
 Public Works
 Office
 Camp Lejeune
 North Carolina


FIELD PARTY
Kelly In Charge
 _____ Instrument
 _____ Notes
 _____ Tape Read
 _____ Tape or Rod
 _____ Tape or Rod
 _____ Instrument No.
 _____ Tape No.

WEATHER
 Clear _____
 Cloudy _____
 Windy _____
 Rain _____
 Fair _____
 Snow _____
 Hot _____
 Moderate _____
 Cold _____
 Fog _____
 Figured By _____
 Notes Checked By _____
 Plotted By _____

FILE No. _____
 Fldr. No. _____
 Sheet 1 of 2
 Date 8-30-57

Quad. No. _____

| Station | Dist. | Angle | + | H. I. Bearing | Ver: Ang. Diff. | Elevation |
|---------|-------|-------|---|---------------|-----------------|-----------|
|---------|-------|-------|---|---------------|-----------------|-----------|

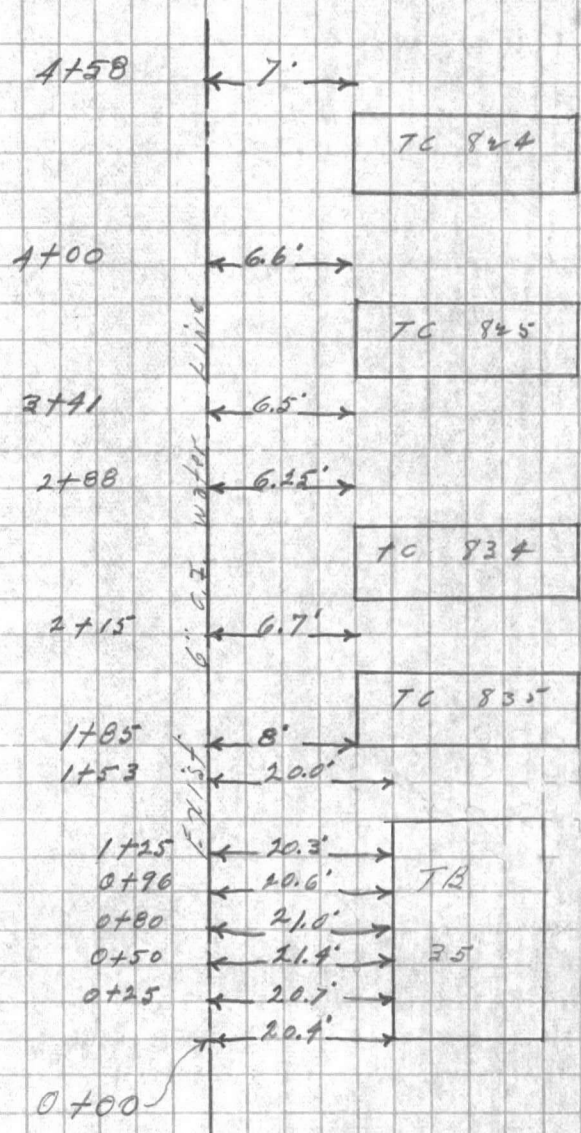







VALUABLE

Return To
Public Works
Office
Camp Lejeune
North Carolina

SUBJECT Water Line Location
cont'd.

FIELD PARTY

In Charge _____
Instrument _____
Notes _____
Tape Read _____
Tape or Rod _____
Tape or Rod _____
Instrument No. _____
Tape No. _____

WEATHER

Clear _____
Cloudy _____
Windy _____
Rain _____
Fair _____
Snow _____
Hot _____
Moderate _____
Cold _____
Fog _____

FILE No. _____

Fldr. No. _____


Sheet 2 of 2

Date 8-30 1957

Figured By _____
Notes Checked By _____
Plotted By _____

Quad. No. _____

Station Dist. ° Angle ' " + H. I. Bearing Ver: Ang. Diff. Elevation

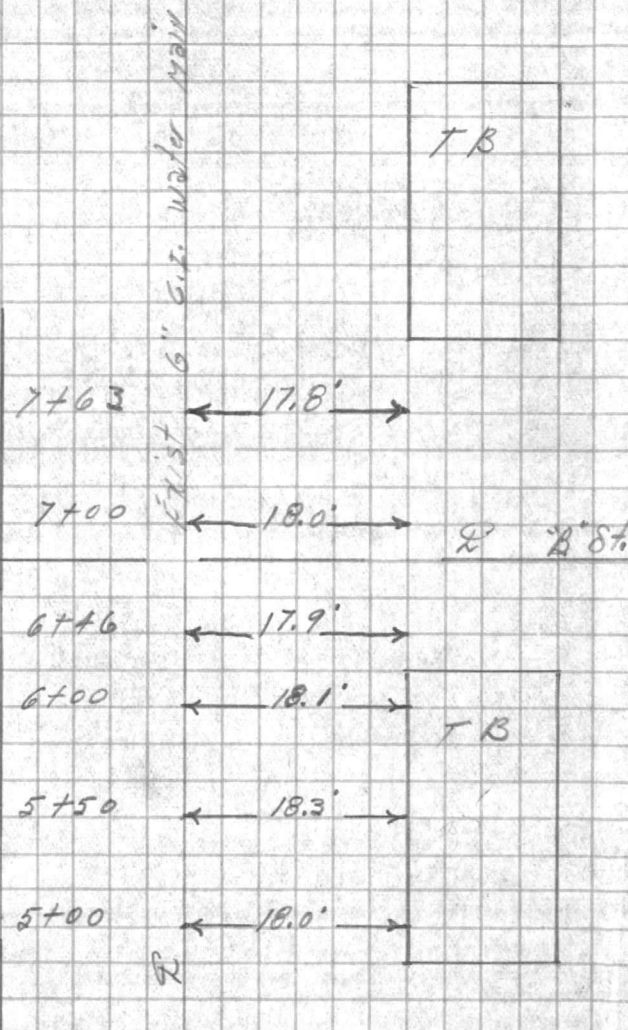





















VALUABLERETURN TO
PUBLIC WORKS
OFFICE
CAMP LEJEUNE
NORTH CAROLINASUBJECT Profile in existing ditch
from Proposed connecting Rd.
from "A" to "C" Sta. out to
Curtis Rd.

FIELD PARTY

KELLY
IN CHARGE
INSTRUMENT
NOTES
TAPE READ
TAPE OR ROD
TAPE OR ROD
INSTRUMENT NO.
TAPE NO.

WEATHER

CLEAR
CLOUDY
WINDY
RAIN
FAIR
SNOW
HOT
MODERATE
COLD
FOG
FIGURED BY
NOTES CHECKED BY
PLOTTED BYFILE No. 118-A
FLDR. No. _____
SHEET 1 of
DATE 10-30 1958

Quad. No. _____

| STATION | DIST. | ANGLE ° ' " | + | H. I. BEARING | VER. ANG. DIFF. | ELEVATION |
|----------------------|-------|----------------|---|------------------|--------------------|-----------|
| B.M. | | | | | | 23.50 |
| | | 2.27 | | 25.77 | | |
| T.P. | | | | | 5.37 | 20.40 |
| | | 5.00 | | 25.40 | | |
| | | | | 25.4 | | |
| 4+95 Rd. Alignment = | | | | | 7.2 | 18.2 |
| 0+00 Existing Ditch | | | | | | |
| 0+27 | | | | | 7.4 | 18.0 |
| T.P. | | | | | 4.62 | 20.78 |
| | | 4.09 | | 24.07 | | |
| | | | | 24.9 | | |
| 1+11 | | | | | 6.5 | 18.4 |
| 1+50 | | | | | 6.8 | 18.1 |
| 1+71 | | | | | 7.1 | 17.8 |
| 2+0 | | | | | 7.2 | 17.7 |
| 2+50 | | | | | 7.0 | 17.9 |
| 2+75 | | | | | | |
| 2+00 | | | | | 6.9 | 18.0 |
| 3+65 | | | | | 6.9 | 18.0 |
| T.P. | | | | | 3.75 | 21.12 |
| | | 4.05 | | 25.17 | | |

spiky in 15" pine 50' at sta. 2+50

Ditch angles Rt. from Rd. 90°

Bend in ditch approx. 90° Lft.

Approx. 90° bend Rt.

int. of ditches ditch Rt. & Lft.

Small ditch to Rt.

Water laying in ditch approx. 1' deep

Approx. 50' Lft. bend
















































VALUABLE

SUBJECT

Ditch Profile contd.

RETURN TO
PUBLIC WORKS
OFFICE
CAMP LEJEUNE
NORTH CAROLINA

FIELD PARTY

____ IN CHARGE
____ INSTRUMENT
____ NOTES
____ TAPE READ
____ TAPE OR ROD
____ TAPE OR ROD
____ INSTRUMENT No.
____ TAPE No.

WEATHER

CLEAR
CLOUDY
WINDY
RAIN
FAIR

SNOW
HOT
MODERATE
COLD
FOG

FILE No. _____

FLDR. No. _____

FIGURED BY _____

SHEET *2-07*

NOTES CHECKED BY _____

DATE *10-30 1958*

PLOTTED BY _____

Quad. No. _____

| STATION | DIST. | ANGLE ° ' " | + | H. I. BEARING | VER: ANG. DIFF. | ELEVATION | |
|---------|-------|----------------|---|------------------|--------------------|-----------|--------------------------------------------------------------|
| | | | | 25.17 | | | |
| | | | | 25.2 | | | |
| 3+96 | | | | | 7.0 | 18.2 | Approx. 45° Bend TO Rt. |
| 4+50 | | | | | 7.0 | 18.2 | |
| 5+0 | | | | | 7.7 | 17.5 | |
| 5+37 | | | | | 8.6 | 16.6 | Int. of ditch with curtis rd. ditch Approx. 90° Bend Lft. |
| T.P. | | | | | 3.06 | 22.11 | |
| | | | | 2.54 | 25.65 | | |
| | | | | 25.7 | | | |
| 6+0 | | | | | 9.2 | 16.5 | in Rd. Ditch |
| 6+50 | | | | | 9.4 | 16.3 | |
| 7+0 | | | | | 9.7 | 16.0 | |
| 7+50 | | | | | 9.9 | 15.8 | |
| 8+0 | | | | | 10.0 | 15.7 | |
| 8+50 | | | | | 10.5 | 15.2 | |
| 9+0 | | | | | 10.4 | 15.3 | |
| 9+50 | | | | | 10.5 | 15.2 | |



































VALUABLE

SUBJECT Profile cont'd.

RETURN TO
PUBLIC WORKS
OFFICE
CAMP LEJEUNE
NORTH CAROLINA

FIELD PARTY

____ IN CHARGE
____ INSTRUMENT
____ NOTES
____ TAPE READ
____ TAPE OR ROD
____ TAPE OR ROD
____ INSTRUMENT NO.
____ TAPE NO.

WEATHER

CLEAR _____ SNOW _____
CLOUDY _____ HOT _____
WINDY _____ MODERATE _____
RAIN _____ COLD _____
FAIR _____ FOG _____
FIGURED BY _____
NOTES CHECKED BY _____
PLOTTED BY _____

FILE No. _____

FLDR. No. _____

SHEET 3 of

DATE 10-30 1958

Quad. No. _____

| STATION | DIST. | ANGLE | | | H. I. BEARING | VER: ANG. DIFF. | ELEVATION |
|---------|-------|-------|---|---|------------------|--------------------|-----------|
| | | ° | ' | " | | | |
| | | | | | 25.65 | | |
| 10+0 | | | | | 25.7 | 10.5 | 157.2 |
| 10+50 | | | | | | 10.6 | 157.1 |
| 11+0 | | | | | | 11.0 | 14.7 |
| 11+50 | | | | | | 10.8 | 14.9 |
| 12+0 | | | | | | 10.8 | 14.9 |
| 12+37 | | | | | | 11.2 | 14.5 |
| | | | | | | 11.67 | 13.98 |
| | | | | | | 11.38 | 14.27 |
| T.P. | | | | | | 3.51 | 22.14 |
| | | | | | 4.56 | 26.70 | |
| T.P. | | | | | | 4.10 | 22.60 |
| | | | | | 4.90 | 27.50 | |
| B.M. | | | | | 4.03 | 23.47 | |
| | | | | | <u>23.50</u> | | |

water flows north from here

int. of ditch from 2 ft. 12' Rt. North
END of 24" Pipe
INV. 24" R.C.P. NORTH END
INV. 24" R.C.P. SOUTH END } Gander Curtis Rd.

spike in 15" pine 50' Rt. Sta. 2+60 on Proposed Road.

VALUABLE

RETURN TO
PUBLIC WORKS
OFFICE
CAMP LEJEUNE
NORTH CAROLINA

SUBJECT LOCATION OF WATER
VALVE BETWEEN "A" ST. AND
BLDG. T.C.#1006 & 1007
CAMP GEIGER.

FIELD PARTY
DENNIS IN CHARGE

INSTRUMENT

NOTES

TAPE READ

TAPE OR ROD


TAPE OR ROD

INSTRUMENT NO. _____
TAPE NO. _____

WEATHER
CLEAR _____
CLOUDY _____
WINDY _____
RAIN _____
FAIR _____
SNOW _____
HOT _____
MODERATE _____
COLD _____
FOG _____
FIGURED BY _____
NOTES CHECKED BY _____
PLOTTED BY _____
FILE No. 118A
FLDR. No. _____
SHEET 1 of 1
DATE 7-29 1954

Quad. No. _____

| STATION | DIST. | ANGLE | | | H. I. BEARING | VER: ANG. DIFF. | ELEVATION |
|---------|-------|-------|---|---|------------------|--------------------|-----------|
| | | ° | ' | " | | | |
| | | | | | | | |

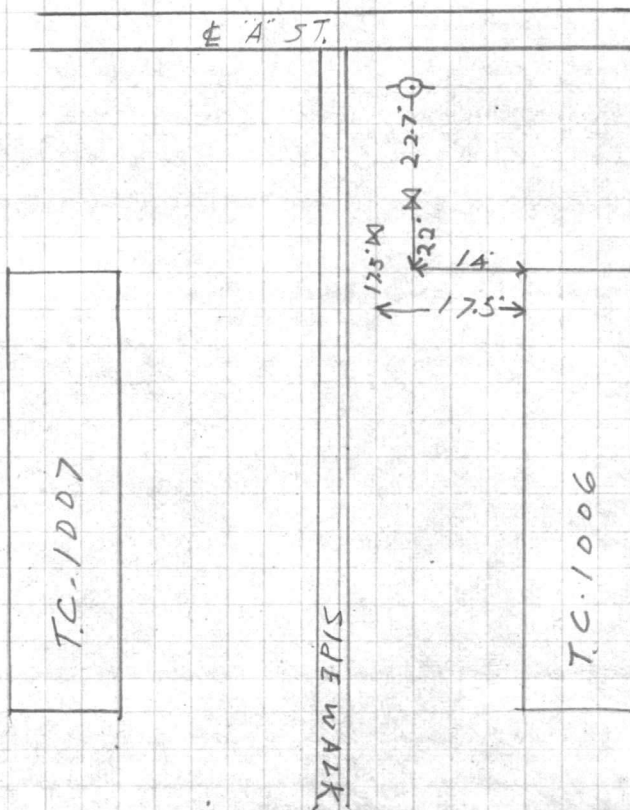
















VALUABLE

SUBJECT LOCATION OF SEWER
MAN HOLE & WATER LINE
AT 11TH & CHURCH ST.

RETURN TO
PUBLIC WORKS
OFFICE
CAMP LEJEUNE
NORTH CAROLINA

FIELD PARTY

DENNIS IN CHARGE

INSTRUMENT

NOTES

TAPE READ

TAPE OR ROD

TAPE OR ROD

INSTRUMENT No.

TAPE No.

WEATHER

CLEAR
CLOUDY
WINDY
RAIN
FAIR

SNOW
HOT
MODERATE
COLD
FOG

FILE No. 118-A

FLDR. No. _____

SHEET 141

DATE 7-22 1954


FIGURED BY _____

NOTES CHECKED BY _____

PLOTTED BY _____

Quad. No. _____

| STATION | DIST. | ANGLE ' " | + | H. I. BEARING | VER. ANG. DIFF. | ELEVATION |
|---------|-------|--------------|---|------------------|--------------------|-----------|
|---------|-------|--------------|---|------------------|--------------------|-----------|

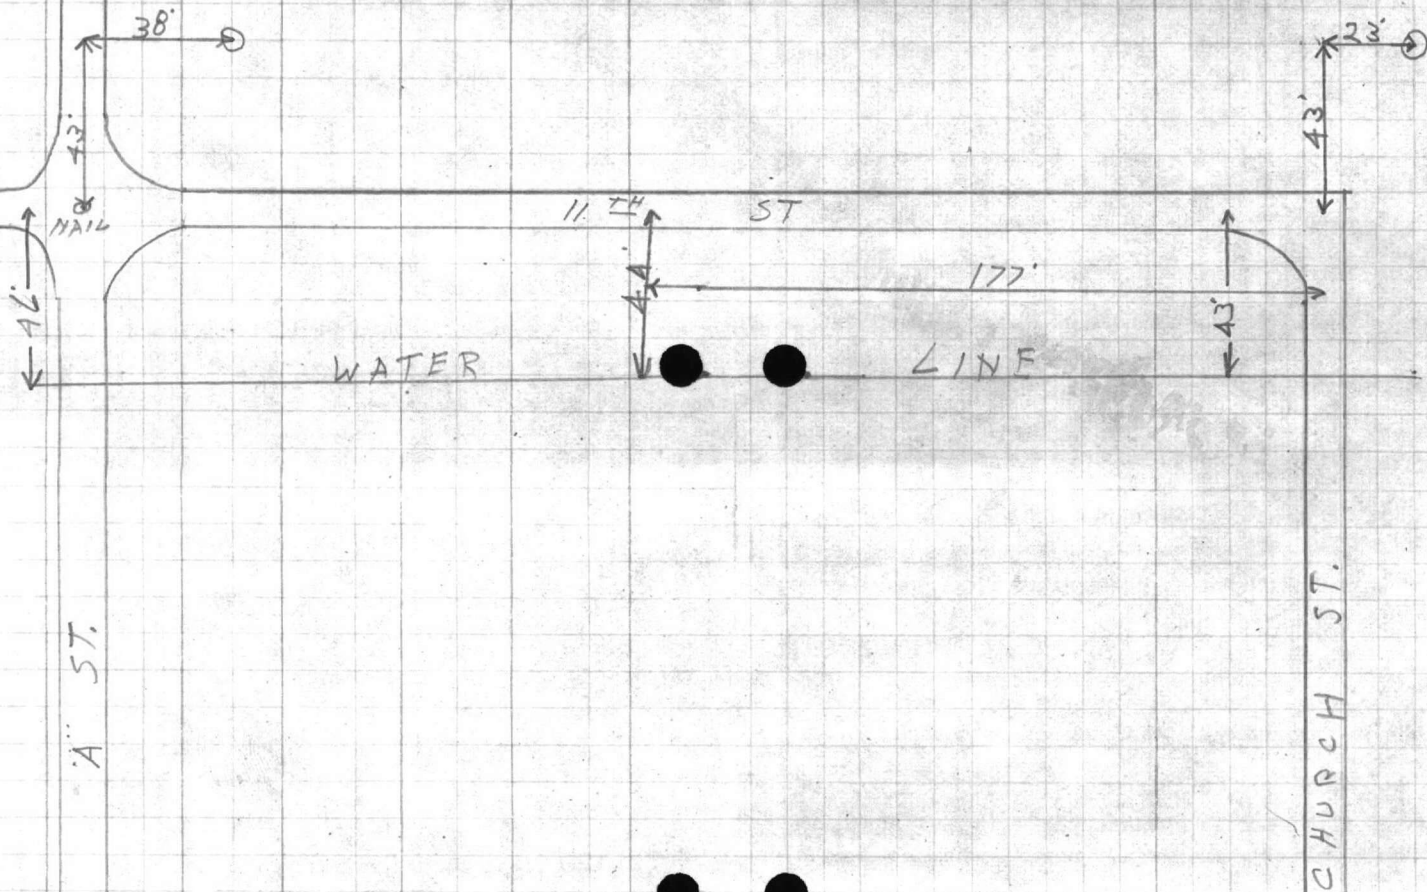

FILE NO.

DATE

REMARKS

REMARKS

VALUABLE

RETURN TO
PUBLIC WORKS
OFFICE
CAMP LEJEUNE
NORTH CAROLINA


SUBJECT LOCATION OF 6" TRANSITE
PIPE

FIELD PARTY
DENNIS IN CHARGE
INSTRUMENT _____
NOTES _____
TAPE READ _____
TAPE OR ROD _____
TAPE OR ROD _____
INSTRUMENT NO. _____
TAPE NO. _____

WEATHER
CLEAR _____ SNOW _____
CLOUDY _____ HOT _____
WINDY _____ MODERATE _____
RAIN _____ COLD _____
FAIR _____ FOG _____
FIGURED BY _____ SHEET 10 of 1
NOTES CHECKED BY _____
PLOTTED BY _____ DATE 7.29 1954

FILE No. 118 A

Quad. No. _____

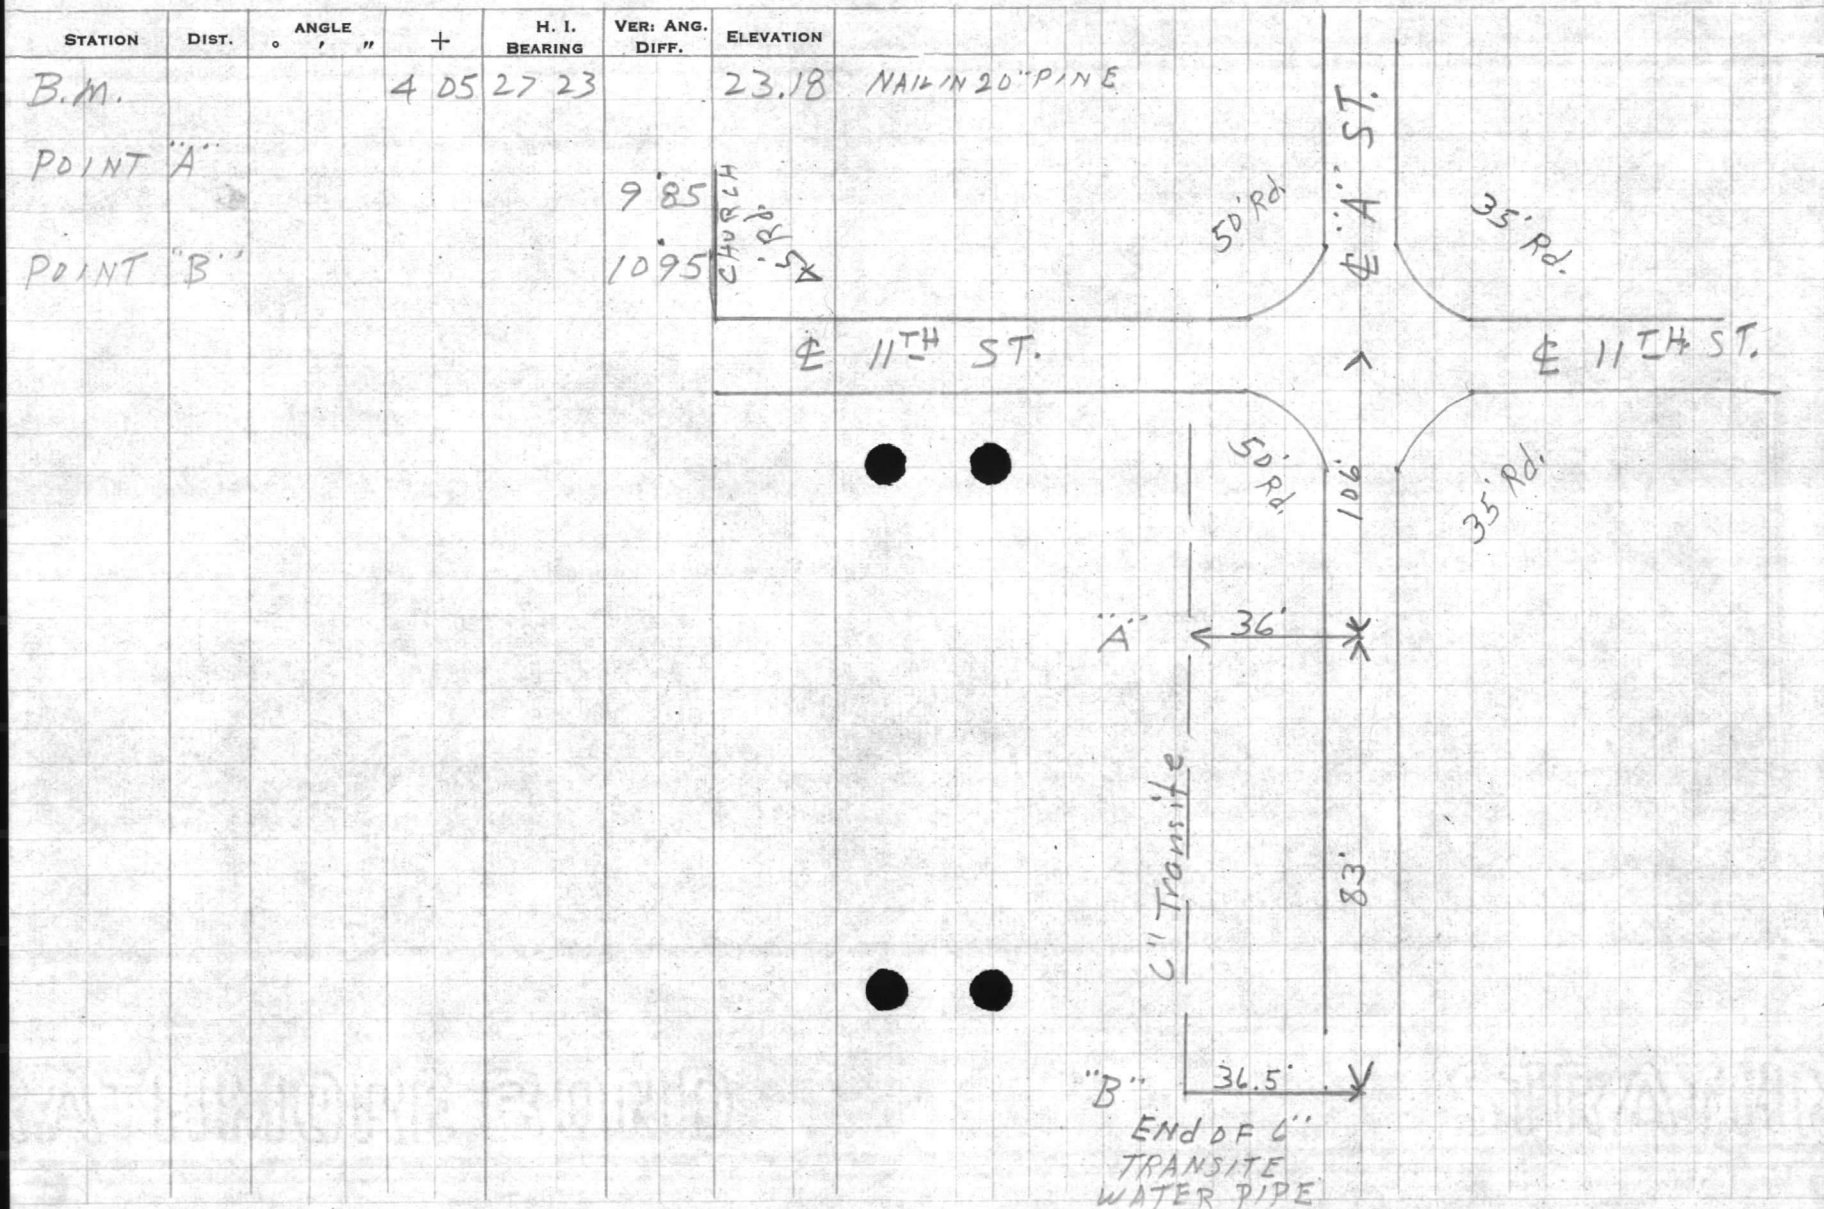

VALUABLE

RETURN TO
PUBLIC WORKS
OFFICE
CAMP LEJEUNE
NORTH CAROLINA

SUBJECT LOCATION OF WATER
VALVE 10TH & 'A' ST. SOUTH,
EAST CAMP GEIGER N.C.

FIELD PARTY
DENNIS IN CHARGE

INSTRUMENT

NOTES

TAPE READ

TAPE OR ROD

TAPE OR ROD

STRUMENT NO. _____
TAP NO. _____


WEATHER
CLEAR _____ SNOW _____
CLOUDY _____ HOT _____
WINDY _____ MODERATE _____
RAIN _____ COLD _____
FAIR _____ FOG _____

FIGURED BY _____
NOTES CHECKED BY _____
PLOTTED BY _____

FILE No. 118 A
FLDR. No. _____
SHEET 1 of 1
DATE 7-29 1954

Quad. No. _____

| STATION | DIST. | ANGLE | | + | H. I. BEARING | VER: ANG. DIFF. | ELEVATION |
|---------|-------|-------|---|---|------------------|--------------------|-----------|
| | | ° | " | | | | |

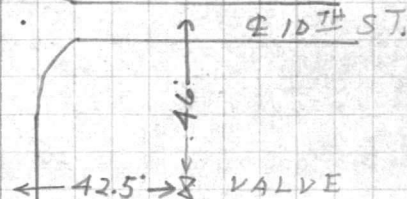






















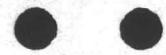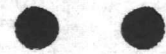

VALUABLE

SUBJECT Proposed B.O.D.
Camp Geiger

RETURN TO
PUBLIC WORKS
OFFICE
CAMP LEJEUNE
NORTH CAROLINA


FIELD PARTY
Guthrie IN CHARGE
INSTRUMENT
NOTES
TAPE READ
TAPE OR ROD
TAPE OR ROD
INSTRUMENT NO.
TAPE NO.

WEATHER
CLEAR
CLOUDY
WINDY
RAIN
FAIR
SNOW
HOT
MODERATE
COLD
FOG
FIGURED BY
NOTES CHECKED BY
PLOTTED BY

FILE No. 118-A
98-D
FLDR. No.
SHEET
DATE 4/24/ 1952

Quad. No.

| STATION | DIST. | ANGLE ° ' " | + | H. I. BEARING | VER: ANG. DIFF. | ELEVATION |
|---------|-------|----------------|---|------------------|--------------------|-----------|
|---------|-------|----------------|---|------------------|--------------------|-----------|

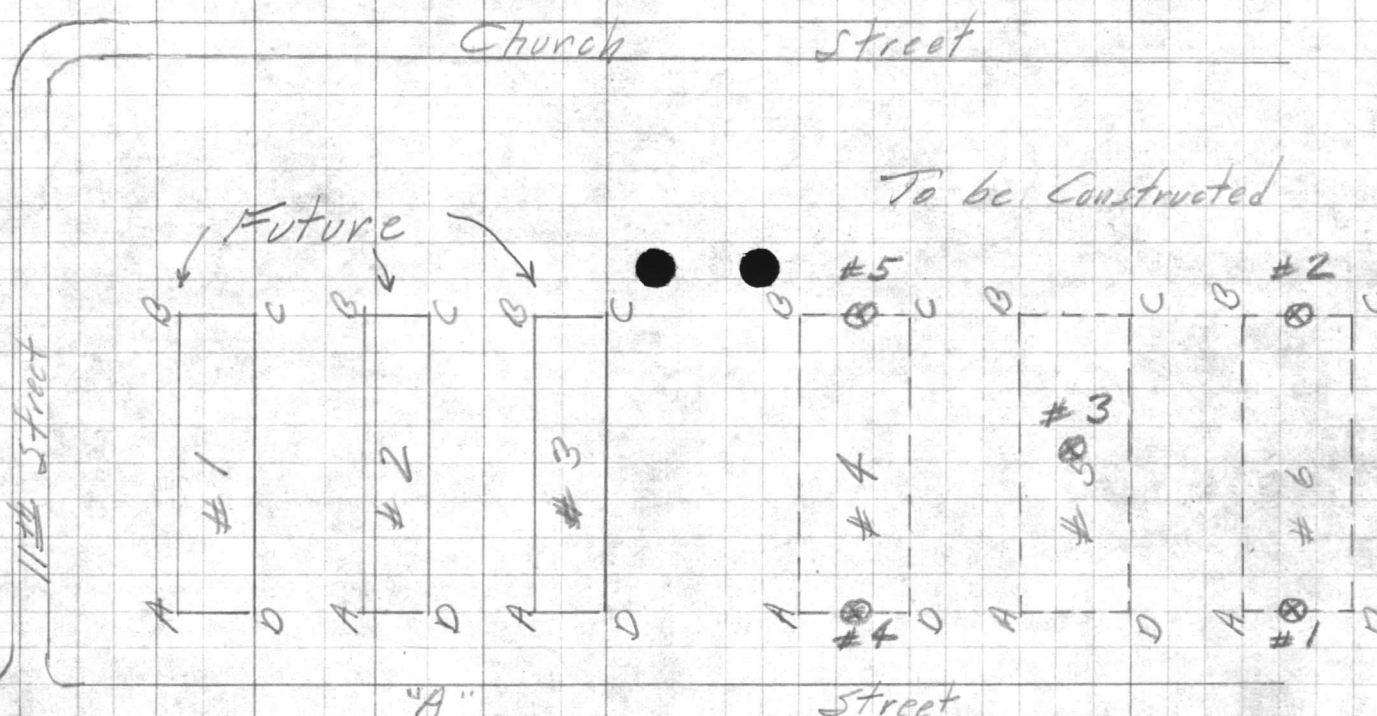

⊗ Soil Borings

401

VALUABLE

SUBJECT

RETURN TO
PUBLIC WORKS
OFFICE
NORTH CAROLINA

STATION

DIST.

ANGLE


+

BEARING

AND

ELEVATION


 

VALUABLE

SUBJECT

Return To
Public Works
Office
Camp LeJeune
North Carolina

Cor. Elev for proposed
B.O.Q AT Camp Geiger

FIELD PARTY

Cutbrie In Charge
Instrument _____
Notes _____
Tape Read _____
Tape or Rod _____
Tape or Rod _____
Instrument No. _____
Tape No. _____

WEATHER

Clear _____
Cloudy _____
Windy _____
Rain _____
Fair _____

Snow _____
Hot _____
Moderate _____
Cold _____
Fog _____

FILE No. _____

Fldr. No. _____

Sheet 107

Date _____

19 _____

Figured By _____
Notes Checked By _____
Plotted By _____

Quad. No. _____

| Station | Dist. | Angle ' " | + | H. I. Bearing | Ver: Ang. Diff. | Elevation |
|---------|-------|--------------|---|------------------|--------------------|-----------|
| | | | | | | 21.5 |
| | | | | 46 | 261 ✓ | |
| | | | | | 47 | 214 |
| | | | | | 44 | 217 |
| | | | | | 45 | 216 |
| | | | | | 46 | 215 |
| | | | | | 47 | 214 |
| | | | | | 48 | 213 |
| | | | | | 46 | 215 |
| | | | | | 47 | 214 |
| | | | | | 46 | 215 |
| | | | | | 4.6 | 215 |
| | | | | | 4.7 | 214 |
| | | | | | H. 6 | 21.5 |
| | | | | | H. 6 | 21.5 |

BLDG # 1 Cor A
" " " Cor D

BLDG # 2 Cor A
" " " " D

BLDG # 3 Cor A
" " " " D

BLDG # 4 Cor A
" " " " Cor D

BLDG # 5 Cor A
" " " " D

BLDG # 6 Cor A
" " " " D

Boring # 4 4.8

27.2
4.8

22.4

22.4

VALUABLE

SUBJECT _____

Return To
 Public Works
 Office
 Camp Lejeune
 North Carolina

FIELD PARTY

_____ In Charge
 _____ Instrument
 _____ Notes
 _____ Tape Read
 _____ Tape or Rod
 _____ Instrument No.
 _____ Tape No.

WEATHER

Clear
 Cloudy
 Windy
 Rain
 Fair

Snow
 Hot
 Moderate
 Cold
 Fog

FILE NO. _____
 Fldr. No. _____
 Sheet 292
 Date _____ 19____

Figured By _____
 Notes Checked By _____
 Plotted By _____
 Quad. No. _____

| Station | Dist. | Angle " + " | H. I. Bearing | Ver: Ang. Diff. | Elevation | | |
|-------------|-------|----------------|------------------|--------------------|-----------|----------|-------|
| | | 57 | 27.2 | | 215 | | |
| | | | | 4.9 | 223 | BLDG # 1 | Cor B |
| | | | | 5.2 | 220 | " " " | Cor C |
| | | | | 4.7 | 225 | BLDG # 2 | Cor B |
| | | | | 4.6 | 226 | " " " | Cor C |
| | | | | 4.7 | 225 | BLDG # 3 | Cor B |
| | | | | 5.0 | 222 | " " " | Cor C |
| | | | | 5.6 | 216 | BLDG # 4 | Cor B |
| | | | | 5.8 | 214 | " " " | Cor C |
| TP on stake | | | | 4.53 | 22.71 | | |
| | | 4.8 | 27.5 | | | | |
| | | | | 6.0 | 215 | BLDG # 5 | Cor B |
| " | | | | 5.4 | 221 | " " " | Cor C |
| | | | | 5.8 | 217 | BLDG # 5 | Cor B |
| | | | | 6.0 | 215 | " " " | Cor C |

VALUABLE

SUBJECT

Return To
Public Works
Office
Camp L...




























 

VALUABLE

RETURN TO
PUBLIC WORKS
OFFICE
CAMP LEJEUNE
NORTH CAROLINA

SUBJECT Test Boring for
proposed. B.O. Camp Geiger.

FIELD PARTY
Butler IN CHARGE
INSTRUMENT
NOTES
TAPE READ
TAPE OR ROD
TAPE OR ROD
INSTRUMENT No.
TAPE No.

WEATHER
CLEAR
CLOUDY
WINDY
RAIN
FAIR
SNOW
HOT
MODERATE
COLD
FOG
FIGURED BY
NOTES CHECKED BY
PLOTTED BY

FILE No. _____
FLDR. No. _____
SHEET 1 of 3
DATE _____ 19__

Quad. No. _____

| STATION | DIST. | ANGLE ° ' " + | H. I. BEARING | VER. ANG. DIFF. | ELEVATION |
|---------|-------|------------------|------------------|--------------------|-----------|
|---------|-------|------------------|------------------|--------------------|-----------|

| | | | | | | |
|-----------|--|--|--|------|--------------------|-----------------------------|
| | | | | | ground elev = 21.5 | Boring #1 |
| | | | | 21.5 | | |
| | | | | 20.9 | 0.6 | Top soil |
| | | | | 19.9 | 1.0 | of BLACK DIRT (Humus) |
| Boring #1 | | | | 18.5 | 1.4 | Red sand-clay 10% |
| | | | | 16.5 | 2.0 | gray and yellow Course Sand |
| BLDG # 6 | | | | 15.0 | 1.5 | white sand (Course) cont. |
| | | | | | 6.5 | water level |

| | | | | | | | |
|-----------|------|--|--|------|--------------------|------|-------------------------|
| | | | | | ground elev = 20.6 | 20.6 | Boring #2 |
| | | | | 20.1 | 0.5 | | Top soil |
| Boring #2 | | | | 17.1 | 3.0 | | BLACK and gray sand. |
| | | | | 16.6 | 0.5 | | Light Brown Sand |
| BLDG # 6 | 16.3 | | | | 4.3 | | water line |
| | | | | 14.6 | 2.0 | | white sand Course Cont. |

VALUABLE
RETURN TO
PUBLIC WORKS
OFFICE






















VALUABLE

SUBJECT _____

RETURN TO
PUBLIC WORKS
OFFICE
CAMP LEJEUNE
NORTH CAROLINA

FIELD PARTY

IN CHARGE

INSTRUMENT

NOTES

TAPE READ

TAPE OR ROD

TAPE OR ROD

INSTRUMENT NO.

TAPE NO.

WEATHER

CLEAR

CLOUDY

WINDY

RAIN

FAIR

SNOW

HOT

MODERATE

COLD

FOG
FIGURED BY _____
NOTES CHECKED BY _____
PLOTTED BY _____

FILE No. _____

FLDR. No. _____

SHEET 243

DATE _____ 19__

Quad. No. _____

| STATION | DIST. | ANGLE ° ' " + | H. I. BEARING | VER. ANG. DIFF. | ELEVATION |
|---------|-------|------------------|------------------|--------------------|-----------|
|---------|-------|------------------|------------------|--------------------|-----------|

ground elev = 22.2

Boreing # 3

| | | | | | |
|-------------|--|--|--|------|-----|
| | | | | 22.2 | |
| | | | | 26.7 | 0.5 |
| BOREING # 3 | | | | 20.2 | 1.5 |
| | | | | 17.2 | 3.0 |
| BLOG # 5 | | | | 16.2 | 1.0 |
| | | | | | 6.0 |

Top soil
BLACK + white sand
DARK Brown sand clay traces
white sand course
water level

ground elev = 22.4

Boreing # 4

| | | | | | |
|-------------|--|--|--|------|-----|
| | | | | 22.4 | |
| | | | | 26.8 | 0.6 |
| BOREING # 4 | | | | 21.4 | 0.4 |
| | | | | 18.4 | 3.0 |
| BLOG # 4 | | | | 17.4 | 1.0 |
| | | | | 16.9 | 5.5 |
| | | | | 16.4 | 1.0 |
| | | | | 15.9 | 0.5 |

Top soil
BLACK white sand.
Red sand clay 10%
gray sand
water level
light brown sand
white sand cont.

22.4
5.5
16.9

VALUABLE

SUBJECT

RETURN TO
PUBLIC WORKS
OFFICE
NORTH CAROLINA

STATION DIST

ANGLE
BEARING
ELEVATION





VALUABLE

SUBJECT _____

RETURN TO
PUBLIC WORKS
OFFICE
CAMP LEJEUNE
NORTH CAROLINA

FIELD PARTY

 _____ IN CHARGE
 _____ INSTRUMENT
 _____ NOTES
 _____ TAPE READ
 _____ TAPE OR ROD
 _____ TAPE OR ROD
 _____ INSTRUMENT NO.
 _____ TAPE NO.

WEATHER

 CLEAR SNOW
 CLOUDY HOT
 WINDY MODERATE
 RAIN COLD
 FAIR FOG
 FIGURED BY _____
 NOTES CHECKED BY _____
 PLOTTED BY _____

FILE No. _____

FLDR. No. _____

SHEET 3 of 3

DATE _____ 19__

Quad. No. _____

| STATION | DIST. | ANGLE ° ' " | + | H. I. BEARING | VER. ANG. DIFF. | ELEVATION |
|---------|-------|----------------|---|------------------|--------------------|-----------|
|---------|-------|----------------|---|------------------|--------------------|-----------|

| | | | | | | | |
|--|--|------------|--|-------|------|------|----------------------------|
| | | ground | | cleu. | = | 20.8 | Boreing #5 |
| | | | | | 20.8 | | |
| | | Boreing #5 | | | 20.3 | 0.5 | Top soil |
| | | | | | 19.3 | 1.0 | Dark Brown sand |
| | | | | | 16.8 | 2.5 | BLACK + gray sand (Course) |
| | | BADG #4 | | | 15.8 | 1.0 | Brown sand clay 10% |
| | | | | | 5.0 | | water table |
| | | | | | 14.8 | 1.0 | White sand. Course (Ext.) |

































7+12.6
3 01.4
4 11.2