

STAKEOUT

CARR AND J. E. GREINER COMPANY

ARCHITECT-ENGINEERS

MARINE BARRACKS, NEW RIVER, N. C.

SUBJECT *Dimension Sheet - Service Clubs Reg. #3*

SHEET OF


COMPUTED BY: *WCA*

DATE *2-27-42*

CHECKED BY:

DATE

OWEN G. DUNN CO. 38974-SM 12-41

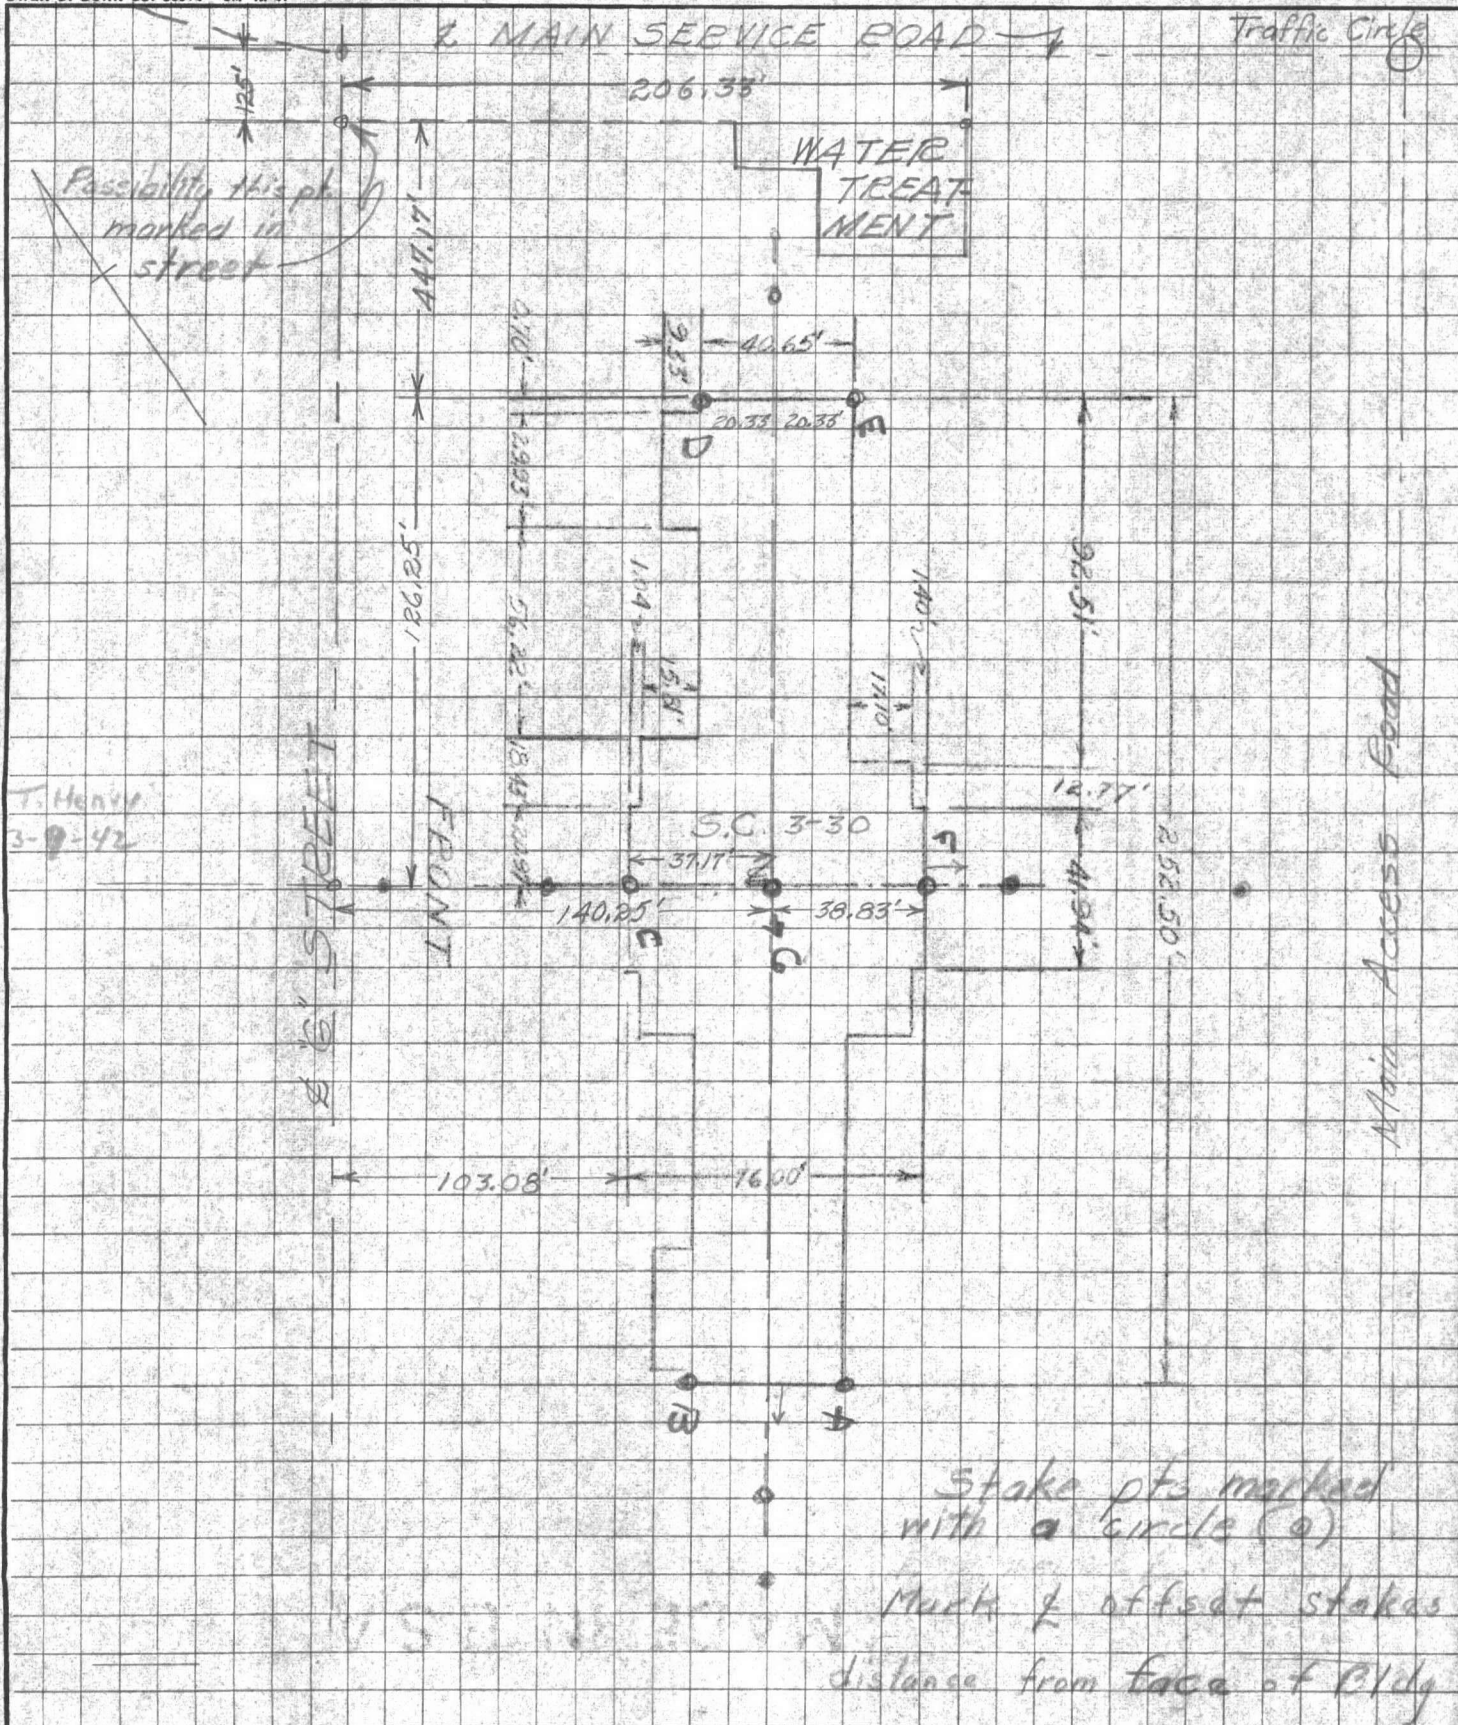

CARR AND J. E. GREINER COMPANY

MARINE BARRACKS NEW RIVER, W. C.

ARCHITECT-ENGINEERS

SHEET

SUBJECT


DATE

CHECKED BY:

DATE

COMPUTED BY:

OWNERS: U.S. NAVY

 

4-105/12-10-11