

VALUABLE
 RETURN TO
 CARR & J. E.
 GREINER CO.
 JACKSONVILLE,
 N. C.

 SUBJECT Establish B.M. and overflow
elevations on Water Tank
Supply & Industrial Area

FIELD PARTY

 W.G.W. IN CHARGE
 W.M.S. INSTRUMENT
 W.G.W. NOTES
 TAPE READ
 B.G. TAPE OR ROD
 TAPE OR ROD
 INSTRUMENT NO.
 TAPE NO.

WEATHER


 CLEAR
 CLOUDY
 WINDY
 RAIN
 FAIR ✓
 SNOW
 HOT
 MODERATE
 COLD
 FOG

FILE No. _____

FLDR. No. 160-W-2SHEET 1 of 1DATE 10-8-1942

STATION	DIST.	ANGLE		H. I.	VER. ANG. DIFF.	ELEVATION
		+	-			
B.M.	4.53	33.92		29.39		88+00.16
B.M.				5.24		27.68 27.68
B.M.	4.53			29.39		88+00.16

Water Tank - Supply & Industrial Area.

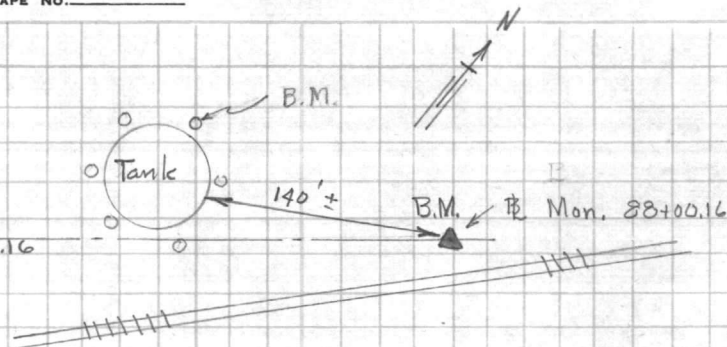

Note: Establish B.M. on north most pier of tower. North anchor bolt.

Find elevation of overflow pipe with chain.

56

RECEIVED
FEB 10 1954

SECTION 101

NO. 1
OFFICE OF
GENERAL COUNSEL
U.S. DEPT. OF JUSTICE

AVAILABLE FOR REPRODUCTION

DATE OF
REVISIONS TO
DATE OF
REVISED
BY
REVISIONS TO
DATE OF
REVISED
BY

REVISIONS TO
DATE OF
REVISED
BY
REVISIONS TO
DATE OF
REVISED
BY

DATE
CHECK
FILE NO