



VALUABLE
 RETURN TO
 CARR & J. E.
 GREINER CO.
 JACKSONVILLE,
 N. C.

 SUBJECT River Road Valve & Hyd.
Location

FIELD PARTY

 _____ IN CHARGE
 _____ INSTRUMENT
 _____ NOTES
 _____ TAPE READ
 _____ TAPE OR ROD
 _____ TAPE OR ROD
 _____ INSTRUMENT NO.
 _____ TAPE NO.

WEATHER

 CLEAR
 CLOUDY
 WINDY
 RAIN
 FAIR
 SNOW
 HOT
 MODERATE
 COLD
 FOG

FILE No. _____

FLDR. No. _____

SHEET 2-4
 FIGURED BY _____
 NOTES CHECKED BY _____
 PLOTTED BY JW
 DATE _____ 19____

STATION	DIST.	ANGLE	+	H. I.	VER. ANG. DIFF.	ELEVATION
---------	-------	-------	---	-------	-----------------	-----------

13° 46' 30" Rt

17+86.3 P.I.

"J" Street

77° 21'

12" V&B 49.4

8" C.I. Pipe

6" V&B 51.7

33.1
F.H.

Nail in Cap.

17+98.4

16+78.5

16+77.6

16+00

14+00

6" V&B

52.34

F.H. 26.5

45.3

12+79.5

11+73.2

12" V&B 45.1

8" C.I. Pipe

86
48
38

1° 35' Lt

"I" Street

85° 34'

15" C.I.

30'

3'

25'

7+00

11+44.1 P.I.

Nail in Cap.






























VALUABLE
 SUBJECT River Road Valve & Hyd.
Location

 RETURN TO
 CARR & J. E.
 GREINER CO.
 JACKSONVILLE,
 N. C.
FIELD PARTY
 _____ IN CHARGE
 _____ INSTRUMENT
 _____ NOTES
 _____ TAPE READ
 _____ TAPE OR ROD
 _____ TAPE OR ROD
 _____ INSTRUMENT NO.
 _____ TAPE NO.
WEATHER
 CLEAR
 CLOUDY
 WINDY
 RAIN
 FAIR
 SNOW
 HOT
 MODERATE
 COLD
 FOG

FILE No. _____

FLDR. No. _____

SHEET 3-4
 FIGURED BY _____
 NOTES CHECKED BY _____
 PLOTTED BY JK
DATE 7/27 1942


STATION	DIST.	ANGLE	+	H. I.	—	ELEVATION
		° ' "			VER: ANG. DIFF.	

20° 13' Lt.

30+38.6 P.I.

7° 23' Rt.

22+43.4 P.I.

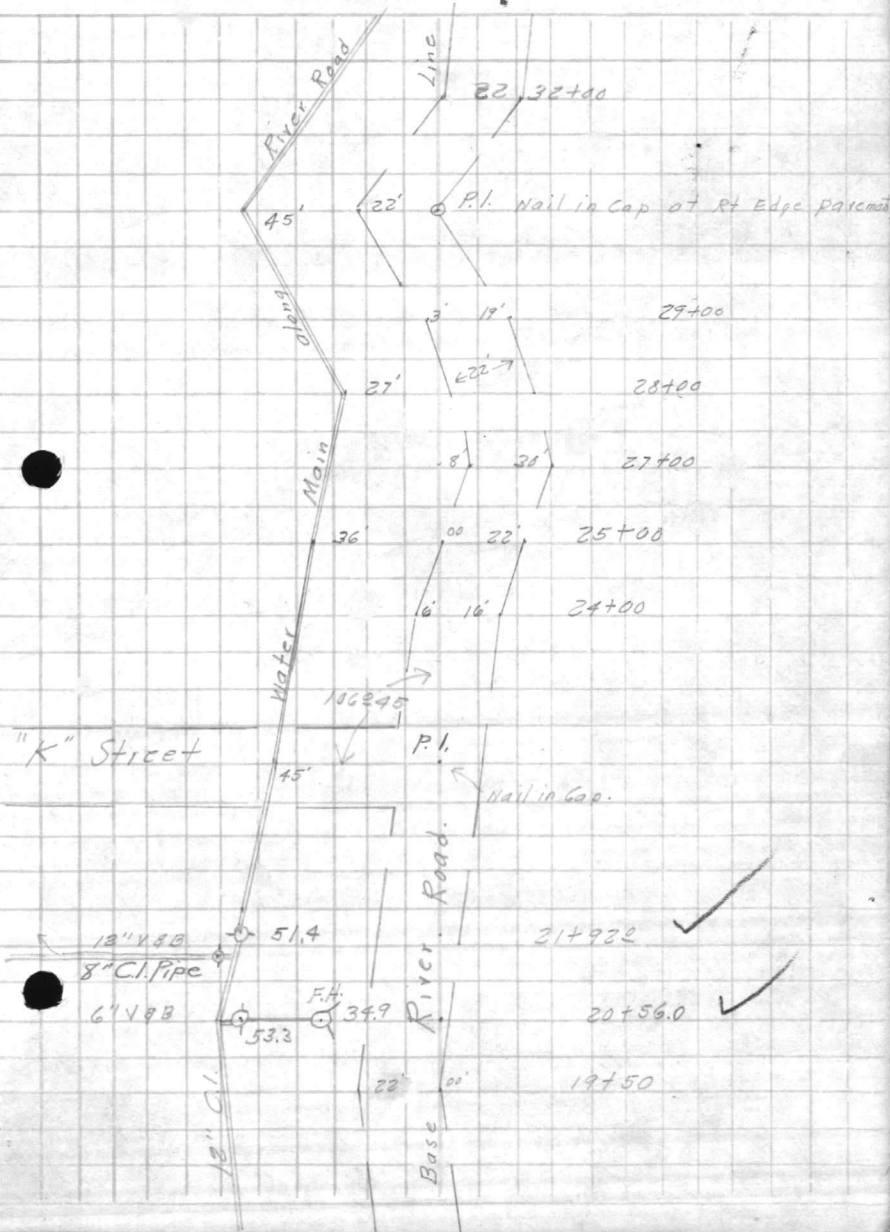












(70)

VALUABLE

RETURN TO
CARR & J. E.
GREINER CO.
JACKSONVILLE,
N. C.


SUBJECT Records as built Valve & Fire Hydrant Location along D-Street Beginning at intersection of Service Road & D-St. Running Through D.St. to River Road.

FIELD PARTY
McMillan IN CHARGE
" INSTRUMENT
" NOTES
Kellom TAPE READ
Caulter TAPE OR ROD
TAPE OR ROD
INSTRUMENT NO.
TAPE NO.

WEATHER
CLEAR CLOUDY
WINDY WINDY
RAIN RAIN
FAIR FAIR
SNOW HOT
MODERATE COLD
FOG FOG
FIGURED BY: _____
NOTES CHECKED BY: _____
PLOTTED BY: H

FILE No. 160
FLDR. No. _____
SHEET 1 of 3
DATE 7/13 19 42

STATION	DIST.	ANGLE	H. I.	VER. ANG. DIFF.	ELEVATION
		° ' "			

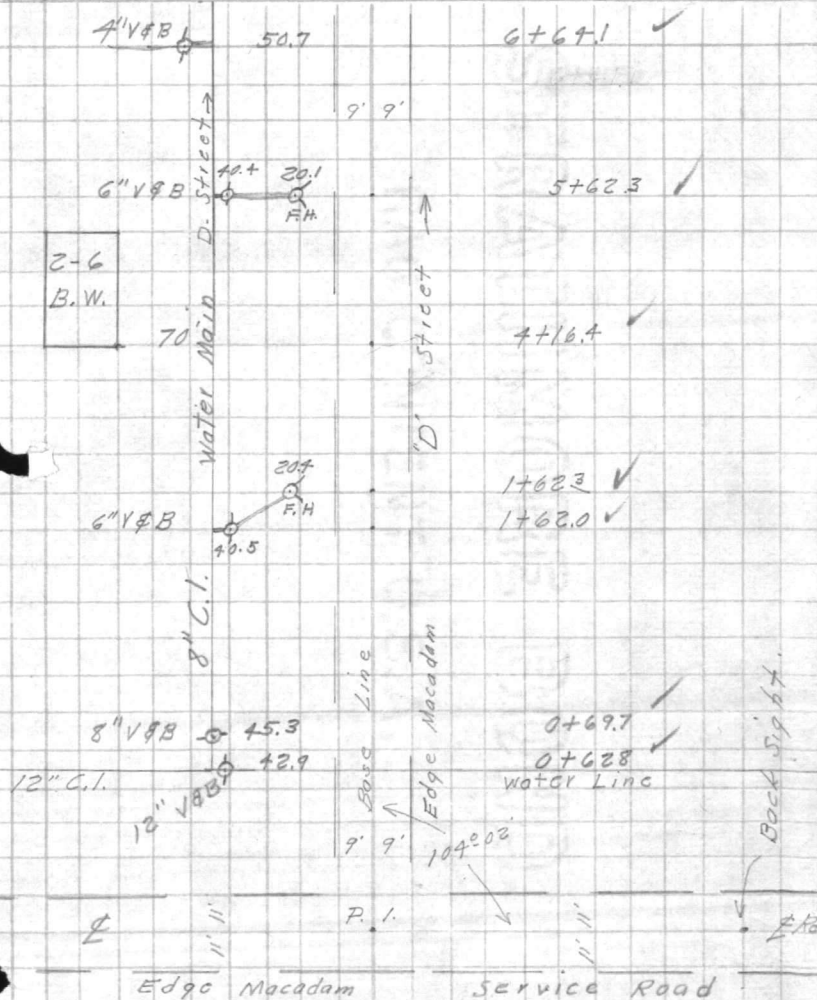

151° 56' Double
75° 58' RT

0+00 Point Intersection W. Lane Service Road & D-Street.

Edge Macadam Service Road















VALUABLE

SUBJECT _____

RETURN TO

CARR & J. E.
GREINER Co.
JACKSONVILLE,
N. C.

FIELD PARTY

 _____ IN CHARGE
 _____ INSTRUMENT
 _____ NOTES
 _____ TAPE READ
 _____ TAPE OR ROD
 _____ TAPE OR ROD
 _____ INSTRUMENT NO.
 _____ TAPE NO.

WEATHER

 CLEAR
 CLOUDY
 WINDY
 RAIN
 FAIR
 SNOW
 HOT
 MODERATE
 COLD
 FOG
 FIGURED BY _____
 NOTES CHECKED BY _____
 PLOTTED BY _____


FILE No. _____

FLDR. No. _____

SHEET 2-3

DATE _____ 19__

STATION	DIST.	ANGLE		+	H. I.	- VER. ANG. DIFF.	ELEVATION
		°	' "				

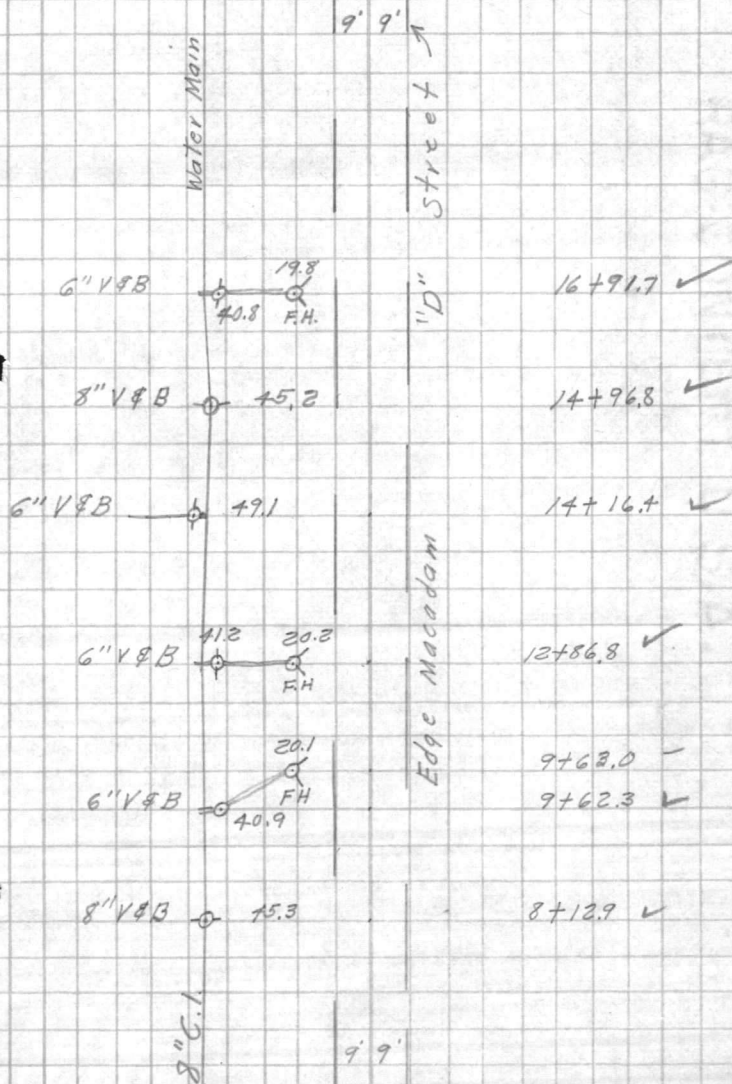
















VALUABLE

SUBJECT _____

RETURN TO
CARR & J. E.
GREINER CO.
JACKSONVILLE,
N. C.

FIELD PARTY

IN CHARGE

INSTRUMENT

NOTES

TAPE READ

TAPE OR ROD

TAPE OR ROD

INSTRUMENT NO.

TAPE NO.

WEATHER

CLEAR

CLOUDY

WINDY

RAIN

FAIR

FIGURED BY _____
NOTES CHECKED BY _____
PLOTTED BY _____

FILE No. _____

FLDR. No. _____


SHEET 7-3

DATE _____ 19__

STATION	DIST.	ANGLE		+	H. I.	- VER. ANG. DIFF.		ELEVATION
		°	' "					

249°74' Double
122°22' RT

22+67.0 P.I.

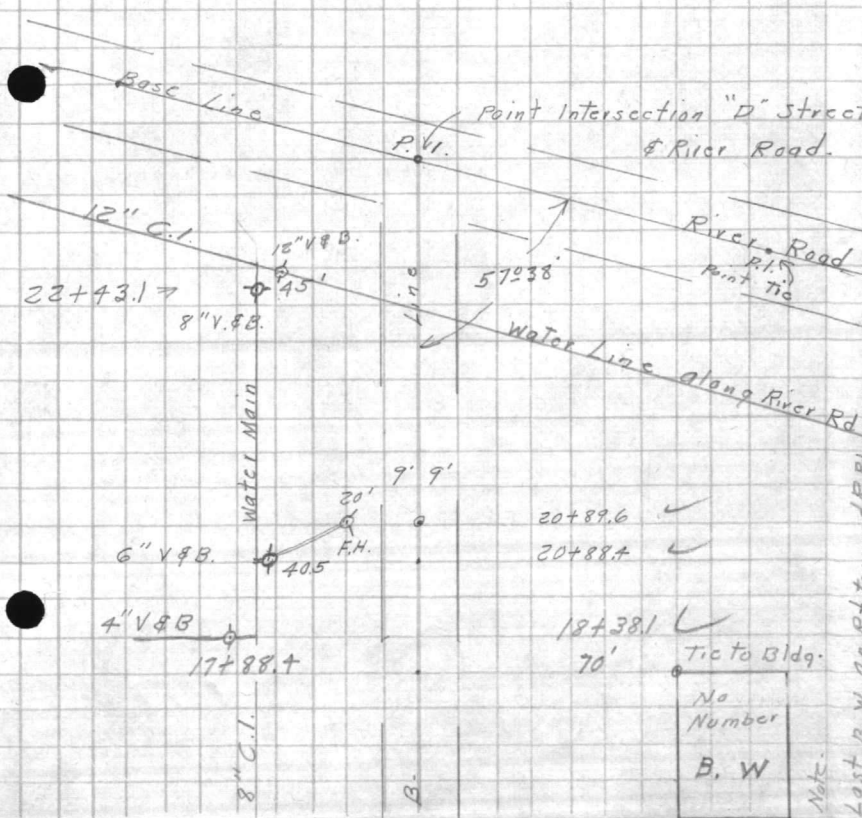








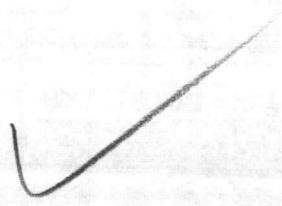










VALUABLE
 RETURN TO
 CARR & J. E.
 GREINER CO.
 JACKSONVILLE,
 N. C.

 SUBJECT Record as Built Location
for Valves & Hydrants on water
Main along River Road Beginning
at A-Street Intersection & Running
along River Road To Access Rd. Intersection
FIELD PARTY
M.S. Millan IN CHARGE
 " INSTRUMENT
 " NOTES
Kellum TAPE READ
Patten TAPE OR ROD
Coolter TAPE OR ROD
 INSTRUMENT NO. _____
 TAPE NO. _____
WEATHER
 CLEAR _____
 CLOUDY _____
 WINDY _____
 RAIN _____
 FAIR _____
 SNOW _____
 HOT _____
 MODERATE _____
 COLD _____
 FOG _____
FILE No. 160

FLDR. No. _____

SHEET 1 of 4DATE 7/10 19 42

FIGURED BY _____

NOTES CHECKED BY WPLOTTED BY W

STATION	DIST.	ANGLE	H. I.	VER. ANG. DIFF.	ELEVATION
		° ' "			

5907' Lt

7+03.8 P.I.

4" V&B 49.5

11+21 ✓

6" V&B 41.2 F.H. 213

10+83 ✓

8" C.I. Water Main
along B. St.Note - See B. St. Line
for Valve Location

P.O.T.

B. Street

63±00

P.I.

± Rd 4+00
14'

Quad 160

12" C.I. Water Main

6" V&B 13.6 F.H. 5.2

3+86 ✓

Quad 159

12" C.I. Water Main
along A-StreetNote: See A-Street Line
for Valve Location

68±08'

P.O.T.

A-Street

P.I.

111952' Lt

0+00 P.I.

 Base Line along River Road Beginning at
 A-Street Intersection & Running along
 River Road To Access Road Intersection

7





















VALUABLE
 SUBJECT _____

 RETURN TO
 CARR & J. E.
 GREINER Co.
 JACKSONVILLE,
 N. C.
FIELD PARTY
 _____ IN CHARGE
 _____ INSTRUMENT
 _____ NOTES
 _____ TAPE READ
 _____ TAPE OR ROD
 _____ TAPE OR ROD
 _____ INSTRUMENT NO.
 _____ TAPE NO.
WEATHER
 CLEAR
 CLOUDY
 WINDY
 RAIN
 FAIR
 SNOW
 HOT
 MODERATE
 COLD
 COLD
 FOG

FILE No. _____

FLDR. No. _____

SHEET 2-4DATE 7/10 19 42
 FIGURED BY _____
 NOTES CHECKED BY _____
 PLOTTED BY JW


STATION	DIST.	ANGLE	+	H. I.	VER. ANG. DIFF.	ELEVATION
---------	-------	-------	---	-------	-----------------	-----------

31+65.1 P.I.		15°52' Lt				
--------------	--	-----------	--	--	--	--




30+90.3						
30+87.2						✓
21' ERD					3+00	✓
34' ERD					28+00	✓
28' ERD					26+00	✓

23+95.7 P.I.		0°43' Lt				
--------------	--	----------	--	--	--	--

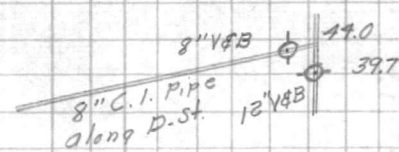


24+19.2						✓
---------	--	--	--	--	--	---

48+03 R+						
----------	--	--	--	--	--	--

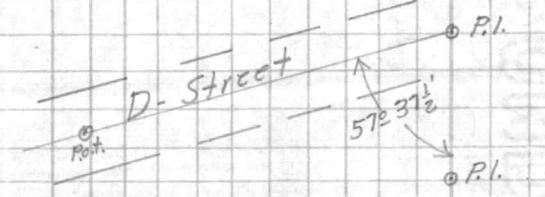

46' ERD						✓
---------	--	--	--	--	--	---

17+98.0 P.I.						
--------------	--	--	--	--	--	--

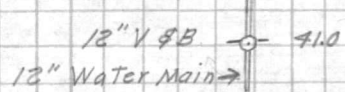

15+00						
-------	--	--	--	--	--	--

15+47.5						✓
---------	--	--	--	--	--	---
















































VALUABLE

SUBJECT _____

RETURN TO

CARR & J. E.
GREINER Co.
JACKSONVILLE,
N. C.

FIELD PARTY

 IN CHARGE _____
 INSTRUMENT _____
 NOTES _____
 TAPE READ _____
 TAPE OR ROD _____
 TAPE OR ROD _____
 INSTRUMENT NO. _____
 TAPE NO. _____

WEATHER

 CLEAR _____ SNOW _____
 CLOUDY _____ HOT _____
 WINDY _____ MODERATE _____
 RAIN _____ COLD _____
 FAIR _____ FOG _____

FILE No. _____

FLDR. No. _____

FIGURED BY _____

SHEET 4-4

NOTES CHECKED BY _____

PLOTTED BY JWDATE 7/11 1942

STATION	DIST.	ANGLE		+	H. I.	- VER. ANG. DIFF.		ELEVATION
		°	' "					

92°05'14"

49+81.7 P.I.

12" Water Main along Access Rd

Access Road

P.O.T.

87°55'

Line tied in with South
Lane Access Road.

12" V. & B. 43.2

49+50.5 ✓

12" V. & B. 47.7

49+46.1

12" V. & B. 42.7

49+41.9 ✓

6" V. & B.

48+26.0

6" V. & B.

12.8
F.H.C.

30.6

47+23.8

47+22.2 ✓





























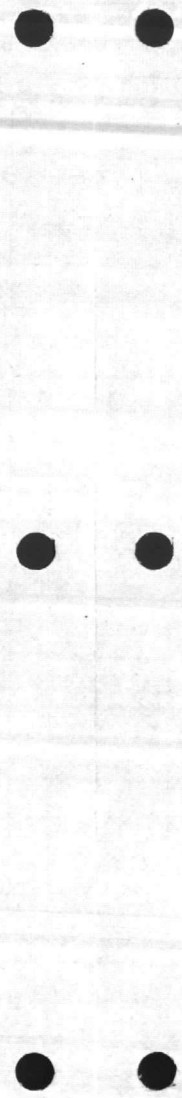

Post Troop Area

VALUABLE

SUBJECT _____

RETURN TO
 CARR & J. E.
 GREINER CO.
 JACKSONVILLE,
 N. C.

FIELD PARTY

IN CHARGE _____
 INSTRUMENT _____
 NOTES _____
 TAPE READ _____
 TAPE OR ROD _____
 TAPE OR ROD _____
 INSTRUMENT NO. _____
 TAPE NO. _____

WEATHER

CLEAR _____ SNOW _____
 CLOUDY _____ HOT _____
 WINDY _____ MODERATE _____
 RAIN _____ COLD _____
 FAIR _____ FOG _____

FILE No. _____

FLDR. No. _____

SHEET 2-5

FIGURED BY _____
 NOTES CHECKED BY _____
 PLOTTED BY _____ DATE _____ 19__


STATION	DIST.	ANGLE	H. I.	VER. ANG. DIFF.	ELEVATION
		° ' "			

75° 55' RT

7+99.3 P.I.

76° 46' RT

7+39.0 P.I.

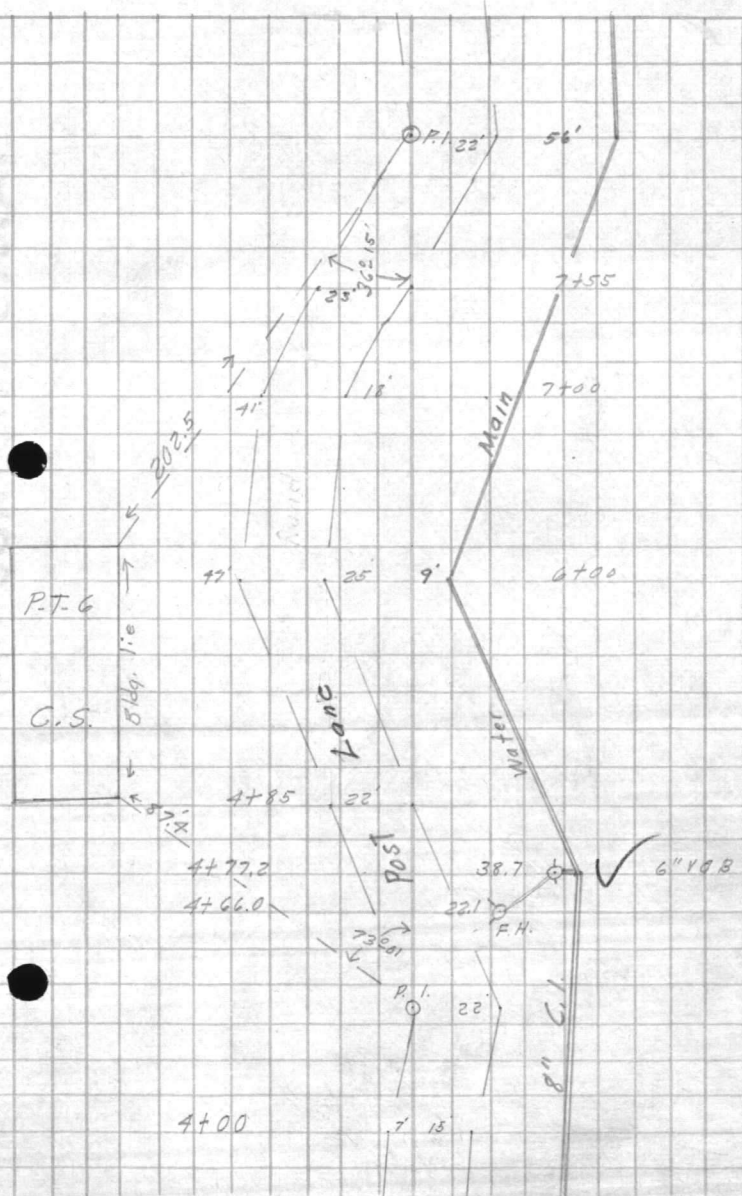







Post Troop Area

VALUABLE

SUBJECT _____

RETURN TO
 CARR & J. E.
 GREINER CO.
 JACKSONVILLE,
 N. C.

FIELD PARTY

IN CHARGE _____
 INSTRUMENT _____
 NOTES _____
 TAPE READ _____
 TAPE OR ROD _____
 TAPE OR ROD _____
 INSTRUMENT NO. _____
 TAPE NO. _____

WEATHER

CLEAR _____ SNOW _____
 CLOUDY _____ HOT _____
 WINDY _____ MODERATE _____
 RAIN _____ COLD _____
 FAIR _____ FOG _____

FILE No. _____


FLDR. No. _____

FIGURED BY _____ SHEET 3-5

NOTES CHECKED BY _____ DATE 8/5 1942

PLOTTED BY _____

STATION	DIST.	ANGLE		+	H. I.	VER. ANG. DIFF.	ELEVATION
		°	"				

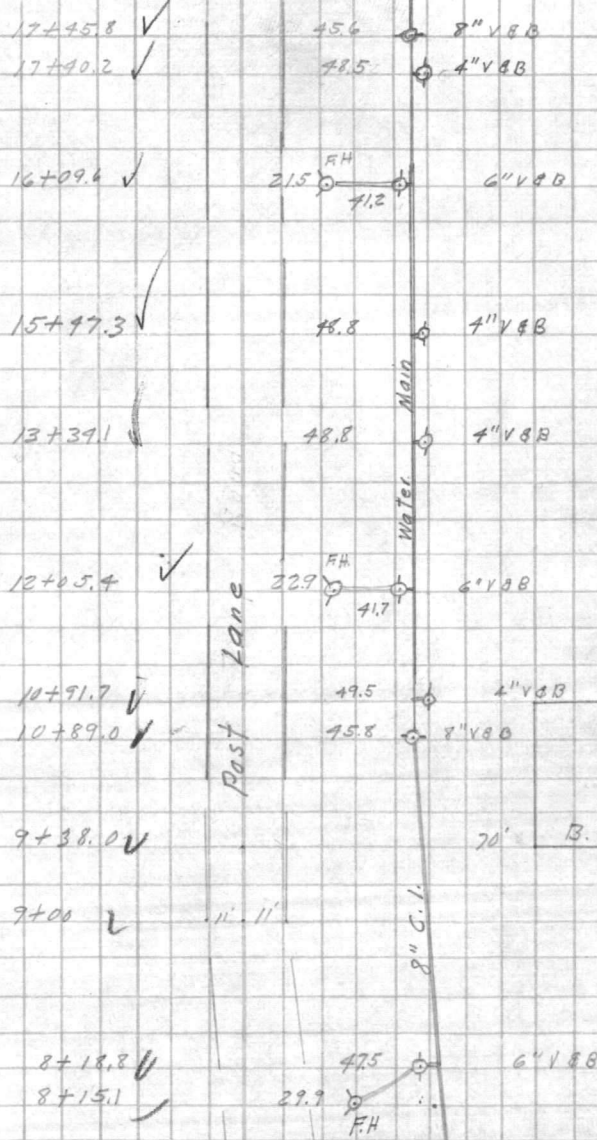








Post Troop Area

VALUABLE

SUBJECT _____

RETURN TO
 CARR & J. E.
 GREINER CO.
 JACKSONVILLE,
 N. C.

FIELD PARTY

IN CHARGE _____
 INSTRUMENT _____
 NOTES _____
 TAPE READ _____
 TAPE OR ROD _____
 TAPE OR ROD _____
 INSTRUMENT NO. _____
 TAPE NO. _____

WEATHER

CLEAR _____
 CLOUDY _____
 WINDY _____
 RAIN _____
 FAIR _____
 SNOW _____
 HOT _____
 MODERATE _____
 COLD _____
 FOG _____

FILE No. _____

FLDR. No. _____

FIGURED BY _____ SHEET 4-5

NOTES CHECKED BY _____ DATE 8/6 1992

PLOTTED BY _____


STATION	DIST.	ANGLE		+	H. I.	VER. ANG. DIFF.	ELEVATION
		°	' "				

16° 22' 30" Lt


22+55.6 P.I.
 (21+65)

10° 35' Lt

18+73.8 P.I.

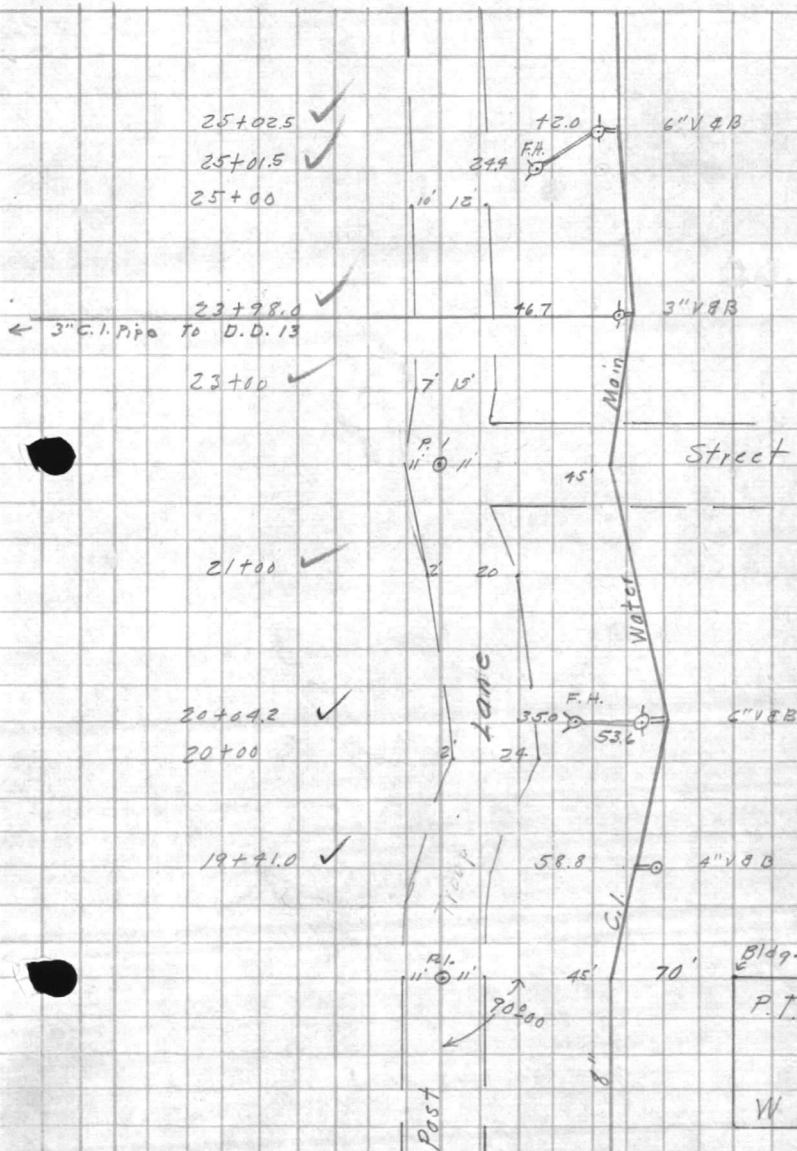

Bldg. Tie
 P.T. 3
 W.H.

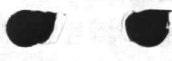

WOODS BROTHERS
NEW YORK

Post Troop Area

VALUABLE

RETURN TO
CARR & J. E.
GREINER CO.
JACKSONVILLE,
N. C.

SUBJECT _____

FIELD PARTY

IN CHARGE

INSTRUMENT

NOTES

TAPE READ

TAPE OR ROD

TAPE OR ROD

INSTRUMENT No.

TAPE No.

WEATHER

CLEAR
CLOUDY
WINDY
RAIN
RAIN
FAIR

SNOW
HOT
MODERATE
COLD
FOG

FILE No. _____

FLDR. No. _____

FIGURED BY _____ SHEET 5-5

NOTES CHECKED BY _____

PLOTTED BY _____ DATE 8/6 1992


STATION	DIST.	ANGLE	H. I.	VER. ANG. DIFF.	ELEVATION
		° ' "			

3345
2265
381

26+46 Post Road
↙

89°-05' RT.

= 35+46.0 Rot of Access Road
23+53.6 P.I. Post Lane rd.

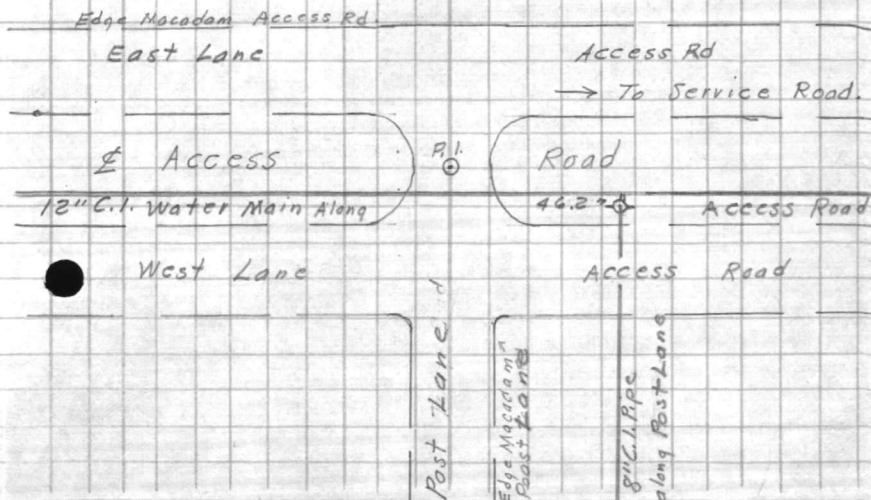


Post Lane

Edge Macadam Post Lane

8\"/>

B. E. BEAVIN (The Boss)
(Big)

OR
J. WILSON (Little Boss)

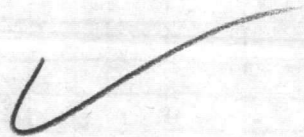

78

VALUABLE

RETURN TO
 CARR & J. E.
 GREINER CO.
 JACKSONVILLE,
 N. C.

SUBJECT Record as built Valve & Fire
Hydrant Location on water main along
Service Rd. Base Line Beginning at
A St. intersecting on Runing along
Service Rd To South Lane Access Road.

FIELD PARTY


McMillan IN CHARGE
 " INSTRUMENT
 " NOTES
Kellum TAPE READ
Patten TAPE OR ROD
Soulter TAPE OR ROD
 INSTRUMENT NO. _____
 TAPE NO. _____

WEATHER

CLEAR _____
 CLOUDY _____
 WINDY _____
 RAIN _____
 FAIR _____
 SNOW _____
 HOT _____
 MODERATE _____
 COLD _____
 FOG _____
 FIGURED BY _____
 NOTES CHECKED BY _____
 PLOTTED BY JP

FILE No. 160
 FLDR. No. _____
 SHEET 1-4
 DATE 7/9 1942

STATION	DIST.	ANGLE		+	H. I.	- VER. ANG. DIFF.	ELEVATION
		°	' "				

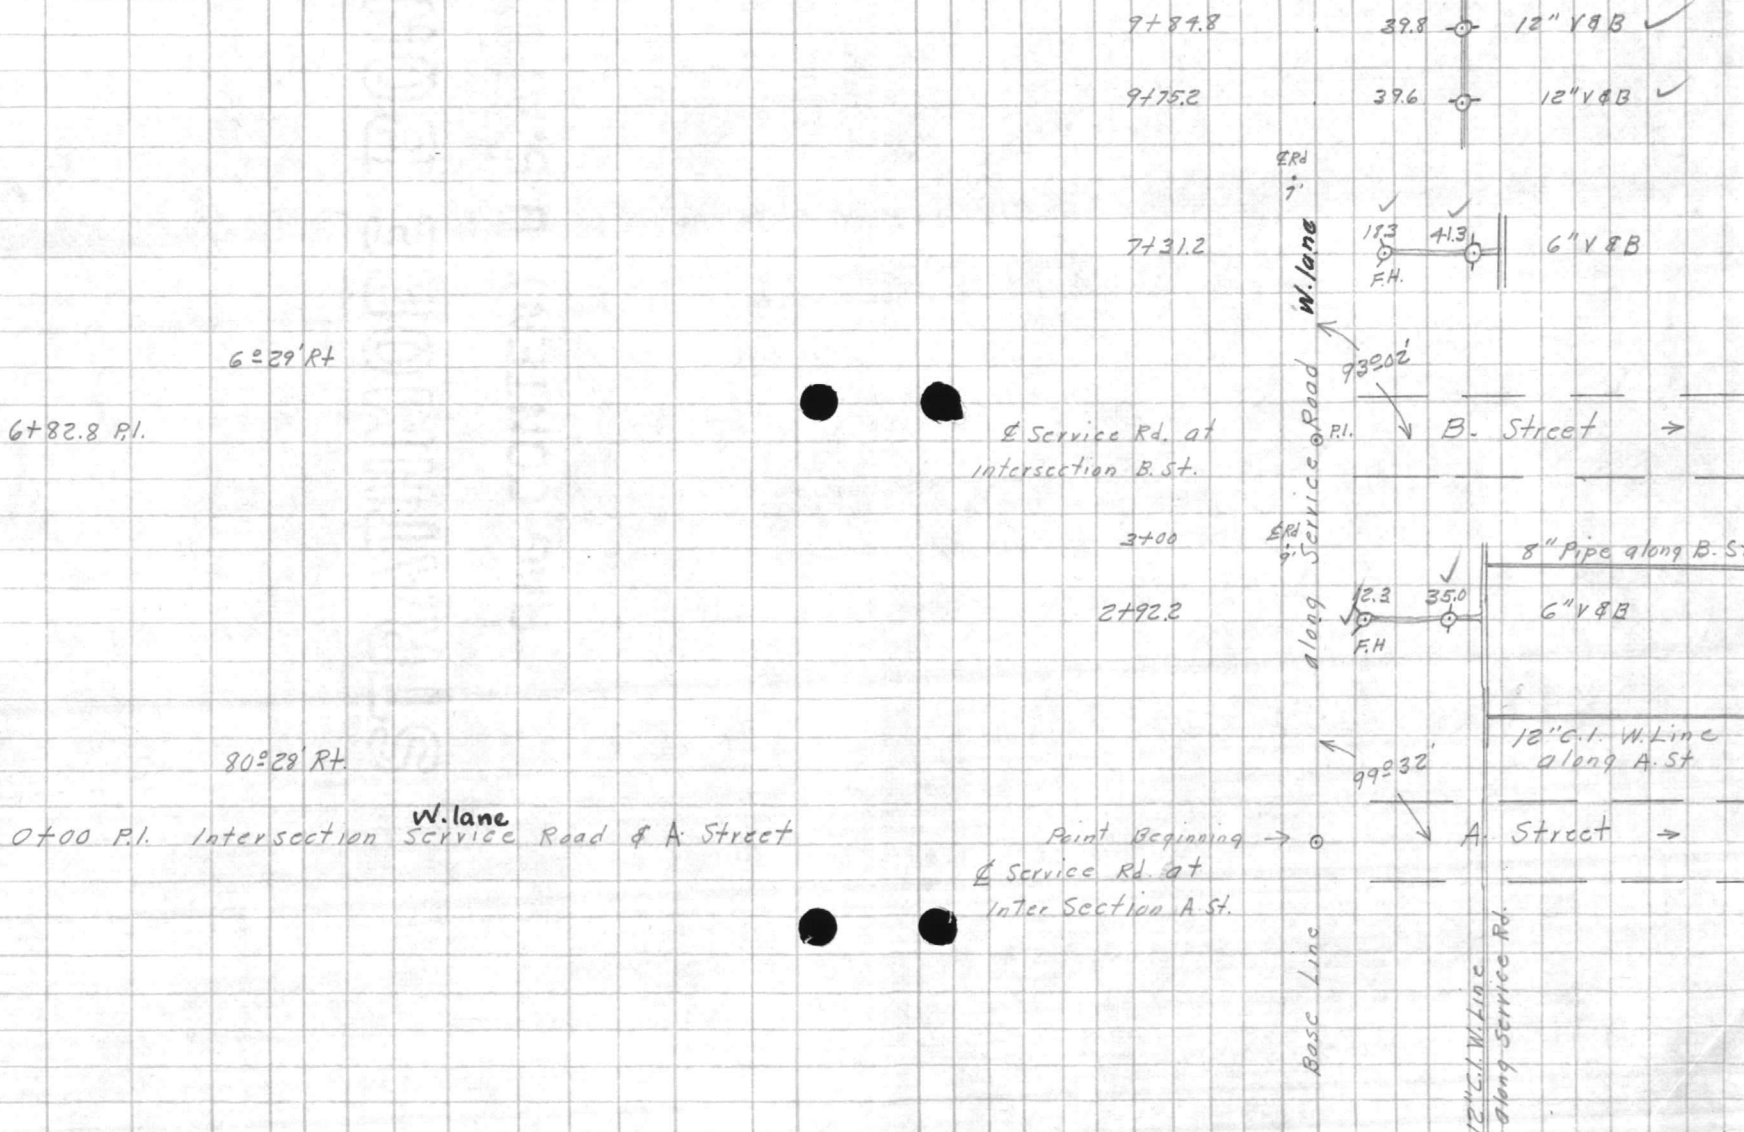


6+82.8 P.I.
 6°29' RT

0+00 P.I. Intersection W. lane
Service Road & A Street

Service Rd. at
 intersection B. St.

Point Beginning →
 Service Rd. at
 Inter Section A. St.

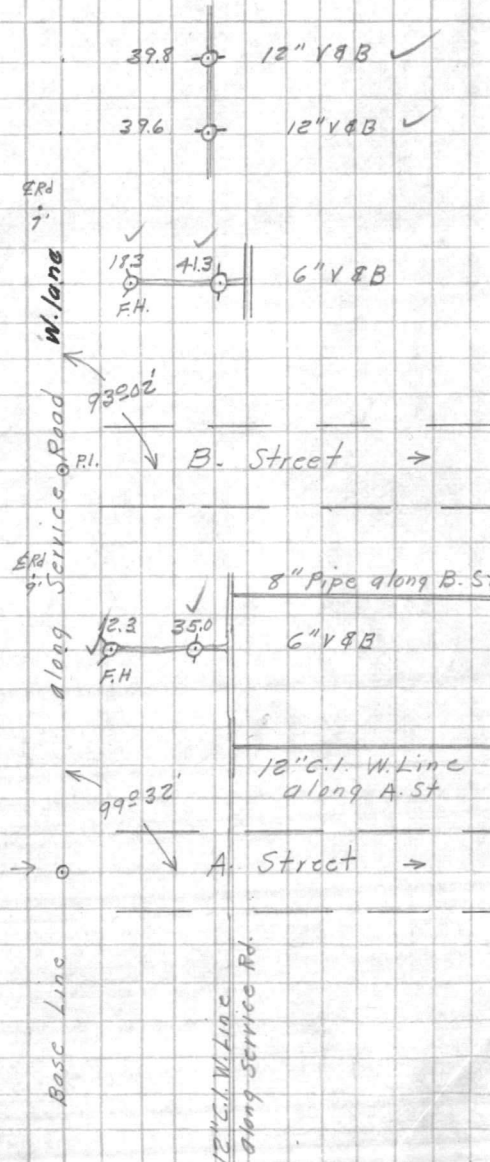



















VALUABLE

SUBJECT _____

RETURN TO
 CARR & J. E.
 GREINER Co.
 JACKSONVILLE,
 N. C.

FIELD PARTY

 IN CHARGE

 INSTRUMENT

 NOTES

 TAPE READ

 TAPE OR ROD

 TAPE OR ROD


 INSTRUMENT No. _____
 TAPE No. _____

WEATHER

CLEAR _____
 CLOUDY _____
 WINDY _____
 RAIN _____
 FAIR _____
 SNOW _____
 HOT _____
 MODERATE _____
 COLD _____
 FOG _____
 FIGURED BY _____
 NOTES CHECKED BY _____
 PLOTTED BY _____

FILE No. _____
 FLDR. No. _____
 SHEET 214
 DATE _____ 19____

STATION	DIST.	ANGLE	+	H. I.	VER. ANG. DIFF.	ELEVATION
---------	-------	-------	---	-------	-----------------	-----------

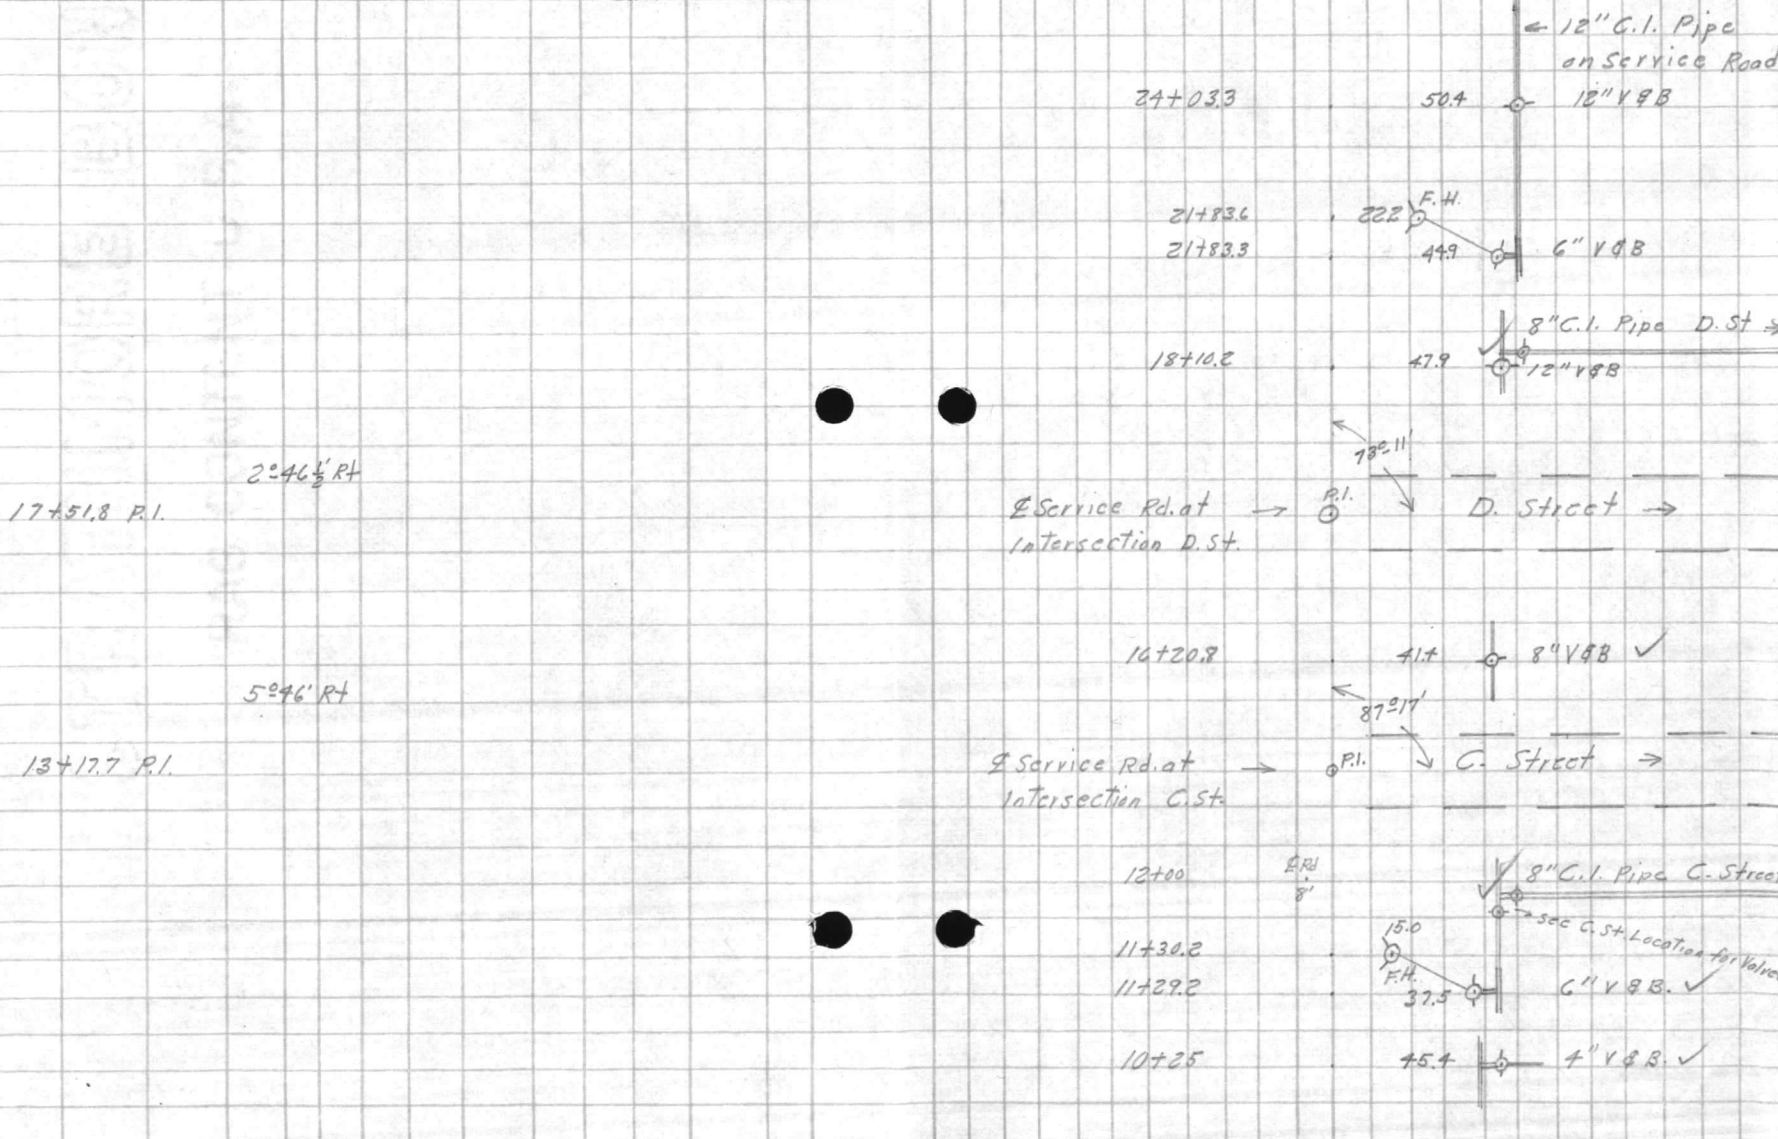


















VALUABLE

SUBJECT _____

RETURN TO

CARR & J. E.
GREINER CO.
JACKSONVILLE,
N. C.

FIELD PARTY

 _____ IN CHARGE
 _____ INSTRUMENT
 _____ NOTES
 _____ TAPE READ
 _____ TAPE OR ROD
 _____ TAPE OR ROD
 _____ INSTRUMENT NO.
 _____ TAPE NO.

WEATHER

 CLEAR
 CLOUDY
 WINDY
 RAIN
 FAIR
 SNOW
 HOT
 MODERATE
 COLD
 FOG

FILE No. _____

FLDR. No. _____

SHEET 3-4DATE 7/10 1942

FIGURED BY _____

NOTES CHECKED BY _____

PLOTTED BY _____

STATION	DIST.	ANGLE	+	H. I.	— VER. ANG. DIFF.	ELEVATION
---------	-------	-------	---	-------	-------------------------	-----------

112°30' LT

32+42.1 P.I.

33+05.5

56.6

12" V&B

32+97.5

56.1

12" V&B

32+90.2 ✓

30.9

F.H.

32+88.9 ✓

50.9

6" V&B.

87°14'

 Service Rd. at
 Intersection G. St.

P.I.

G. Street

79°52' LT

29+05.3 P.I.

81°11'

 Service Rd. at
 Intersection F. St.

P.I.

F. Street

28+72.1

51.3

8" C.I. Pipe F. St. →

28+48.9

24.6

47.6

12" V&B

6" V&B

F.H.

02°06' LT

24+36.2 P.I.

73°14'

 Service Rd. at
 Intersection E. St.

P.I.

E. Street →

24+03.3

50.8























































































































































































































VALUABLE

SUBJECT _____

RETURN TO
CARR & J. E.
GREINER CO.
JACKSONVILLE,
N. C.

FIELD PARTY

IN CHARGE

INSTRUMENT

NOTES

TAPE READ

TAPE OR ROD

TAPE OR ROD

INSTRUMENT NO.

TAPE NO.

WEATHER

CLEAR
CLOUDY
WINDY
RAIN
FAIR

SNOW
HOT
MODERATE
COLD
FOG

FIGURED BY _____
NOTES CHECKED BY _____
PLOTTED BY _____

FILE No. _____

FLDR. No. _____

SHEET 4-4

DATE 7/10 1942

STATION	DIST.	ANGLE		+	H. I.	- VER. ANG. DIFF.	ELEVATION
		°	"				

87913' RT

394215 PI

P.I. set with ♀ South
Lane Access Rd.

South Lane Access Rd

Service Rd ↑

PI

72247

37418.2

00.3

12" V. B.

37405.2

37403.8

Service Rd ↓

477

288

F.H.

6" V. B.






















VALUABLE
 RETURN TO
 CARR & J. E.
 GREINER Co.
 JACKSONVILLE,
 N. C.

 SUBJECT Location of Water Main
Valves & Hydrants Along
B. Street Regimental
Area # I
FIELD PARTY
M. S. Milon IN CHARGE
 " INSTRUMENT
 " NOTES
Patten TAPE READ
Kellum TAPE OR ROD
Sautter TAPE OR ROD
 INSTRUMENT NO. _____
 TAPE NO. _____
WEATHER
 CLEAR _____ SNOW _____
 CLOUDY _____ HOT _____
 WINDY _____ MODERATE _____
 RAIN _____ COLD _____
 FAIR _____ FOG _____
 FIGURED BY _____
 NOTES CHECKED BY _____
 PLOTTED BY JH
FILE No. 160

FLDR. No. _____

SHEET 1 of 3DATE 7/2 19 42

STATION	DIST.	ANGLE	+	H. I.	VER. ANG.	ELEVATION
		"			DIFF.	

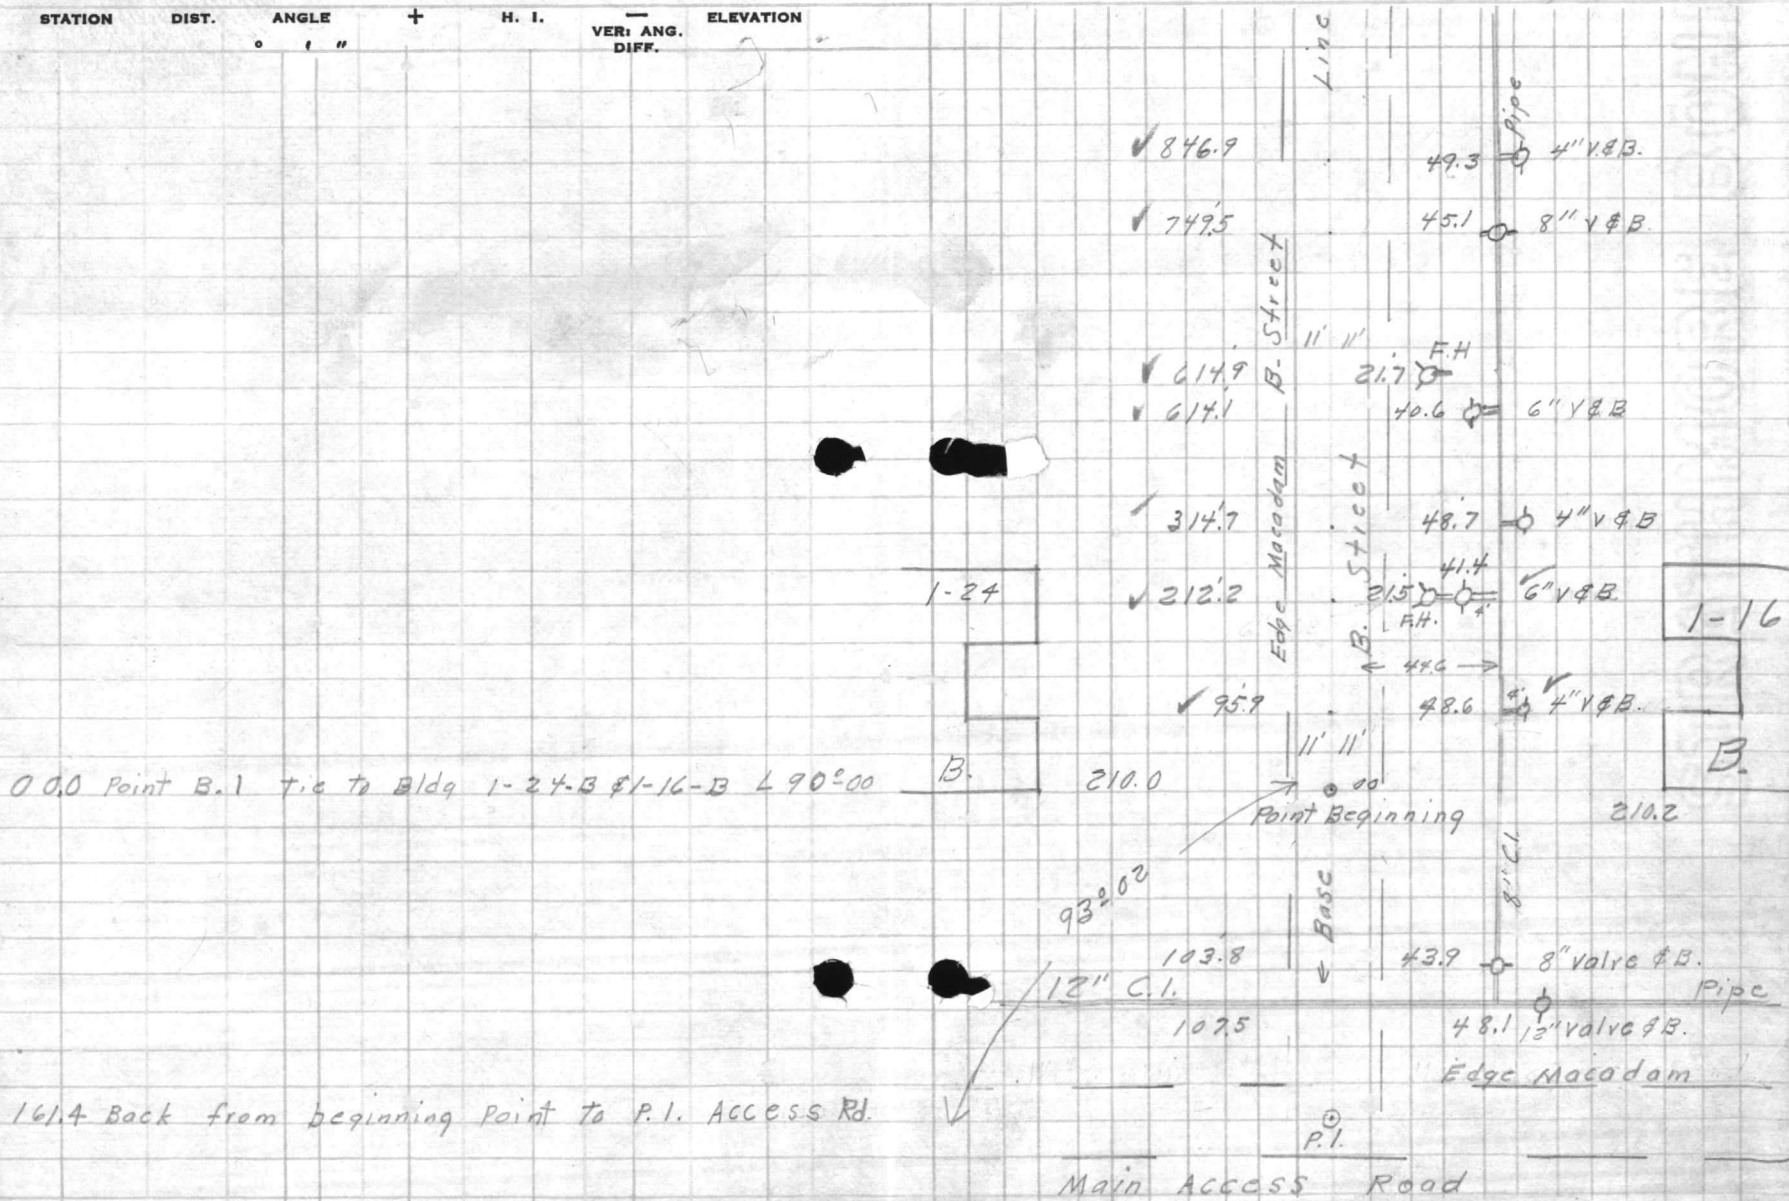

UNCLASSIFIED

B. Street
Regimental Area #1


VALUABLE

SUBJECT _____

RETURN TO

CARR & J. E.
GREINER Co.JACKSONVILLE,
N. C.

FIELD PARTY

 _____ IN CHARGE
 _____ INSTRUMENT
 _____ NOTES
 _____ TAPE READ
 _____ TAPE OR ROD
 _____ TAPE OR ROD
 _____ INSTRUMENT NO.
 _____ TAPE NO.

WEATHER

 CLEAR
 CLOUDY
 WINDY
 RAIN
 FAIR
 SNOW
 HOT
 MODERATE
 COLD
 FOG

FILE No. _____

FLDR. No. _____

SHEET 2-3

DATE 19____

FIGURED BY _____

NOTES CHECKED BY _____

PLOTTED BY _____

STATION	DIST.	ANGLE	+	H. I.	—	ELEVATION
		° ' "			VER. ANG. DIFF.	

2001.5 Pat B-3. Tie To Bldg. 1-8-B L 90°00

27 Pipe Line along C. Street



✓ 1987.1

✓ 1809.0

✓ 1633.9

✓ 1471.1

← 8" C.I.

✓ 1410.4

✓ 1407.7

✓ 1298.2

1127.4 Pat B-2. Tie To Bldg. 1-13-B. L 90°00

1060.9

✓ 1010.4

✓ 1009.7

Base

8" C.I.


























































































VALUABLE

SUBJECT _____

RETURN TO

CARR & J. E.
GREINER Co.
JACKSONVILLE,
N. C.

FIELD PARTY

 _____ IN CHARGE
 _____ INSTRUMENT
 _____ NOTES
 _____ TAPE READ
 _____ TAPE OR ROD
 _____ TAPE OR ROD
 _____ INSTRUMENT NO.
 _____ TAPE NO.

WEATHER

 CLEAR
 CLOUDY
 WINDY
 RAIN
 FAIR
 SNOW
 HOT
 MODERATE
 COLD
 FOG

FILE No. _____

FLDR. No. _____

SHEET 3-3

DATE _____ 19__

 FIGURED BY _____
 NOTES CHECKED BY _____
 PLOTTED BY W

STATION	DIST.	ANGLE	+	H. I.	VER. ANG. DIFF.	ELEVATION
		° ' "				

Line →

 P. I. River Rd.
 23+29.2 Post 'B' St

Edge Macadam

River Road

P. I.

2278.0

12" C.I.

40.3

12" V & B

22928

+5.2

8" V & B

2218.0

49.5

4" V & B

2206.0

41.7

6" V & B

2205.9

220

F.H.

Edge Macadam B. Street

11' 11"

B.

Water Main along River Rd.

VALUABLE

SUBJECT



(4) ✓

FILE NO


















FILE NO





VALUABLE

SUBJECT _____

 RETURN TO
 CARR & J. E.
 GREINER CO.
 JACKSONVILLE,
 N. C.

FIELD PARTY

 _____ IN CHARGE
 _____ INSTRUMENT
 _____ NOTES
 _____ TAPE READ
 _____ TAPE OR ROD
 _____ TAPE OR ROD
 _____ INSTRUMENT NO.
 _____ TAPE NO.

WEATHER

 CLEAR _____
 CLOUDY _____
 WINDY _____
 RAIN _____
 FAIR _____
 SNOW _____
 HOT _____
 MODERATE _____
 COLD _____
 FOG _____
 FIGURED BY _____
 NOTES CHECKED BY _____
 PLOTTED BY _____

FILE No. _____


FLDR. NO. _____

SHEET 2-2

DATE _____ 19____

STATION	DIST.	ANGLE	+	H. I.	VER. ANG. DIFF.	ELEVATION
---------	-------	-------	---	-------	-----------------	-----------

93°01'4
 = 13417.7 P.I. Service Road.
 21+97.0 P.I. "C" Street

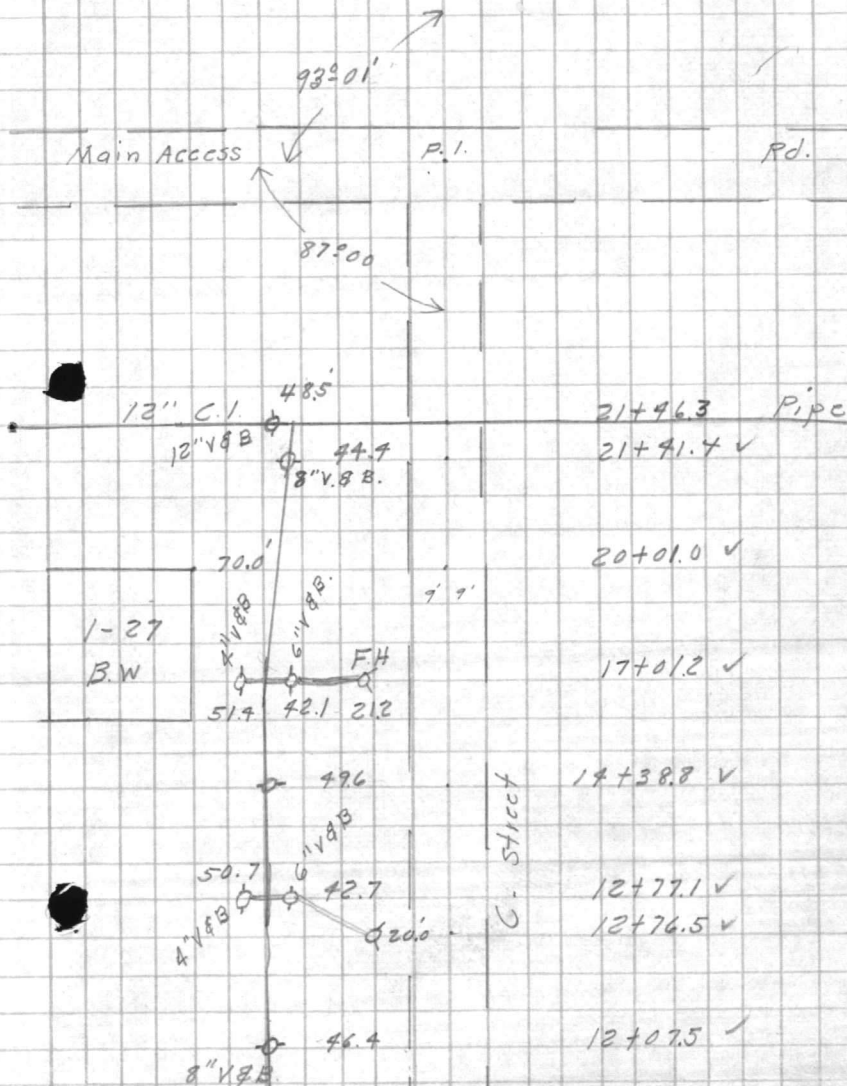

AVAILABLE

C Street
Regimental Area #1

(3)