




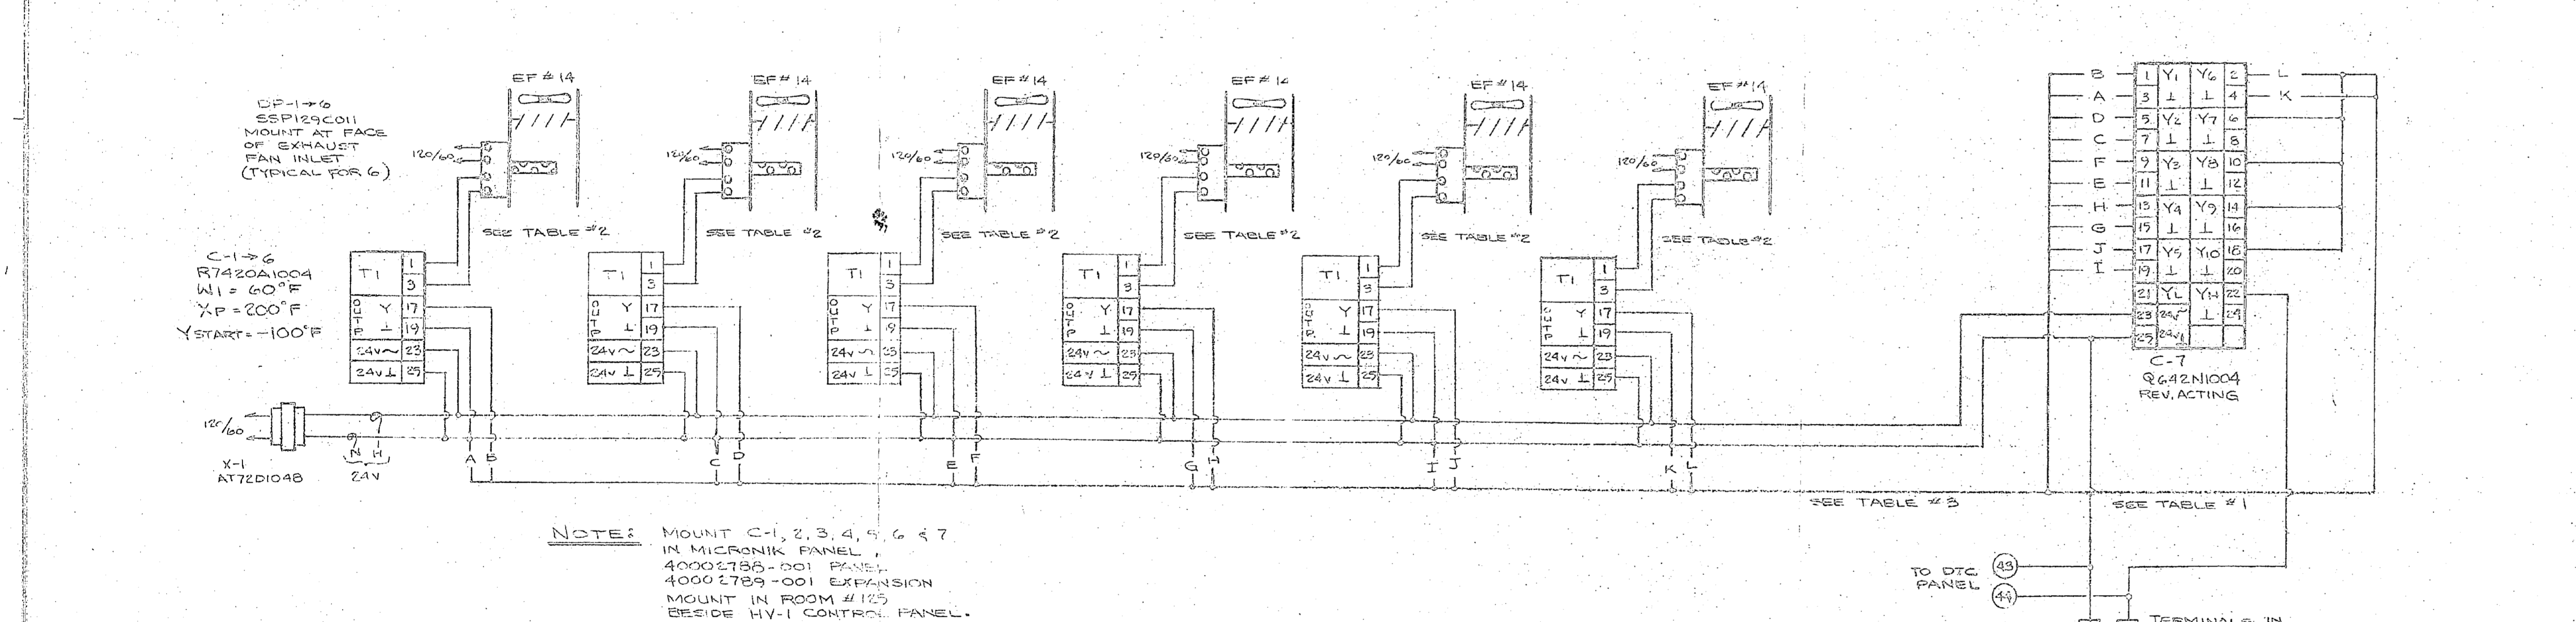

NOTE: MOUNT C-1, 2, 3, 4, 5, 6 & 7 IN MICRONIK PANEL, 40002785-001 PANEL, 40002789-001 EXPANSION MOUNT IN ROOM #125 BESIDE HV-1 CONTROL PANEL.

TABLE #1

WIRING	FROM CONTROLLER	TYPE OF WIRE	DISTANCE LIMITATION IN FT. (M)
		14 AWG (.5 mm ²)	656 (200)
		16 AWG (.25 mm ²)	410 (125)
		18 AWG (.10 mm ²)	262 (80)
		20 AWG (.08 mm ²)	164 (50)

TABLE #2

WIRING R7420A	FROM CONTROLLER	TYPE OF WIRE	DISTANCE LIMITATION IN FT. (M)
		14 AWG (.5 mm ²)	656 (200)
		16 AWG (.25 mm ²)	410 (125)
		18 AWG (.10 mm ²)	262 (80)
		20 AWG (.08 mm ²)	164 (50)

TABLE #3

FROM Q642N TO:	TYPE OF WIRE	DISTANCE LIMITATION IN FT. (M)
ACTUATORS	14 AWG (.5 mm ²)	656 (200)
	16 AWG (.25 mm ²)	410 (125)
	18 AWG (.10 mm ²)	262 (80)
	20 AWG (.08 mm ²)	164 (50)
R7420 CONTROLLERS	18 AWG (.10 mm ²)	328 (100)
	20 AWG (.08 mm ²)	196 (60)

NOTE: THE E/P TRANSDUCER TERMINAL 24V L (0 VOLTS) MUST BE CONNECTED TO THE CONTROL TERMINAL 25.

LE BEND:

- = MOUNT IN DTC PANEL.
- ⊗ = MOUNT IN HV-1 CONTROL PANEL.
- ⊑ = TERMINAL IN HV-1 CONTROL PANEL.
- ⊚ = TERMINAL IN DTC PANEL.

N.H. = NOT BY HONEYWELL

THIS IS THE LATEST REVISION TO THIS DRAWING, DESTROY ALL PREVIOUS ISSUES. MAY 9 1983

SHAW-WALKER, INC.

517 S. SHARON AVENUE, CHARLOTTE, N.C. 28211


FIELD MAINTENANCE SHOP, MARINE CORPS AIR BASE, CAMP LEJEUNE, N.C.

3/18/83 CNG


939-82616-1X1

DESIGNED BY: NAVAL FACILITIES ENGINEER: NAVAL FACILITIES CONTRACTOR: SNEEDEN, INC. APPLICATION ENGINEER: NELSON GATES

NOTE: ECONOMIZER PACKAGE IS SUPPLIED WITH AC UNIT AND REQUIRES NO FIELD INSTALLATION OR WIRING OTHER THAN INTERLOCKING WITH ECONOMIZER POWER SUPPLY (SEE AC-1,3 CONTROL WIRING)

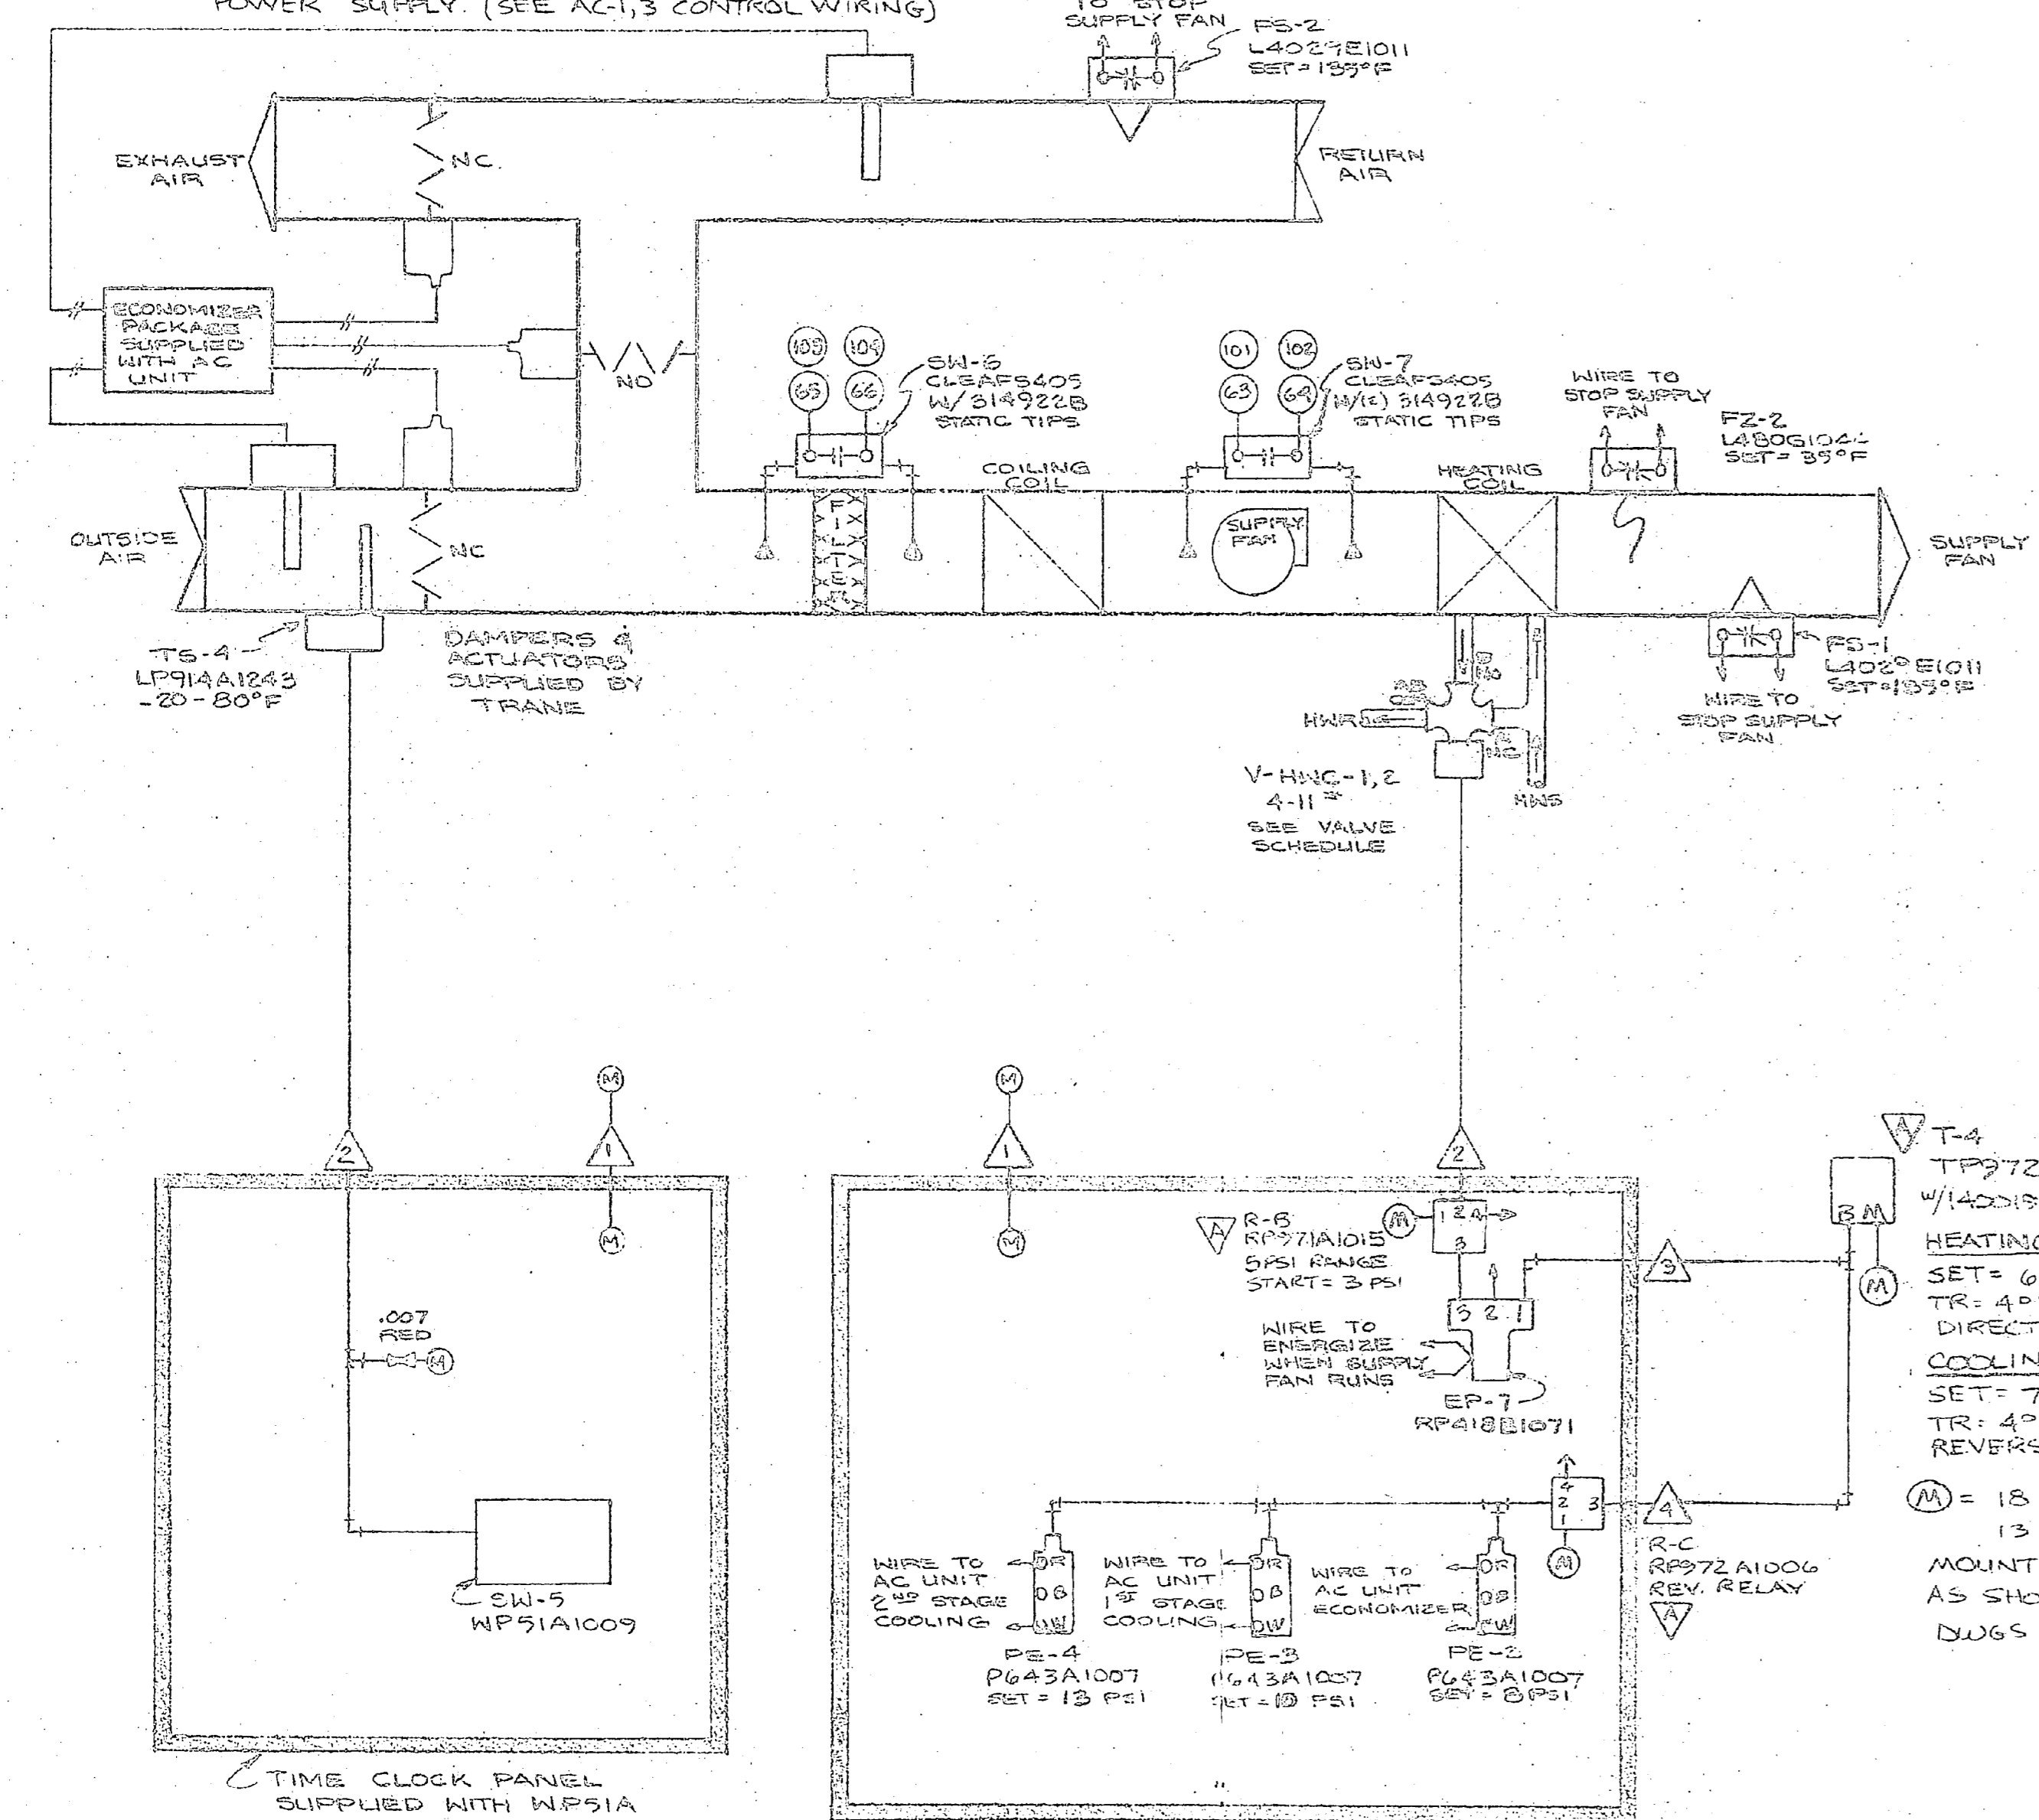

AC-1,3 CONTROLS (TYPICAL FOR 2)

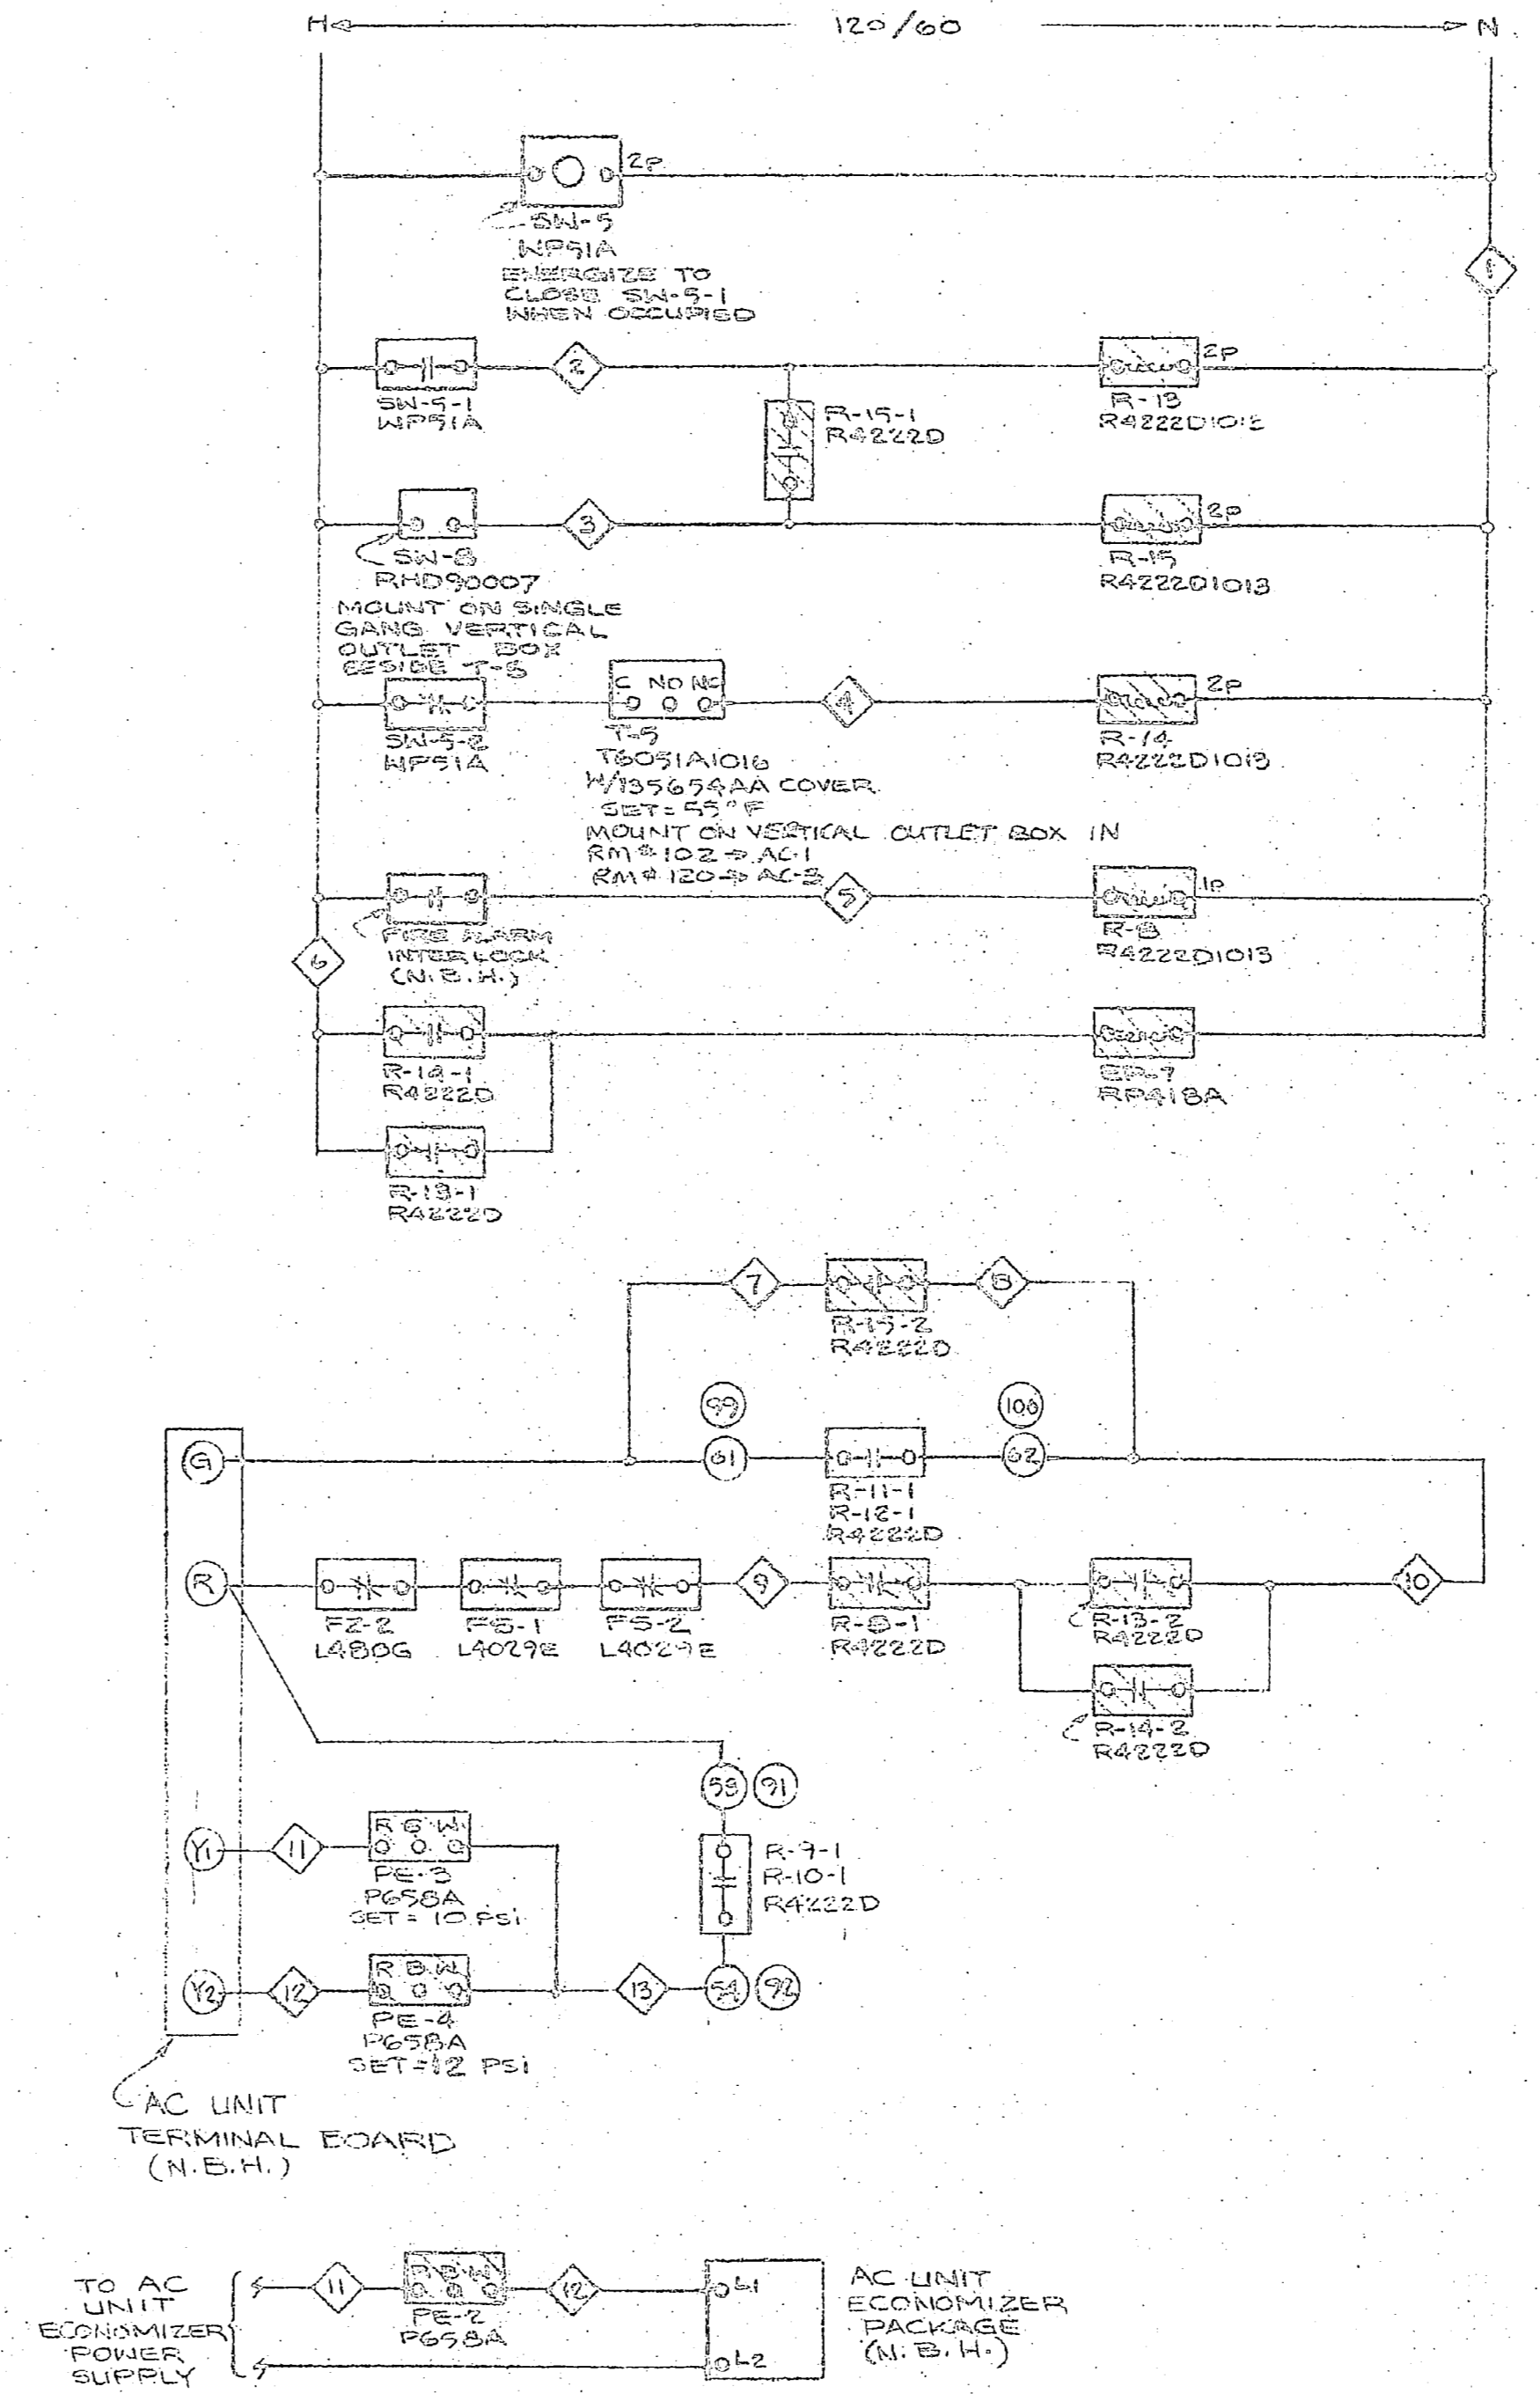

AC-1 & 3 CONTROL WIRING (TYPICAL FOR 2)


- Legend:
 - ◊ = TERMINAL IN AC-1,3 CONTROL PANELS
 - = TERMINAL IN DTC PANEL
 - = MOUNT IN DTC PANEL
 - = MOUNT IN AC-1,3 CONTROL PANELS.
- N.E.H. = NOT BY HONEYWELL

THIS IS THE LATEST REVISION TO THIS DRAWING, DESTROY ALL PREVIOUS ISSUES.
MAY 9 1983

ARCHITECT: NAVAL FACILITIES
ENGINEER: NAVAL FACILITIES
CONTRACTOR: SNEYDEN, INC.
APPLICATION ENGINEER: NELSON GATES



DATE	11-18-82	BY	DRS	NO.	1
REVISION	2	DATE	11-18-82	BY	DRS
DATE	11-18-82	BY	DRS	NO.	1

317 E. SHARON AVENUE, CHARLOTTE, N.C. 28211
FIELD MAINTENANCE SHOP
MARINE CORPS AIR BASE
MAIN SERVICE ROAD
CAMP LEJUNE, N.C.

939-82616-2X1







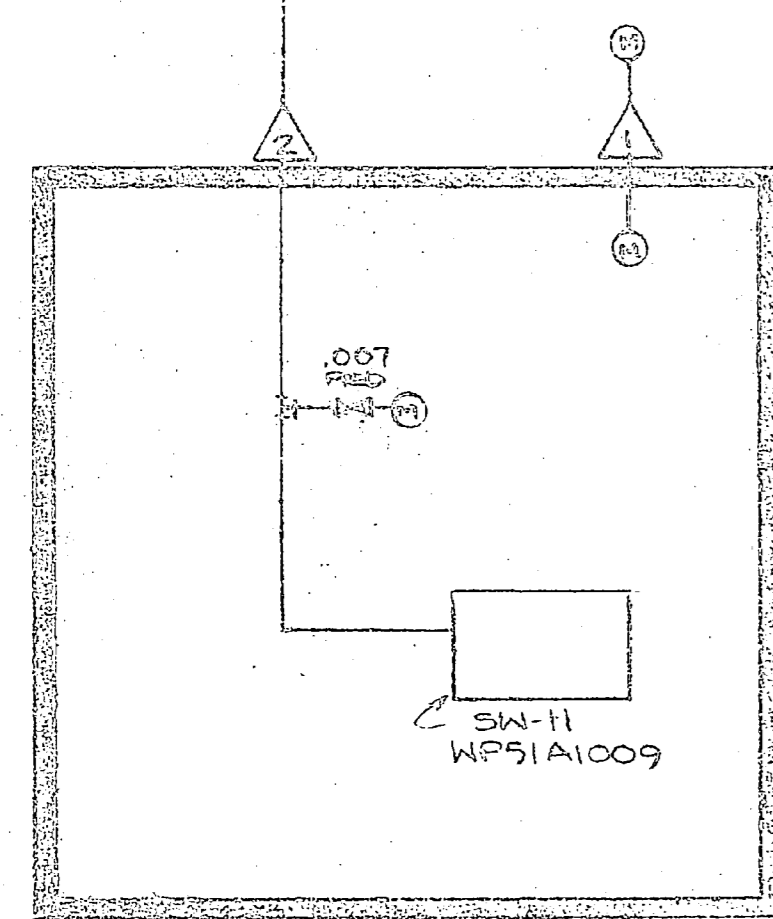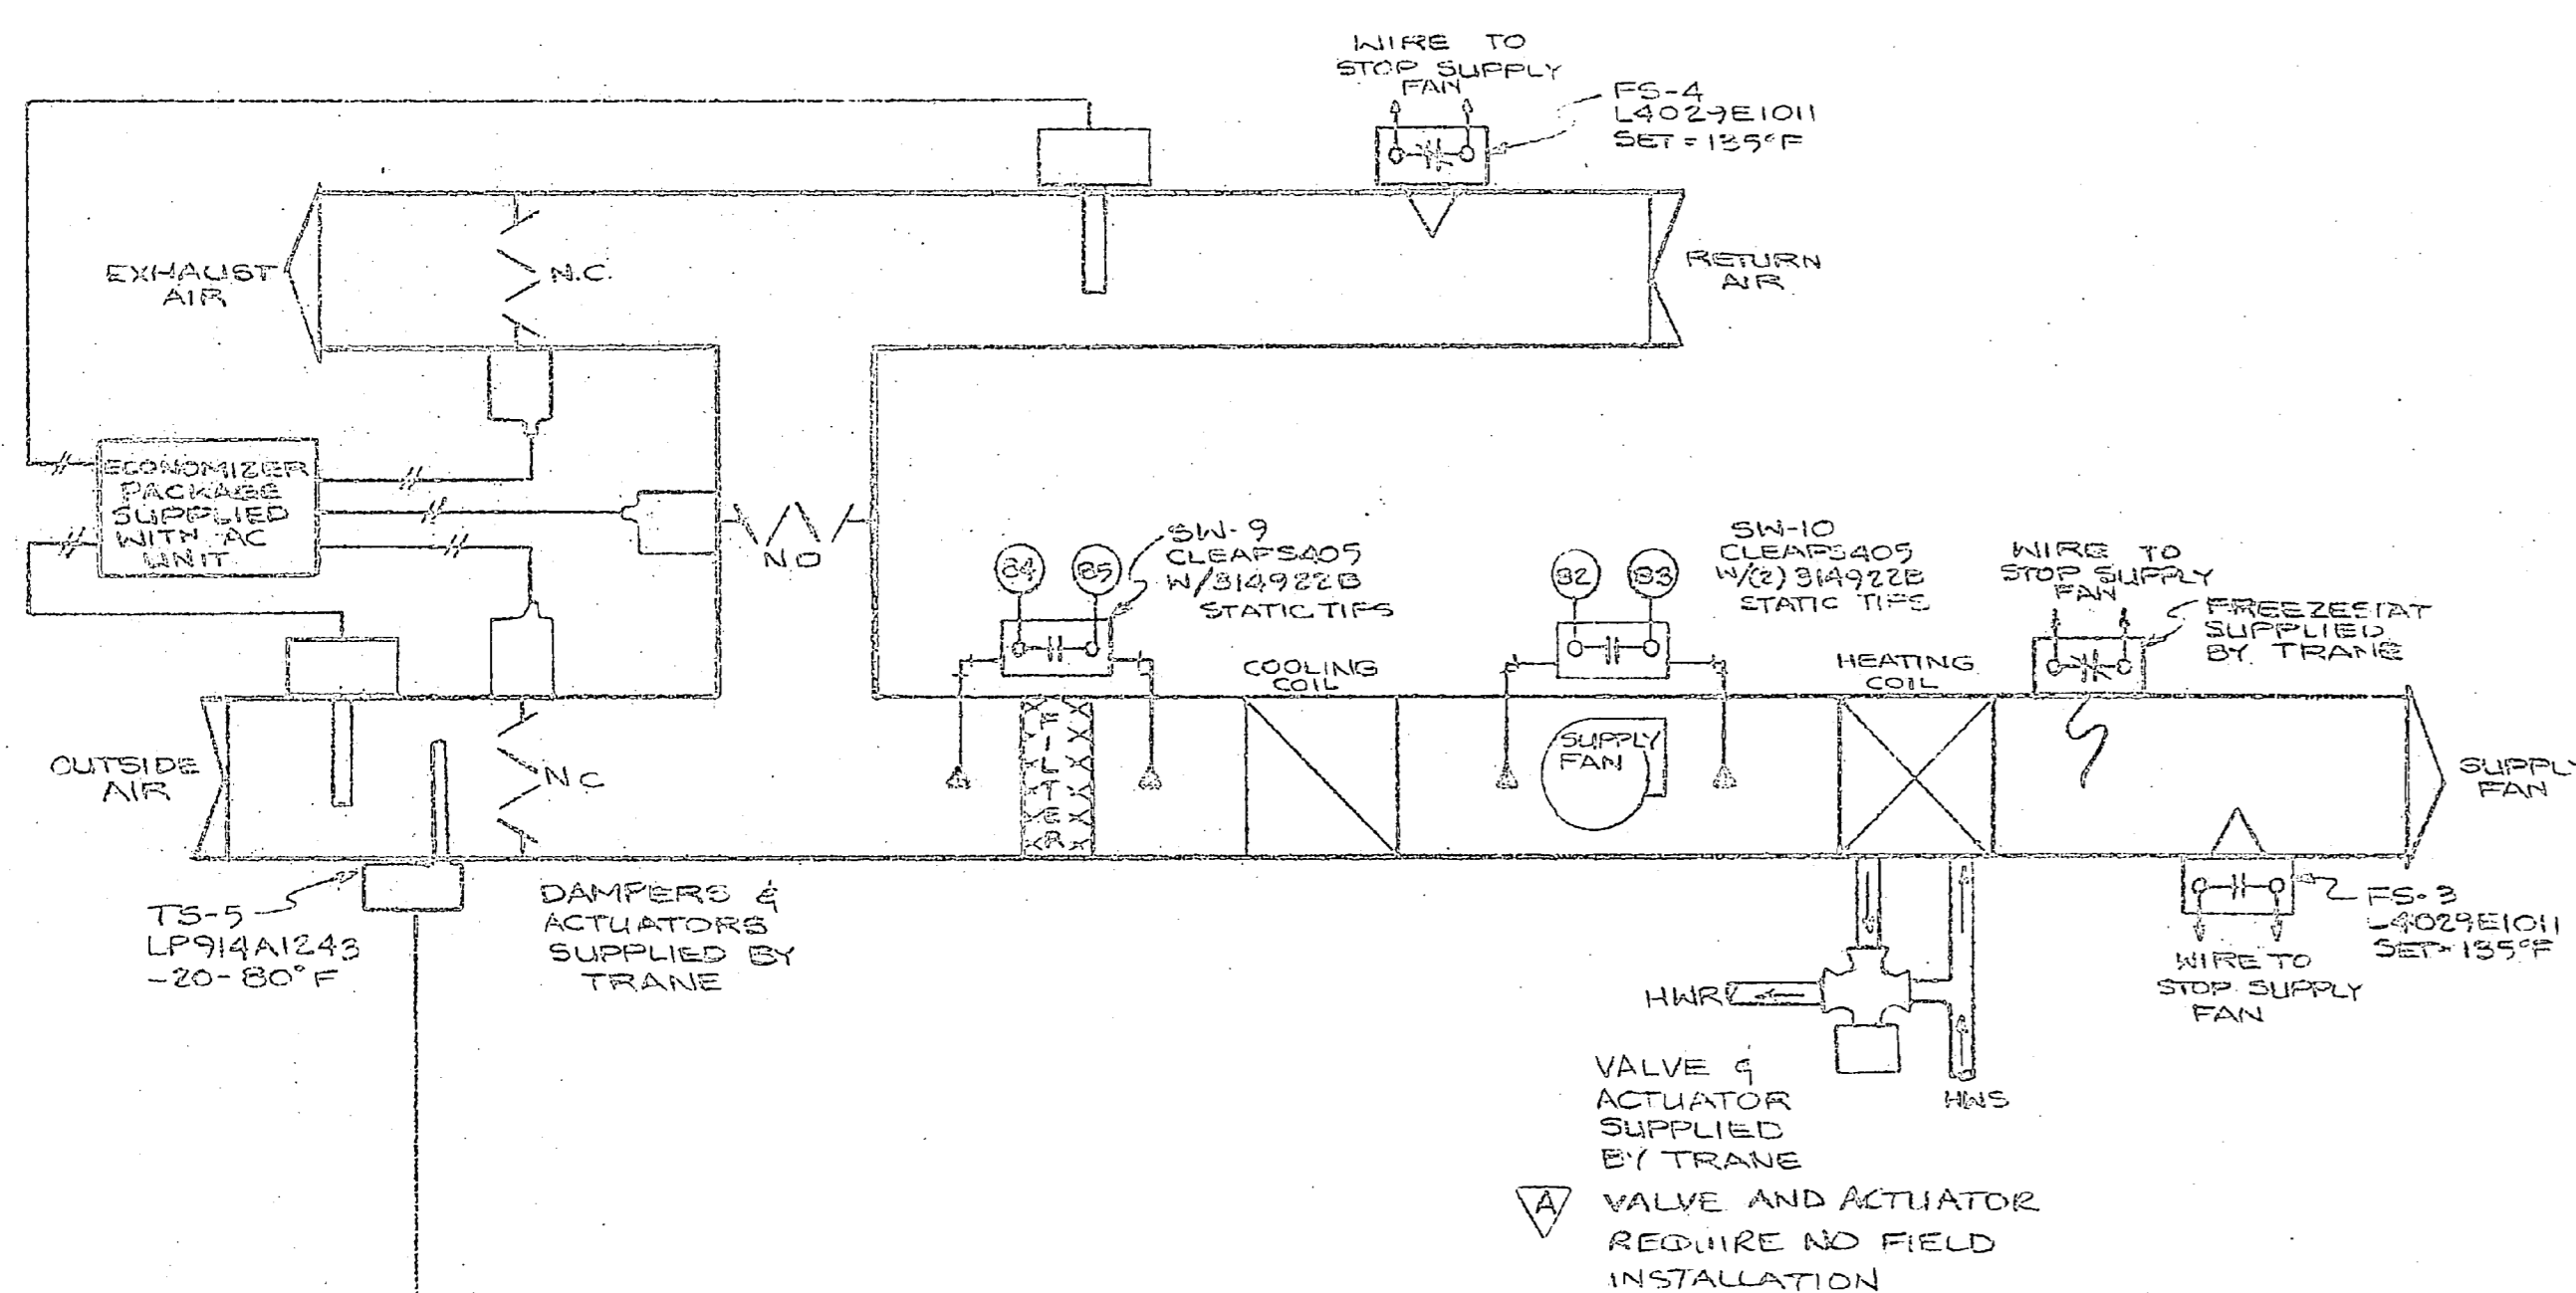


AC-2 CONTROL PANEL

- (1) 15752544-001 1/2 SIZE SUBPANEL
 - (1) 15752553-003 1/2 SIZE RING
 - (1) 15753440-001 1/2 SIZE DOOR
- MOUNT AC-2 PANEL IN RM. # 125

AC-2 CONTROLS
(TYPICAL FOR 1)

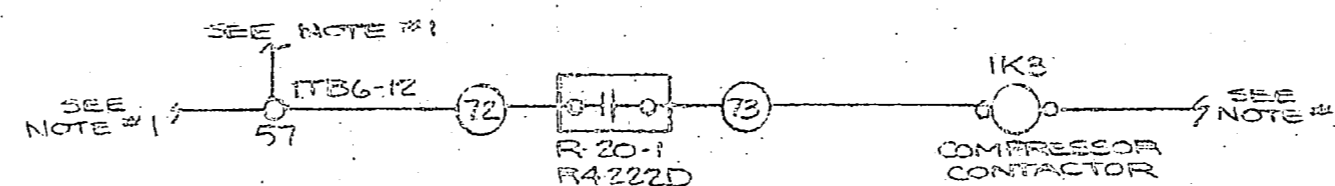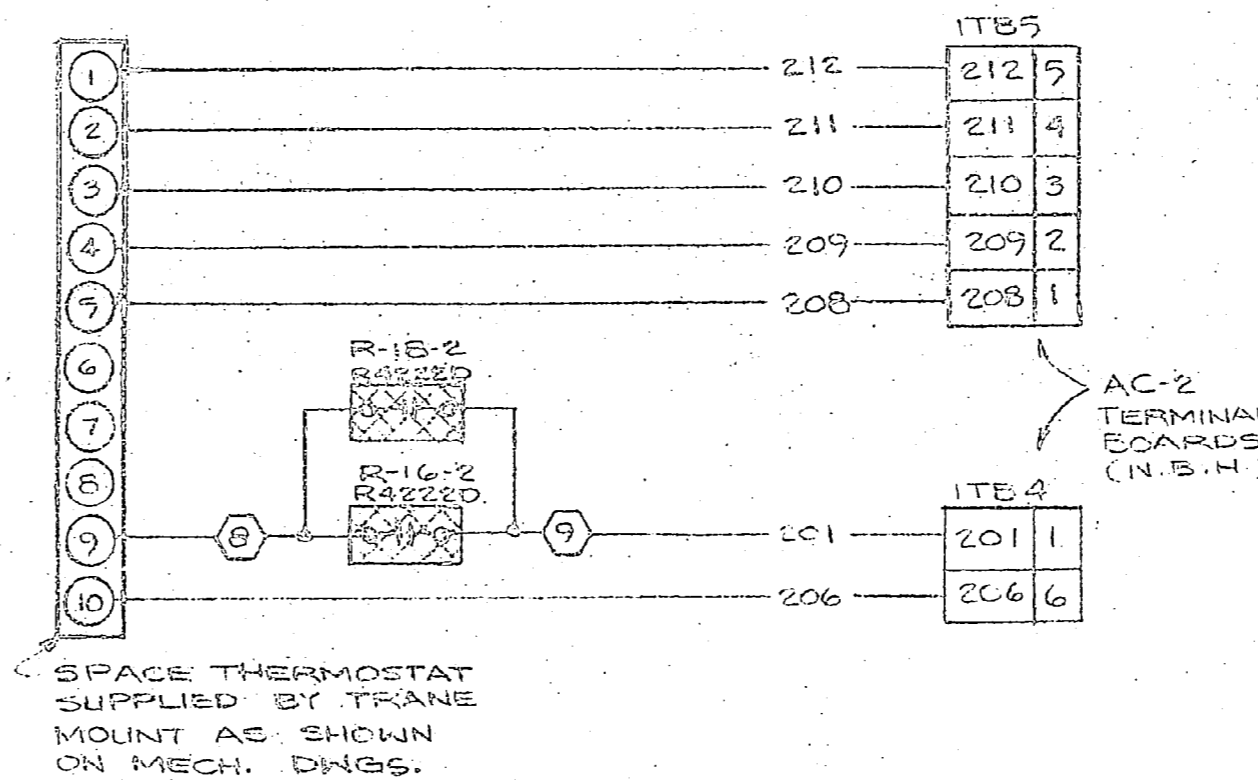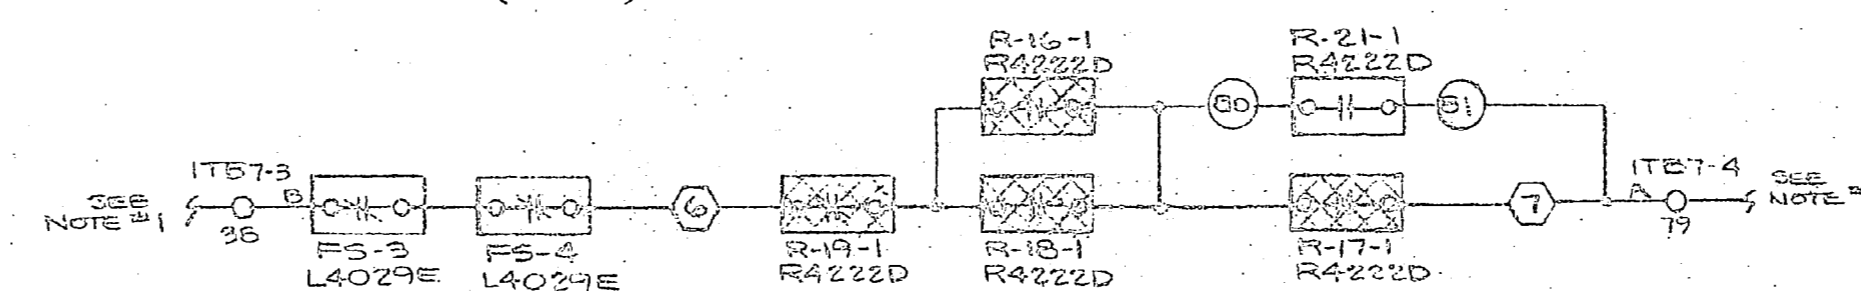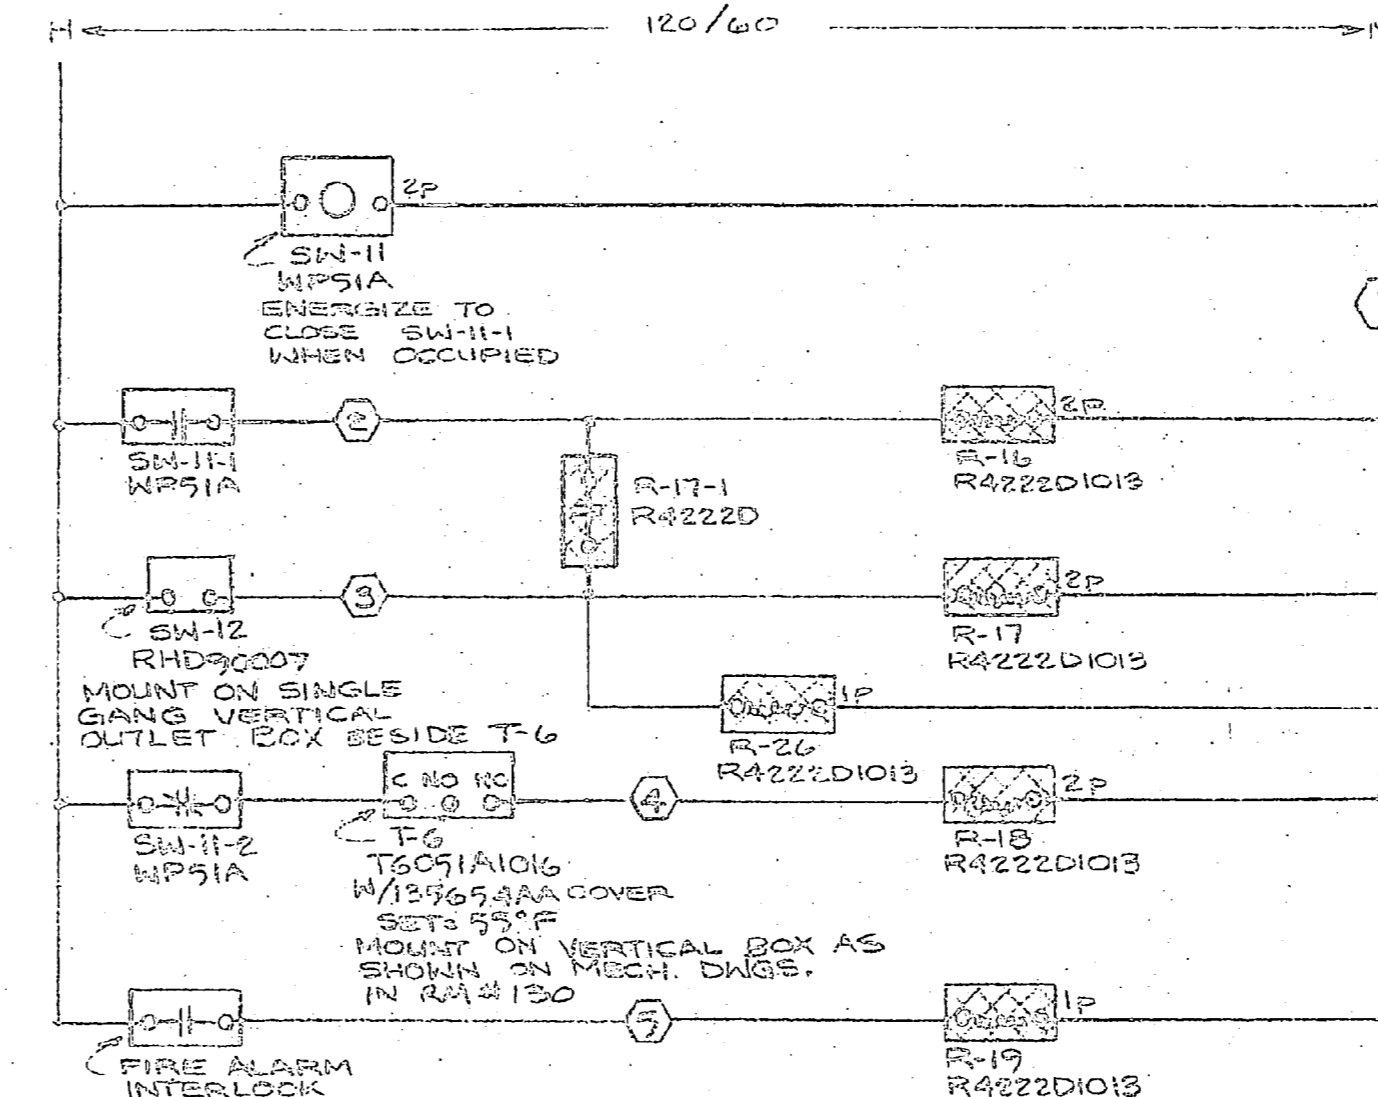

AC-2 CONTROL WIRING
(TYPICAL FOR 1)

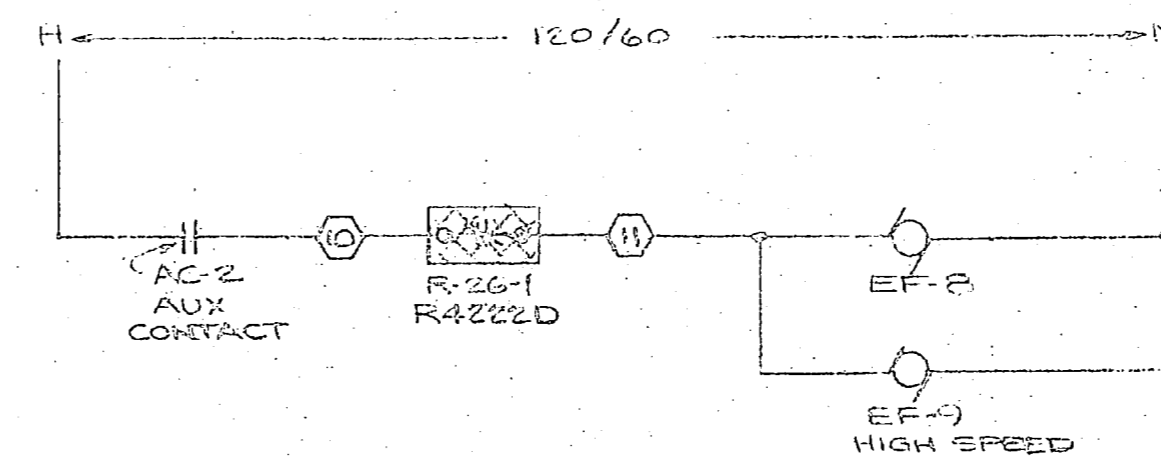

EF-8 & 9 CONTROL WIRING
(TYPICAL FOR 1)







- LEGEND:**
- (1) = TERMINAL IN AC-2 CONTROL PANEL
 - (2) = TERMINAL IN DTC PANEL
 - (3) = MOUNT IN DTC PANEL
 - (4) = MOUNT IN AC-2 CONTROL PANEL
- N.B.H. = NOT BY HONEYWELL

NOTE #1: FOR CONTINUATION SEE TRANE WIRING DIAGRAM FOR AC MODEL # SLHC-254.

**THIS IS THE LATEST REVISION
TO THIS DRAWING. DESTROY ALL
PREVIOUS ISSUES. MAY, 9 1983**


ARCHITECT: NAVAL FACILITIES
ENGINEER: NAVAL FACILITIES
CONTRACTOR: CNEEDEN, INC
APPLICATION ENGINEER: NELSON GATES

HONEYWELL, INC.		5175 SHARON AMITY RD., CHARLOTTE, N.C. 28211	
FIELD MAINTENANCE SHOP		MARINE CORPS AIR BASE	
MARINE SERVICE ROAD		CAMP LEJUNEAU, N.C.	
Supervised By	Approved By	Date	Rev.
		11-18-82	
		Sheet 3 of 6	
		DRAWING NUMBER	929-82616-3XT

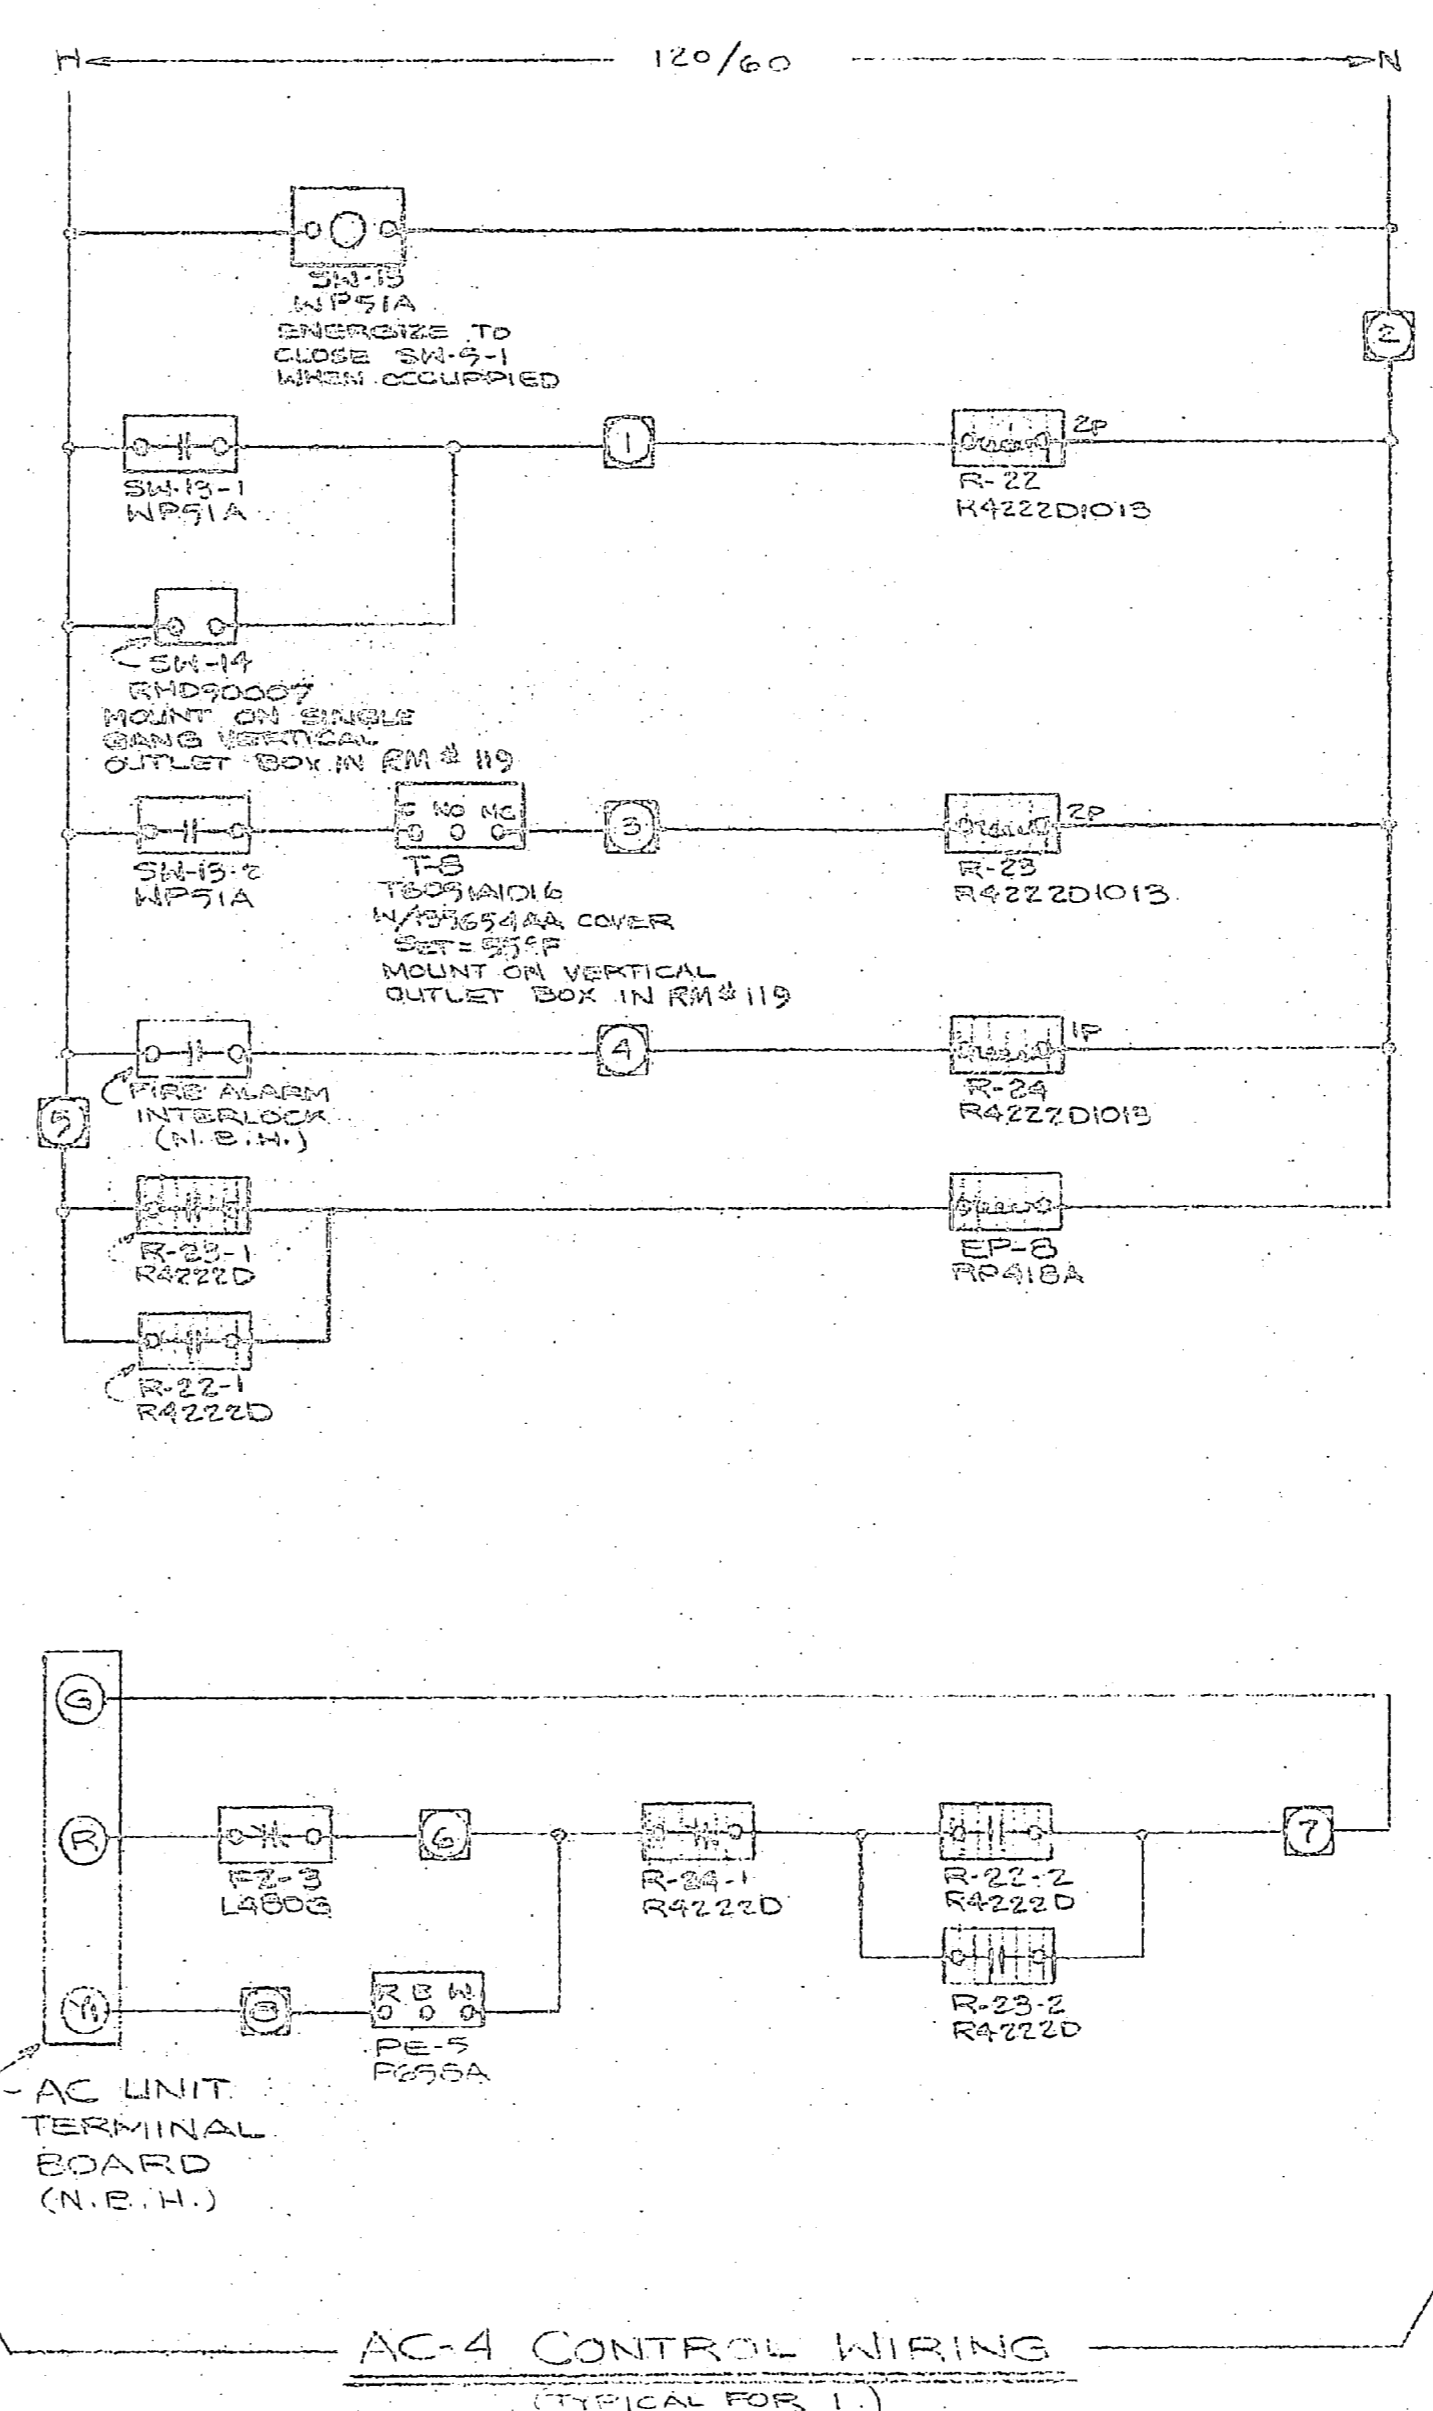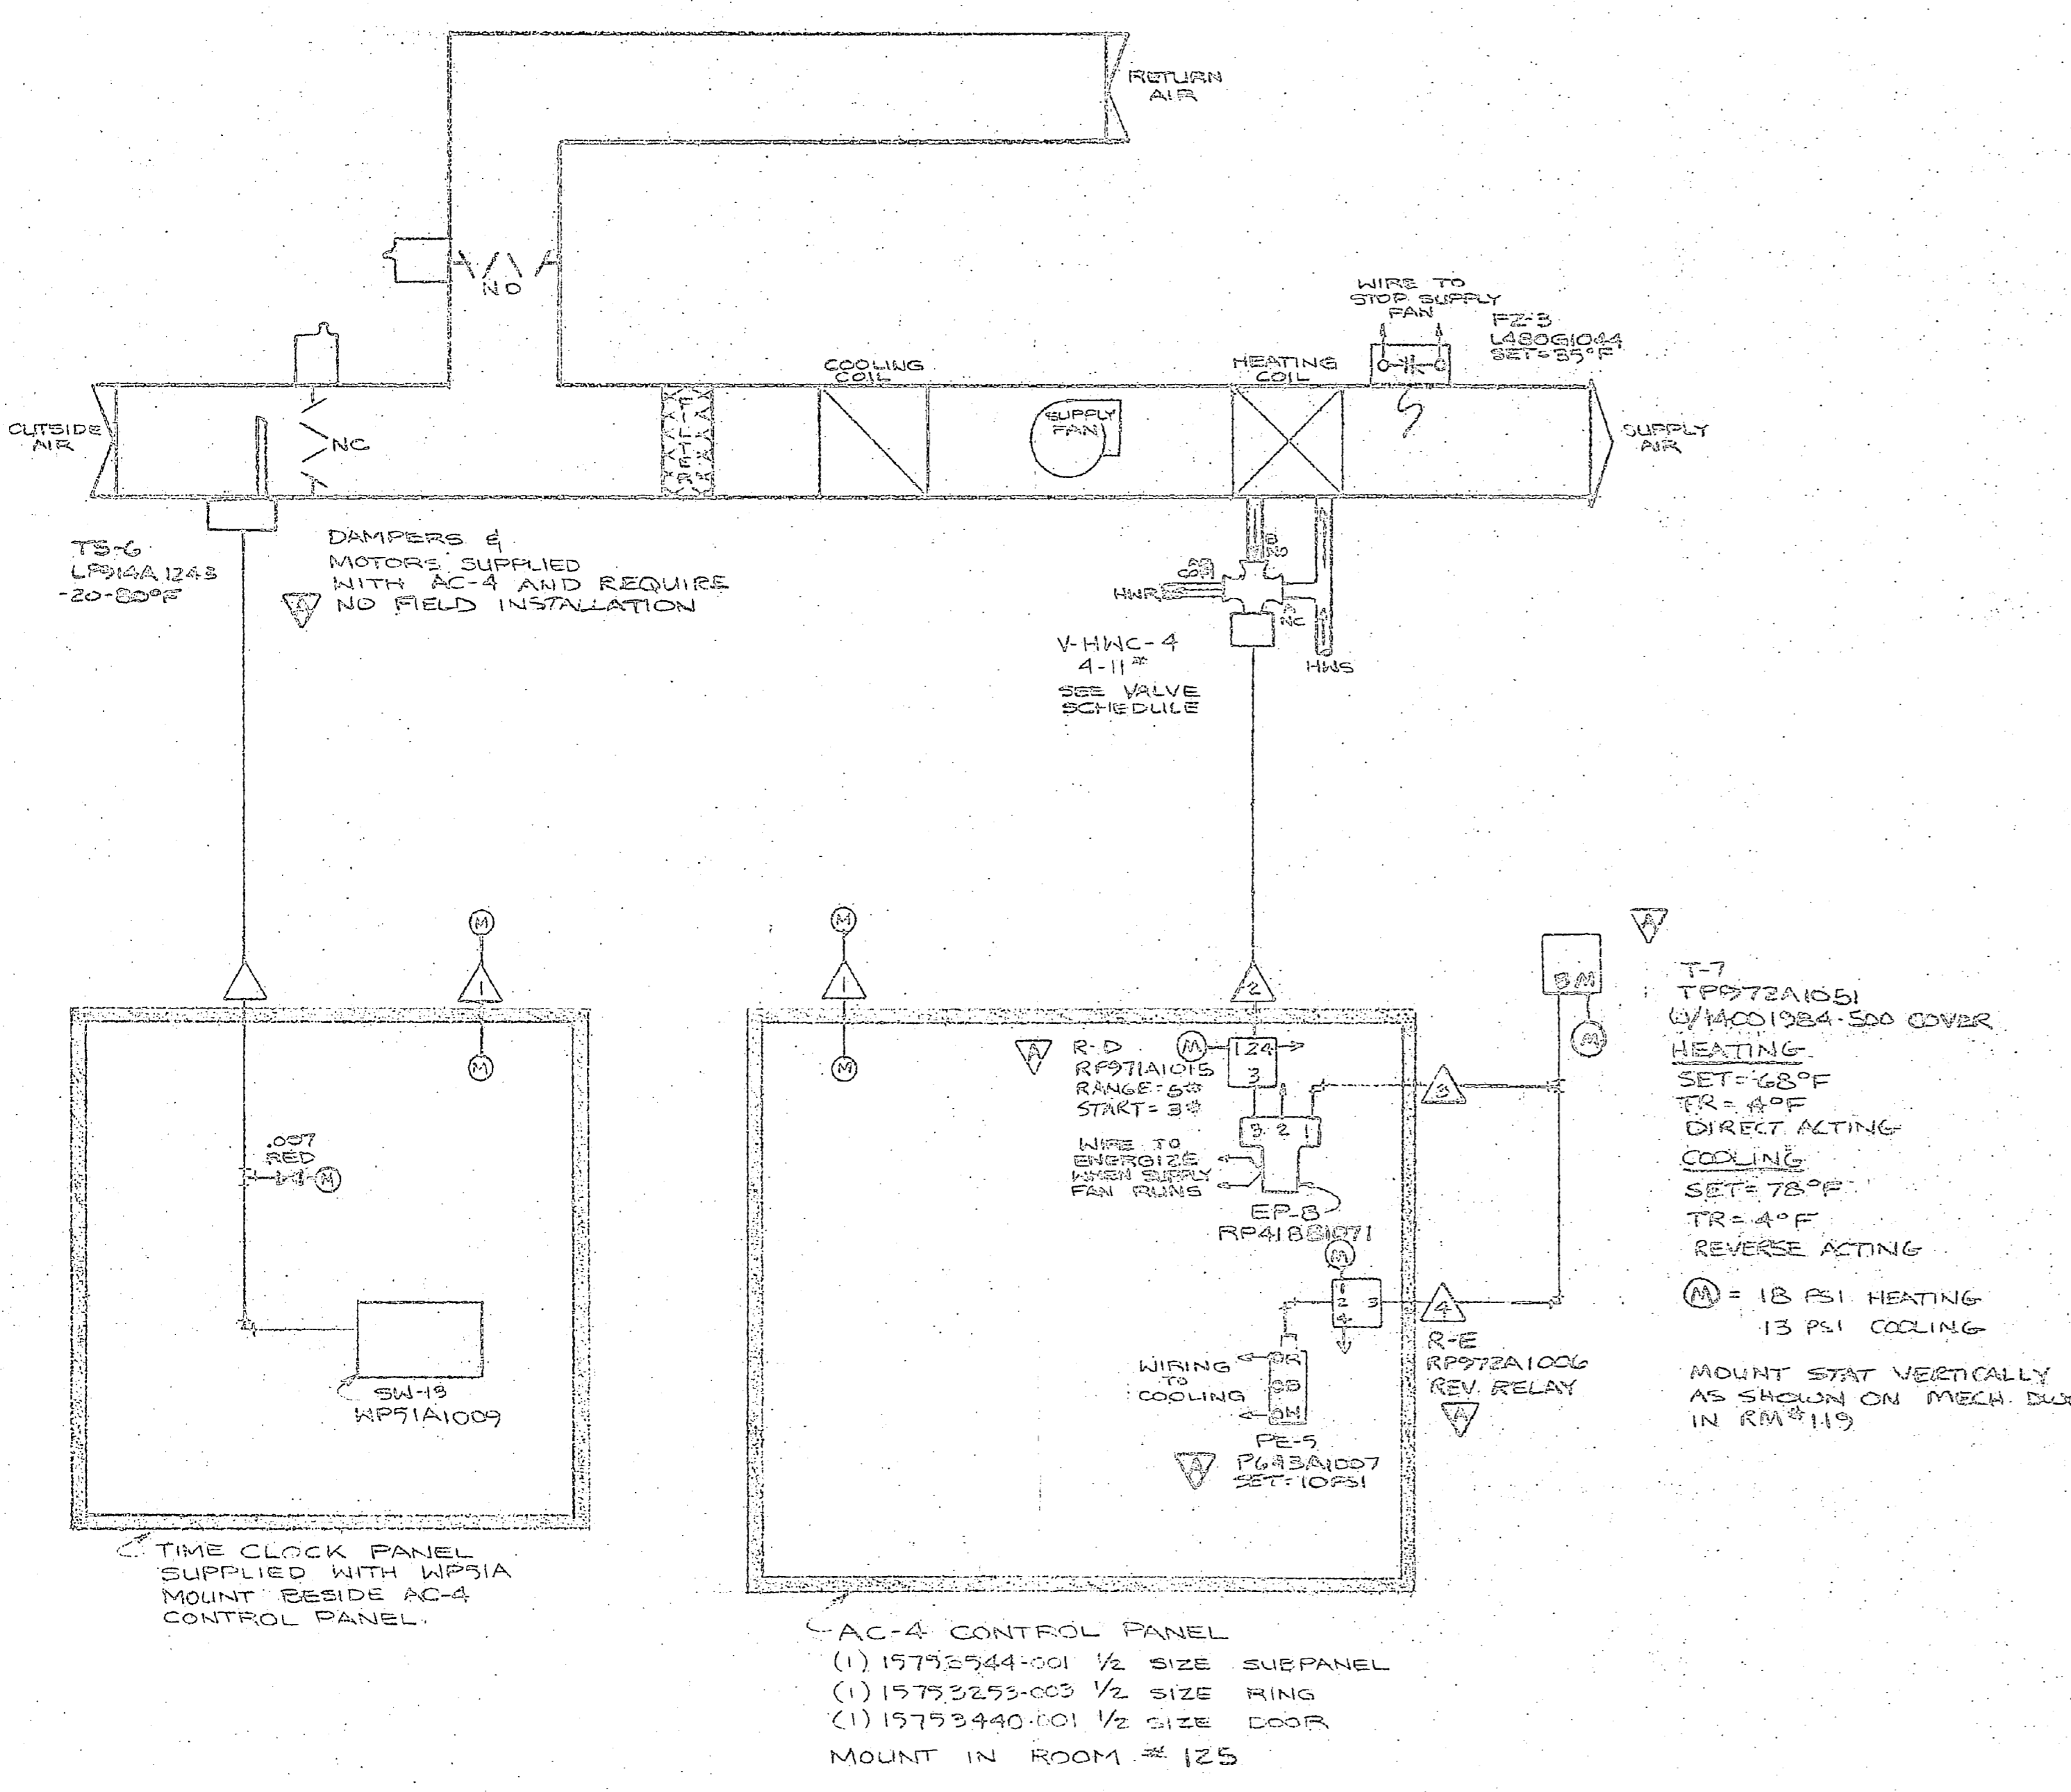



AC UNIT #	VALVE ID #	VALVE PART #	SIZE	CV	MOTOR PART #	RANGE	ACTION
AC-1	V-H K-1	V5013A1047	1/4" NPT	16 CV	MP953C1026	4-11	DA
AC-2	V-H K-2	BY TRANE	BY TRANE	BY TRANE	BY TRANE	BY TRANE	BY TRANE
AC-3	V-H G-3	V5013A1033	1" NPT	10 CV	MP953C1026	4-11	DA
AC-4	V-H K-4	V5013A1005	1/2" NPT	29 CV	MP953C1026	4-11	DA
HE-1	V-H E-1	V5011C1391	2" NPT	40 CV	MP953F1101	8-12	SA
HV-1	V-H V-1	V5011C1458	2 1/2" NPT	63 CV	MP953C1075	8-12	DA

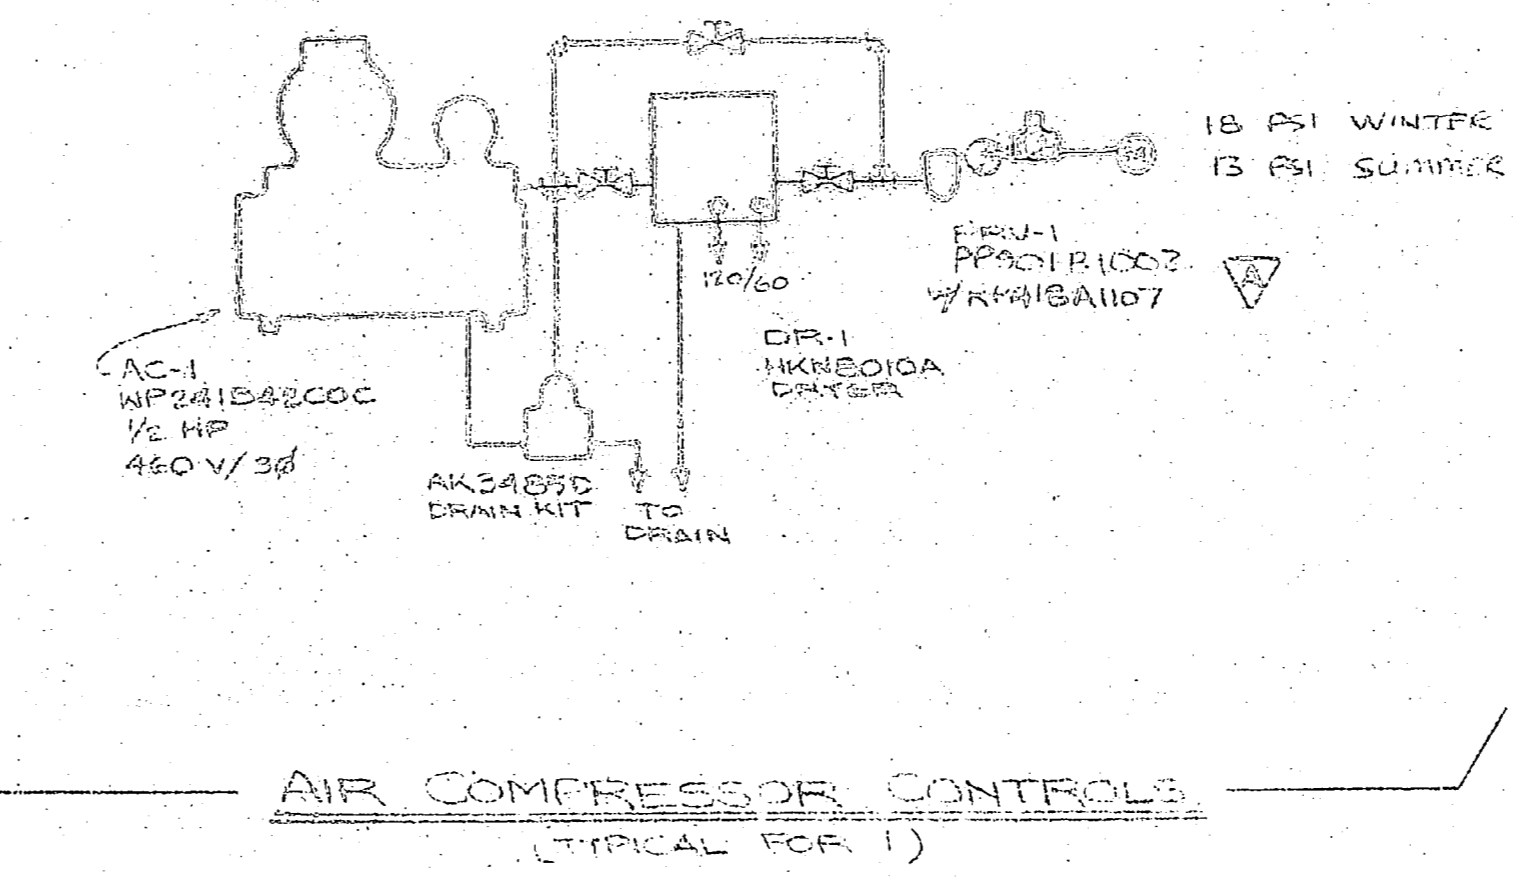

LEGEND:
 () = TERMINAL IN AC-4 CONTROL PANEL
 [] = MOUNT IN AC-1 CONTROL PANEL
 N.E.H. = NOT BY HONEYWELL

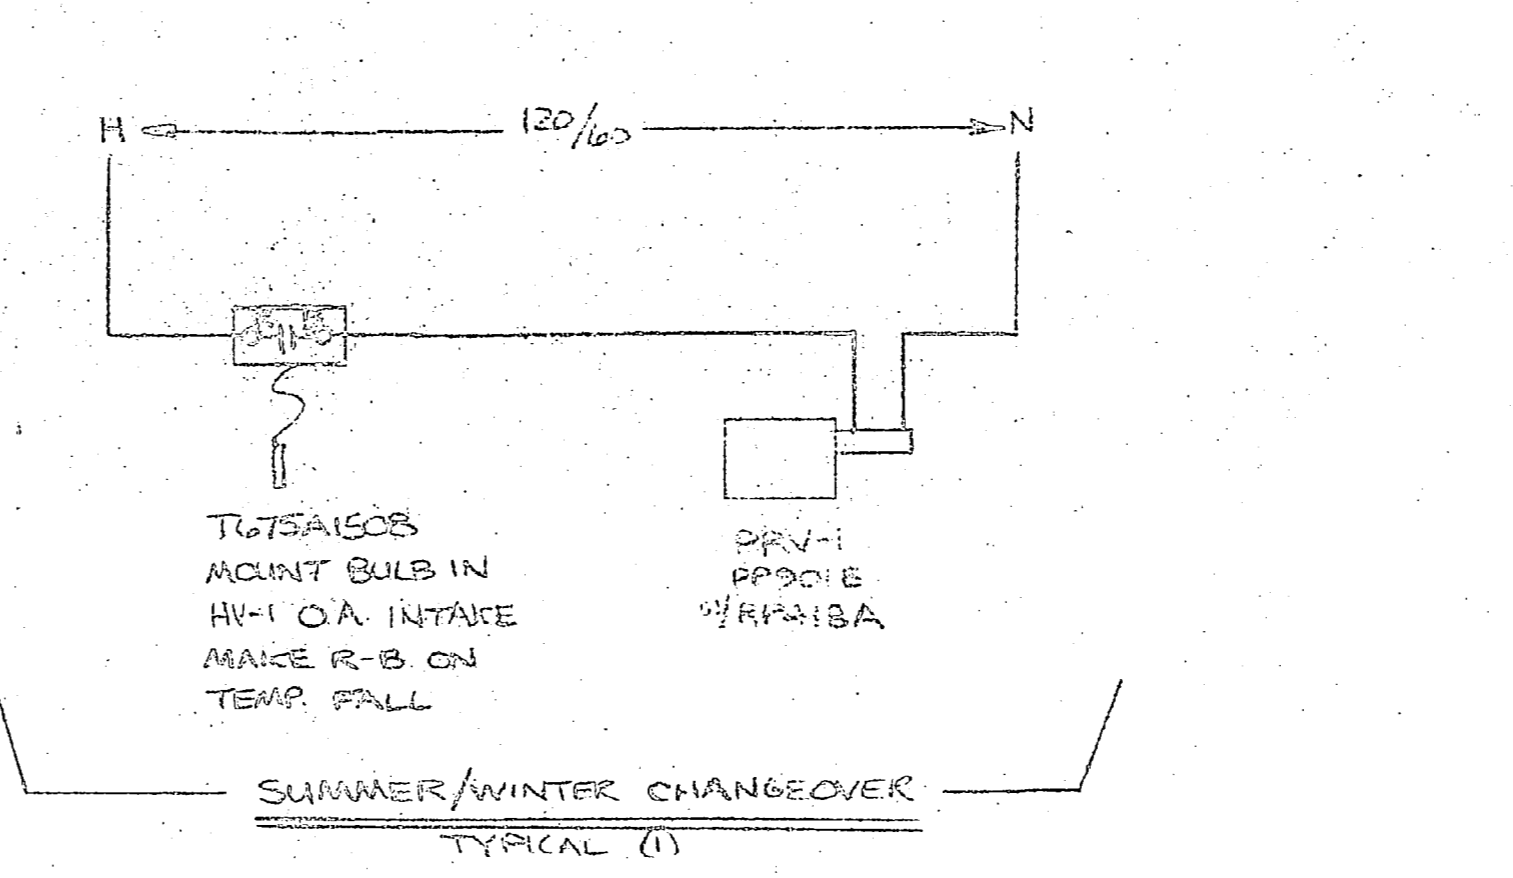


THIS IS THE LATEST REVISION TO THIS DRAWING, DESTROY ALL PREVIOUS ISSUES.

ARCHITECT: NAVAL FACILITIES
 ENGINEER: NAVAL FACILITIES
 CONTRACTOR: SNEEDEN, INC.
 APPLICATION ENGINEER: NELSON GATES

HONEYWELL, INC.		197 S. CHARLTON AVENUE RD., CHARLOTTE, N.C. 28211	
FIELD MAINTENANCE SHOP		MARINE CORPS AIR BASE	
CAMP LEJEUNE, N.C.		MAIN SERVICE ROAD	
Supervisor	Drawn By	Date	Scale
Approved By	Checked By	Drawn By	Scale


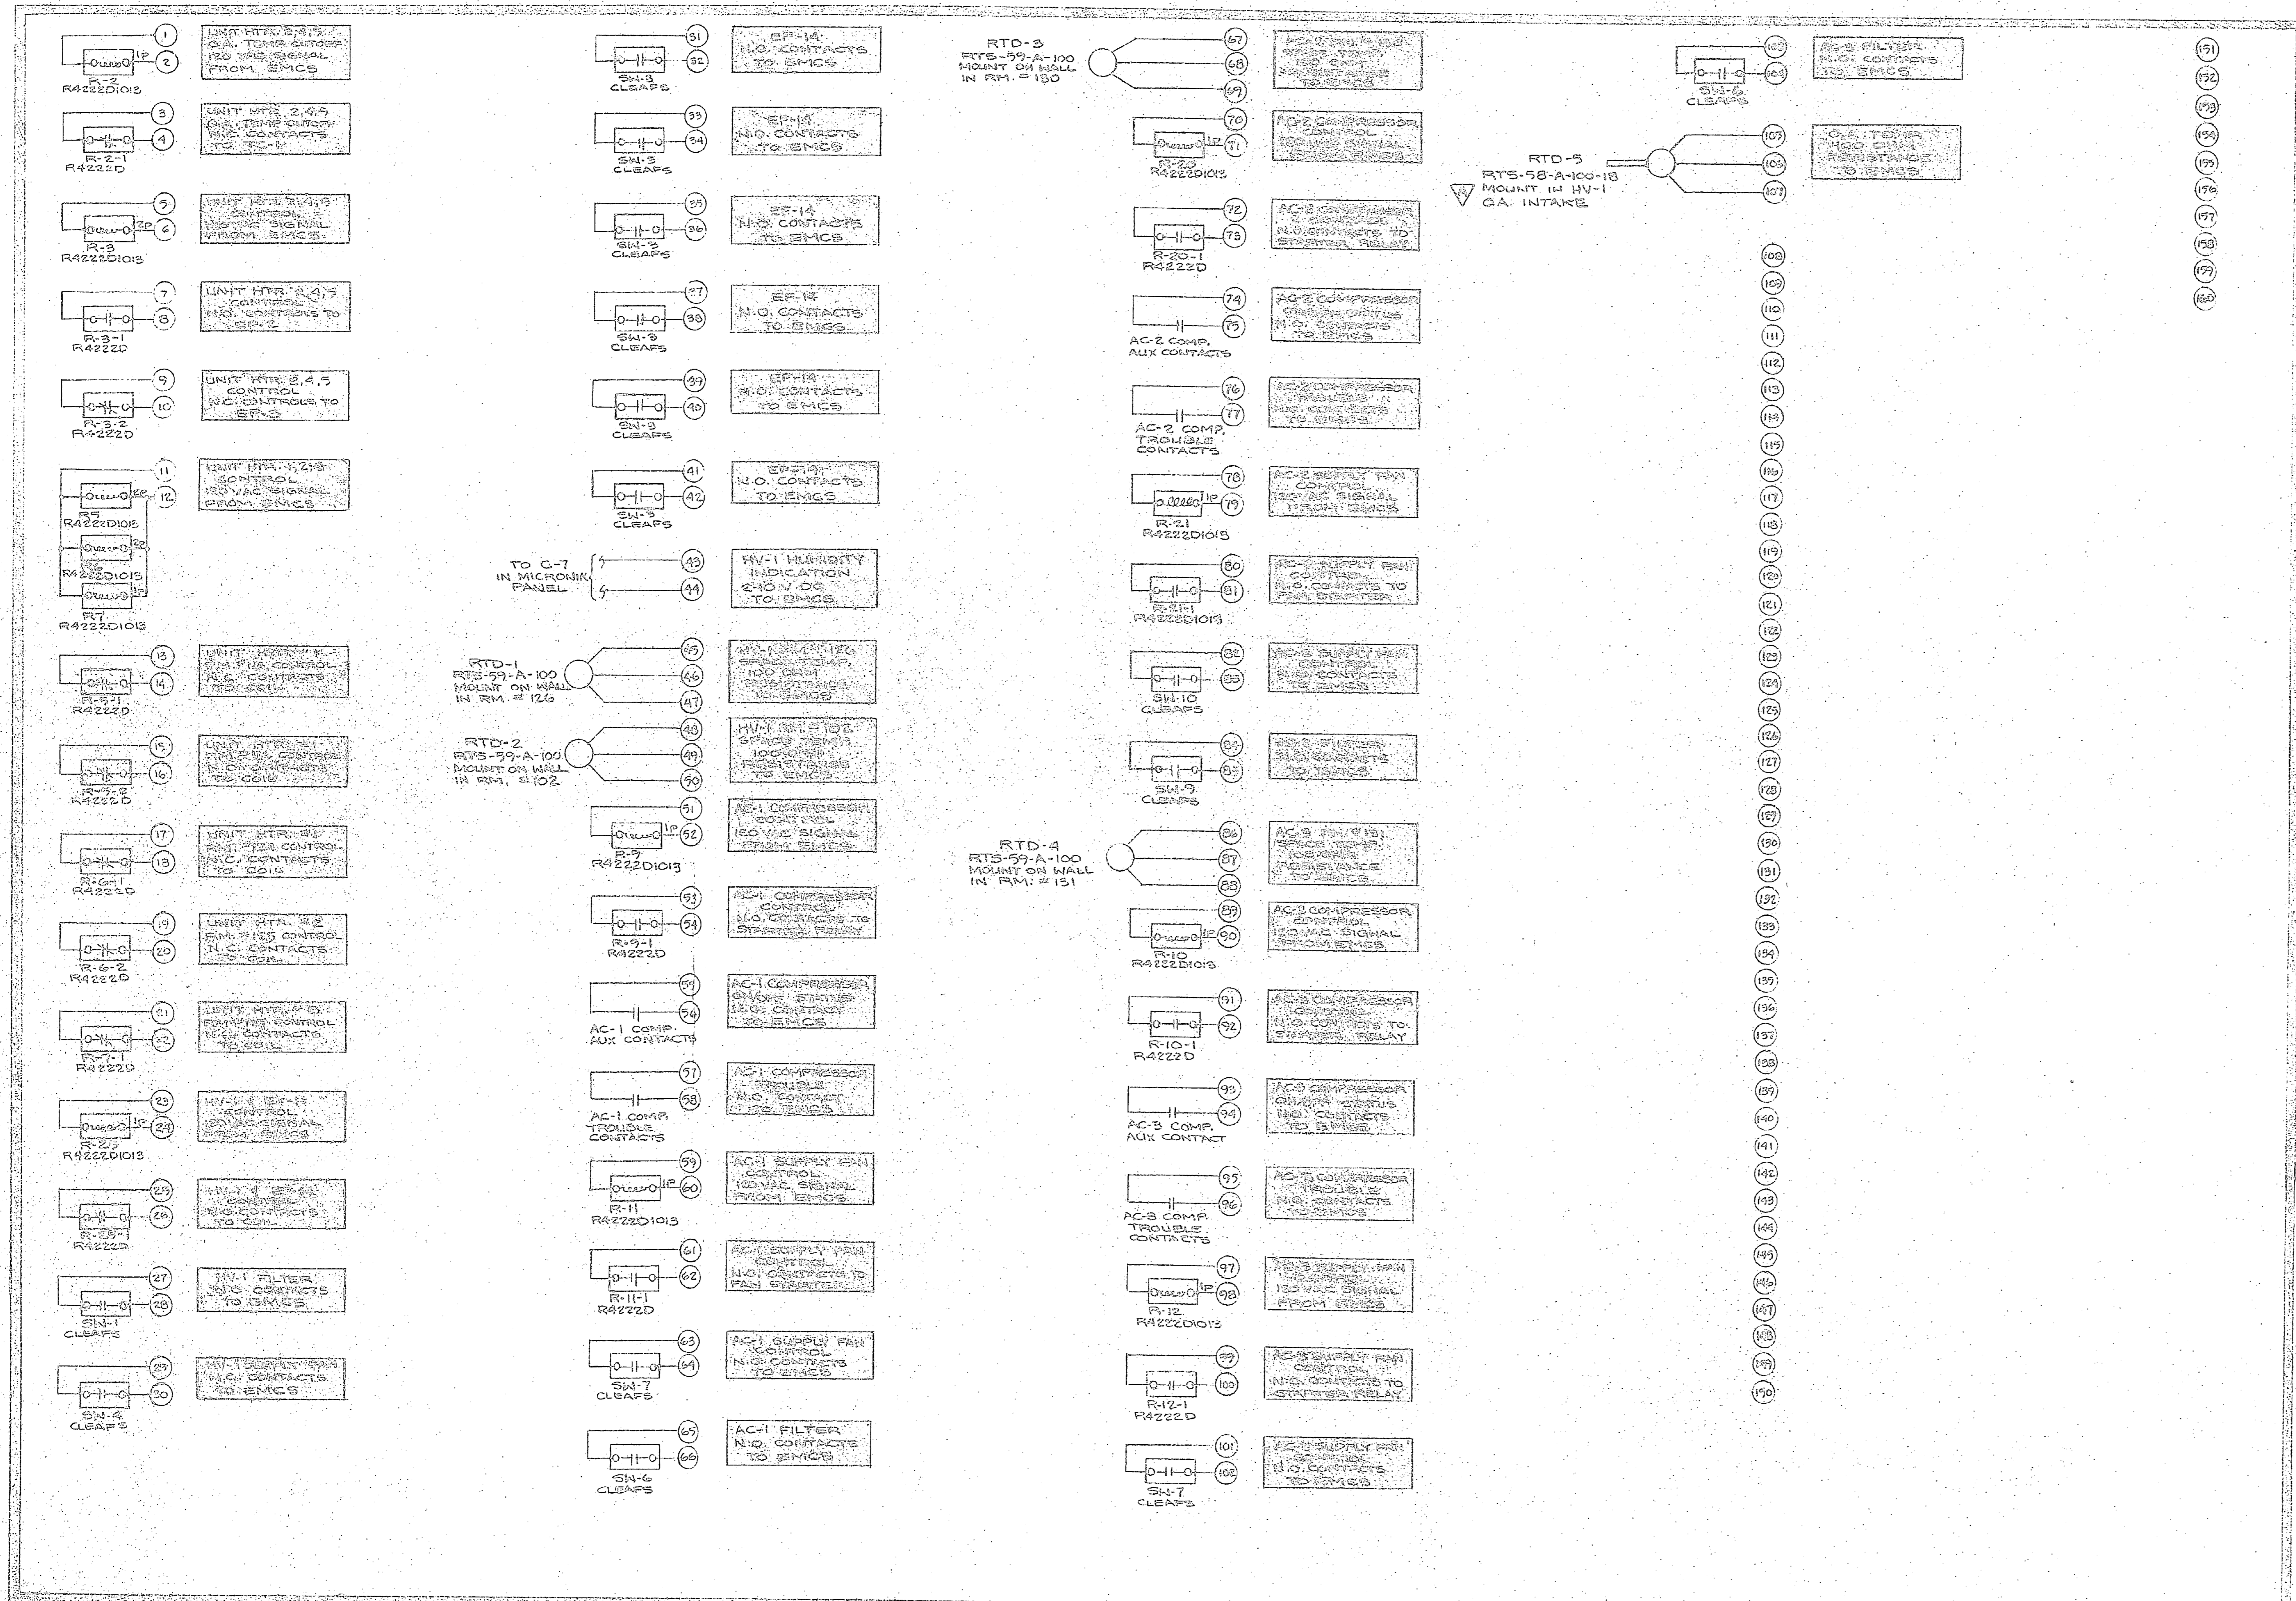

LEGEND:
 (C) = TERMINAL IN DTC PANEL
 (M) = MOUNT IN DTC PANEL

DTC CONTROL PANEL
 (1) 1575244-003 FULL SIZE SUBPANEL
 (1) 1575253-004 FULL SIZE RING
 (1) 1575240-002 FULL SIZE DOOR
 (1) 1575244-001 1/2 SIZE SUBPANEL
 (1) 1575253-003 1/2 SIZE RING
 (1) 1575240-001 1/2 SIZE DOOR












MOUNT IN ROOM # 125

THIS IS THE LATEST REVISION TO THIS DRAWING, DESTROY ALL PREVIOUS ISSUES. MAY 9 1963

ARCHITECT: NAVAL FACILITIES
 ENGINEER: NAVAL FACILITIES
 CONTRACTOR: SNEDECOR, INC.
 APPLICATION ENGINEER: NELSON GATES

HONEYWELL INC.				
C				5175 SHARON AVENUE RD., CHARLOTTE, N.C. 28211
B				
A	LOCATED RTD-5	1/18/63	CNC	FIELD MAINTENANCE SHOP
Region		Date	Appd.	MAIN SERVICE ROAD
Supervised by	Drawn By: P. H. H.	Date: 11-19-62		CAMP LEJUNE, N.C.
Supervised by	Approved by: C. H.	Sheet 5 of 6	DRAWING NUMBER 929-82616-5XI	


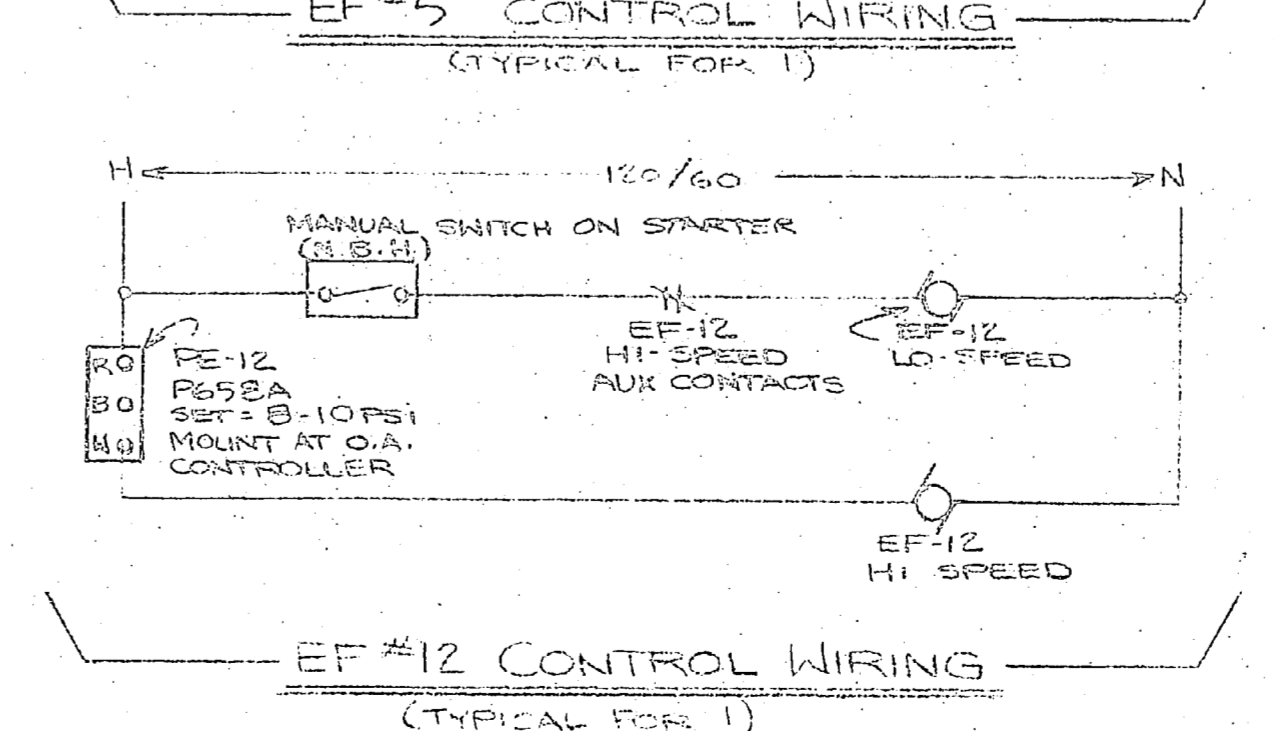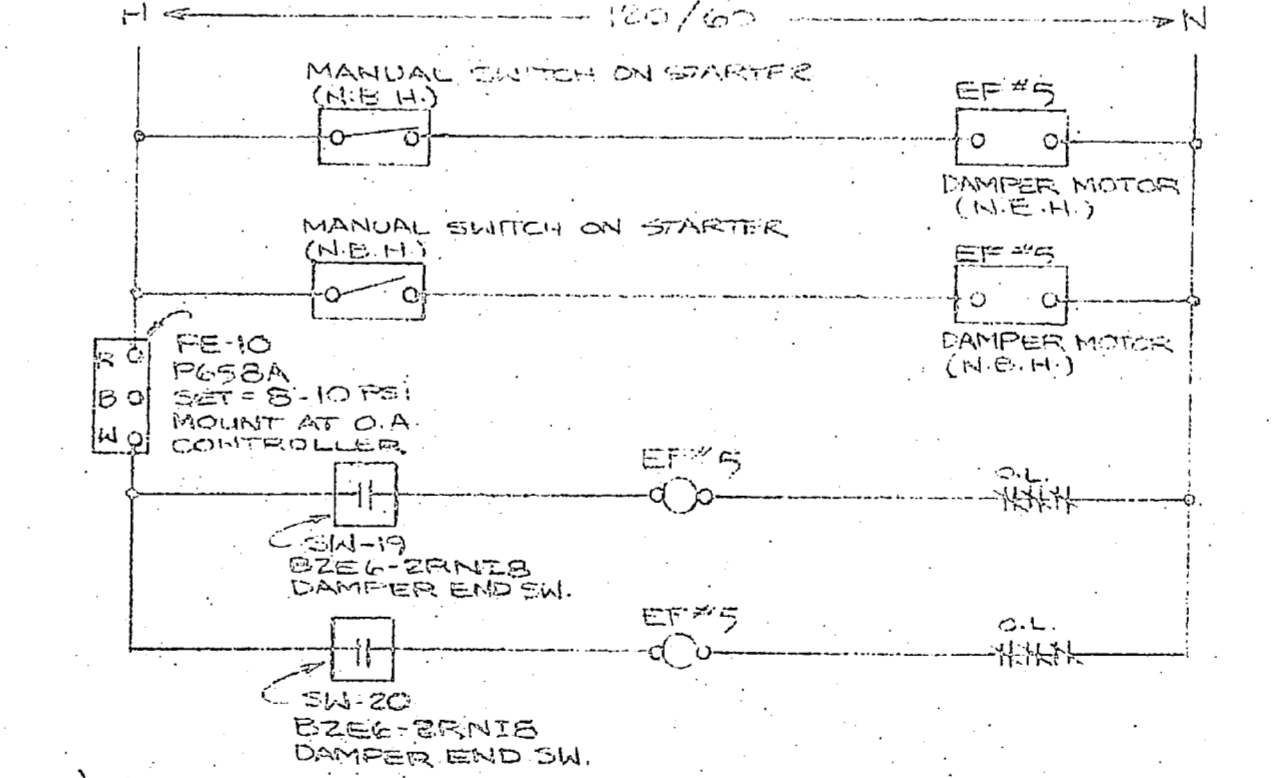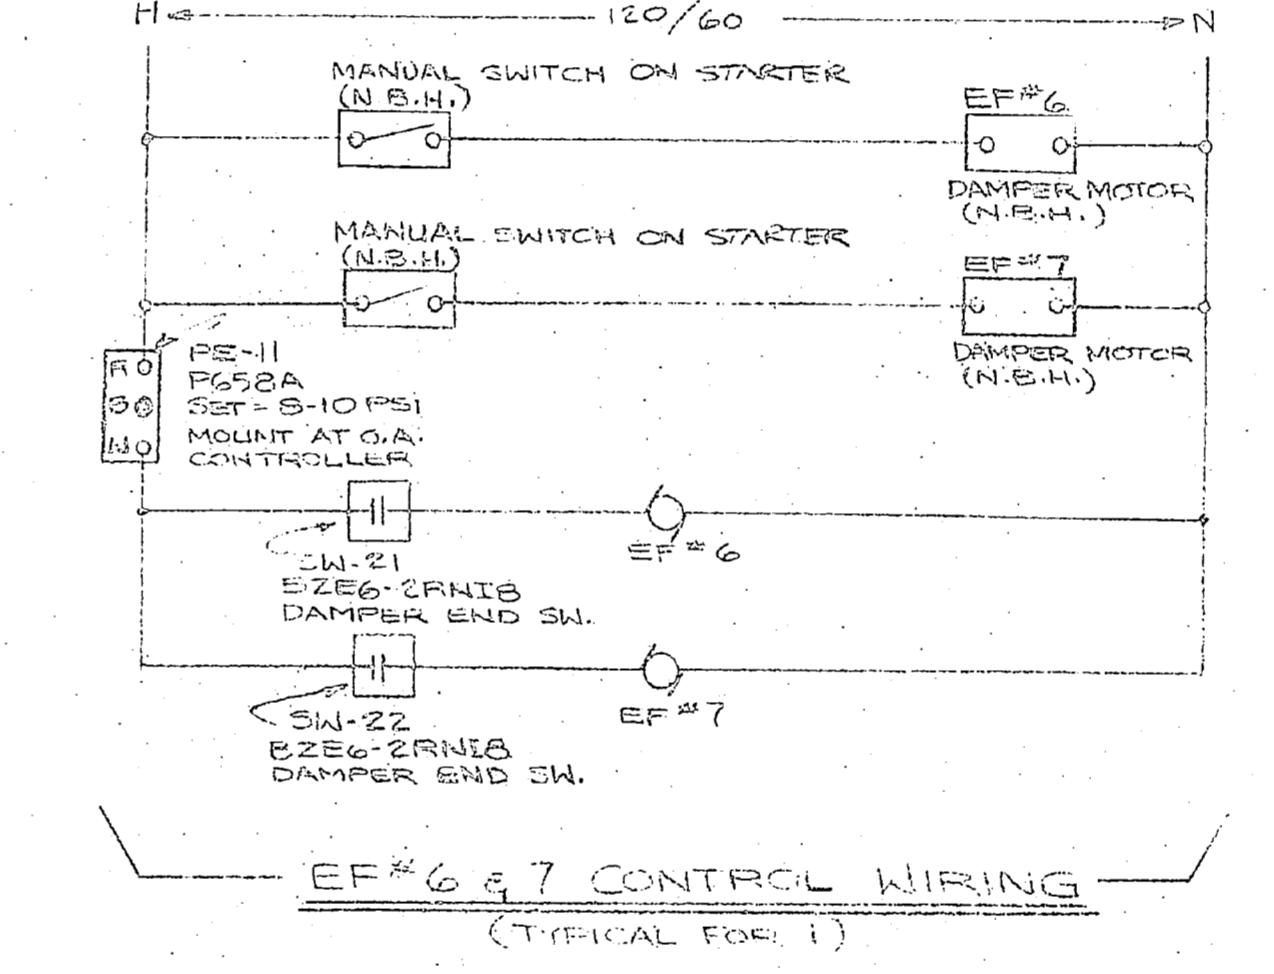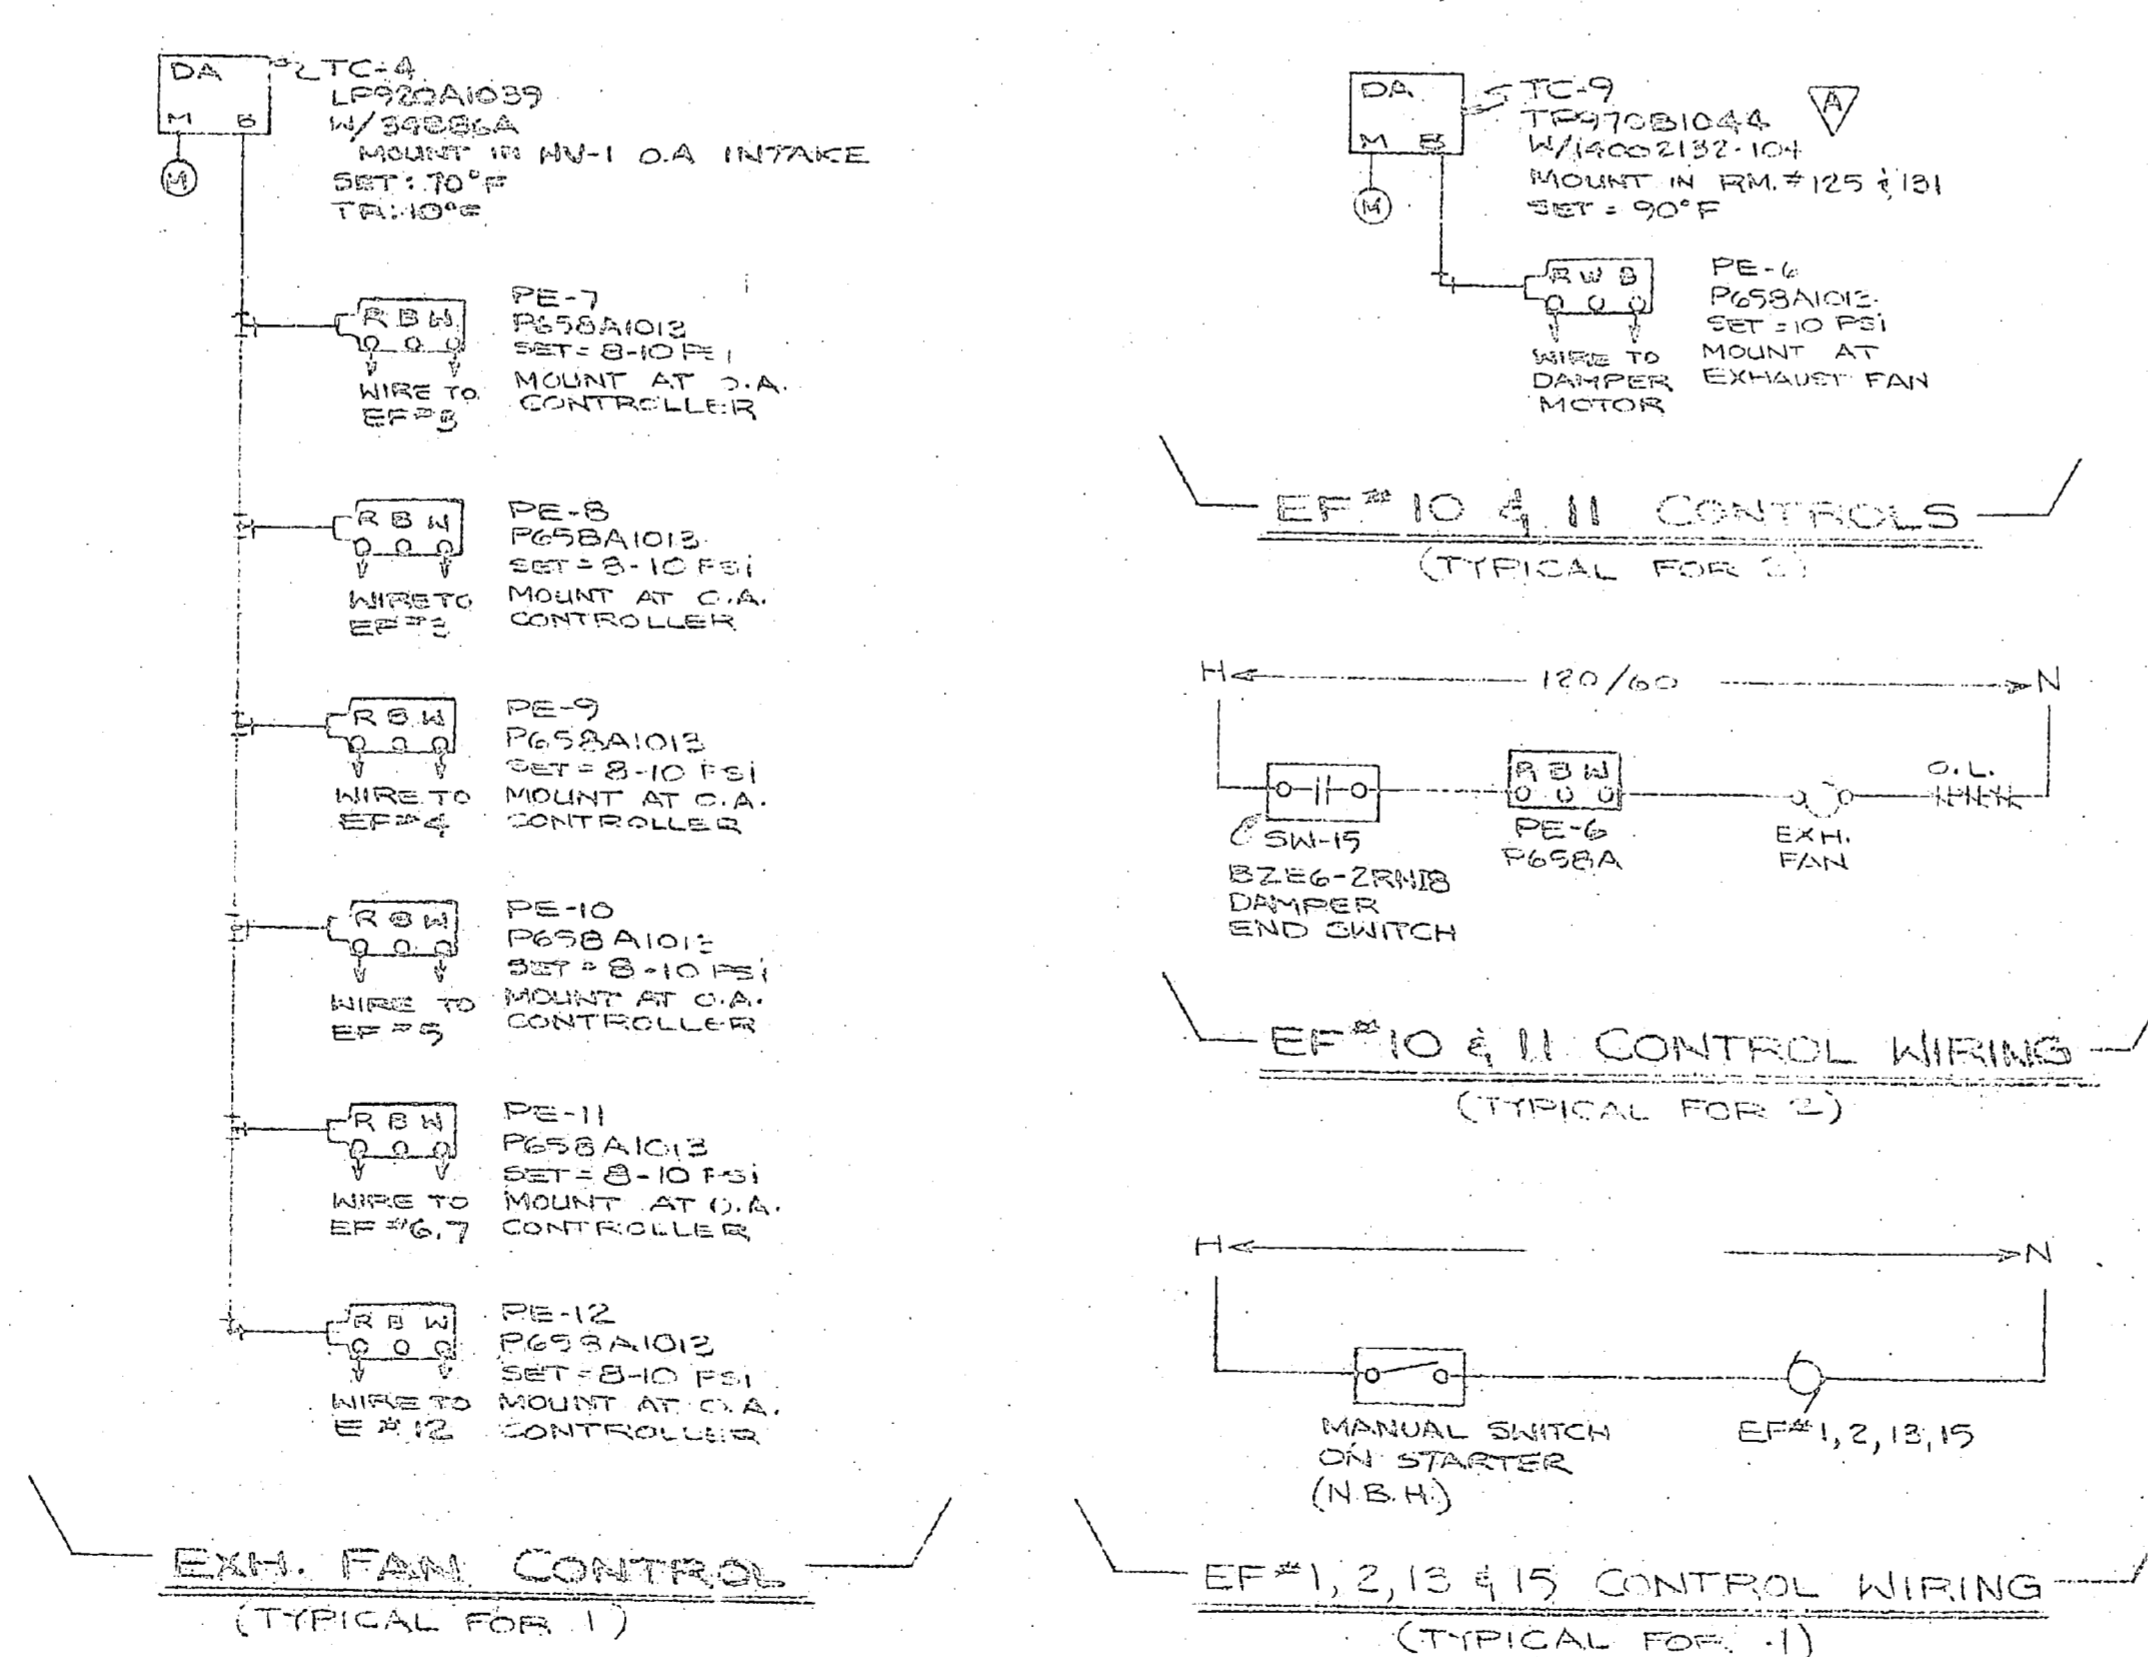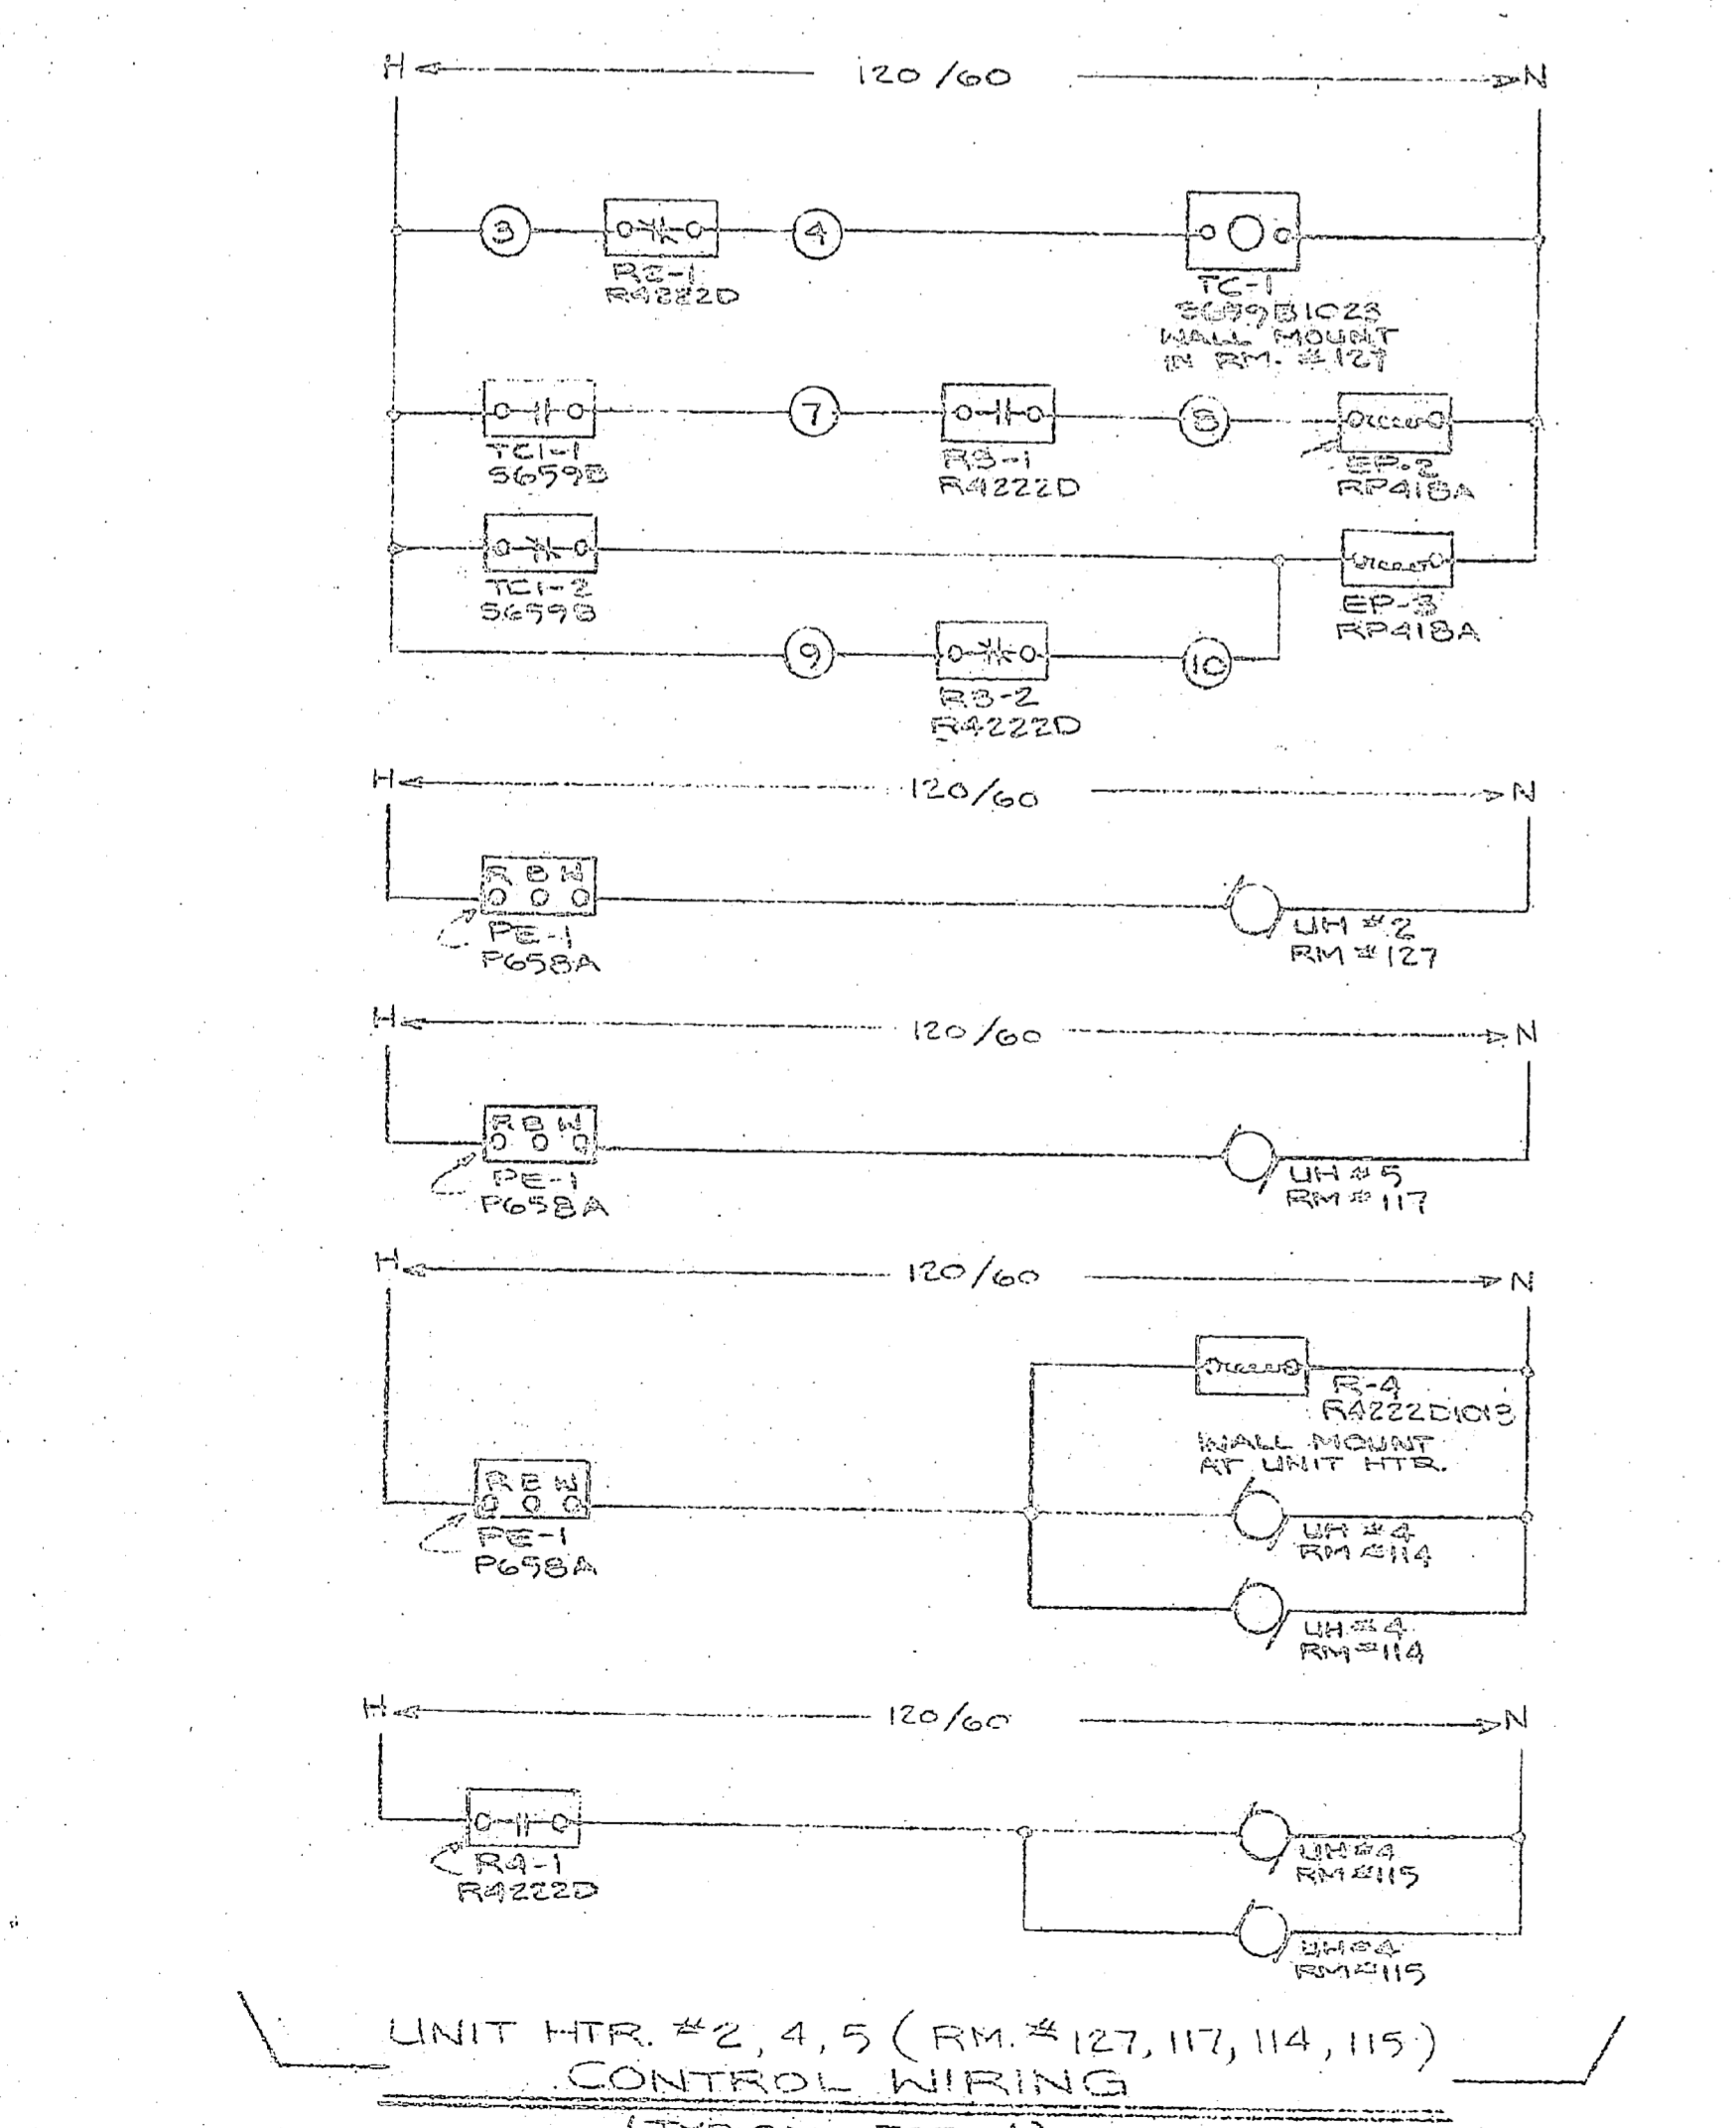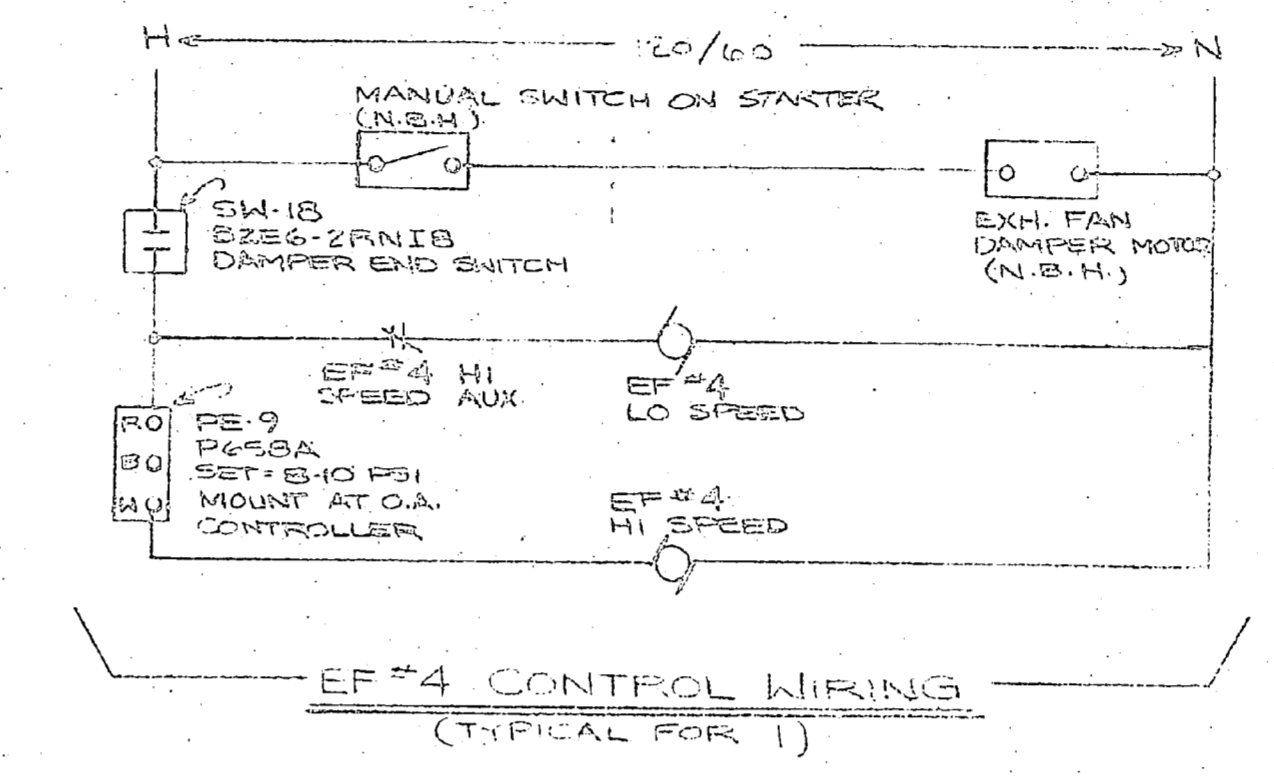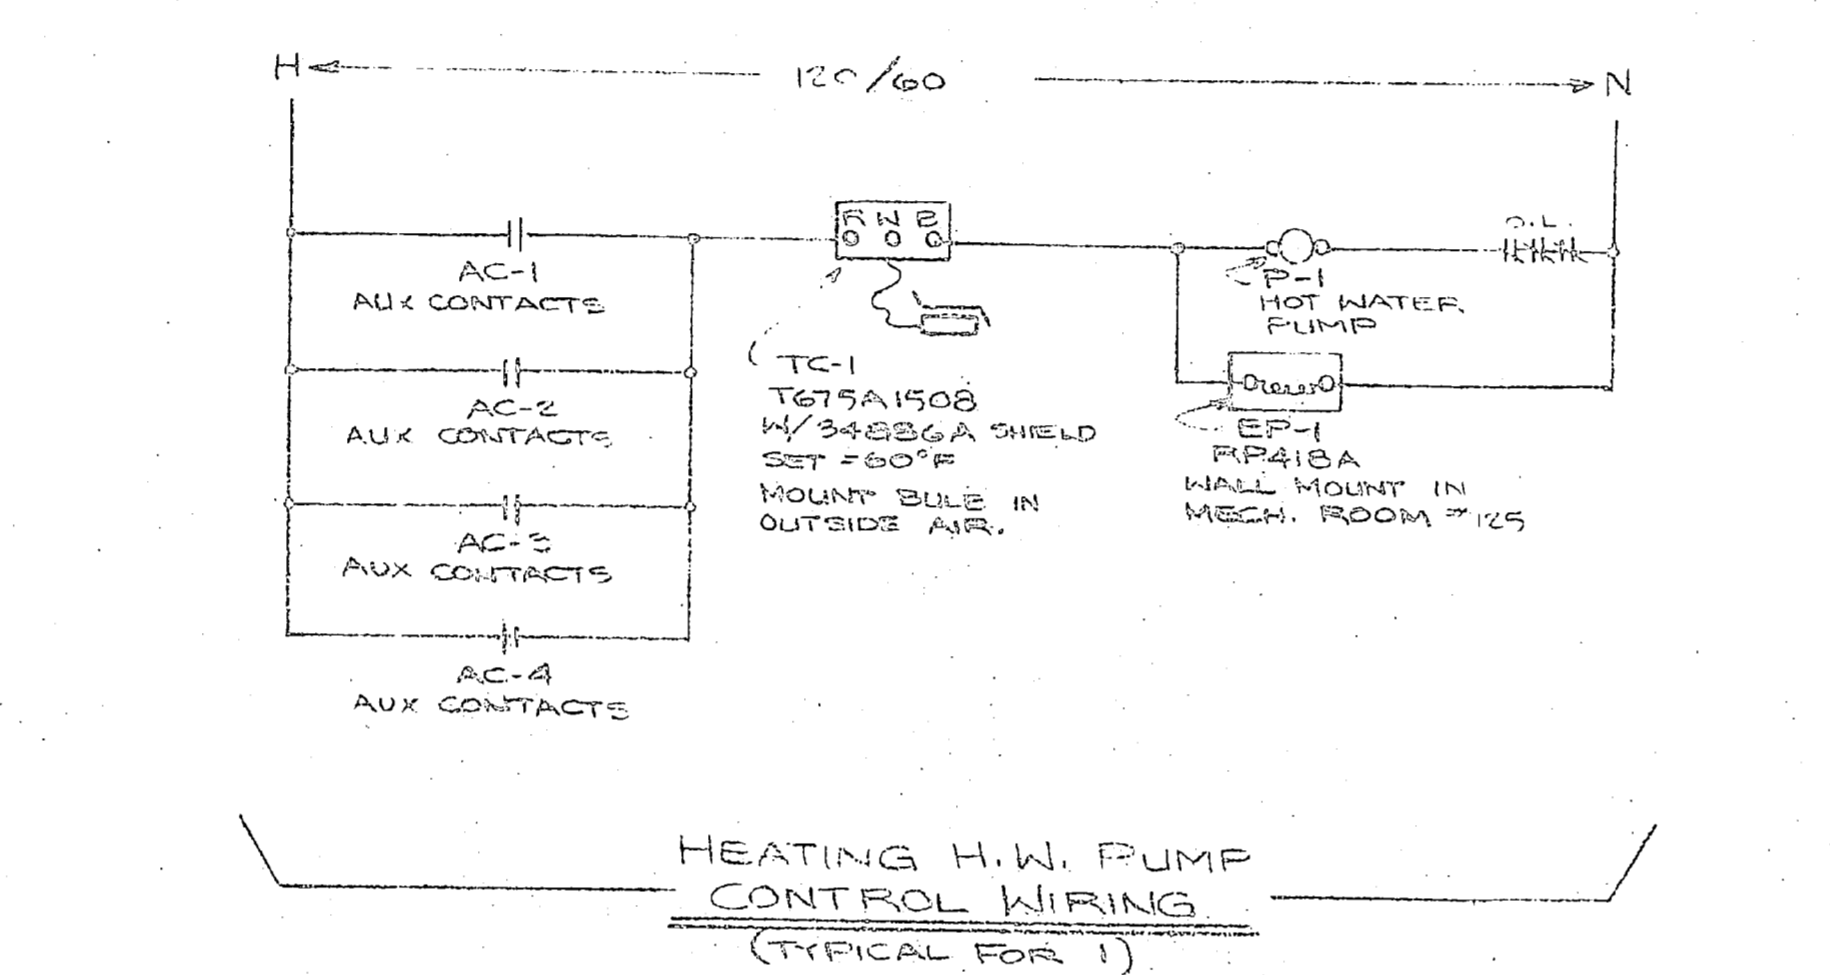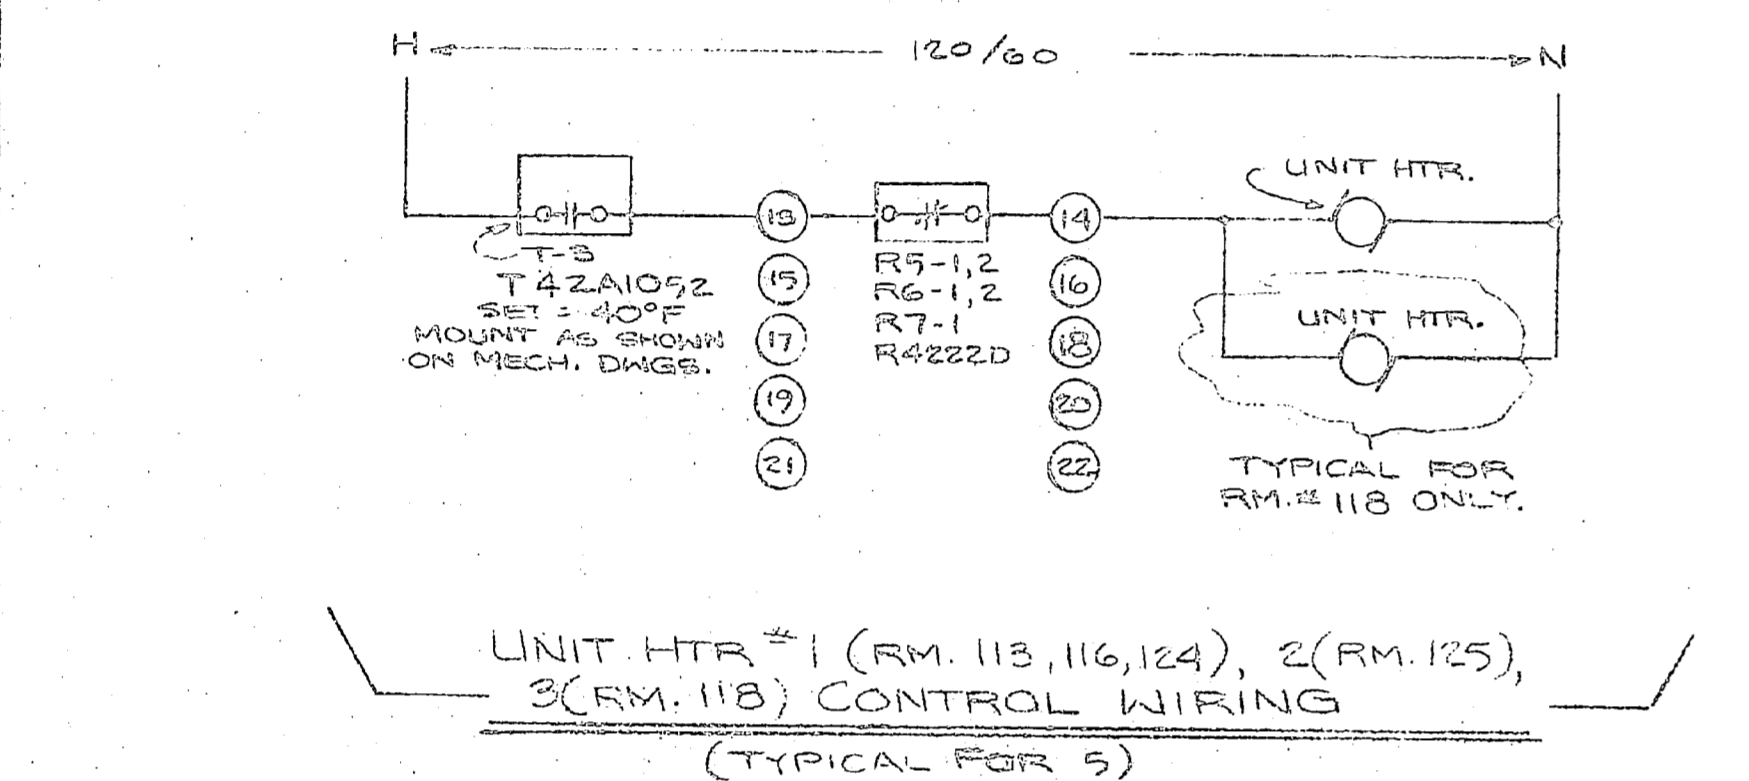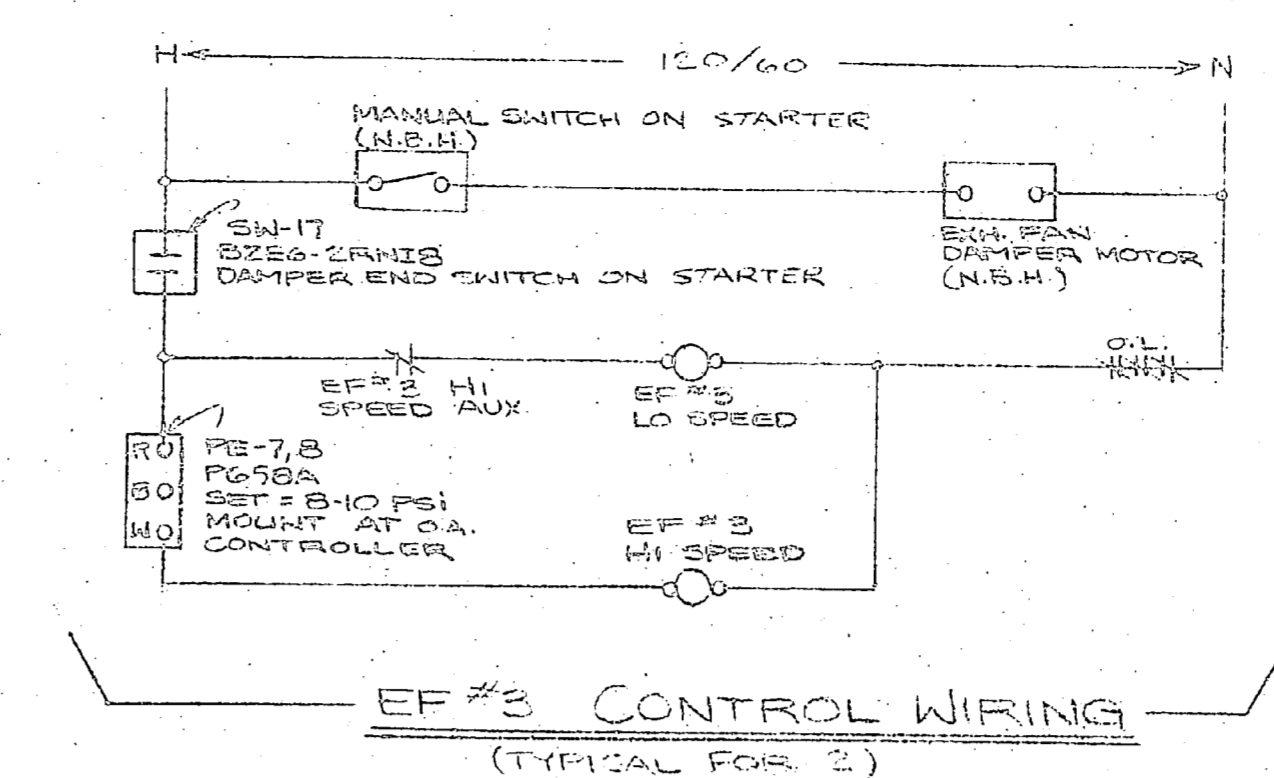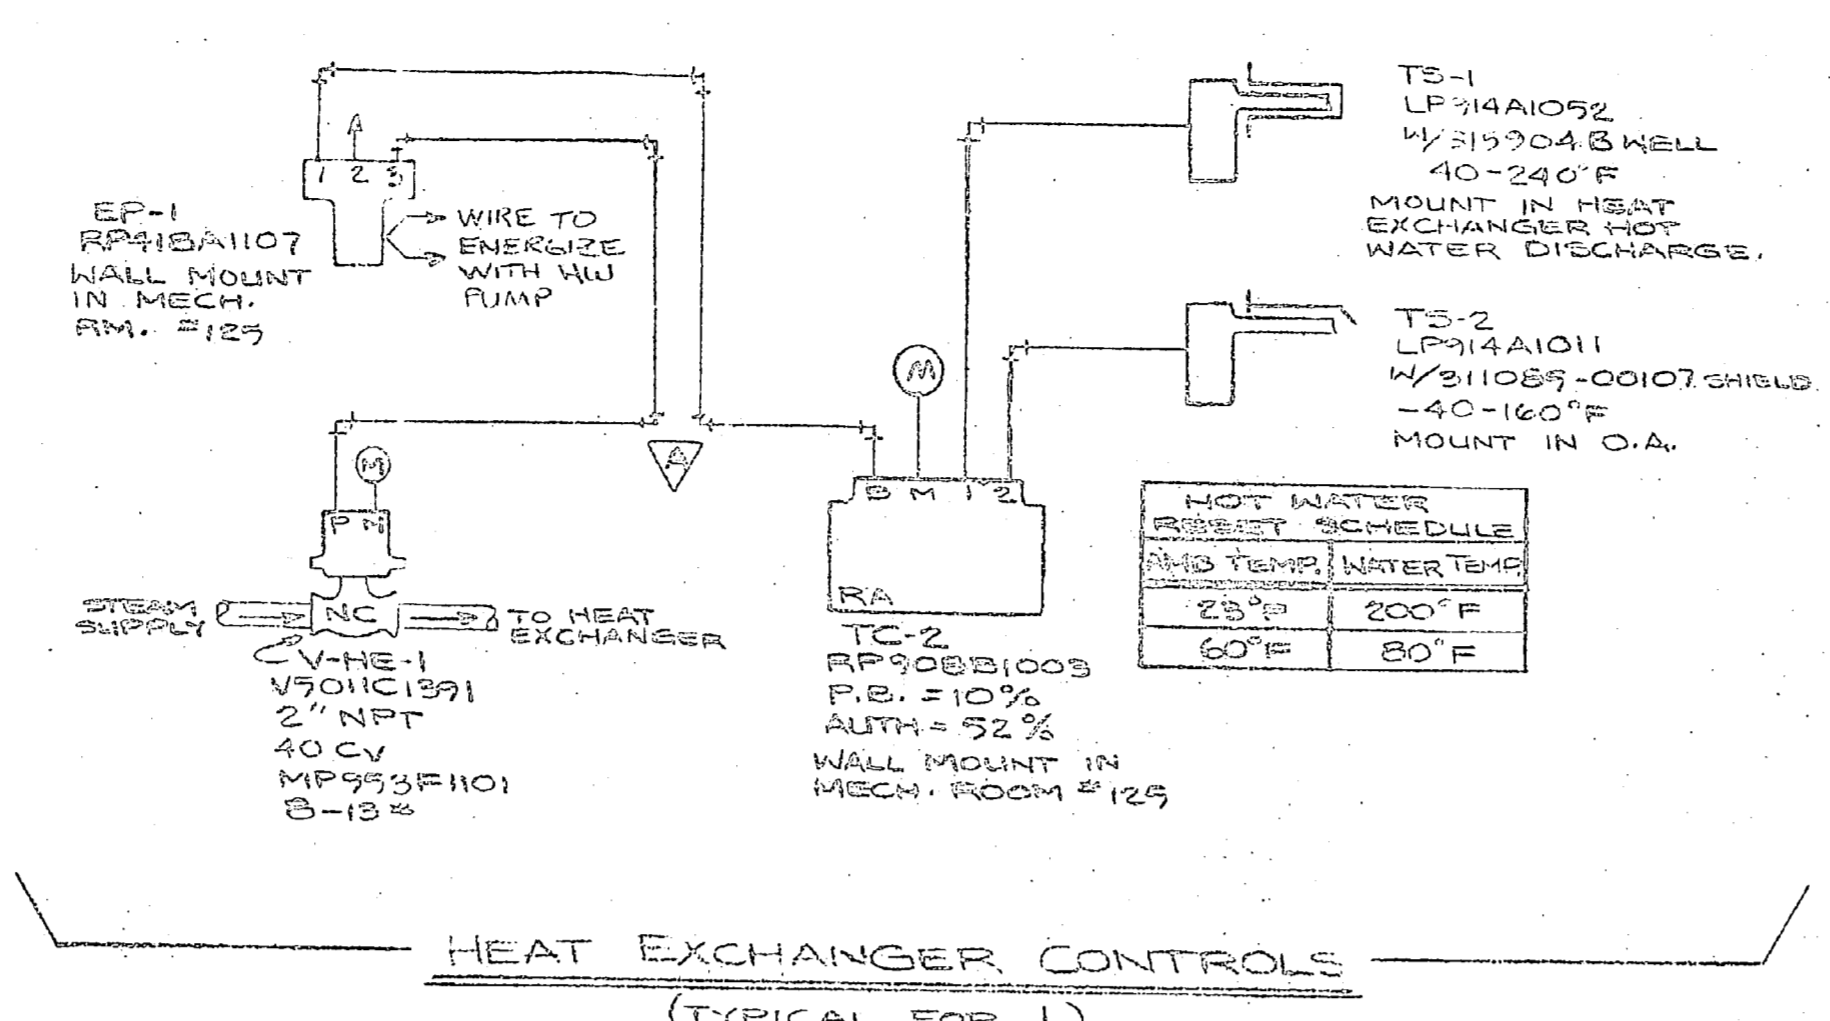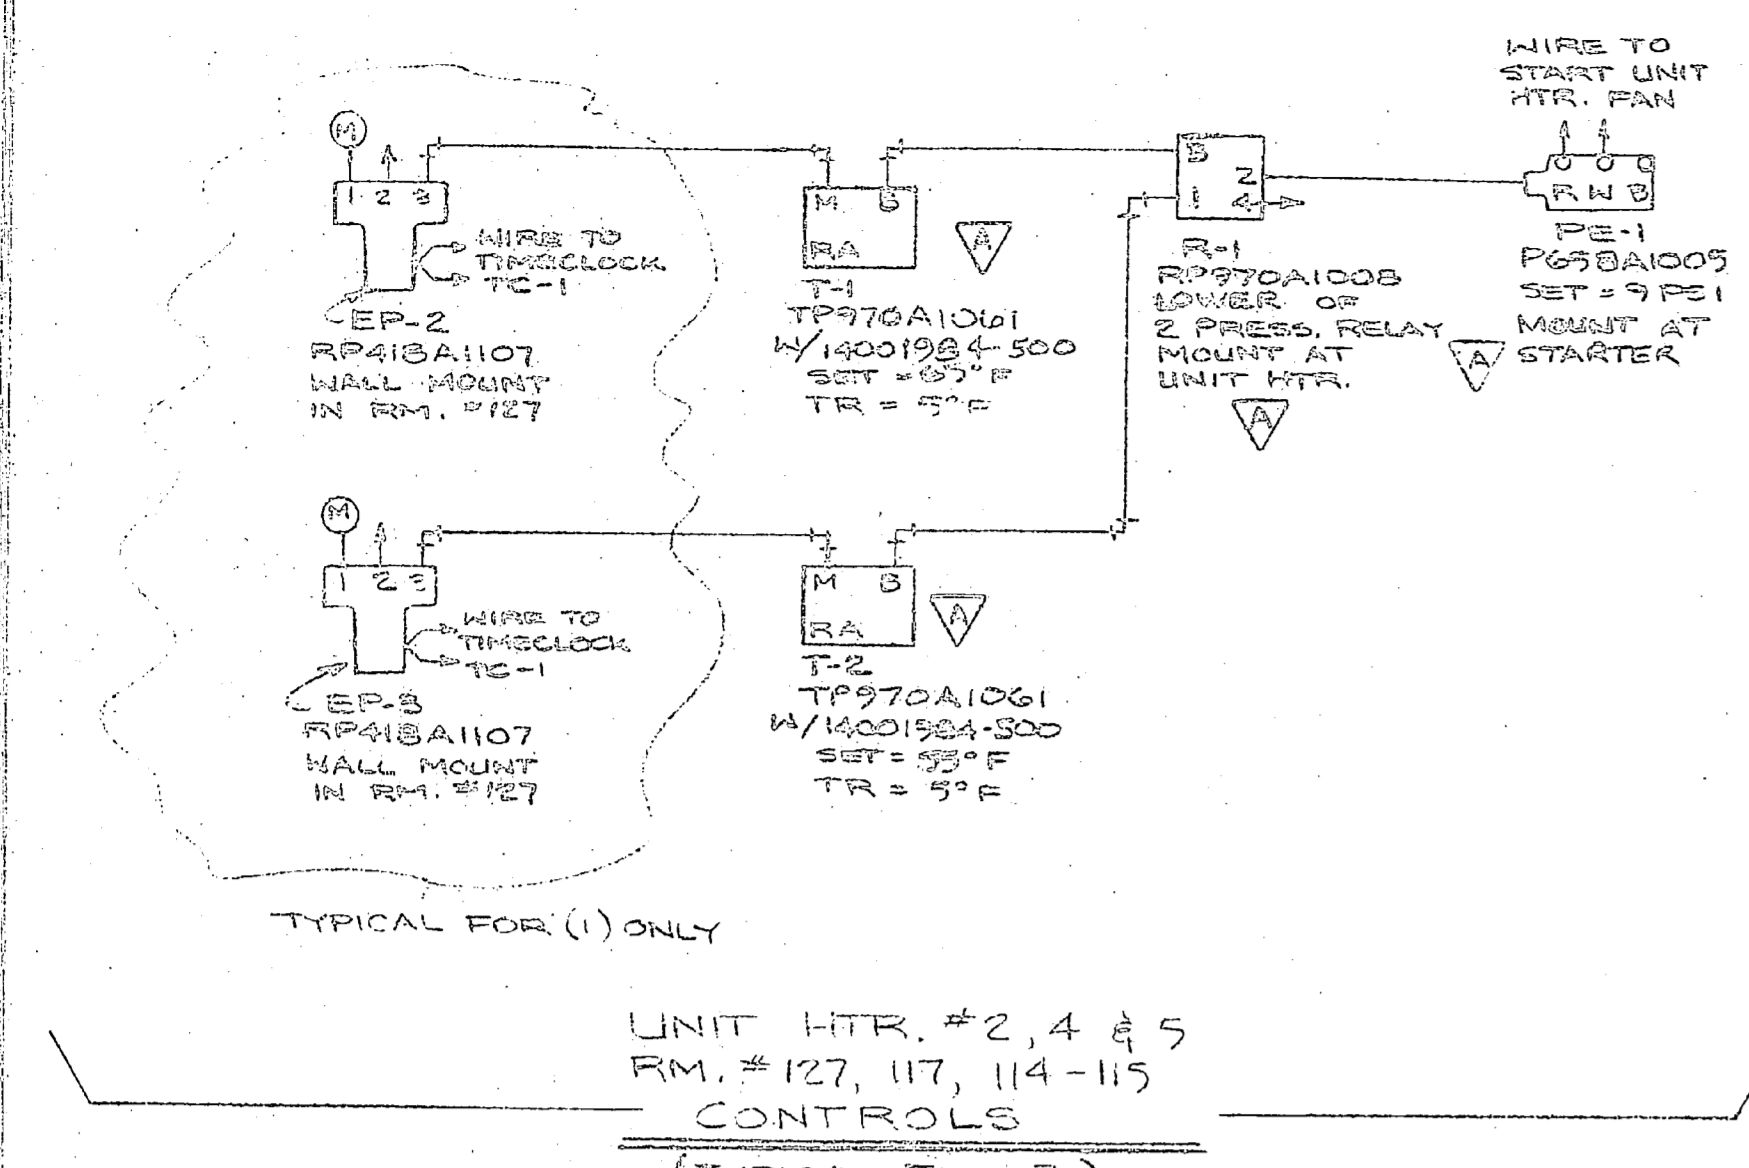


LEGEND:
 [Symbol] = MOUNT IN DTC PANEL
 [Symbol] = TERMINAL IN DTC PANEL
 N.B.H. = NOT BY HONEYWELL

THIS IS THE LATEST REVISION TO THIS DRAWING. DESTROY ALL PREVIOUS ISSUES. MAY 1, 1983

ARCHITECT: NAVA FACILITIES
 ENGINEER: NAVA FACILITIES
 CONTRACTOR: SHEDDEN, INC.
 APPLICATION ENGINEER: NELSON GATES

HONEYWELL, INC.		SITE: SHARON ARMY FLD., CHARLOTTE, N.C. 28211	
