

VALUABLE

RETURN TO
CARR & J. E.
GREINER CO.
JACKSONVILLE,
N. C.



SUBJECT Drainage Data in
Officers Quarters

FIELD PARTY
McClung IN CHARGE
Bonner INSTRUMENT
Batson NOTES
TAPE READ
TAPE OR ROD
TAPE OR ROD
INSTRUMENT NO.
TAPE NO.

WEATHER
CLEAR
CLOUDY
WINDY
RAIN
FAIR
SNOW
HOT
MODERATE
COLD
FOG
FIGURED BY
NOTES CHECKED BY
PLOTTED BY

FILE No. _____
FLDR. No. _____
SHEET 1 of 12
DATE Nov 7 1942

STATION	DIST.	ANGLE ° ' "	+	H. I.	— VERI ANG. DIFF.	ELEVATION
<u>B.M.</u>				<u>539</u>	<u>26.17</u>	<u>20.78</u>
					<u>150</u>	<u>24.67</u>
					<u>820</u>	<u>17.97</u>
					<u>640</u>	<u>19.77</u>
<u>Tile</u>					<u>703</u>	<u>19.14</u>
					<u>1</u>	
					<u>160</u>	<u>24.57</u>
					<u>680</u>	<u>19.37</u>
					<u>680</u>	<u>19.37</u>
					<u>750</u>	<u>18.67</u>

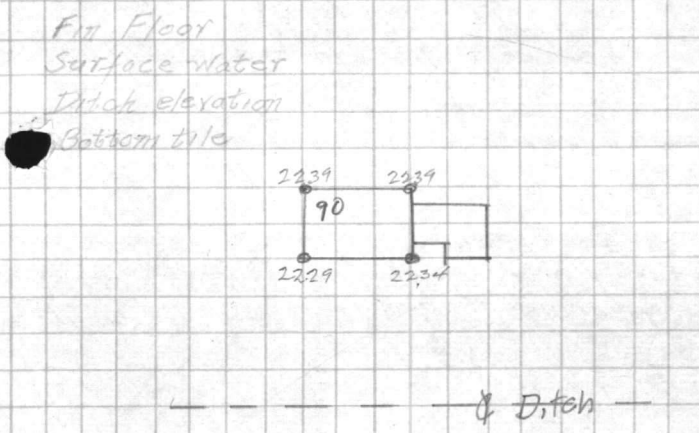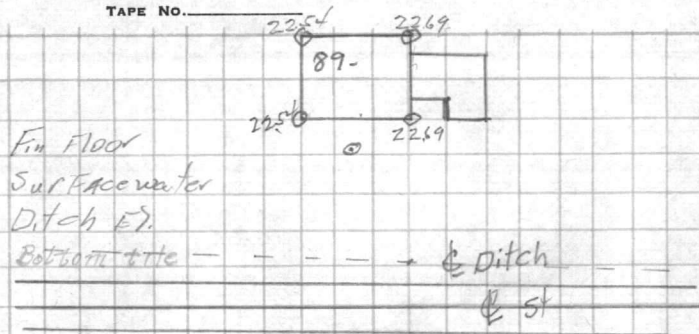

TP 386 2595 408 22.09







VALUABLE
 RETURN TO
 CARR & J. E.
 GREINER CO.
 JACKSONVILLE,
 N. C.

 SUBJECT Drainage Data in
Officers Quarters

FIELD PARTY

 IN CHARGE _____
 INSTRUMENT _____
 NOTES _____
 TAPE READ _____
 TAPE OR ROD _____
 TAPE OR ROD _____
 INSTRUMENT No. _____
 TAPE No. _____

WEATHER

 CLEAR _____ SNOW _____
 CLOUDY _____ HOT _____
 WINDY _____ MODERATE _____
 RAIN _____ COLD _____
 FAIR _____ FOG _____

FILE No. _____


FLDR. No. _____

SHEET 2 of 12DATE Nov 7, 1942

STATION	DIST.	ANGLE		+	H. I.	ELEVATION		VER. ANG. DIFF.
		°	' "					

25.95


					25.95			
						0.87	25.08	
						8.70	17.25	
						6.9	19.0	
						7.18	18.77	

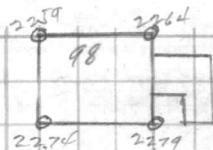 Fin floor
 Sur. water
 Ditch elev
 Bottom tile


Ditch

St

						0.34	25.61	
						5.75	20.20	
						6.40	19.35	
						6.26	19.69	

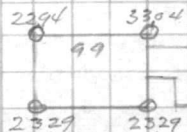 Fin floor
 Sur. water
 Ditch elev
 Bottom tile


Ditch

Road

ST PAULI MEMORIE BUREAU
HAS CONTENT U.S.A.

VALUABLE

SUBJECT Drainage Data in OFFICERS
Quarters

RETURN TO
CARR & J. E.
GREINER CO.
JACKSONVILLE,
N. C.

FIELD PARTY

IN CHARGE

INSTRUMENT

NOTES

TAPE READ

TAPE OR ROD

TAPE OR ROD

INSTRUMENT No.

TAPE No.

WEATHER

CLEAR
CLOUDY
WINDY
RAIN
FAIR

SNOW
HOT
MODERATE
COLD
FOG

023
54
FILE No. _____


FLDR. No. _____

SHEET 3 of 12

DATE Nov. 7, 1942

STATION	DIST.	ANGLE		+	H. I.	ELEVATION	
		°	' "			VER. DIFF.	ANG. DIFF.
					2595	- 29	2624
							527 2068
							566 2029
							587 2008

Fin. floor
water elev
Bottom ditch
" Tile

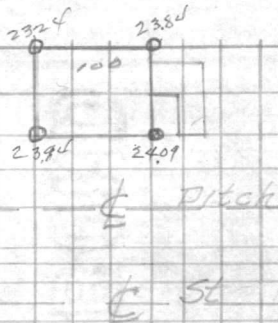

023
54
11-11-42

VALUABLESUBJECT Drainage Data in Officers
QuartersRETURN TO
CARR & J. E.
GREINER CO.
JACKSONVILLE,
N. C.

FIELD PARTY


IN CHARGE McClung
Bonnet
INSTRUMENT
NOTES
Patson
TAPE READ
TAPE OR ROD
TAPE OR ROD
INSTRUMENT NO.
TAPE NO.WEATHER
CLEAR
CLOUDY
WINDY
RAIN
FAIR
SNOW
HOT
MODERATE
COLD
FOG
FIGURED BY
NOTES CHECKED BY
PLOTTED BY

FILE No. _____

FLDR. No. _____

SHEET 5 of 12DATE Nov 9 1942


STATION	DIST.	ANGLE		+	H. I.	ELEVATION	
		°	' "			VER:	ANG. DIFF.
					2859	278	26.31
						765	21.14
						765	20.94
						814	20.45
						440	24.19
						470	24.39

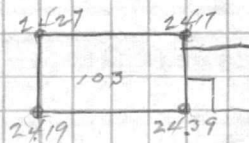Fin floor
Sur Water
Drick elev
Bot. Tile
Front House
"

Ditch

SE

						220	26.39
						710	21.49
						850	20.09
						870	19.89
						420	24.19
						490	24.29

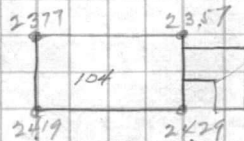Fin floor
Sur Water
Drick elev
Bot. Tile
Front House
"

Ditch

SE

T.P. 577 28 87 -5.49 23 10

STRAIGHT THROUGH BOLL

HAS CONTINUED U.S.A.

ATTACHED

STRANIMORIS # 0110

100-100000



VALUABLE

RETURN TO
CARR & J. E.
GREINER CO.
JACKSONVILLE,
N. C.

SUBJECT Drainage Data
Of Siccers Quarters

FIELD PARTY
McClung IN CHARGE
Bonnet INSTRUMENT
NOTES
Batson TAPE READ
TAPE OR ROD
TAPE OR ROD
INSTRUMENT NO.
TAPE NO.

WEATHER
CLEAR
CLOUDY
WINDY
RAIN
FAIR
SNOW
HOT
MODERATE
COLD
FOG
FIGURED BY
NOTES CHECKED BY
PLOTTED BY

FILE No. _____
FLDR. No. _____
SHEET 7 of 12
DATE Nov. 9 1942

STATION	DIST.	ANGLE		H. I.	VER. DIFF.	ANG. DIFF.	ELEVATION
		°	' "				

2766

223

2543

Fin. floor

740

20.26

Water level

800

19.66

Ditch

830

18.86

tile

450

2316

Front House

440

2326

"

2783 ← 400

2383

Back House

↑ 400

2383

"

244

2522

Fin. floor

910

18.56

Water level

850

19.16

Ditch

900

18.66

Tile

380

2386

Front House

420

2346

"

410



2373

Back House

410

2373

"

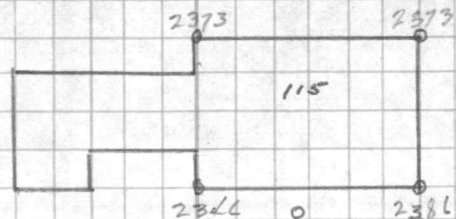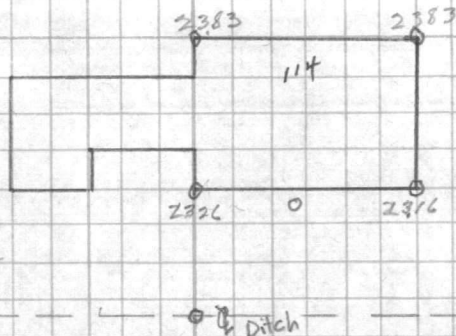

STATION

STATION NUMBER 13 5110

TYPE CONTENT U.S.A.

VALUABLE

RETURN TO
CARR & J. E.
GREINER CO.
JACKSONVILLE,
N. C.

SUBJECT Drainage Data
Officers Quarters


FIELD PARTY
McClung IN CHARGE
Bonner INSTRUMENT
Batson NOTES
TAPE READ
TAPE OR ROD
INSTRUMENT NO.
TAPE NO.

WEATHER
CLEAR CLOUDY WINDY RAIN FAIR
SNOW HOT MODERATE COLD FOG
FIGURED BY
NOTES CHECKED BY
PLOTTED BY

FILE No. _____
FLDR. No. _____
SHEET 8 of 12
DATE Nov. 9 1942

STATION	DIST.	ANGLE		+	H. I.	—		ELEVATION
		°	' "			VER.	ANG. DIFF.	
					27.66	7.61		25.05
						9.80		17.86
						8.50		19.16
						8.70		18.96
						5.00		22.66
					27.83	4.80		22.86
						24.30		23.53
						4.10		23.73

Fin floor
Water level
Ditch
Tile
Front House
" "
Back House

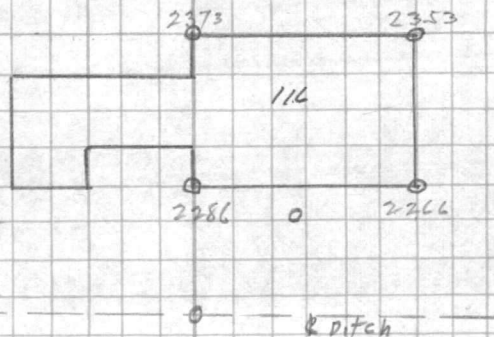

J.P.

FILE NO.

DATE

BY

NO.

REMARKS



VALUABLE
 RETURN TO
 CARR & J. E.
 GREINER CO.
 JACKSONVILLE,
 N. C.

 SUBJECT Drainage Data
Officers Quarters

 FIELD PARTY
McChung IN CHARGE
Banner INSTRUMENT
 NOTES
Batson TAPE READ
 TAPE OR ROD
 TAPE OR ROD
 INSTRUMENT NO.
 TAPE NO.

 WEATHER
 CLEAR
 CLOUDY
 WINDY
 RAIN
 FAIR
 SNOW
 HOT
 MODERATE
 COLD
 FOG
 FIGURED BY _____
 NOTES CHECKED BY _____
 PLOTTED BY _____

FILE No. _____


FLDR. No. _____

SHEET 9 of 12DATE Nov-9 1942

STATION	DIST.	ANGLE		+	H. I.	- VER: ANG. DIFF.		ELEVATION
		°	' "					

T.P.					2783	444		2339
	369				2708			
						439		2279
						1090		1618
						1075		1633
						1066		1642
						630		2078
						648		2068

						286		2422
						920		1788
						960		1748
						955		1753
						560		2148
						510		2198

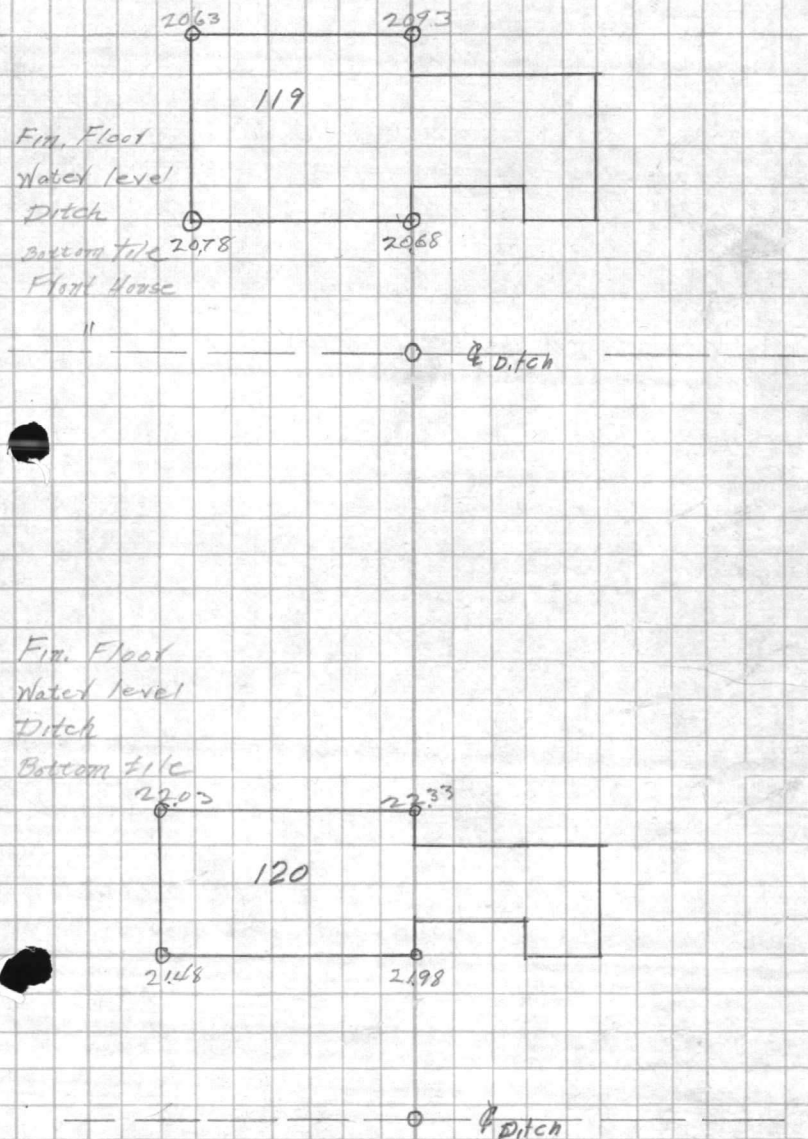








STRAIGHTMORNING

AMERICAN CONTINENTAL L.S.A.

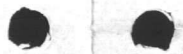

VALUABLE

RETURN TO
CARR & J. E.
GREINER CO.
JACKSONVILLE,
N. C.

SUBJECT Drainage Data
Officers Quarters

FIELD PARTY
McClung IN CHARGE
Bonner INSTRUMENT
Batson NOTES
TAPE READ
TAPE OR ROD
TAPE OR ROD
INSTRUMENT NO.
TAPE NO.


WEATHER
CLEAR
CLOUDY
WINDY
RAIN
FAIR
SNOW
HOT
MODERATE
COLD
FOG
FIGURED BY
NOTES CHECKED BY
PLOTTED BY

FILE No. _____
FLDR. No. _____
SHEET 10 of 12
DATE Nov 9 1942

STATION	DIST.	ANGLE		+	H. I.	—		ELEVATION
		°	' "			VER: ANG.	DIFF.	


2708

222	2486
1010	1698
830	1878
808	1900
430	2278
430	2278

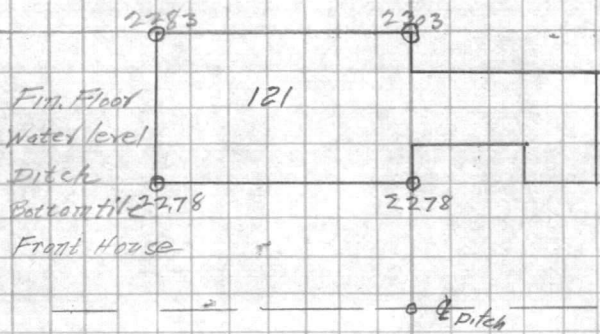

172	2536
710	1998
720	1988
732	1976
490	2278
490	2278


Fin. Floor
Water level
Ditch
Bottom tile
Front House 2323

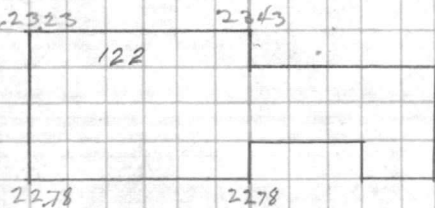

Ditch

STURMUTIMORE BC ME

MADE IN GREAT BRITAIN

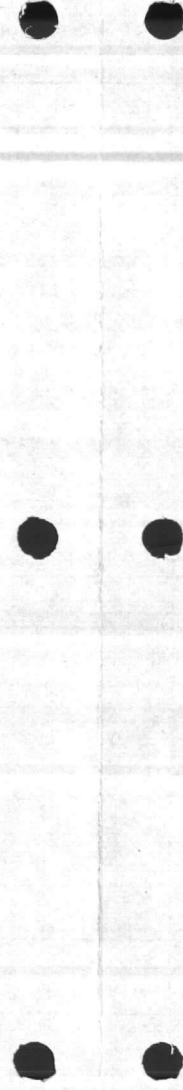

VALUABLE

RETURN TO
CARR & J. E.
GREINER CO.
JACKSONVILLE,
N. C.


SUBJECT Drainage Data
Officers Quarters

FIELD PARTY
MCClurg IN CHARGE
Banner INSTRUMENT
Batson NOTES
TAPE READ
TAPE OR ROD
INSTRUMENT NO.
TAPE NO.


WEATHER
CLEAR
CLOUDY
WINDY
RAIN
FAIR
SNOW
HOT
MODERATE
COLD
FOG
FIGURED BY
NOTES CHECKED BY
PLOTTED BY

FILE No. _____
FLDR. No. _____
SHEET 11 of 12
DATE Nov 9, 1942

STATION	DIST.	ANGLE ° ' "	H. I.	VER. ANG. DIFF.	ELEVATION
			2708	150	2558
				650	2058
				730	1978
				727	1981
				390	2318
				355	2353

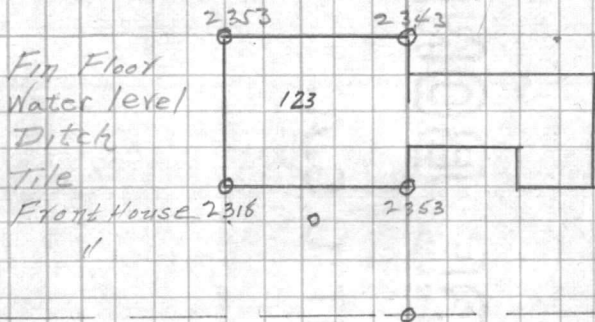

123	2585	Fin Floor
600	2108	Water level
690	2018	Ditch
733	1975	Tile
355	2353	Front House
333	2375	

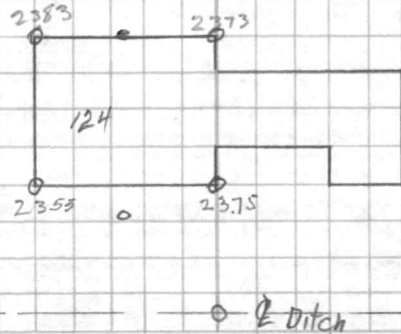

STRATIMOR® (M)

FRAGMENTS U.S.A.



VALUABLE

SUBJECT Drainage Data
Officers Quarters


RETURN TO
 CARR & J. E.
 GREINER CO.
 JACKSONVILLE,
 N. C.

FIELD PARTY
McClung IN CHARGE
Banner INSTRUMENT
 NOTES
Batson TAPE READ
 TAPE OR ROD
 TAPE OR ROD
 INSTRUMENT NO.
 TAPE NO.

WEATHER
 CLEAR
 CLOUDY
 WINDY
 RAIN
 FAIR
 SNOW
 HOT
 MODERATE
 COLD
 FOG
 FIGURED BY
 NOTES CHECKED BY
 PLOTTED BY

FILE No. _____
 FLDR. No. _____
 SHEET 12 0512
 DATE Nov 9 1942

STATION	DIST.	ANGLE		+	H. I.	- VER: ANG. DIFF.		ELEVATION
		°	' "					
					2708			
						135		2573
						640		2068
						680		2028
						765		1943
						340		2368
						345		2363

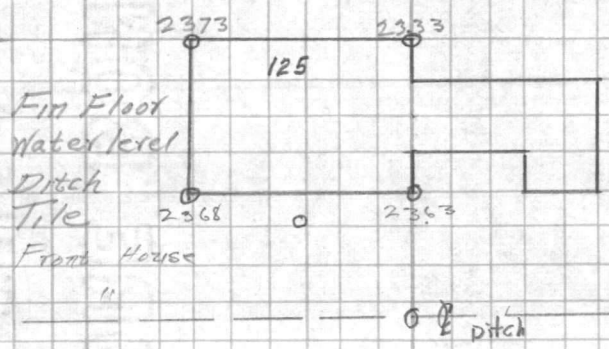

336 652

496 910

336 472

497 052

VALUABLE

RETURN TO
CARR & J. E.
GREINER CO.
JACKSONVILLE,
N. C.

SUBJECT B. O. Q
Elev. To Control Tile Underdrain



FIELD PARTY
BECK IN CHARGE
" INSTRUMENT
NOTES
TAPES READ
GARNER TAPE OR ROD
GODWIN TAPE OR ROD
INSTRUMENT NO.
TAPE NO.

WEATHER
CLEAR
CLOUDY
WINDY
RAIN
FAIR
SNOW
HOT
MODERATE
COLD
FOG
FIGURED BY
NOTES CHECKED BY
PLOTTED BY

FILE No. _____
FLDR. No. _____
SHEET 1
DATE 11/7 19__

STATION	DIST.	ANGLE o' " "	+	H. I.	- VER. ANG. DIFF.	ELEVATION
B.M.#716				4.39	2433	19.54
T.P.				4.98	2489	4.42 19.91
1/4" 18" R.C.P.						7.69 17.2
Grd. @ Cor "A"						3.4 21.5
Top Footer "A"						5.55 19.3
Main Floor Elev. B.O.Q (A-B)						2.39
Grd. @ Cor "B"						4.1
Top Footer "B"						5.46
T.P.				6.30		4.98
Grd. @ Cor "C"						4.3
Top Footer "C"						5.48
Grd. @ Cor "D"						4.7
Top Footer "D"						5.91
Main Floor Elev. B.O.Q (C-D)						3.69
T.P.				4.61		6.30
B.M.#716						4.59

Insert Elev. Probably Established On Sewer Stakeout To Servants Qtrs.

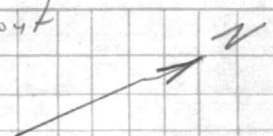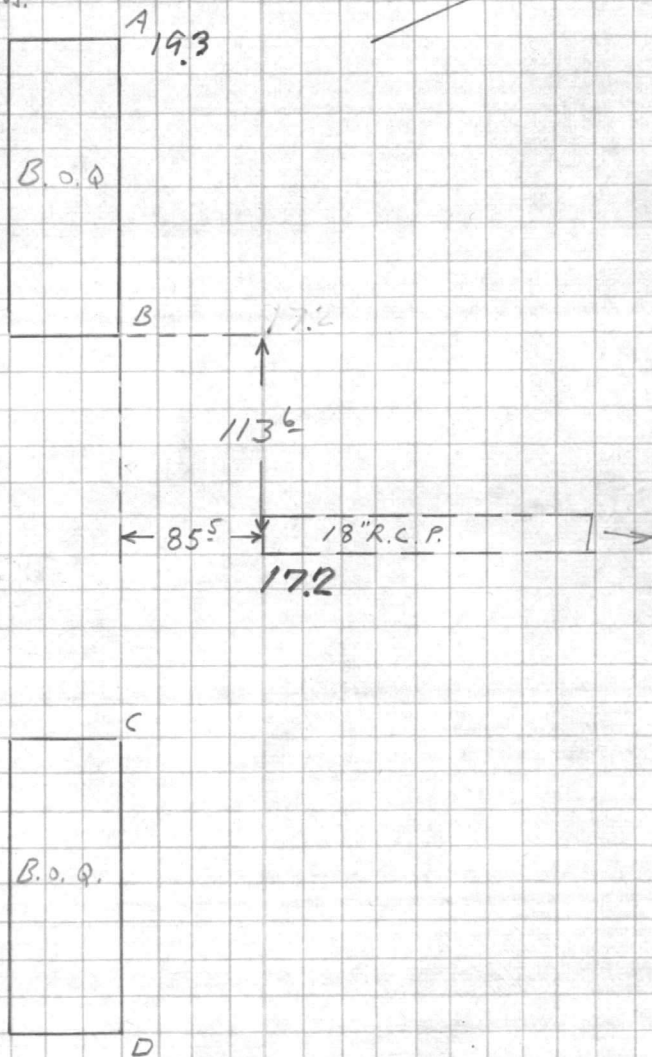








