

STREET LAY-OUT
INDUSTRIAL AREA



90° 02



1927.95
1.00059
15423.60
9639.75
11182.110



1.0002909
1.00004

1927.89
1.00004
10771.156

-0.08
1.12
1.20

2819.41
1.20
2818.21

VALUABLE

RETURN TO
PUBLIC WORKS
OFFICE
CAMP LEJEUNE
NEW RIVER, N. C.

SUBJECT Street Lay-out
for Record Mapping
Industrial Area.


FIELD PARTY

____ IN CHARGE
____ INSTRUMENT
____ NOTES
____ TAPE READ
____ TAPE OR ROD
____ TAPE OR ROD
____ INSTRUMENT NO.
____ TAPE NO.

WEATHER

CLEAR _____
CLOUDY _____
WINDY _____
RAIN _____
FAIR _____
SNOW _____
HOT _____
MODERATE _____
COLD _____
FOG _____

FILE No. 100
FLDR. No. _____
SHEET _____
FIGURED BY _____
NOTES CHECKED BY _____
PLOTTED BY _____ DATE _____ 19____
Quad. No. _____

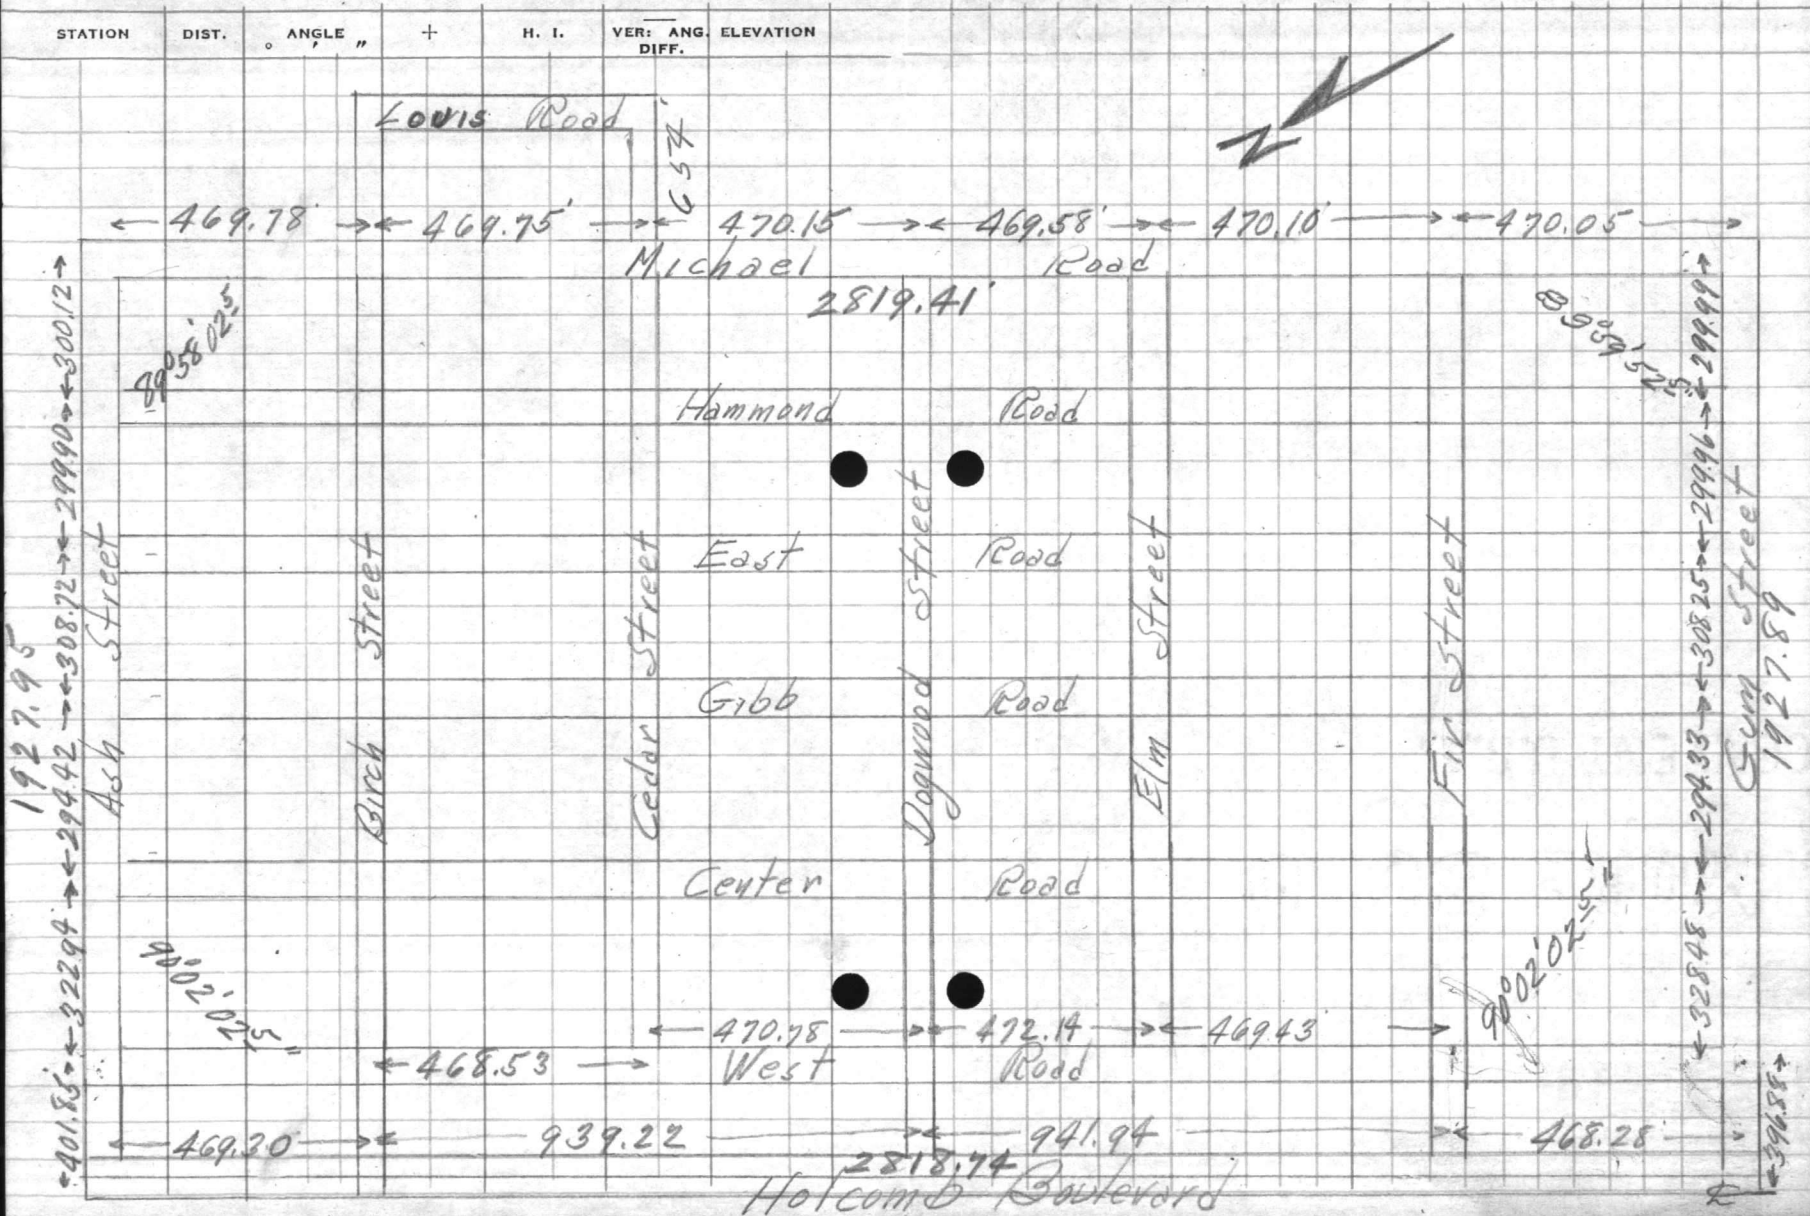




VALUABLE

SUBJECT Record Data

Industrial Area

RETURN TO
PUBLIC WORKS
OFFICE

CAMP LEJEUNE
NEW RIVER, N. C.

FIELD PARTY

Sommerlin IN CHARGE

INSTRUMENT

NOTES

TAPE READ

TAPE OR ROD

TAPE OR ROD

INSTRUMENT NO.

TAPE NO.

WEATHER

CLEAR SNOW
CLOUDY HOT
WINDY MODERATE
RAIN COLD
FAIR FOG

FILE No.

FLDR. No.


FIGURED BY SHEET 1091

NOTES CHECKED BY

PLOTTED BY DATE 11/30 1944

Quad. No.

STATION	DIST.	ANGLE "	+	H. I.	VER. ANG. DIFF.	ELEVATION
---------	-------	---------	---	-------	-----------------	-----------

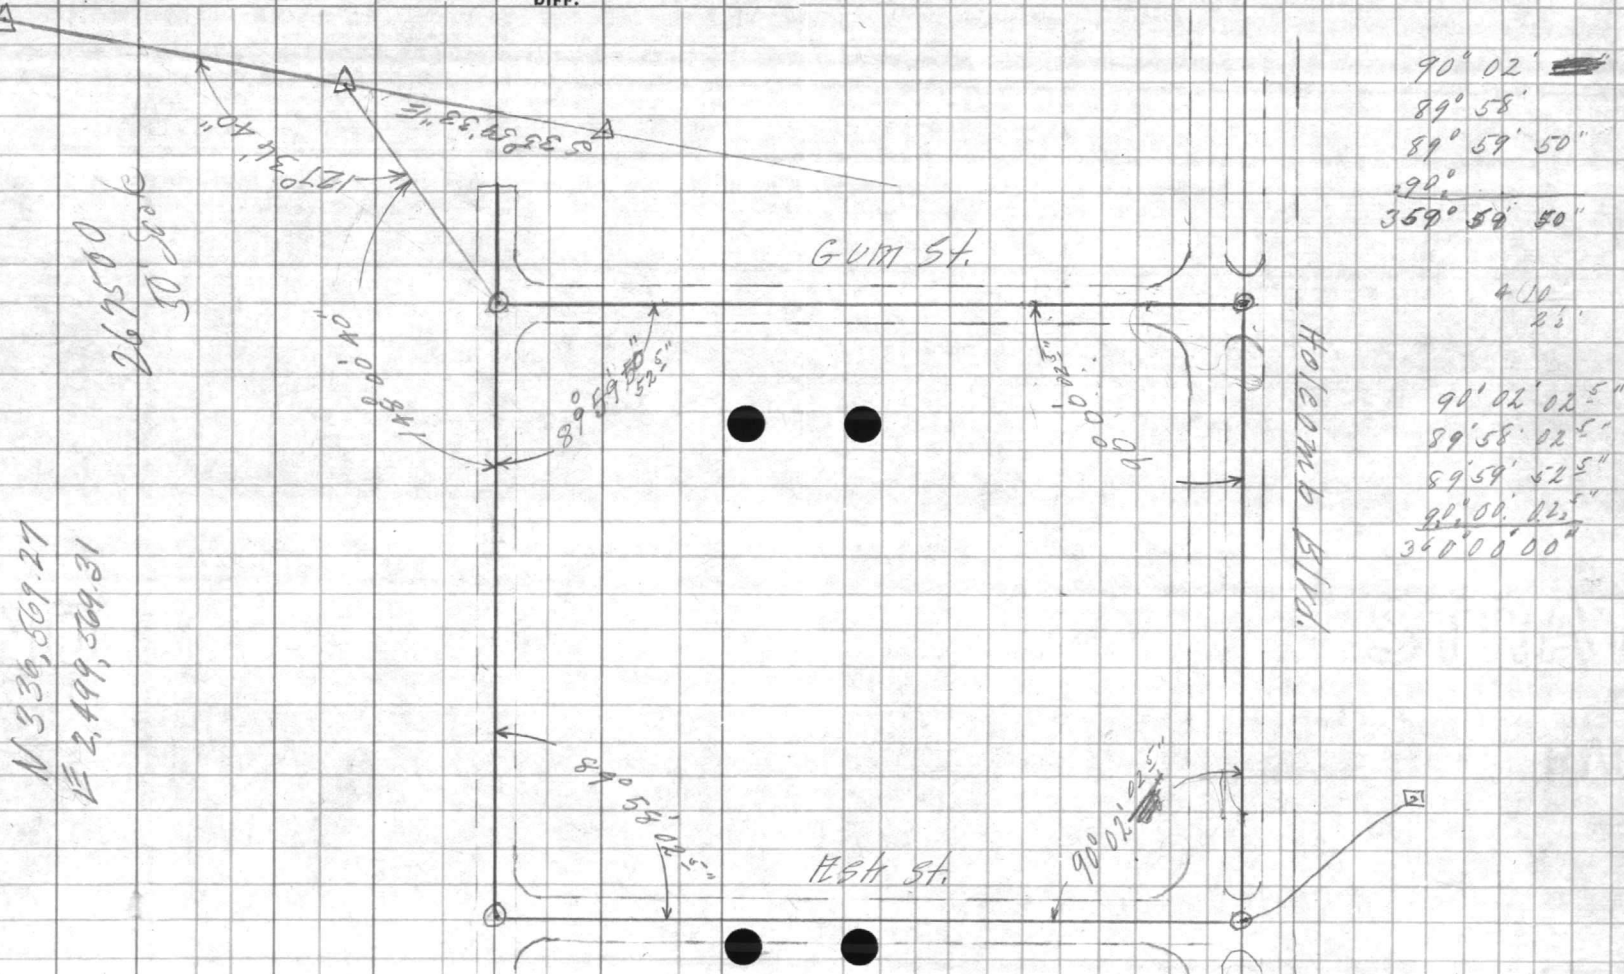

90° 02' ~~00"~~
89° 58'
89° 59' 50"
90°
359° 59' 50"

4.10
26'

90° 02' 02.5"
89° 58' 02.5"
89° 59' 52.5"
90° 00' 02.5"
360° 00' 00"

N 339.669.27
E 2.499.369.31

267500
30.200

89 23 35
N 10° 19' 50" W

N 79° 08' 45" E ✓

59 14 50

138 23 35 ✓

179 59 60

S 41° 36' 25" E ✓

89 58 02

S 48° 21' 37½" W

31 59 20

S 16° 22' 17½" W

52° 23' 20"

S 36° 01' 03" E

35 59 33

01' 30'

90 01 59.5 ✓

41 36 25

S 48° 25' 32.5" W ✓

31 59 20

S 16° 26' 12" W W

52° 23' 20"

14 26 12.5

35 59 33

35 59 33

2' 25.5"

41 36 25

89 58 02.5

138 34 27.5

179 59 60

48 25 32.5

S 48° 25' 32.5" W

90 00' 07.5"

138 25' 40"

179 59 60

N 41° 34' 20" W

89 59 57.5

N 48° 25' 37.5" E







PUBLIC WORKS DEPARTMENT
Camp Lejeune, North Carolina
Survey Department

File 160-C
Quadrangle _____
Date _____
Sheet _____ of _____

Traverse Computation
Description

Co-ordinates of St. Intersections on Cedar St. Industrial Area

Station	Distance	Bearing	Cosine	Sine	Latitude	Departure	Y Coordinate North	X Coordinate East
Int. of Holcomb Blvd. & Ash St.		548°25'40"W	toward Gum St.				340,459.96	2,500,567.79
" " " " + Cedar St.	937.83	"	663573	748112	622.32	701.60	339,837.64	2,499,866.19
Int. of Ash St. & Michael Rd.		548°25'40"W	toward Gum St.				339,018.36	2,501,847.91
" " Cedar St. + " "	939.53	"	663573	748112	623.45	702.87 *	338,394.91	2,501,145.04 *
Int. of Cedar St. + Holcomb Blvd.		"	663573	748112	623.45	702.87	339,837.64	2,499,866.19
" " " " + West Rd.	400.20	541-33-15 E	748329	663328	299.48	265.46	339,538.16	2,500,131.65
" " " " + Center "	324.78	"	"	"	243.04	215.44	339,295.12	2,500,347.09
" " " " + Gibb "	294.39	"	"	"	220.30	195.28	339,074.82	2,500,542.37
" " " " + East "	308.56	"	"	"	230.90	204.68	338,843.92	2,500,747.05
" " " " + Hammond "	299.92	"	"	"	224.44	198.95	338,619.48	2,500,946.00
" " " " + Michael "	300.08	"	"	"	224.56	199.05 *	338,394.92	2,501,145.05 *

Cedar Street

VALUABLE

RETURN TO
PUBLIC WORKS
OFFICE
CAMP LEJEUNE
NORTH CAROLINA

SUBJECT ELEV. 8" WATER
PIPE END BLDG.#
1106

FIELD PARTY
DEWNS IN CHARGE

INSTRUMENT

NOTES

TAPE READ

TAPE OR ROD

TAPE OR ROD

INSTRUMENT No. _____
TAPE No. _____

WEATHER
CLEAR _____
CLOUDY _____
WINDY _____
RAIN _____
FAIR _____
SNOW _____
HOT _____
MODERATE _____
COLD _____
FOG _____
FIGURED BY _____
NOTES CHECKED BY _____
PLOTTED BY _____

FILE No. 160 C
FLDR. No. _____
SHEET 1 of 1
DATE 2-13-56

Quad. No. _____

STATION	DIST.	ANGLE ° ' "	+	H. I. BEARING	VER. ANG. DIFF.	ELEVATION
B.M. STEAM PIT N.E. COR. MICHEAL & BIRCH	4.12	34.13				30.01

"A" TOP 8" C.I. WATER
LINE → 8.75 25.38

MICHEAL

R.D.

8" C.I. WATER

PIPE

1107

1104

← 20.8 →

VALUABLE

RETURN TO
PUBLIC WORKS
OFFICE
CAMP LEVINE
NORTH CAROLINA

SUBJECT

STATION DIST

ANGLE

BEARING

HT. VER. AND
CURVE

ELEVATION

STATION NO.

TYPE OF PT.

TAB. NO. TO

TAB. NO.

INSTRUMENT

IN CHARGE

FIELD PARTY

DATE

CHECKED BY

DRAWN BY

SCALE

COPIES

NO.

DATE

VALUABLE

SUBJECT LOCATION OF
6" C.I. WATER LINE AT
HEATING PLANT

Return To
 Public Works
 Office
 Camp Lejeune
 North Carolina

FIELD PARTY

_____ In Charge
 _____ Instrument
 _____ Notes
 _____ Tape Read
 _____ Tape or Rod
 _____ Instrument No.
 _____ Tape No.


WEATHER

Clear _____
 Cloudy _____
 Windy _____
 Rain _____
 Fair _____
 Snow _____
 Hot _____
 Moderate _____
 Cold _____
 Fog _____

FILE No. 160-B
 Fldr. No. _____
 Sheet _____
 Date 12-9 1949

Figured By _____
 Notes Checked By _____
 Plotted By _____
 Quad. No. _____

Station	Dist.	Angle " "	+	H. I. Bearing	Ver: Ang. Diff.	Elevation
						2844
	454	3298				
TOP 6" C.I. WATER LINE 0+79				1063	22,35	

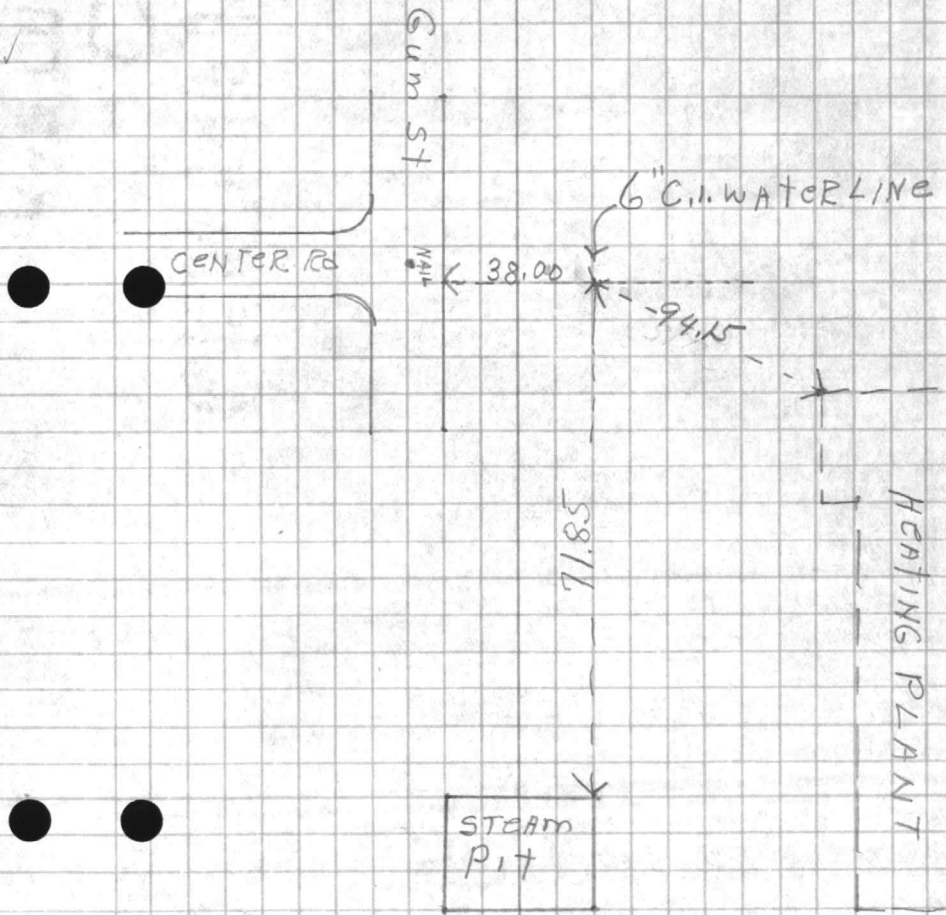







VALUABLE

SUBJECT _____

Return To
Public Works
Office
Camp Lejeune
North Carolina

FIELD PARTY

 _____ In Charge
 _____ Instrument
 _____ Notes
 _____ Tape Read
 _____ Tape or Rod
 _____ Tape or Rod
 _____ Instrument No.
 _____ Tape No.

WEATHER

 Clear _____
 Cloudy _____
 Windy _____
 Rain _____
 Fair _____
 Snow _____
 Hot _____
 Moderate _____
 Cold _____
 Fog _____

FILE No. _____

Fldr. No. _____

Figured By _____ Sheet _____

Notes Checked By _____

Plotted By _____ Date _____ 19__

Quad. No. _____

Station	Dist.	Angle ' "	+	H. I. Bearing	Ver: Ang. Diff.	Elevation	
R.M.						49.44	Nail int. of gum st. AND center ROAD.
						1.54 32.98	
						8.05 21.93	ON 6"X6" tee

UNAVAILABLE

SUBJECT

Return To
Public Works
Office
Camp Lajeune
North Carolina

FIELD PARTY

WEATHER

Clear
Cloudy
Fog
Hail
Moderate
Rain
Cold
Fog

In Charge
Instrument
Notes
Tape Read

FIELD No.

Roll No.

Sheet

Figured BY

Notes Checked BY

Date

Plotted BY

Quad No.

Tape No.

Station
Dist.
Angle
H. I.
Bearing
M. I.
Elevation

VALUABLE

RETURN TO
PUBLIC WORKS
OFFICE
CAMP LEJEUNE
NORTH CAROLINA

SUBJECT Location Elev. & boring logs
of proposed scales & scales
House

FIELD PARTY

Caulk IN CHARGE
INSTRUMENT _____
NOTES _____
TAPE READ _____
TAPE OR ROD _____
STRUMENT NO. _____
TAPE NO. _____


WEATHER

CLEAR _____ SNOW _____
CLOUDY _____ HOT _____
WINDY _____ MODERATE _____
RAIN _____ COLD _____
FAIR _____ FOG _____
FIGURED BY _____
NOTES CHECKED BY _____
PLOTTED BY _____

FILE No. 160-C
FLDR. No. _____
SHEET 1 of
DATE 1-29 1933

Quad. No. _____

STATION	DIST.	ANGLE		H. I. BEARING	VER. ANG. DIFF.	ELEVATION
		°	"			
Dogwood & West Rd.			4.30			25.21
				29.51		
Elm & West Rd.				4.19		25.32
Pipe 1 1/2" Elm & West Rd. inter.				7.96		21.55
Steam line				9.64		19.87
Steam line				9.15		20.36
Pipe 1 1/2" Bor. A				7.82		21.67
Edge Pavc Bor. "A"				4.13		25.38
Boring "A"				4.7		24.8
Boring "B"				5.0		24.5
Pipe 1 1/2" Bor. B				7.64		21.87
Edge Pavc Bor. "B"				4.22		25.29
Edge Pavc @ Rad. pt. Elm & Center				4.49		25.02
Rail line with Bor. 195				4.61		24.90
Rail				4.63		24.88
Edge Pavc Line Bor. 195				4.80		24.71
End Side walk				4.55		24.96
Elm & Center Rd.				5.04		24.47
Fit & West Rd.				2.20		27.31

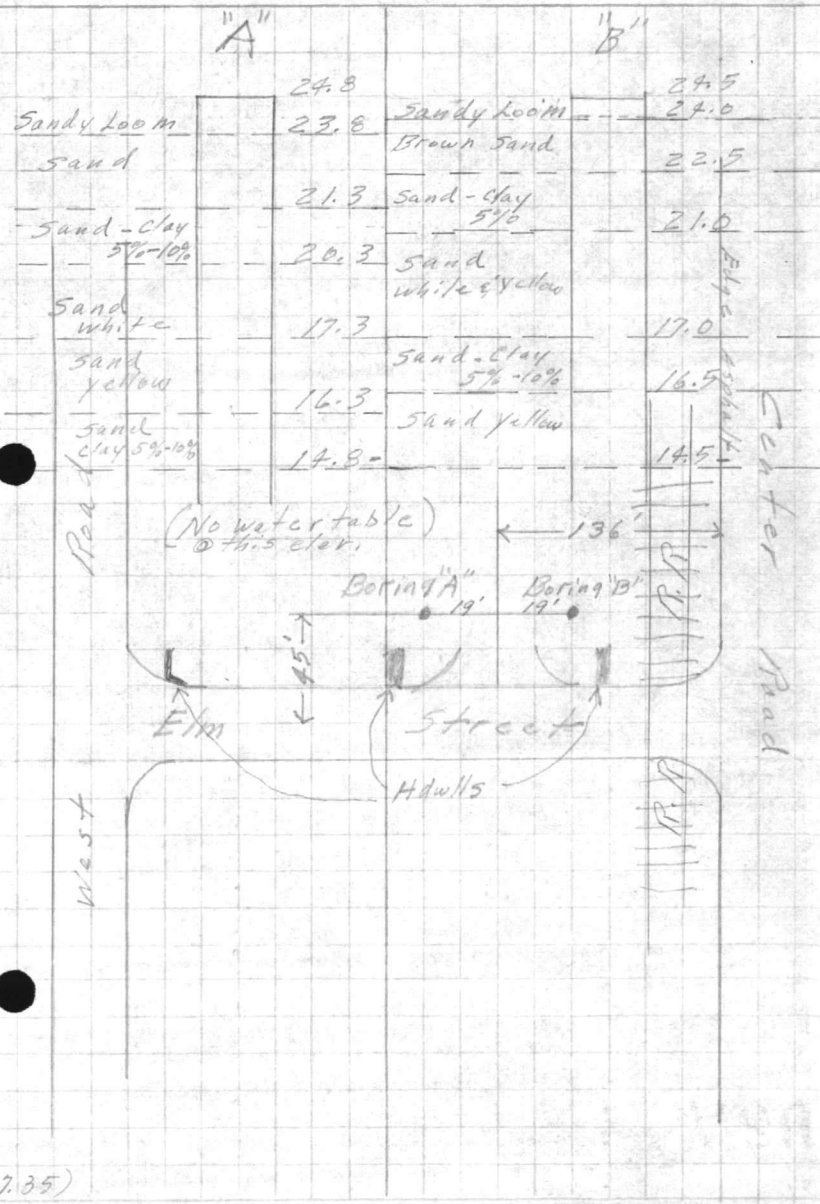

(27.35)








VALUABLE

RETURN TO
PUBLIC WORKS
OFFICE
CAMP LEJEUNE
NORTH CAROLINA

SUBJECT Bench Levels in vicinity
of scale house (proposed)

FIELD PARTY

Paul IN CHARGE
INSTRUMENT
NOTES
TAPE READ
TAPE OR ROD
TAPE OR ROD
INSTRUMENT NO.
TAPE NO.

WEATHER

CLEAR
CLOUDY
WINDY
RAIN
FAIR
SNOW
HOT
MODERATE
COLD
FOG
FIGURED BY
NOTES CHECKED BY
PLOTTED BY

FILE No. _____
FLDR. No. _____
SHEET 104
DATE 1-29 1953

Quad. No. _____

STATION	DIST.	ANGLE			H. I. BEARING	VER: ANG. DIFF.	ELEVATION				
		°	'	"							
Dogwood West Rd.							25.21				
					29.58						
B.M.	TP					3.91	25.67				S.E. Corner TL @ Inter. Elm St. & West Rd.
					29.54						
Dogwood West Rd.						4.36	25.18				(25.21)




































VALUABLE

RETURN TO
PUBLIC WORKS
OFFICE
CAMP LEJEUNE
NORTH CAROLINA

SUBJECT

*Fire alarm cable location
Dogwood Street*

FIELD PARTY

Murphy IN CHARGE
INSTRUMENT
NOTES
TAPES READ
TAPE OR ROD
TAPE OR ROD
INSTRUMENT NO.
TAPE NO.

WEATHER

CLEAR
CLOUDY
WINDY
RAIN
FAIR
SNOW
HOT
MODERATE
COLD
FOG

FILE No. *160-6*

FLDR. No. _____


FIGURED BY _____ SHEET *102*

NOTES CHECKED BY _____

PLOTTED BY _____ DATE *10-22 1953*

Quad. No. _____

STATION	DIST.	ANGLE			H. I. BEARING	VER: ANG. DIFF.	ELEVATION
		°	'	"			

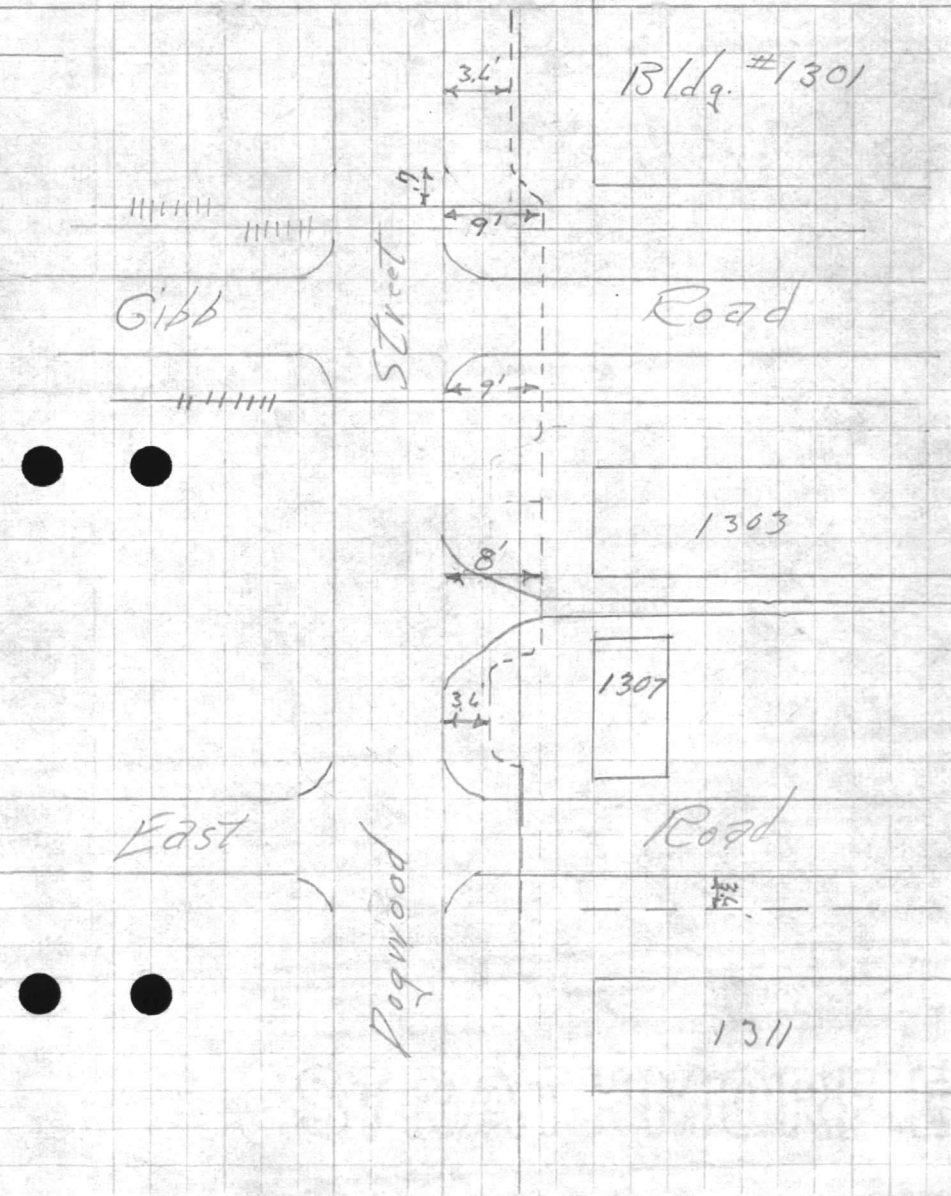
























VALUABLE

SUBJECT _____

RETURN TO
 PUBLIC WORKS
 OFFICE
 CAMP LEJEUNE
 NORTH CAROLINA

FIELD PARTY

_____ IN CHARGE
 _____ INSTRUMENT
 _____ NOTES
 _____ TAPE READ
 _____ TAPE OR ROD
 _____ TAPE OR ROD
 _____ INSTRUMENT No.
 _____ TAPE No.

WEATHER

CLEAR SNOW
 CLOUDY HOT
 WINDY MODERATE
 RAIN COLD
 FAIR FOG
 FIGURED BY _____
 NOTES CHECKED BY _____
 PLOTTED BY _____

FILE No. _____


FLDR. No. _____

SHEET *202*

DATE _____ 19____

Quad. No. _____

STATION	DIST.	ANGLE		H. I.	VER. ANG.	ELEVATION
		° ' "	+	BEARING	DIFF.	

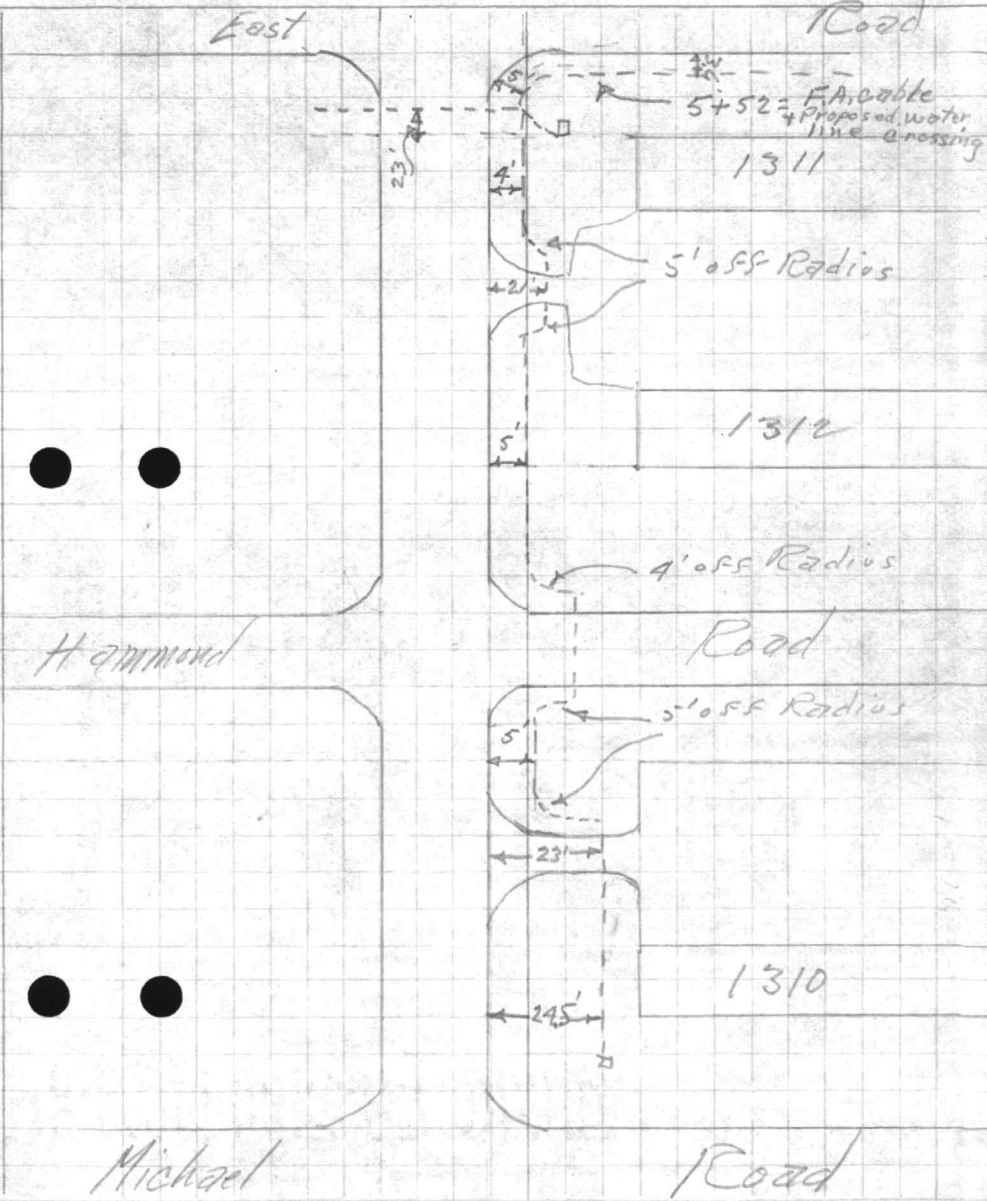

REASON FOR
APPLICANT'S
ACTION
DATE ACTION
APPROVED BY


STATION
DATE

APPROVED BY
DATE

FIELD PARTY
IN CHARGE
STATION
NOTE
DATE
YARD OR ROD
YARD OR ROD
DATE


FIELD PARTY

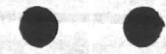

VALUABLE

RETURN TO

OFFICE

CAMP

NO. 1

STATION

AREA

DATE

TIME

END PARTY

CHANGE

WINDY

WEATHER

CLEAR











VALUABLE

SUBJECT LOCATION WATER
GAS LINE NORTH SIDE
GUM ST. BETWEEN WEST
HOLCOMB

RETURN TO
 PUBLIC WORKS
 OFFICE
 CAMP LEJEUNE
 NORTH CAROLINA

FIELD PARTY
DENNIS IN CHARGE
 _____ INSTRUMENT
 _____ NOTES
 _____ TAPE READ
 _____ TAPE OR ROD
 _____ TAPE OR ROD
 _____ INSTRUMENT No.
 _____ TAPE No.

WEATHER
 CLEAR _____ SNOW
 CLOUDY _____ HOT
 WINDY _____ MODERATE
 RAIN _____ COLD
 FAIR _____ FOG
 FIGURED BY _____
 NOTES CHECKED BY _____
 PLOTTED BY _____

FILE No. 160-C
 FLDR. No. _____
 SHEET 1 of 1
 DATE 10-24-1958

Quad. No. _____

STATION	DIST.	ANGLE ° ' "	+	H. I. BEARING	VER: ANG. DIFF.	ELEVATION	
B.m.				287 2963		26765	N. MOST COR. OLD PIT SOUTH OF INT. GUM & WEST
"A"					11 85	16.78	TOP 12" C.I. WATER LINE
"B"					10 07	19.56	TOP 3" GAS LINE
B.m.				340 3145		2805	
					11 82	19.63	TOP 12" X 12" X 12" TFE




































VALUABLE

SUBJECT

Sewer and Water to Bldg # 1711

Industrial Area

RETURN TO
PUBLIC WORKS
OFFICE
CAMP LEJEUNE
NORTH CAROLINA

FIELD PARTY

Morten IN CHARGE

INSTRUMENT

NOTES

TAPE READ

TAPE OR ROD

TAPE OR ROD

INSTRUMENT NO.

TAPE NO.

WEATHER

CLEAR
CLOUDY
WINDY
RAIN
FAIR

SNOW
HOT
MODERATE
COLD
FOG

FIGURED BY

NOTES CHECKED BY

PLOTTED BY

FILE No. *160-6*

FLDR. No.

SHEET

DATE *10/19/56*

Quad. No.


STATION	DIST.	ANGLE ° ' "	+	H. I. BEARING	VER: ANG. DIFF.	ELEVATION
---------	-------	----------------	---	------------------	--------------------	-----------

B.M.						5.25
A						5.23
B						5.25
B.M.						5.25

Int. Michael and Gum

54'

M.H.
55'
13"

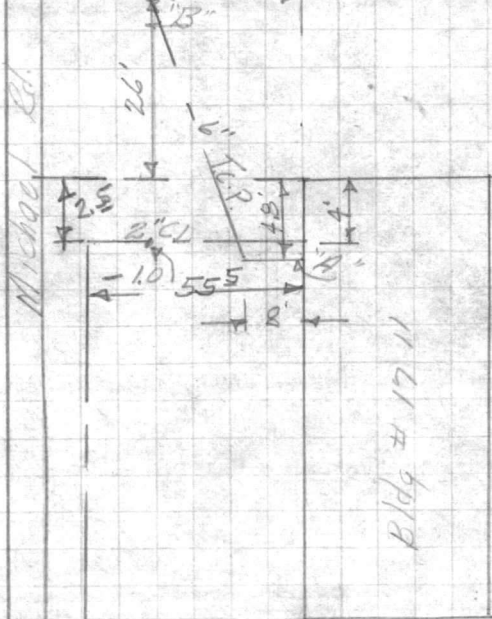

Bldg # 1711

VALUABLE

RETURN TO
PUBLIC WORKS
OFFICE



15' 0" →
9.1°
#



VALUABLE

Return To
Public Works
Office
Camp Lejeune
North Carolina

SUBJECT

Water Line 25

built P.X. filling

Station


FIELD PARTY
F. COOPER In Charge
Instrument
Notes
Tape Read
Tape or Rod
Tape or Rod
Instrument No.
Tape No.

WEATHER
Clear
Cloudy
Windy
Rain
Fair
Snow
Hot
Moderate
Cold
Fog
Figured By
Notes Checked By
Plotted By

FILE No. 160-C
Fldr. No.
Sheet
Date 19

Quad. No.

Station Dist. Angle " + H. I. Bearing Ver: Ang. Diff. Elevation

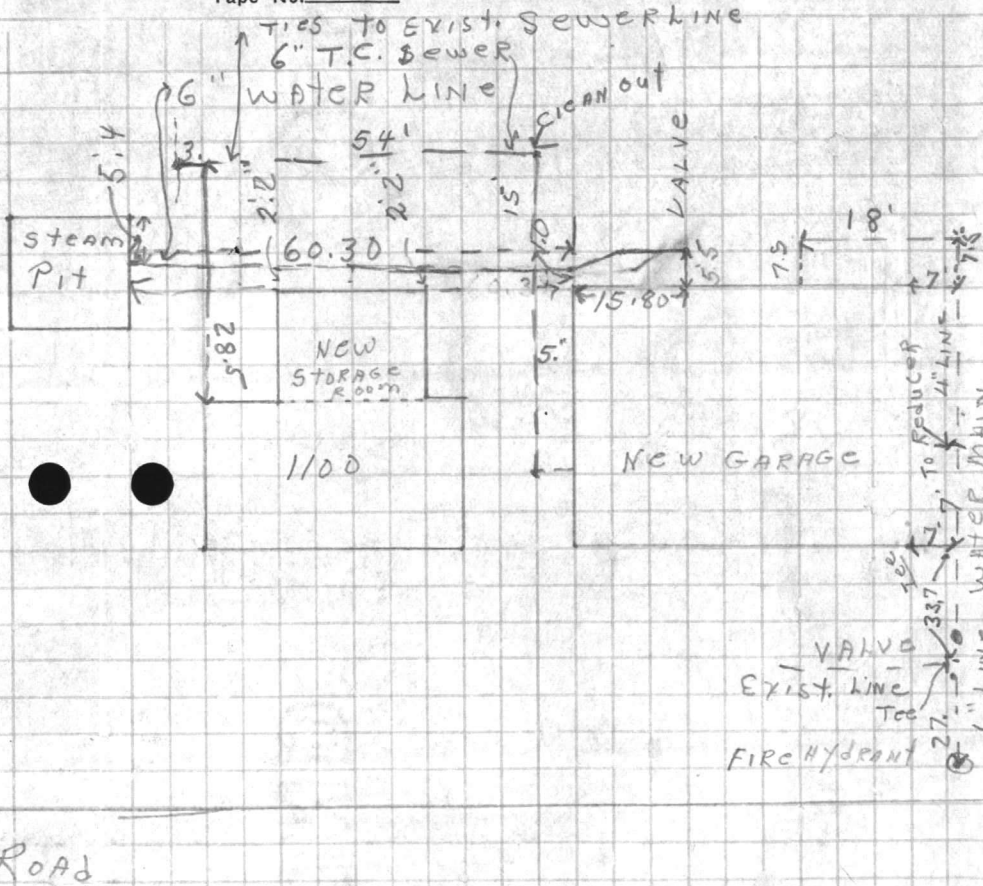

West Road

15.80
27
33.7
12

VALUABLE

Public Works
Office
Camp Lejeune
North Carolina

Station
Date

SUBJECT




















VALUABLE

SUBJECT

P-X-Filling Station

FIELD PARTY

In Charge
Instrument
Notes
Tape Read
Tape or Rod
Tape or Rod
Instrument No.
Tape No.

WEATHER

Clear
Cloudy
Windy
Rain
Fair
Snow
Hot
Moderate
Cold
Fog

FILE No.

160-C

Fldr. No.

Figured By

Sheet

Notes Checked By


Date

5/ 19 49

Plotted By

Quad. No.

Return To
Public Works
Office
Camp Lejeune
North Carolina

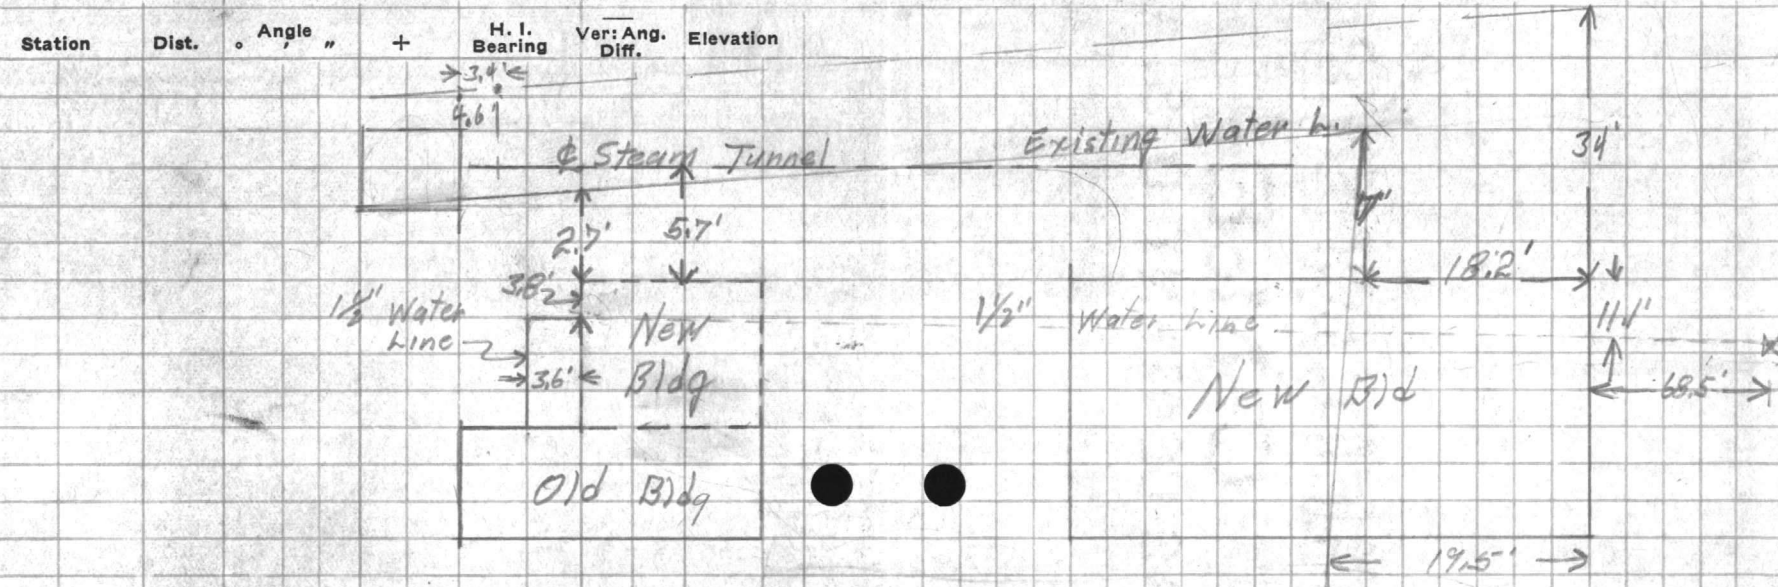

Station Dist. Angle " + H. I. Bearing Ver: Ang. Diff. Elevation

VALUABLE

North Carolina
Camp Lejeune
Office
Public Works
Harris To

SUBJECT

FIELD PARTY

WEATHER
Clear
Snow
Hot
Cloudy
Windy
Mist
Rain
Cold
Fog

In Charge
Instrument
Notes
Tape Head
Type of Rod
Type of Box
In Use
Tape No.

FIELD NO.


DATE

TIME

BY

36
8
288
22

385

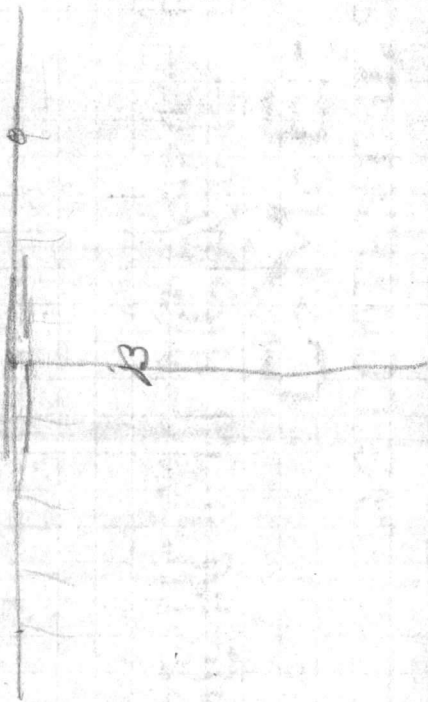

29
11/2
22
40
52

VALUABLE

Return To
Public Works
Office
Camp LeJeune
North Carolina

SUBJECT Under ground ut
ax P. X. Service
Station


FIELD PARTY
Turlington In Charge
Instrument _____
Notes _____
Tape Read _____
Tape or Rod _____
Tape or Rod _____
Instrument No. _____
Tape No. _____

WEATHER
Clear _____
Cloudy _____
Windy _____
Rain _____
Fair _____
Snow _____
Hot _____
Moderate _____
Cold _____
Fog _____
Figured By _____
Notes Checked By _____
Plotted By _____

FILE No. 100-C
Fldr. No. _____
Sheet _____
Date 6-2 49

Quad. No. _____

Station	Dist.	Angle "	H. I.	Ver: Ang.	Elevation
			Bearing	Diff.	

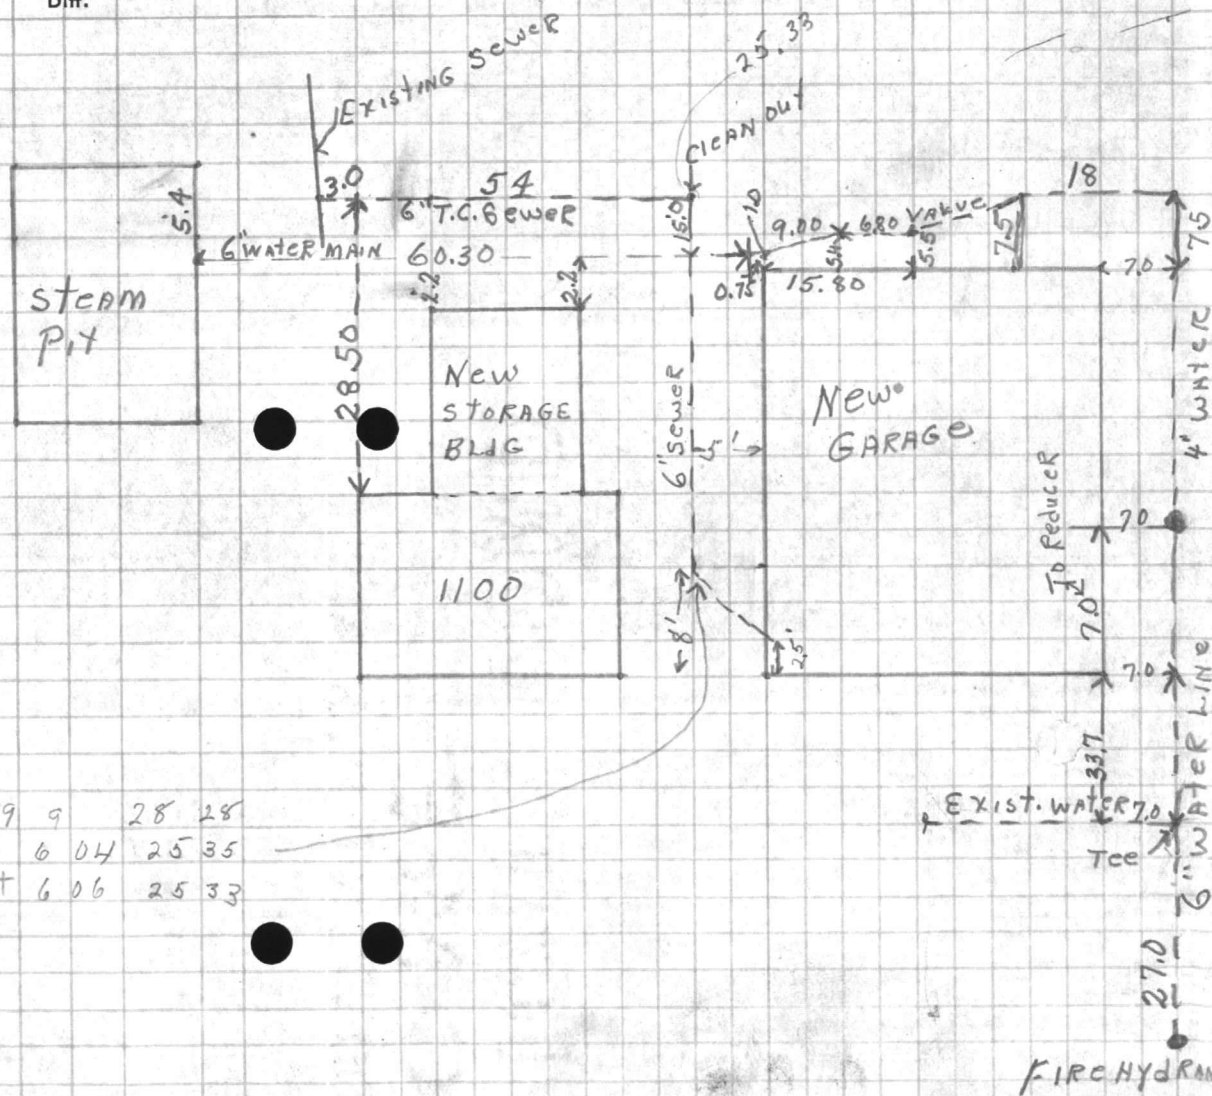

BM	311	31	39	9	28	28
Top Pipe				6	04	25
at clean out				6	06	25

EXIST. WATER 7.0
Tce
6\"/>

Return To
Public Works
Office
Camp Lejeune
North Carolina

SUBJECT _____




72
57 1/2
129 1/2
18
12 1/2
117 1/2
116 1/2
1/2

VALUABLE

SUBJECT Location of 5000 gal
Tanks P.X. filling Sta.

Return To
Public Works
Office
Camp Lejeune
North Carolina

FIELD PARTY

In Charge _____
Instrument _____
Notes _____
Tape Read _____
Tape or Rod _____
Tape or Rod _____
Instrument No. _____
Tape No. _____

WEATHER

Clear _____
Cloudy _____
Windy _____
Rain _____
Fair _____
Snow _____
Hot _____
Moderate _____
Cold _____
Fog _____

FILE No. 160-C


Fldr. No. _____

Sheet 1 of 3

Date 5/7 19 51

Quad. No. _____

Station	Dist.	Angle	+	H. I. Bearing	Ver. Ang. Diff.	Elevation
				440	31.80	27.40
① Tank	5000 Gal.	15.25' x 7.68'		7.95		23.85
② "	"	"	"	7.65		24.15
③ "	"	"	"	8.48		23.32
④ "	"	"	"	9.35		22.45
⑤	3000 Gal.	18.0' x 5'4"		8.45		23.35
⑥	"	"	"	7.43		24.37
BM				440		27.40

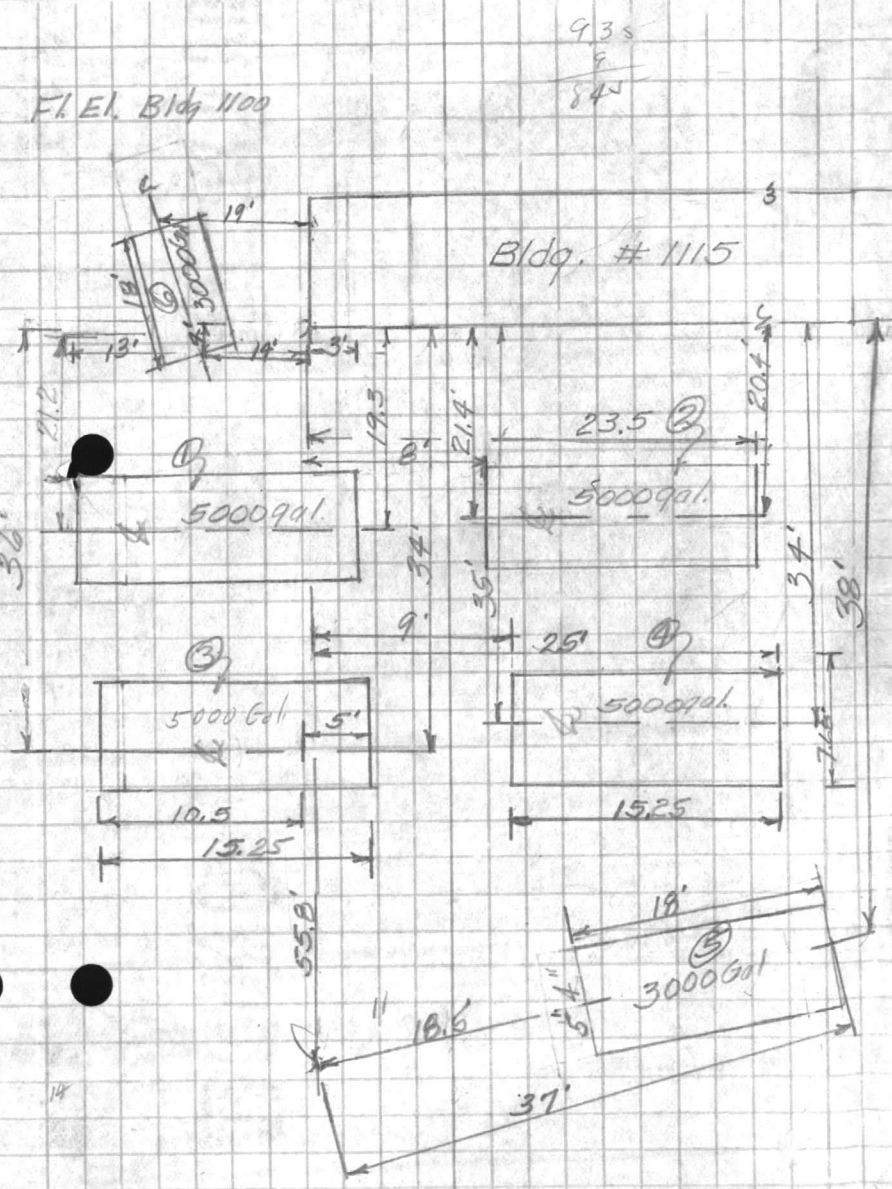



VALUABLE



































VALUABLE

SUBJECT Location of pipes and
Vents At Camp Gas Sta.

Return To
Public Works
Office
Camp Lejeune
North Carolina

FIELD PARTY

In Charge _____
Instrument _____
Notes _____
Tape Read _____
Tape or Rod _____
Tape or Rod _____
Instrument No. _____
Tape No. _____

WEATHER

Clear _____
Cloudy _____
Windy _____
Rain _____
Fair _____
Snow _____
Hot _____
Moderate _____
Cold _____
Fog _____

FILE No. _____

Fldr. No. _____

Sheet 2 of 3

Date 5/7 19 51

Figured By _____


Notes Checked By _____

Plotted By _____

Quad. No. _____

Station	Dist.	Angle	"	+	H. I. Bearing	Ver: Ang. Diff.	Elevation
---------	-------	-------	---	---	---------------	-----------------	-----------

Note:
all Pump lines are 1 1/2"
" VENT " " 2"
" Filling " " 3"

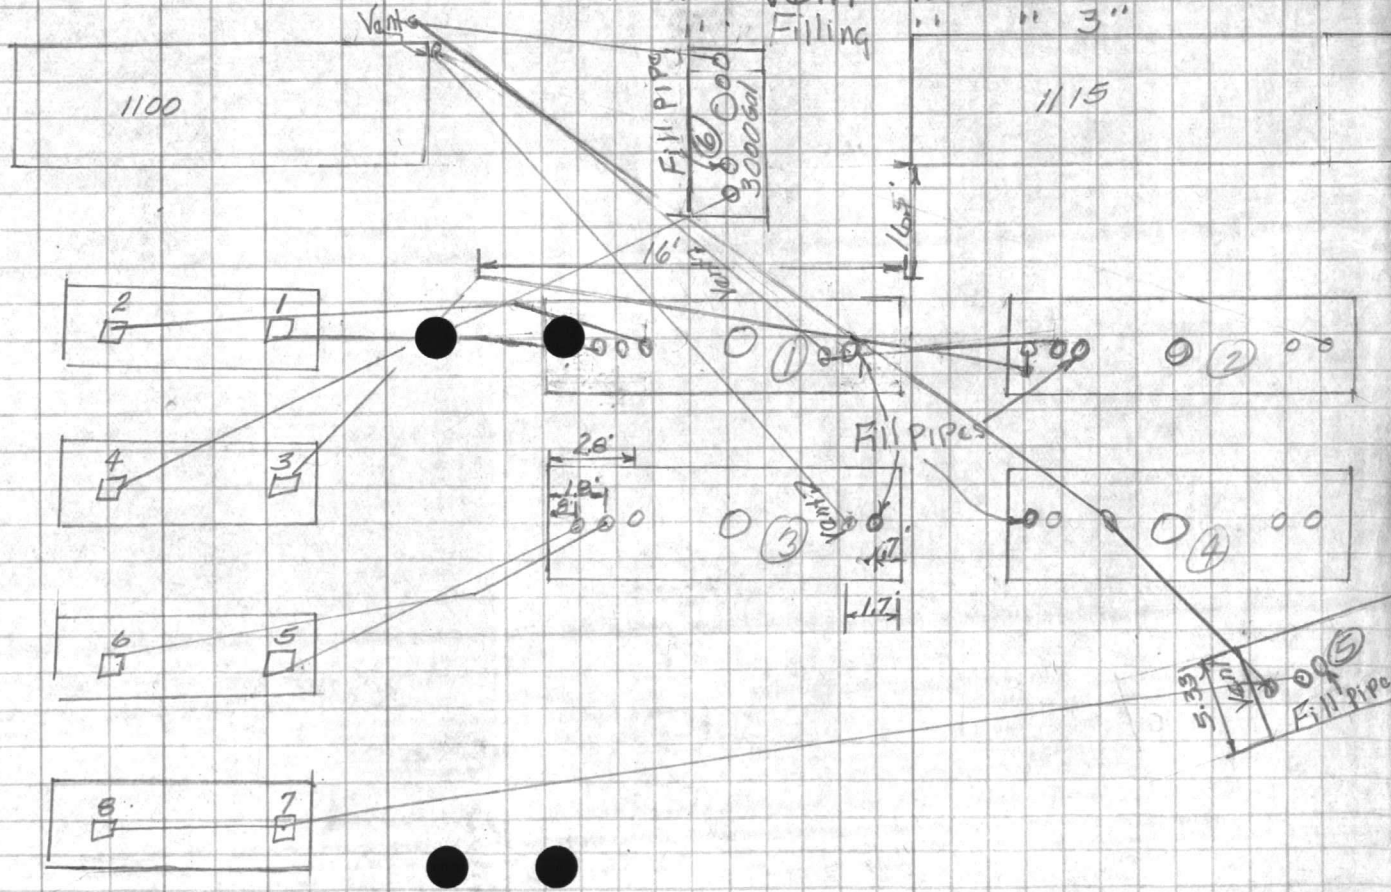





















VALUABLE

Return To
Public Works Office
Camp Lejeune
North Carolina

SUBJECT Location New Pumps
and lines at Camp Filling
Station


FIELD PARTY
In Charge _____
Instrument _____
Notes _____
Tape Read _____
Tape or Rod _____
Tape or Rod _____
Instrument No. _____
Tape No. _____

WEATHER
Clear _____
Cloudy _____
Windy _____
Rain _____
Fair _____
Snow _____
Hot _____
Moderate _____
Cold _____
Fog _____
Figured By _____
Notes Checked By _____
Plotted By _____

FILE No. _____
Fldr. No. _____
Sheet 3 of 3
Date 5/9 1951

Quad. No. _____

Station	Dist.	Angle " "	+	H. I. Bearing	Ver: Ang. Diff.	Elevation
---------	-------	--------------	---	------------------	--------------------	-----------

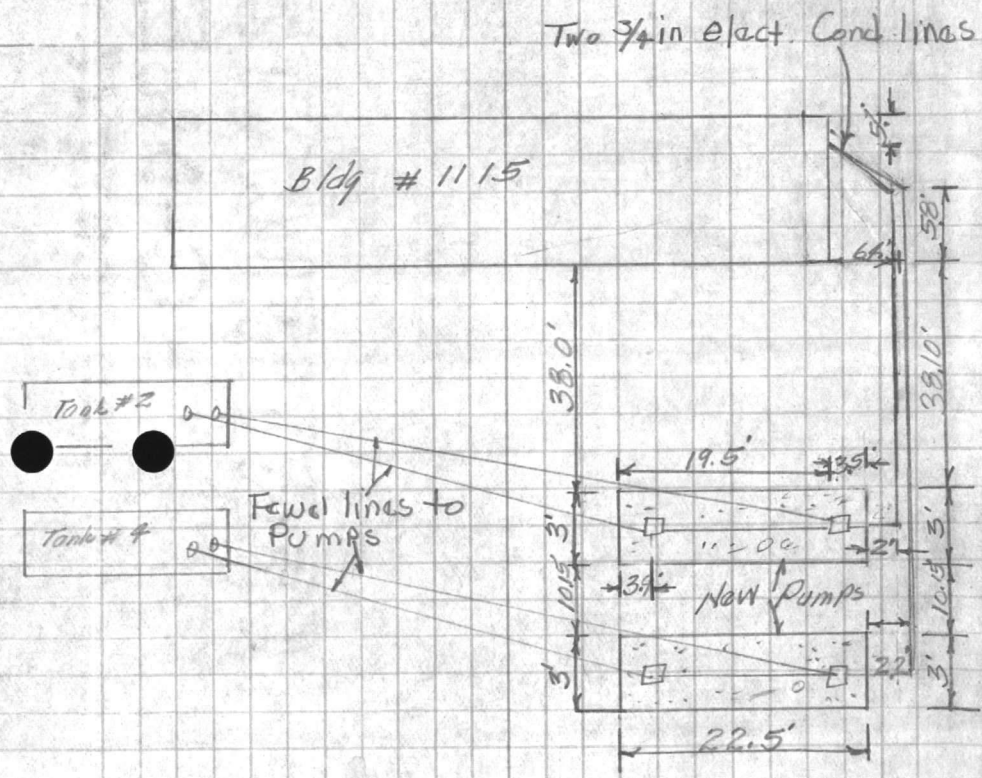




































1.25
VALUABLE

SUBJECT

Loc. Water & Sewer Lines

*Constructed by Maintenance
Industrial Area*

RETURN TO
PUBLIC WORKS
OFFICE
CAMP LEJEUNE
NORTH CAROLINA

FIELD PARTY

Martin IN CHARGE
INSTRUMENT
NOTES
TAPE READ
TAPE OR ROD
TAPE OR ROD
INSTRUMENT No.
TAPE No.

WEATHER

CLEAR
CLOUDY
WINDY
RAIN
FAIR

SNOW
HOT
MODERATE
COLD
FOG

FILE No. *160-C*

FLDR. No.


FIGURED BY SHEET *101*

NOTES CHECKED BY DATE *7/24/1952*

PLOTTED BY

Quad. No.

STATION	DIST.	ANGLE " "	+	H. I. BEARING	VER. ANG. DIFF.	ELEVATION
B.M.				2.02	29.52	27.50
A					10.84	
B	<i>Top m.H.</i>				4.91	
C	<i>Inv. in M.H.</i>				10.20	
B.M.				3.12		27.50 (<i>lot Hammond and Fir St.</i>)
"D"	<i>Top 6" T.C.P. Sewer</i>				6.33	
B.M.					3.12	
E	<i>2" Water Line 15' below top Ground</i>					
"F"	<i>2" Water Line 1' " " Asphalt</i>					

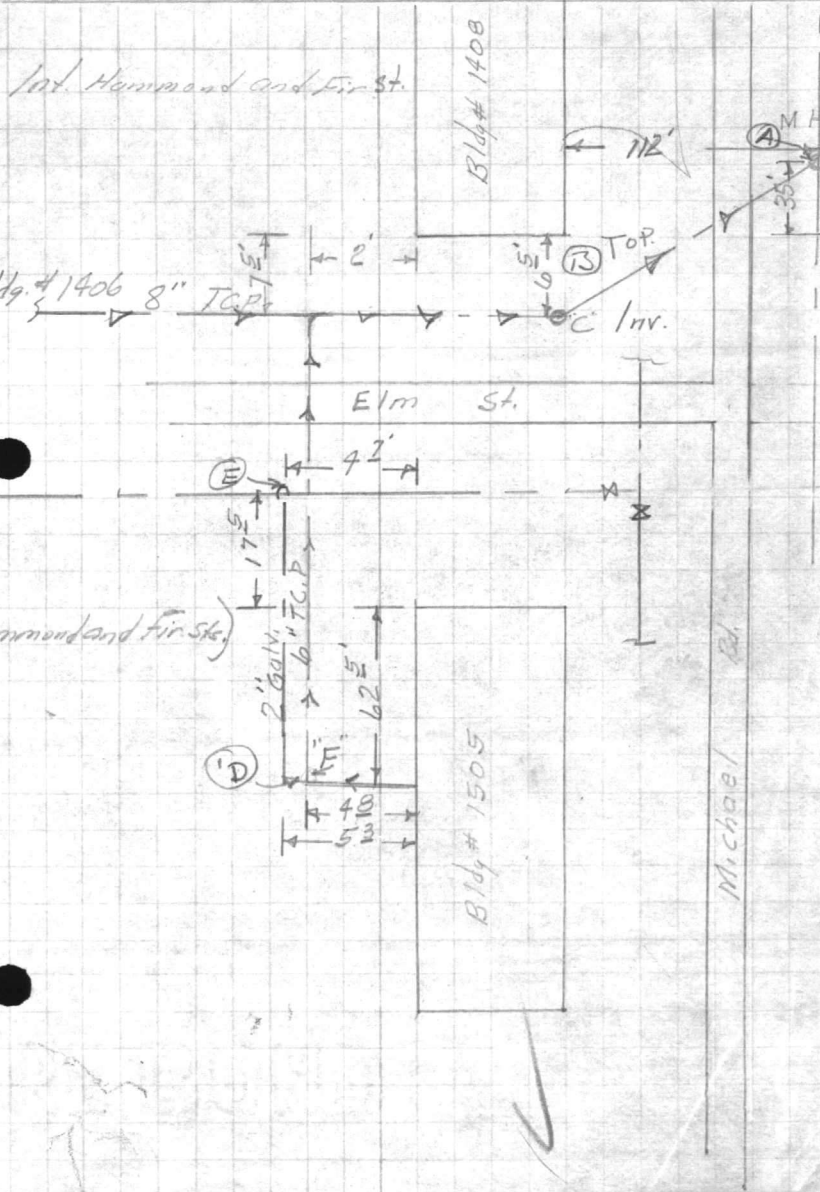






VALUABLE
 SUBJECT _____

 RETURN TO
 PUBLIC WORKS
 OFFICE
 CAMP LEJEUNE
 NORTH CAROLINA

FIELD PARTY

 _____ IN CHARGE
 _____ INSTRUMENT
 _____ NOTES
 _____ TAPE READ
 _____ TAPE OR ROD
 _____ TAPE OR ROD
 _____ INSTRUMENT NO.
 _____ TAPE NO.

WEATHER

 CLEAR
 CLOUDY
 WINDY
 RAIN
 FAIR
 SNOW
 HOT
 MODERATE
 COLD
 FOG

FILE No. _____


FLDR. No. _____

SHEET 20f

DATE _____ 19__

Quad. No. _____

STATION	DIST.	ANGLE ° ' "	+	H. I. BEARING	VER. ANG. DIFF.	ELEVATION
B.M.				29.52		27.50
"A"					8.34	
B					5.62	
C					3.52	
"D"					4.61	
B.M.					2.02	

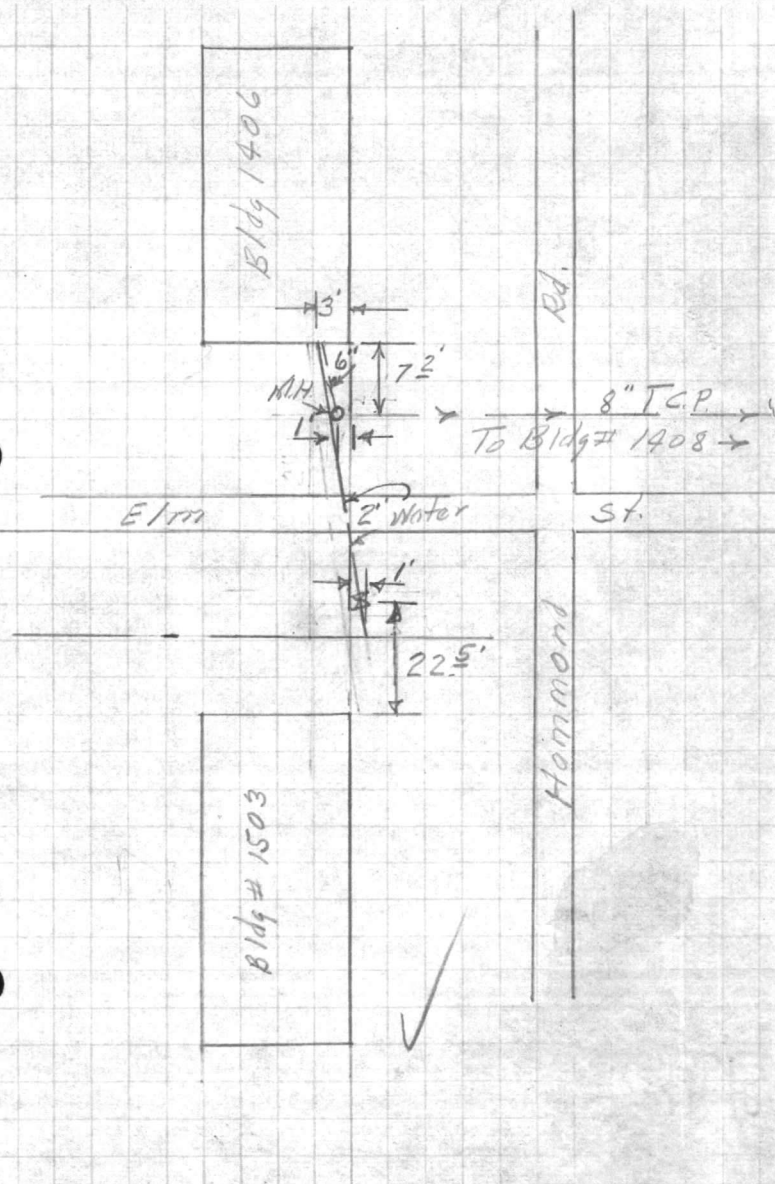

5.08
1.25

6.33







VALUABLE

SUBJECT _____

RETURN TO
 PUBLIC WORKS
 OFFICE
 CAMP LEJEUNE
 NORTH CAROLINA

FIELD PARTY

_____ IN CHARGE
 _____ INSTRUMENT
 _____ NOTES
 _____ TAPE READ
 _____ TAPE OR ROD
 _____ TAPE OR ROD
 _____ INSTRUMENT NO.
 _____ TAPE NO.

WEATHER

CLEAR SNOW
 CLOUDY HOT
 WINDY MODERATE
 RAIN COLD
 FAIR FOG

FILE No. _____

FLDR. No. _____


SHEET 301

NOTES CHECKED BY _____

PLOTTED BY _____ DATE _____ 19__

Quad. No. _____

STATION	DIST.	ANGLE		+	H. I. BEARING	VER: ANG. DIFF.	ELEVATION
		°	' "				
B.M.				4.88	32.38		27.50
A	In. 6" T.C.P. in MH					6.05	
"B"	Top 6" T.C.P. of Bldg #1704					3.50	
B.M.				4.88			

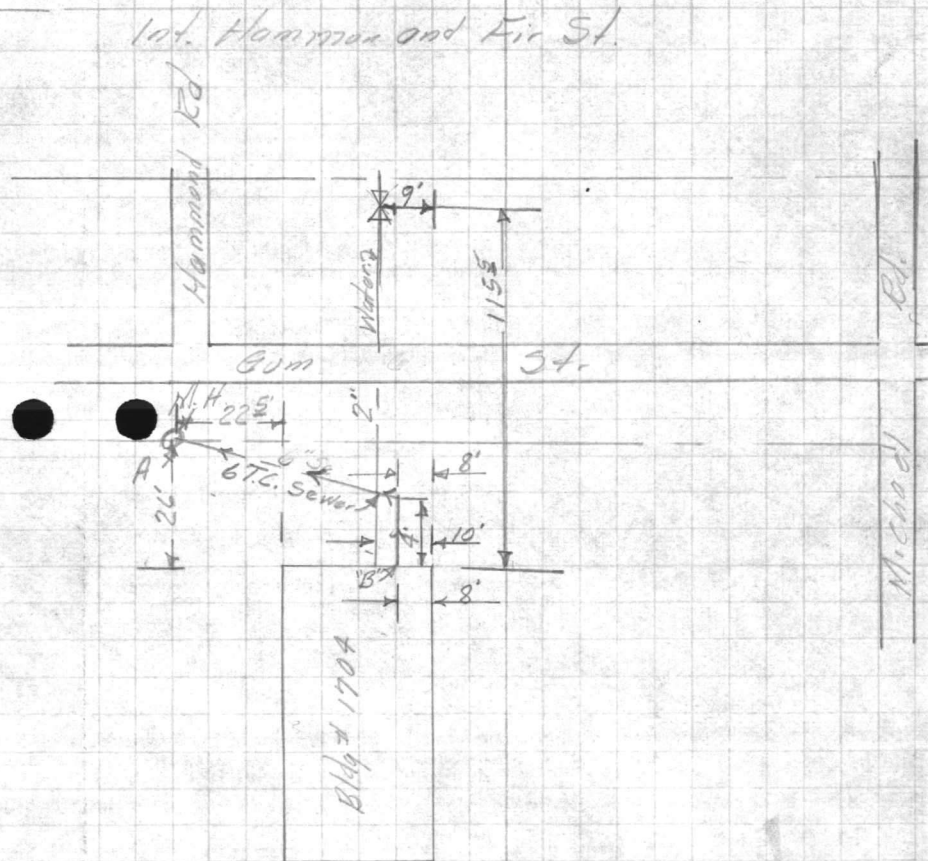


















VALUABLE

SUBJECT _____

RETURN TO
 PUBLIC WORKS
 OFFICE
 CAMP LEJEUNE
 NORTH CAROLINA

FIELD PARTY

 IN CHARGE

 INSTRUMENT

 NOTES

 TAPE READ

 TAPE OR ROD

 TAPE OR ROD

 INSTRUMENT NO. _____
 TAPE NO. _____

WEATHER

CLEAR
 CLOUDY
 WINDY
 RAIN
 FAIR
 SNOW
 HOT
 MODERATE
 COLD
 FOG
 FIGURED BY _____
 NOTES CHECKED BY _____
 PLOTTED BY _____

FILE No. _____
 FLDR. No. _____
 SHEET 4 "A" OF
 DATE _____ 19__

Quad. No. _____

STATION	DIST.	ANGLE ° ' "	+	H. I. BEARING	VER: ANG. DIFF.	ELEVATION	
BM.				1.94	3254	29.94	Int. East Road and Cedar St.
"A"				Top 6" T.C.P.	4.44		
"B"				Inv. in M.H.	6.59		
"C"				Top M.H.	3.08		
D				Top 6" T.C.P.	4.37		
E				" " "	4.15		
F				Inv. in M.H.	7.40		
G				Top M.H.	2.94		
H				Inv. 8" T.C.P.	8.12		












VALUABLE

SUBJECT _____

RETURN TO
PUBLIC WORKS
OFFICE
CAMP LEJEUNE
NORTH CAROLINA

FIELD PARTY

IN CHARGE

INSTRUMENT

NOTES

TAPE READ

TAPE OR ROD

TAPE OR ROD

INSTRUMENT NO.

TAPE NO.

WEATHER

CLEAR SNOW
CLOUDY HOT
WINDY MODERATE
RAIN COLD
FAIR FOG

FILE No. _____

FLDR. No. _____

FIGURED BY _____

SHEET

NOTES CHECKED BY _____


DATE

PLOTTED BY _____

19 _____

Quad. No. _____

STATION	DIST.	ANGLE			+	H. I. BEARING	VER. ANG. DIFF.	ELEVATION
		°	'	"				

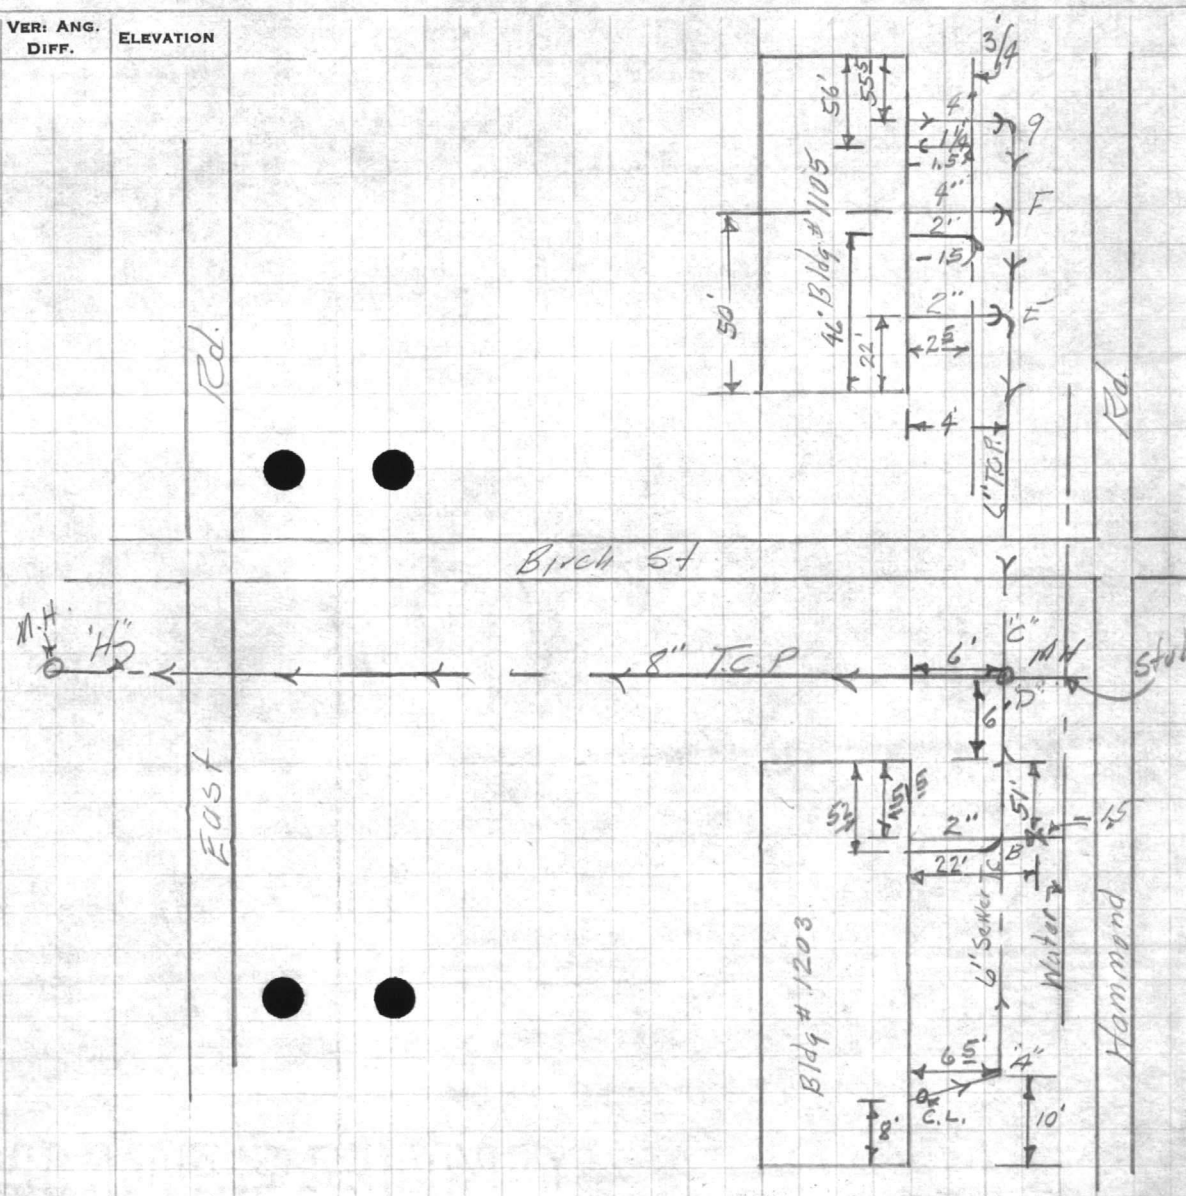






VALUABLE

SUBJECT _____

RETURN TO
 PUBLIC WORKS
 OFFICE
 CAMP LEJEUNE
 NORTH CAROLINA

FIELD PARTY

 IN CHARGE

 INSTRUMENT

 NOTES

 TAPE READ

 TAPE OR ROD

 TAPE OR ROD

 INSTRUMENT NO. _____
 TAPE NO. _____

WEATHER

CLEAR
 CLOUDY
 WINDY
 RAIN
 FAIR

SNOW
 HOT
 MODERATE
 COLD
 FOG

FILE No. _____

FLDR. No. _____

FIGURED BY _____ SHEET 5 "A" of

NOTES CHECKED BY _____

PLOTTED BY _____ DATE _____ 19__

Quad. No. _____

STATION	DIST.	ANGLE ° ' "	+	H. I. BEARING	VER. ANG. DIFF.	ELEVATION	
B.M.				3.64 34.04		30.40	Int. Hammond and Birch
A					5.68		
B					6.19		
C				100 in M.H.	8.00	26.04	
D				TOP M.H.	4.20	29.84	
E					6.38		
F					6.16		
G					5.53	28.51	34.04 8.00 ----- 26.04
H					9.02		34.04 4.20 ----- 29.84
B.M.					3.64	30.40	34.4 9.20 ----- 30.2




















VALUABLE

SUBJECT _____

RETURN TO
PUBLIC WORKS
OFFICE
CAMP LEJEUNE
NORTH CAROLINA

FIELD PARTY
DENNIS IN CHARGE

INSTRUMENT

NOTES

TAPE READ

TAPE OR ROD

TAPE OR ROD

INSTRUMENT No. _____
TAPE No. _____

WEATHER
CLEAR
CLOUDY
WINDY
RAIN
RAIN
FAIR
SNOW
HOT
MODERATE
COLD
FOG
FIGURED BY _____
NOTES CHECKED BY _____
PLOTTED BY _____

FILE No. _____
FLDR. No. _____
SHEET 2 of 2
DATE 6-8 1959

Quad. No. _____

STATION	DIST.	ANGLE " "	+	H. I. BEARING	VER: ANG. DIFF.	ELEVATION	
B.m.				598 34 19	✓	28 21	ON STEAM TUNNEL ACROSS ST. FROM GAS. STA.
"A"					8.41	25.58	FLOOR PUMP STA.
"B"					8.06 8.43	25.76	} TOP 4" C.I. SEWER LINE INV.
"C"					8.06 8.43	25.76	
"D"					8.00 8.37	25.82	} INV. TOP 4" C.I. SEWER LINE
"E"					8.41	25.78	
F					9.00	25.19 (25.20)	FL. LINE 6" T.C. SEWER LINE IN M. H.
					5.42	28.77	TOP M. H.
B.m				598		28.21	SAME AS ABOVE

























VALUABLE

SUBJECT

Loc. Water & Sewer Lines
Constructed by Maintenance

RETURN TO
PUBLIC WORKS
OFFICE
CAMP LEJEUNE
NORTH CAROLINA

Industrial Area

FIELD PARTY

Horton IN CHARGE

INSTRUMENT

NOTES

TAPE READ

TAPE OR ROD

TAPE OR ROD

TRUMENT NO.

TAPE No.

WEATHER

CLEAR
CLOUDY
WINDY
RAIN
FAIR

SNOW
HOT
MODERATE
COLD
FOG

FIGURED BY

NOTES CHECKED BY

PLOTTED BY

FILE No. 1160-C

FLDR. No.


SHEET 105

DATE 7/29/

1956

Quad. No.

STATION	DIST.	ANGLE			+	H. I. BEARING	VER. ANG. DIFF.	ELEVATION
		°	'	"				

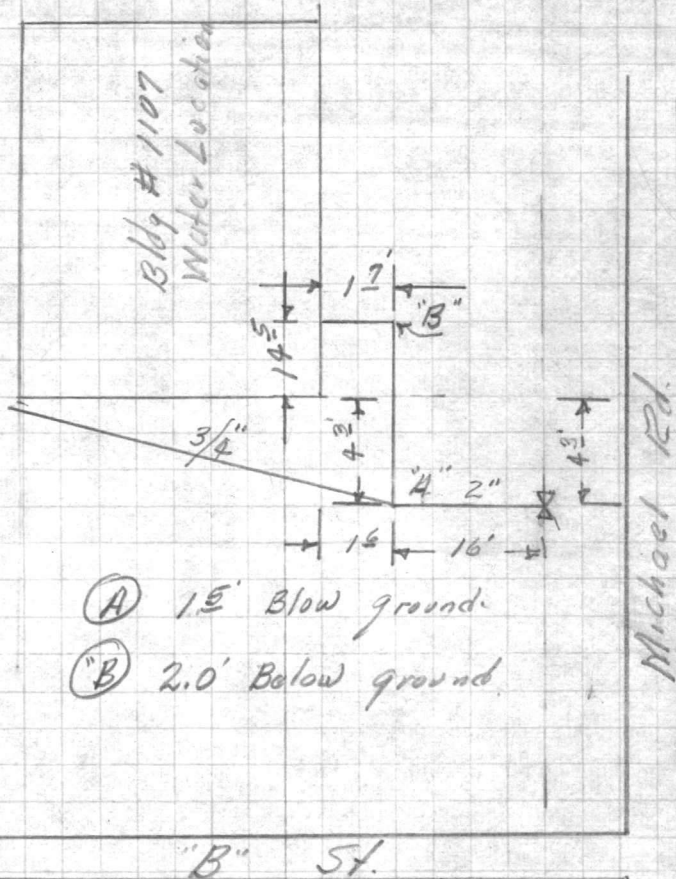

VALUABLE




























VALUABLE

SUBJECT _____
_____ *8.12* _____

RETURN TO
PUBLIC WORKS
OFFICE
CAMP LEJEUNE
NORTH CAROLINA

FIELD PARTY

IN CHARGE

INSTRUMENT

NOTES

TAPE READ

TAPE OR ROD

TAPE OR ROD

INSTRUMENT NO.

TAPE NO.

WEATHER

CLEAR SNOW
CLOUDY HOT
WINDY MODERATE
RAIN COLD
FAIR FOG
FIGURED BY _____
NOTES CHECKED BY _____
PLOTTED BY _____


FILE No. _____
FLDR. No. _____
SHEET *2 of* _____
DATE _____ 19__

Quad. No. _____

STATION	DIST.	ANGLE ° ' "	+	H. I. BEARING	VER. ANG. DIFF.	ELEVATION
B.M.				4.53 34.54		30.01

on Steam Pit H.W. Bldg. #1110

A				7.82	26.72	
B				7.45		
C				6.20		
D				8.15		
B.M.				4.53		

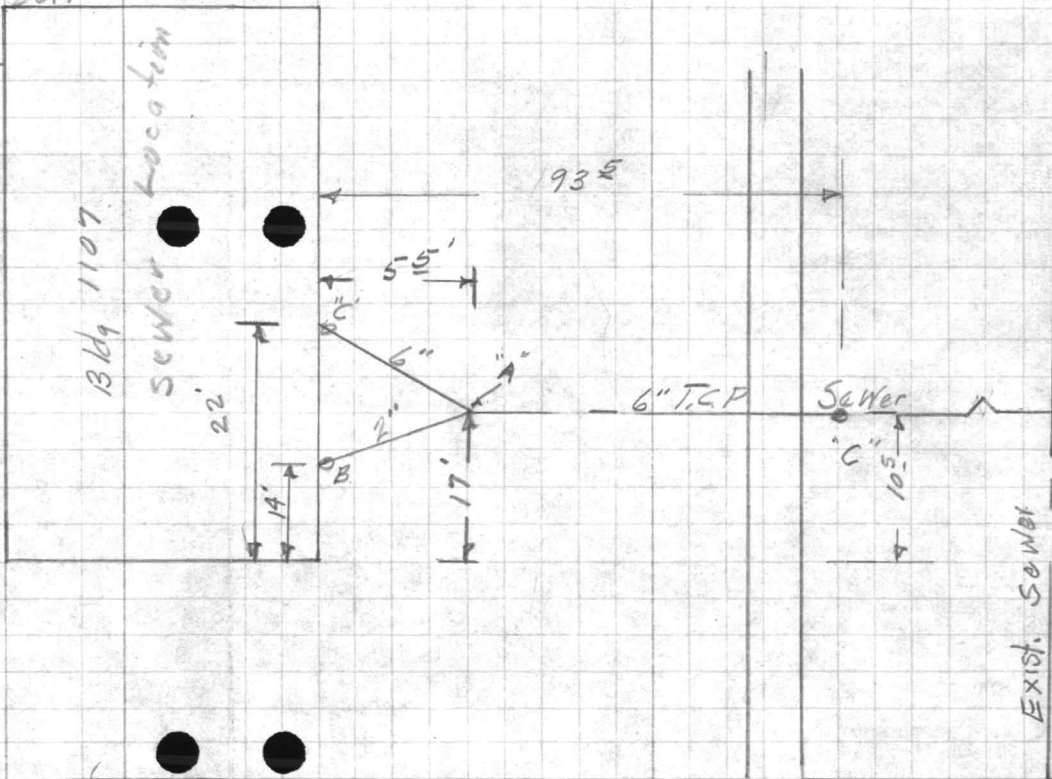




















VALUABLE

SUBJECT _____

 RETURN TO
 PUBLIC WORKS
 OFFICE
 CAMP LEJEUNE
 NORTH CAROLINA

FIELD PARTY

 _____ IN CHARGE
 _____ INSTRUMENT
 _____ NOTES
 _____ TAPE READ
 _____ TAPE OR ROD
 _____ TAPE OR ROD
 _____ INSTRUMENT NO.
 _____ TAPE NO.

WEATHER

 CLEAR SNOW
 CLOUDY HOT
 WINDY MODERATE
 RAIN COLD
 FAIR FOG

FILE No. _____

FLDR. No. _____


SHEET *3 of* _____

FIGURED BY _____ NOTES CHECKED BY _____

PLOTTED BY _____ DATE _____ 19__

Quad. No. _____

STATION	DIST.	ANGLE ° ' "	+	H. I. BEARING	VER. ANG. DIFF.	ELEVATION
B.M.				0.80 34.20		33.40
"A"				Top pipe	5.88	
"B"				" "	8.48	
"C"				2" Water line - 1.6 Below Top Ground		
B.M.					0.180	

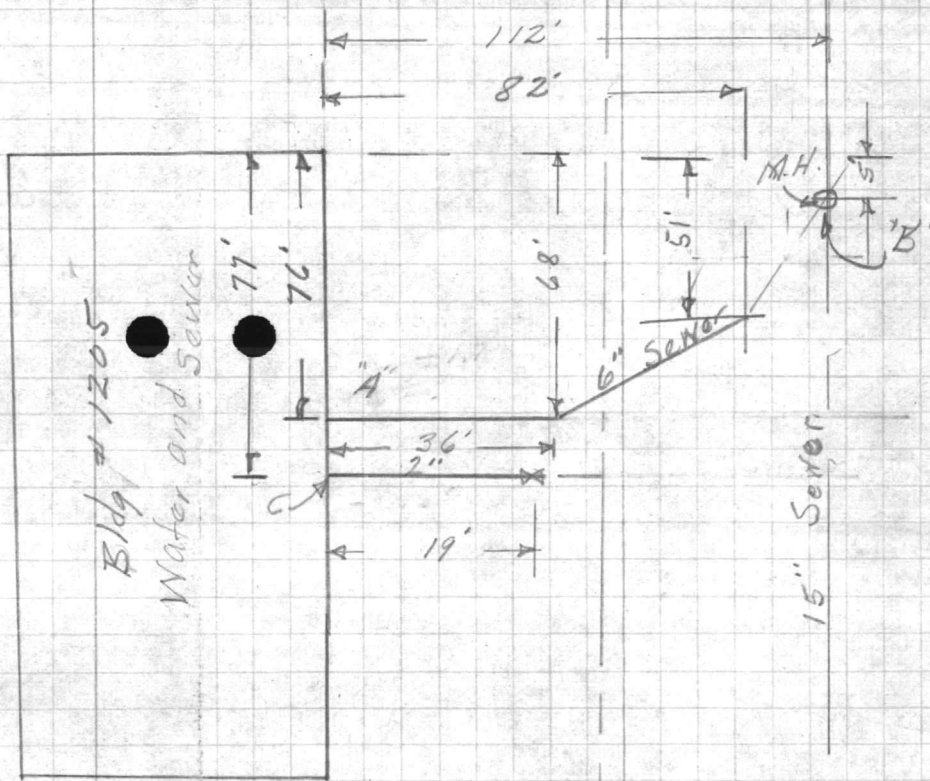

VALUABLE

SUBJECT _____

RETURN TO
 PUBLIC WORKS
 OFFICE
 CAMP LEJEUNE
 NORTH CAROLINA

FIELD PARTY

_____ IN CHARGE
 _____ INSTRUMENT
 _____ NOTES
 _____ TAPE READ
 _____ TAPE OR ROD
 _____ TAPE OR ROD
 _____ INSTRUMENT NO.
 _____ TAPE NO.


WEATHER

CLEAR SNOW
 CLOUDY HOT
 WINDY MODERATE
 RAIN COLD
 FAIR FOG
 FIGURED BY _____
 NOTES CHECKED BY _____
 PLOTTED BY _____

FILE No. _____
 FLDR. No. _____
 SHEET 4 of _____
 DATE _____ 19__

Quad. No. _____

STATION	DIST.	ANGLE ° ' "	+	H. I. BEARING	VER. ANG. DIFF.	ELEVATION
B.M.				2.51 33.41		30.90
"A"				33.4	6.30 27 01	
"B"				Top M.H.	4.22 29 19	
"C"				Inv.	6.50 26 91	
"D"					7.83 25 58	
B.M.				2.51 30 90		30.90
B.M.				2.84 33.74		30.90
"E"				Top pipe	8.48 25 26	
"F"					6.5 27 24	
B.M.				2.84 30 90		30.90

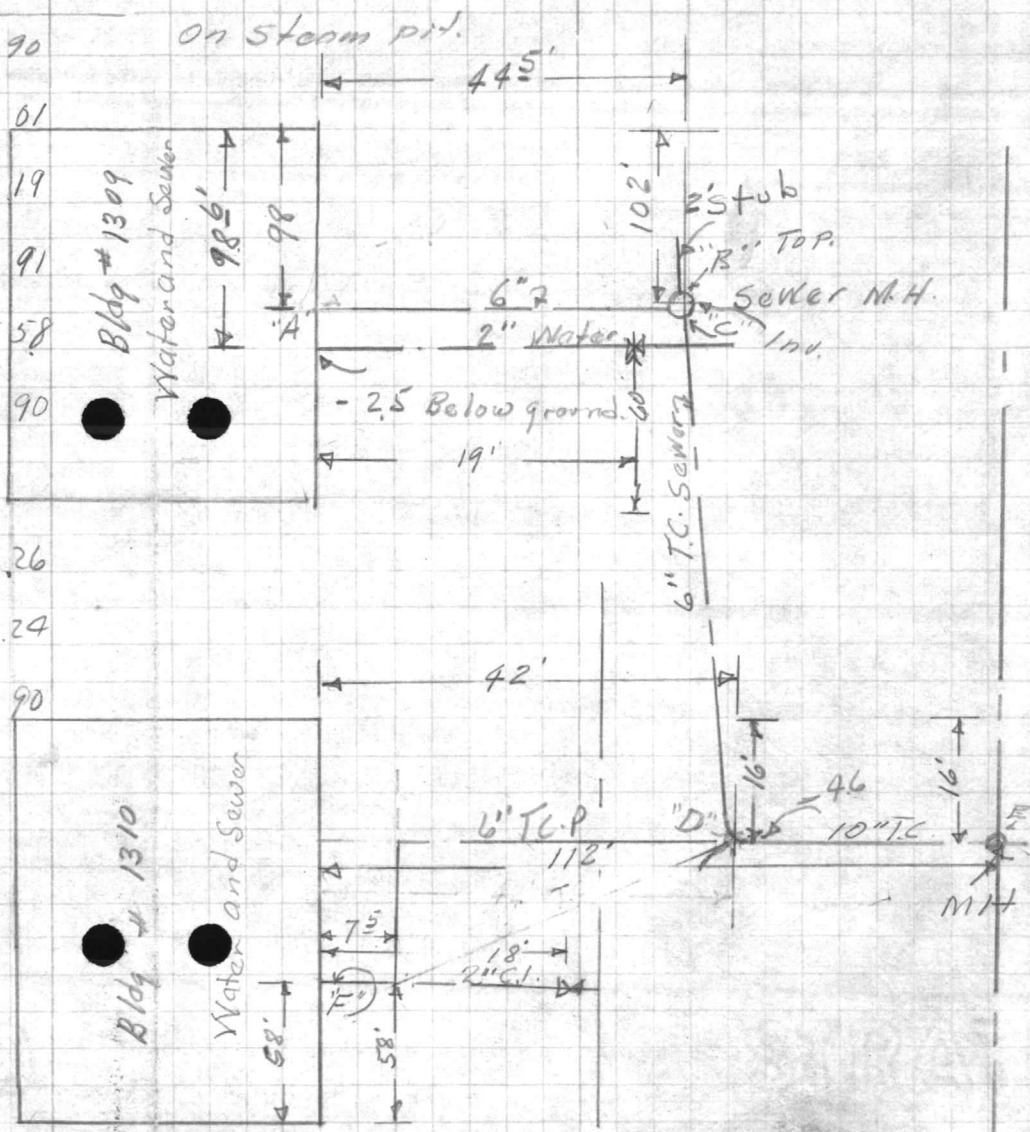

VALUABLE

SUBJECT _____

RETURN TO
 PUBLIC WORKS
 OFFICE
 CAMP LEJEUNE
 NORTH CAROLINA

6.93
 8.3
 15.23

FIELD PARTY

_____ IN CHARGE
 _____ INSTRUMENT
 _____ NOTES
 _____ TAPE READ
 _____ TAPE OR ROD
 _____ TAPE OR ROD
 _____ INSTRUMENT NO.
 _____ TAPE NO.

WEATHER

CLEAR SNOW
 CLOUDY HOT
 WINDY MODERATE
 RAIN COLD
 FAIR FOG

FILE No. _____

FLDR. No. _____


SHEET 50f

FIGURED BY _____
 NOTES CHECKED BY _____

PLOTTED BY _____ DATE _____ 19__

Quad. No. _____

STATION	DIST.	ANGLE ° ' "	+	H. I. BEARING	VER. ANG. DIFF.	ELEVATION
B.M.			2.84	33.74		30.90
"A"					15.23	
"B"				10.3	23 4	
"C"				7.25		
				2.84		

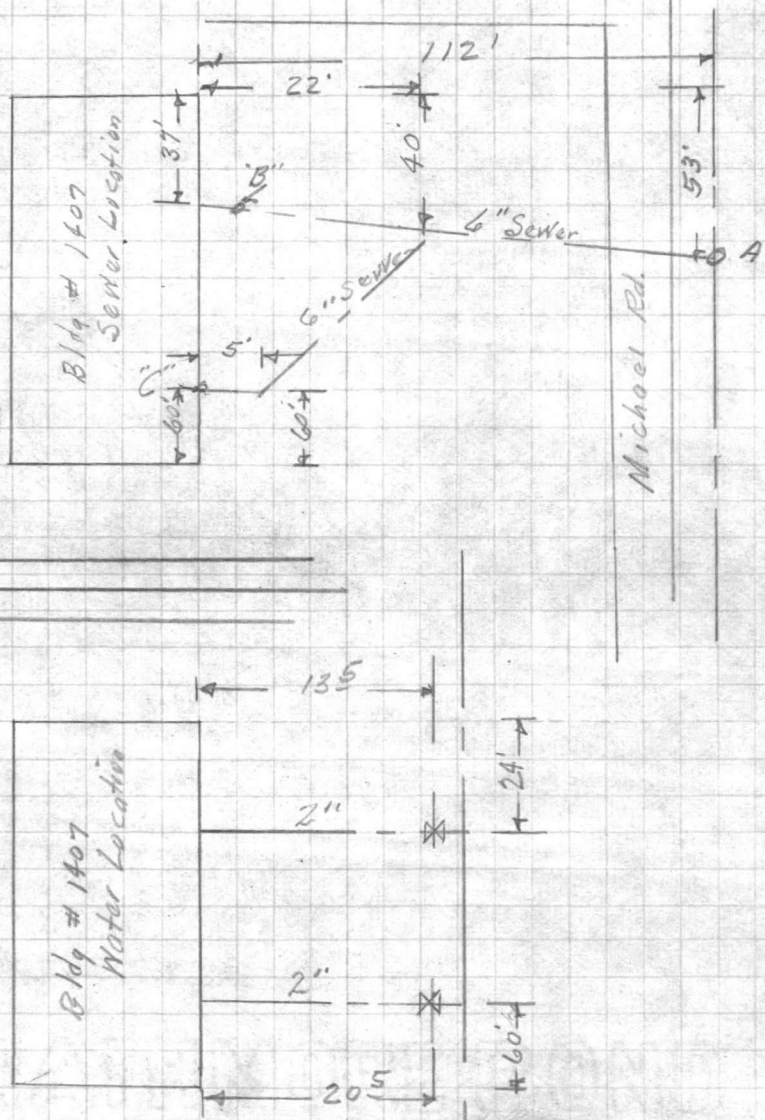




























