

VALUABLE


SUBJECT Loc. Water Lines to
Field House & Football Field

Return To
 Public Works
 Office
 Camp Lejeune
 North Carolina

FIELD PARTY
Turkington In Charge
 Instrument _____
 Notes _____
 Tape Read _____
 Tape or Rod _____
 Tape or Rod _____
 ment No. _____
 Tape No. _____

WEATHER
 Clear _____
 Cloudy _____
 Windy _____
 Rain _____
 Fair _____
 Snow _____
 Hot _____
 Moderate _____
 Cold _____
 Fog _____
 FILE No. 160-G
 Fldr. No. _____
 Sheet #6
 Date 9/8 1949
 Figured By _____
 Notes Checked By _____
 Plotted By _____
 Quad. No. _____

| Station | Dist. | Angle | H. I. Bearing | Ver: Ang. Diff. | Elevation |
|----------|-------|---|---------------|-----------------|-----------|
| Mon #191 | | | | | 28.32 |
| | | 3.60 | 31.92 | | |
| 5+86.9 | | 6"X4" Tee to Bldg | 6.85 | | 25.07 |
| 6+09.7 | | 6"X6" Tee to F.H. | 7.00 | | 24.9 |
| 6+11 | | 6" to 4" Reduct | Begin | | |
| 6+13.6 | | | Ends | | |
| 6+15.8 | | 4" valve | | | |
| +46.7 | | Bldg Line | 6.80 | | |
| 75' | | | 6.12 | | |
| 98.1 | | 4" Valve with T Behind with 3" line out | Right | | |
| Mon #191 | | | 3.60 | | |

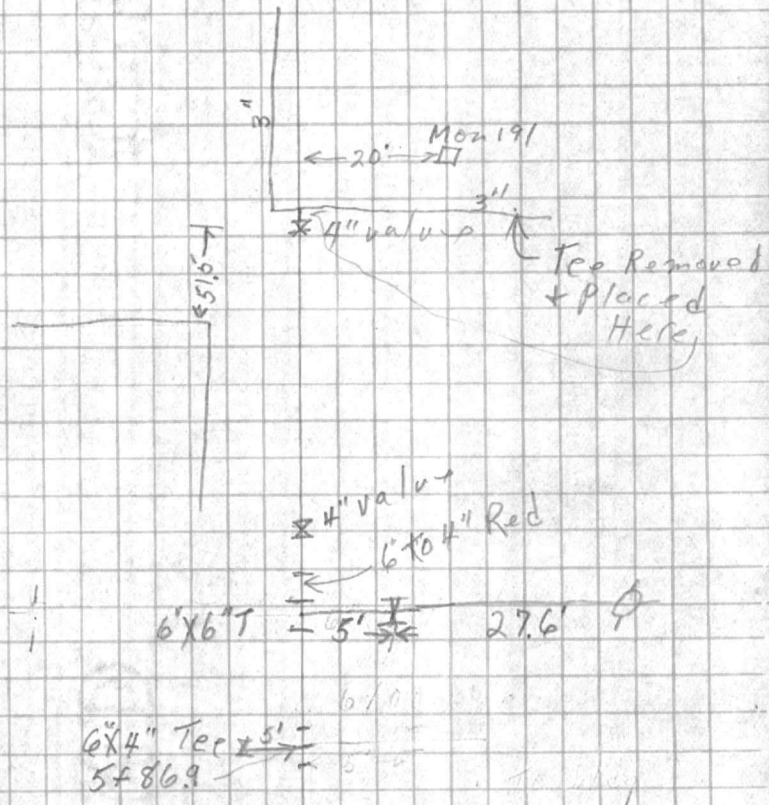













 

VALUABLE

SUBJECT Water Dist. as built

Field House

Return To
Public Works
Office
Camp Lejeune
North Carolina

FIELD PARTY

____ In Charge
____ Instrument
____ Notes
____ Tape Read
____ Tape or Rod
____ Tape or Rod
____ Instrument No.
____ Tape No.

WEATHER

Clear _____
Cloudy _____
Windy _____
Rain _____
Fair _____
Snow _____
Hot _____
Moderate _____
Cold _____
Fog _____

FILE No. 160-G

Fldr. No. _____

Figured By _____ Sheet 1

Notes Checked By _____


Plotted By _____ Date 9/19/49

Quad. No. _____


| Station | Dist. | Angle " | + | H. I. Bearing | Ver. Ang. Diff. | Elevation |
|---------|-------|---------|---|---------------|-----------------|-----------|
|---------|-------|---------|---|---------------|-----------------|-----------|

9417

← 258.1' →

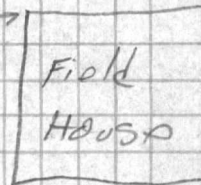

7+45.3

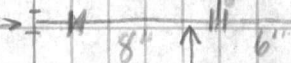

SEE sheet 4+5

3+55.6

12' ← 180' →

Bldg 16

2+62.3

← 180' →

*

*

63'

Bldg A 25

VALUABLE

SUBJECT _____

Return To
 Public Works
 Office
 Camp Lejeune
 North Carolina

FIELD PARTY

_____ In Charge
 _____ Instrument
 _____ Notes
 _____ Tape Read
 _____ Tape or Rod
 _____ Tape or Rod
 _____ ument No.
 _____ Tape No.

WEATHER

Clear
 Cloudy
 Windy
 Rain
 Fair

Snow
 Hot
 Moderate
 Cold
 Fog

FILE No. 160-G
 Fldr. No. _____
 Sheet 2
 Date _____ 19____

Quad. No. _____

| Station | Dist. | Angle " | + | H. I. Bearing | Ver: Ang. Diff. | Elevation | | |
|---------|-----------|---------|---|---------------|-----------------|-----------|----------|----------|
| | | | | 354 | 31.08 ✓ | 27.54 | | |
| T.P. | | | | 416 | 29.17 ✓ | 25.01 ✓ | HUD IN Q | STA 1+98 |
| 0+00 | Top "T" | | | | | 12.67 | 16.50 | |
| +03 | | | | | | 10.67 | 18.50 | |
| +05 | Valve | | | | | 10.22 | 18.95 | |
| +20 | | | | | | 10.22 | 18.95 | |
| +40 | Edge Road | | | | | | | |
| +81 | | | | | | | 19.42 | |
| 1+06 | | | | | | 10.12 | 19.05 | |
| 2+10 | | | | | | 7.48 | 21.69 | |
| +62.3 | Bldg Line | | | | | 8.17 | 21.00 | |
| 3 | | | | | | 8.07 | 21.10 | |
| +86.8 | Bldg Line | | | | | 9.50 | 19.67 | |
| TP | | | | 660 | 32.12 | 3.65 | 25.52 | |
| 4+60 | | | | | | 11.56 | | |









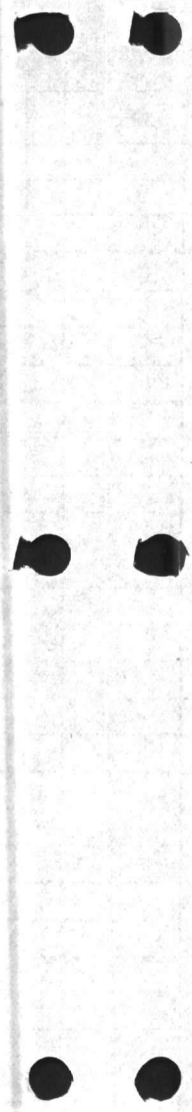

VALUABLE

SUBJECT _____

Return To
Public Works
Office
Camp Lejeune
North Carolina

FIELD PARTY

_____ In Charge
_____ Instrument
_____ Notes
_____ Tape Read
_____ Tape or Rod
_____ Tape or Rod
_____ Instrument No.
_____ Tape No.

WEATHER

Clear _____
Cloudy _____
Windy _____
Rain _____
Fair _____
Snow _____
Hot _____
Moderate _____
Cold _____
Fog _____

FILE No. 160-G

Fldr. No. _____

Figured By _____ Sheet 3

Notes Checked By _____

Plotted By _____ Date _____ 19__

Quad. No. _____

| Station | Dist. | ° Angle " | + | H. I. Bearing | Ver: Ang. Diff. | Elevation |
|---------|--------|--------------|---|---------------|-----------------|-----------|
| 5+00 | | | | 3212 | 11 19 | |
| 450 | | | | | 10 61 | |
| 6 | | | | | 10 25 | |
| 450 | | | | | 9 28 | |
| 7+00 | | | | | 9 21 | |
| 45 | "T" 03 | Line to Bldg | | 10 00 | 22.12 | |
| 8 | | | | | 8 58 | |
| 50 | | | | | 8 60 | |
| 9 | | | | | 8 53 | |
| f06 | valve | Top stem | | | 6 40 | |
| +17 | | End line | | | 8 50 | |











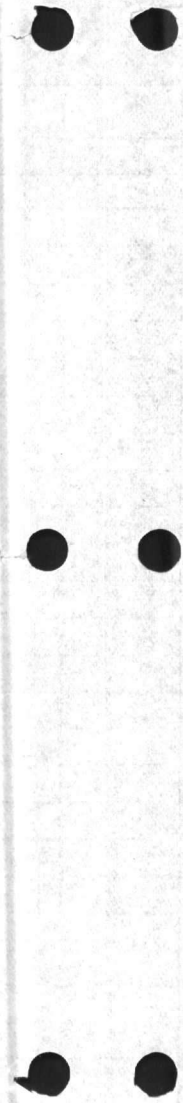

VALUABLE

SUBJECT _____

Return To
Public Works
Office
Camp Lejeune
North Carolina

FIELD PARTY

_____ In Charge
_____ Instrument
_____ Notes
_____ Tape Read
_____ Tape or Rod
_____ Instrument No.
_____ Tape No.

WEATHER

Clear _____
Cloudy _____
Windy _____
Rain _____
Fair _____
Snow _____
Hot _____
Moderate _____
Cold _____
Fog _____
Figured By _____
Notes Checked By _____
Plotted By _____

FILE No. _____


Fldr. No. _____

Sheet 4

Date _____ 19__

Quad. No. _____

| Station | Dist. | Angle " | + | H. I. Bearing | Ver: Ang. Diff. | Elevation |
|---------|---------------------------|---------|---|---------------|-----------------|-----------|
| 0+00 | no A = 7-1453 | | | 32 12 | | |
| 0+07 | Valve | | | | 10 22 | |
| +50 | | | | | 10 76 | |
| 1 | | | | | 10 60 | |
| +50 | | | | | 11 47 | |
| 1+855 | "8" x 8" T End 8-24-49 | | | | 10 80 | |
| BM | | | | | 4 56 27 52 | |
| | | | | | 4.42 31 94 | |
| 2+50 | | | | | 10 32 | |
| 3 | | | | | 9 84 | |
| +50 | | | | | 9 64 | |
| 4 | | | | | 8 95 | |
| +50 | | | | | 7 80 | |
| TP | | | | | 7.25 24 69 | |
| | | | | | 6.50 31 19 | |

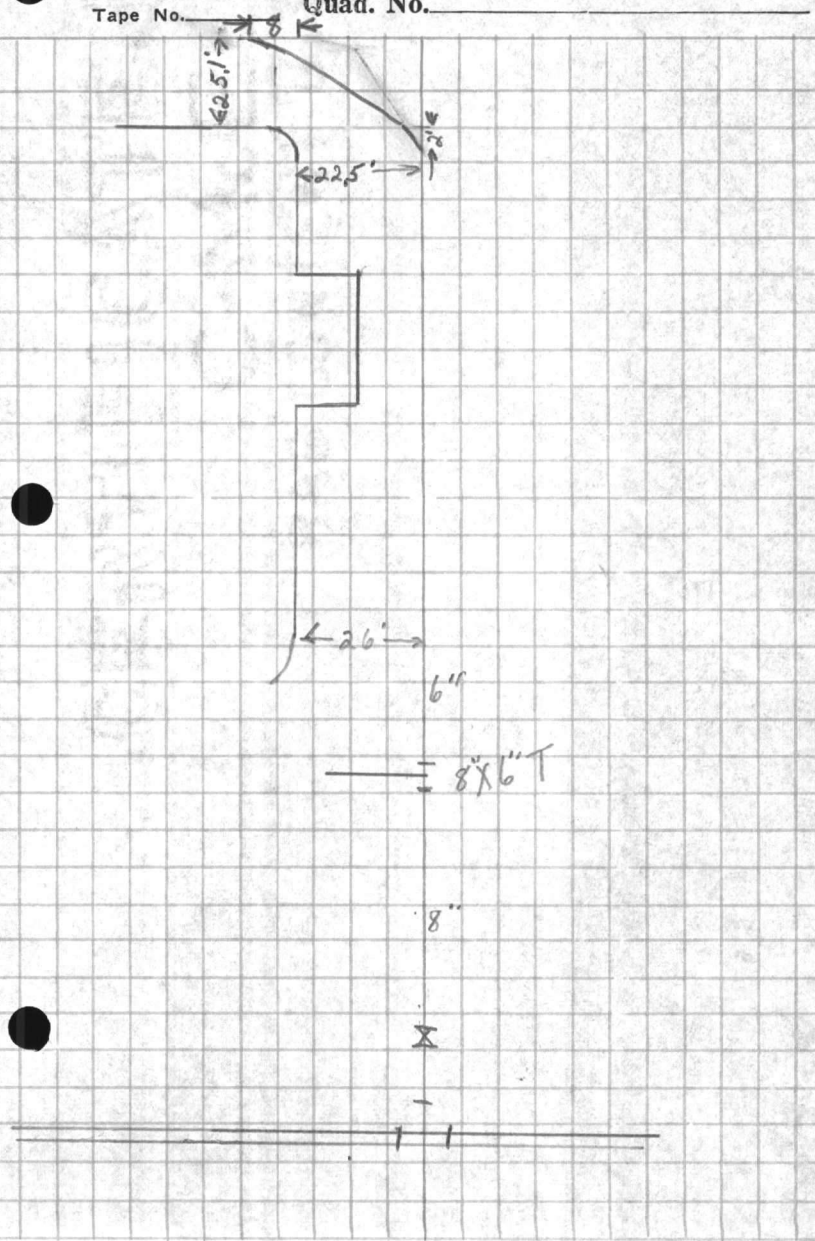








VALUABLE

SUBJECT _____

Return To
Public Works
Office
Camp Lejeune
North Carolina

FIELD PARTY

_____ In Charge
_____ Instrument
_____ Notes
_____ Tape Read
_____ Tape or Rod
_____ Tape or Rod
_____ Instrument No.
_____ Tape No.

WEATHER

Clear
Cloudy
Windy
Rain
Fair

Snow
Hot
Moderate
Cold
Fog

FILE No. _____

Fldr. No. _____

Sheet 5

Notes Checked By _____

Plotted By _____ Date _____ 19____

Quad. No. _____

| Station | Dist. | Angle " + | H. I. Bearing | Ver: Ang. Diff. | Elevation |
|-----------|-------|--------------|------------------|--------------------|-----------|
| | | | 31 19 | | |
| 4+61.5 | | 45° Bend | | 6.60 | |
| 5+01.6 | | 45° Bend | | 5.96 | |
| 50 | | | | 5.79 | |
| 83 | | | | 5.40 | |
| Men # 191 | | End work | 8-30-49 | 2.87 | 28.32 |

31.2
5.4

25.8

19.7

$$\begin{array}{r}
 29.00 \\
 4.56 \\
 \hline
 24.44 \\
 19.7 \\
 \hline
 4.74
 \end{array}$$







VALUABLE

Return To
Public Works
Office
Camp Lejeune
North Carolina

SUBJECT LOCATION TIE UNDER
GROUND POWER CABLE TO
CIRCLE


FIELD PARTY
DENNIS In Charge
____ Instrument
____ Notes
____ Tape Read
____ Tape or Rod
____ Tape or Rod
____ Instrument No.
____ Tape No.

WEATHER
Clear _____
Cloudy _____
Windy _____
Rain _____
Fair _____
Snow _____
Hot _____
Moderate _____
Cold _____
Fog _____
Figured By _____
Notes Checked By _____
Plotted By _____

FILE No. 160-G
Fldr. No. _____
Sheet 10F1
Date 10-A 1951

Quad. No. _____

| Station | Dist. | Angle ° ' " | + | H. I. Bearing | Ver: Ang. Diff. | Elevation |
|---------|-------|----------------|---|------------------|--------------------|-----------|
|---------|-------|----------------|---|------------------|--------------------|-----------|

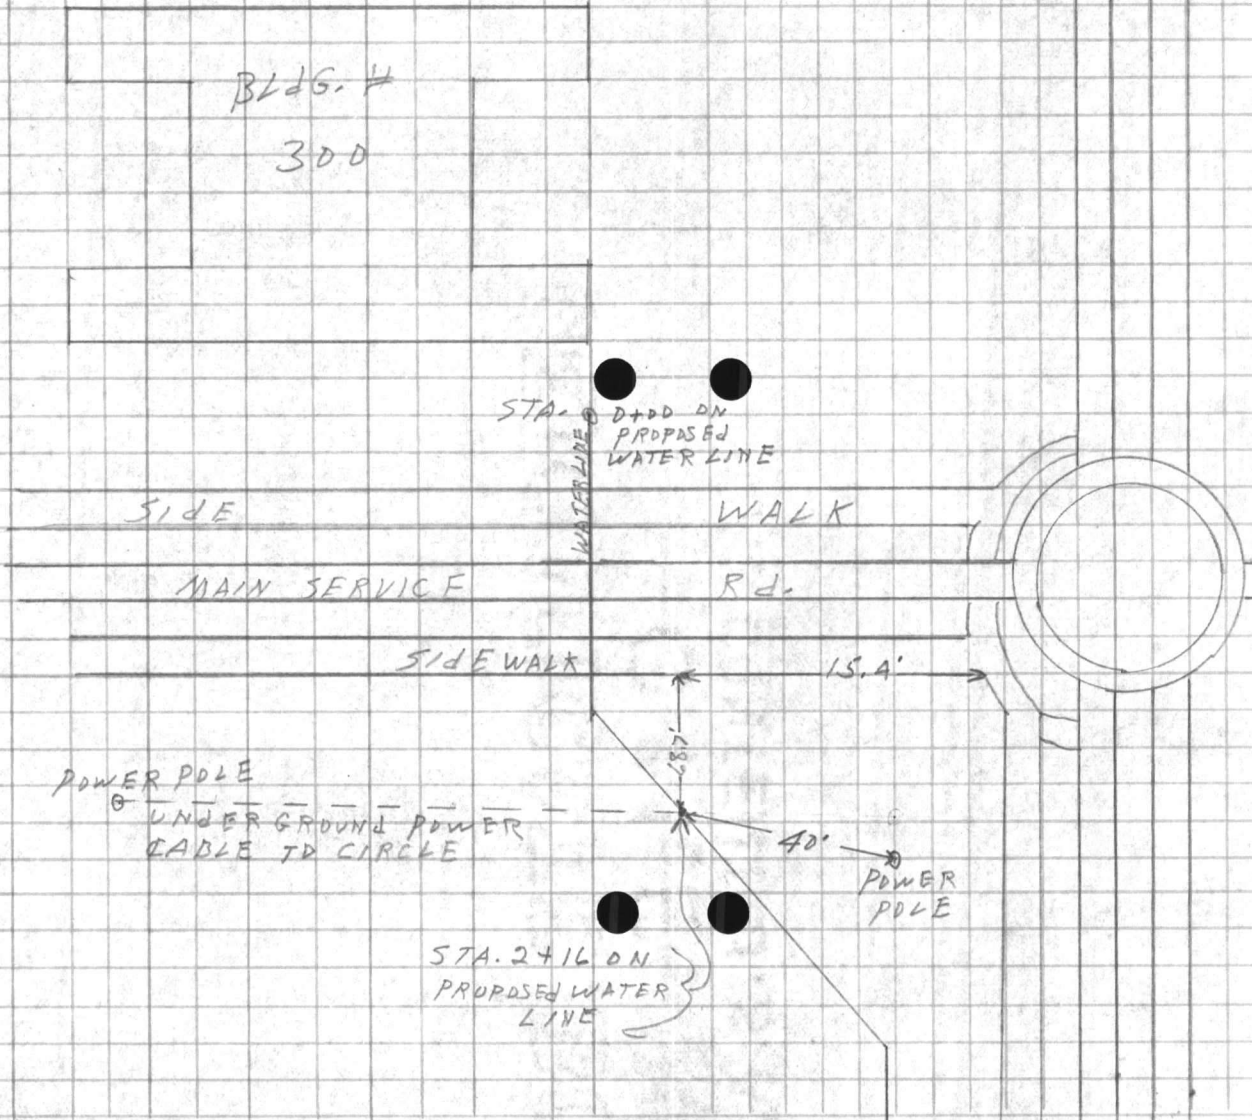


















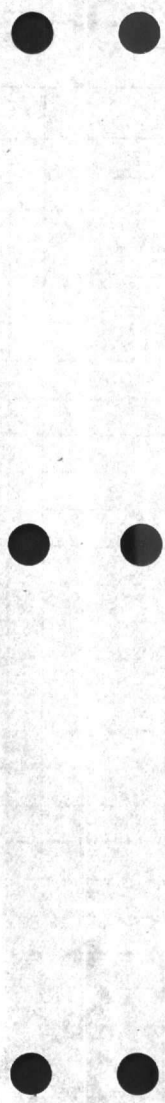

VALUABLE

SUBJECT _____

Return To
Public Works
Office
Camp Lejeune
North Carolina

FIELD PARTY

____ In Charge
____ Instrument
____ Notes
____ Tape Read
____ Tape or Rod
____ Tape or Rod
____ Instrument No. _____
____ Tape No. _____

WEATHER

Clear
Cloudy
Windy
Rain
Fair

Snow
Hot
Moderate
Cold
Fog

FILE No. _____

Fldr. No. _____

Sheet 2 of 2

Date _____ 19__


Figured By _____

Notes Checked By _____

Plotted By _____

Quad. No. _____

| Station | Dist. | Angle " + | H. I. Bearing | Ver: Ang. Diff. | Elevation |
|---------|-------|--------------|------------------|--------------------|-----------|
|---------|-------|--------------|------------------|--------------------|-----------|

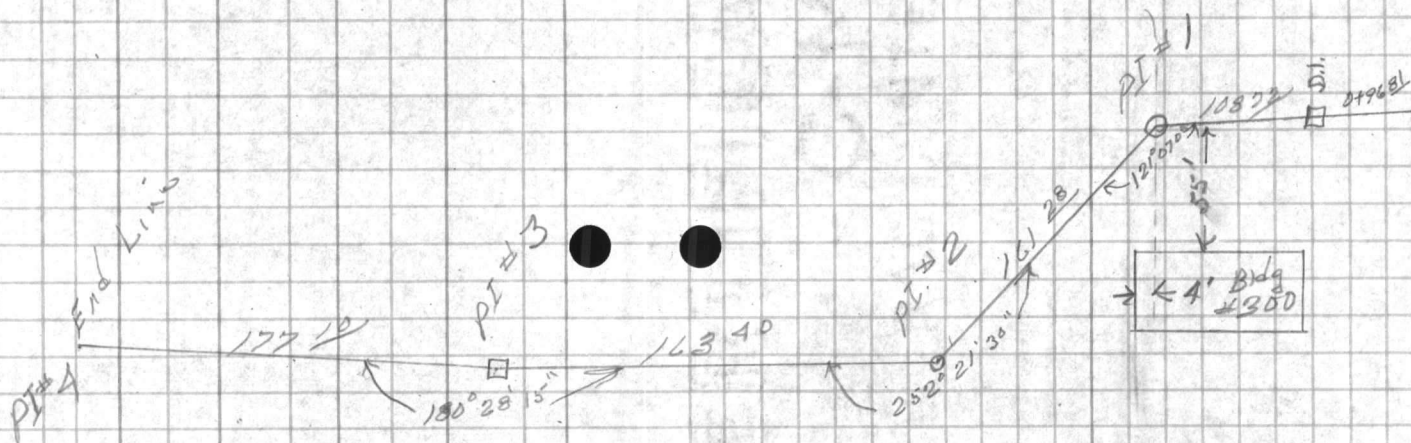








64 29
1700
128
580

15
20
300

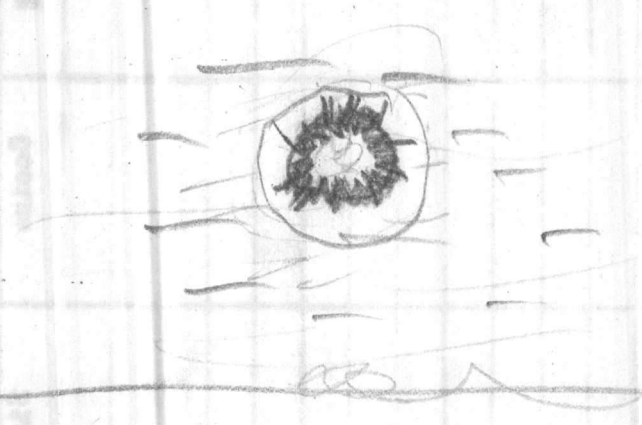

VALUABLE

SUBJECT STAKE OUT OF 2,000,000 GAL.
RESERVOIR
AT WATER TREATMENT PLANT

Return To
 Public Works
 Office
 Camp Lejeune
 North Carolina

FIELD PARTY

Cuthrie In Charge
 _____ Instrument
 _____ Notes
 _____ Tape Read
 _____ Tape or Rod
 _____ Tape or Rod
 _____ Instrument No.
 _____ Tape No.

WEATHER


Clear
 Cloudy
 Windy
 Rain
 Fair

Snow
 Hot
 Moderate
 Cold
 Fog

FILE No. 160-G
 Fldr. No. _____
 Sheet 1 of 1
 Notes Checked By _____
 Plotted By _____
 Date 7/19 1951

Quad. No. _____

| Station | Dist. | Angle ° ' " | + | H. I. Bearing | Ver: Ang. Diff. | Elevation |
|---------|-------|----------------|---|------------------|--------------------|-----------|
|---------|-------|----------------|---|------------------|--------------------|-----------|

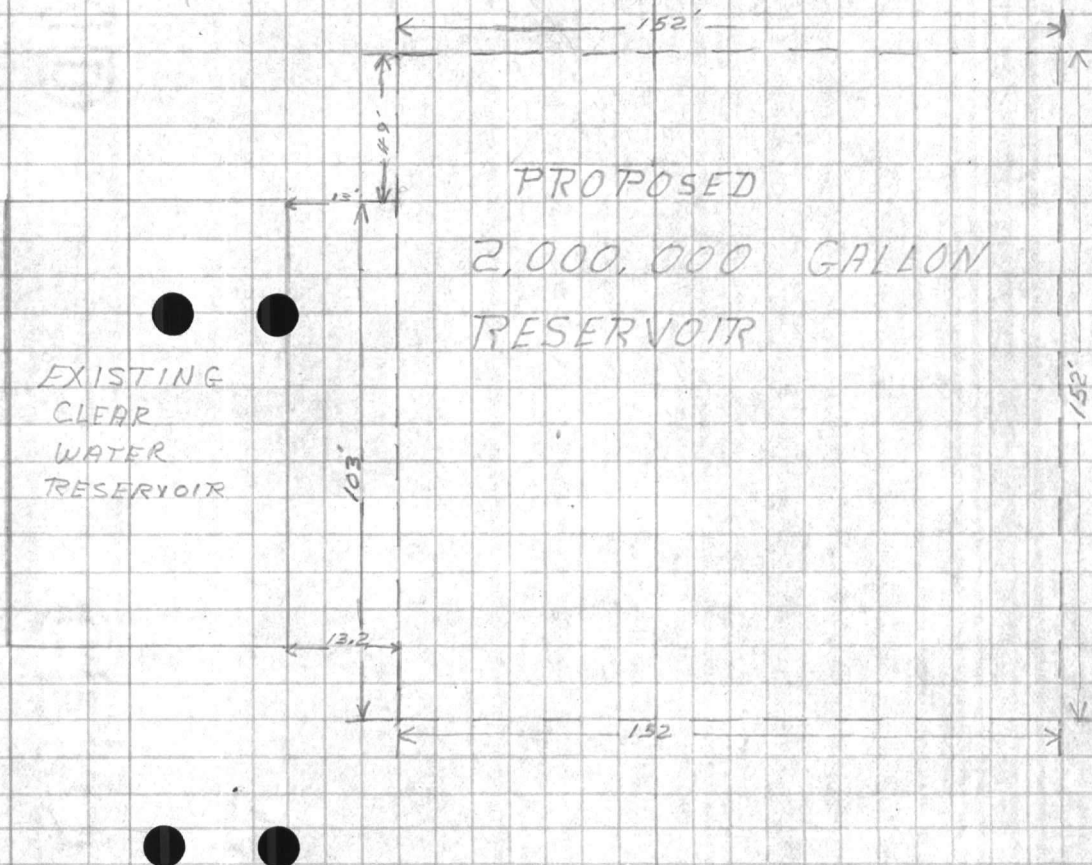

AVAILABLE

Region T
Public Works
District
Camp Johnson
North Carolina

SUBJECT

Station
Date
Area

W. L. Venable
Special Agent

FIELD PARTY

In Charge
In Charge
Notes

Type of Rod
Tension Rod

WEATHER

Clear
Partly
Cloudy
Wind
Moisture
Rain
Cold
Fog

Planted by
Notes
Planted by

(Inch)

FIELD NO.

Sheet

Date

VALUABLE

SUBJECT Sanitary sewer bypass
Location at water treatment
plant.

Return To
 Public Works
 Office
 Camp Lejeune
 North Carolina

FIELD PARTY
Kellum In Charge
 _____ Instrument
 _____ Notes
 _____ Tape Read
 _____ Tape or Rod
 _____ Instrument No.

WEATHER
 Clear _____
 Cloudy _____
 Windy _____
 Rain _____
 Fair _____
 Snow _____
 Hot _____
 Moderate _____
 Cold _____
 Fog _____
 Figured By _____
 Notes Checked By _____
 Plotted By _____

FILE No. 160-6
 Fldr. No. _____
 Sheet 1-2 of 4
 Date 7-20-1954

Tape No. New M.H. #1 Quad. No. _____
26

| Station | Dist. | Angle | + | H. I. Bearing | Ver: Ang. Diff. | Elevation |
|---------|-------|-------|---|---------------|-----------------|-----------|
|---------|-------|-------|---|---------------|-----------------|-----------|

| | | | | | | |
|-------------|-------|------------|--|--|--|--|
| New M.H. #2 | 1.247 | 19°30' | | | | |
| 2+89.34 | 2.21 | 58°30' | | | | |
| 79~ | 14.20 | 247°19'30" | | | | |


checked
 H.I.B.

| | | | | | | |
|-------------|-------|--------|--|--|--|--|
| New M.H. #1 | 1.112 | 30'00" | | | | |
| 2+10.25 | 3.327 | 30'00" | | | | |
| MEAN | 1.112 | 30'00" | | | | |

checked

| | | | | | | |
|------|------|--------|--|--|--|--|
| "A" | 1.9 | 53'45" | | | | |
| | 3.29 | 41'00" | | | | |
| MEAN | 9 | 53'40" | | | | |

checked

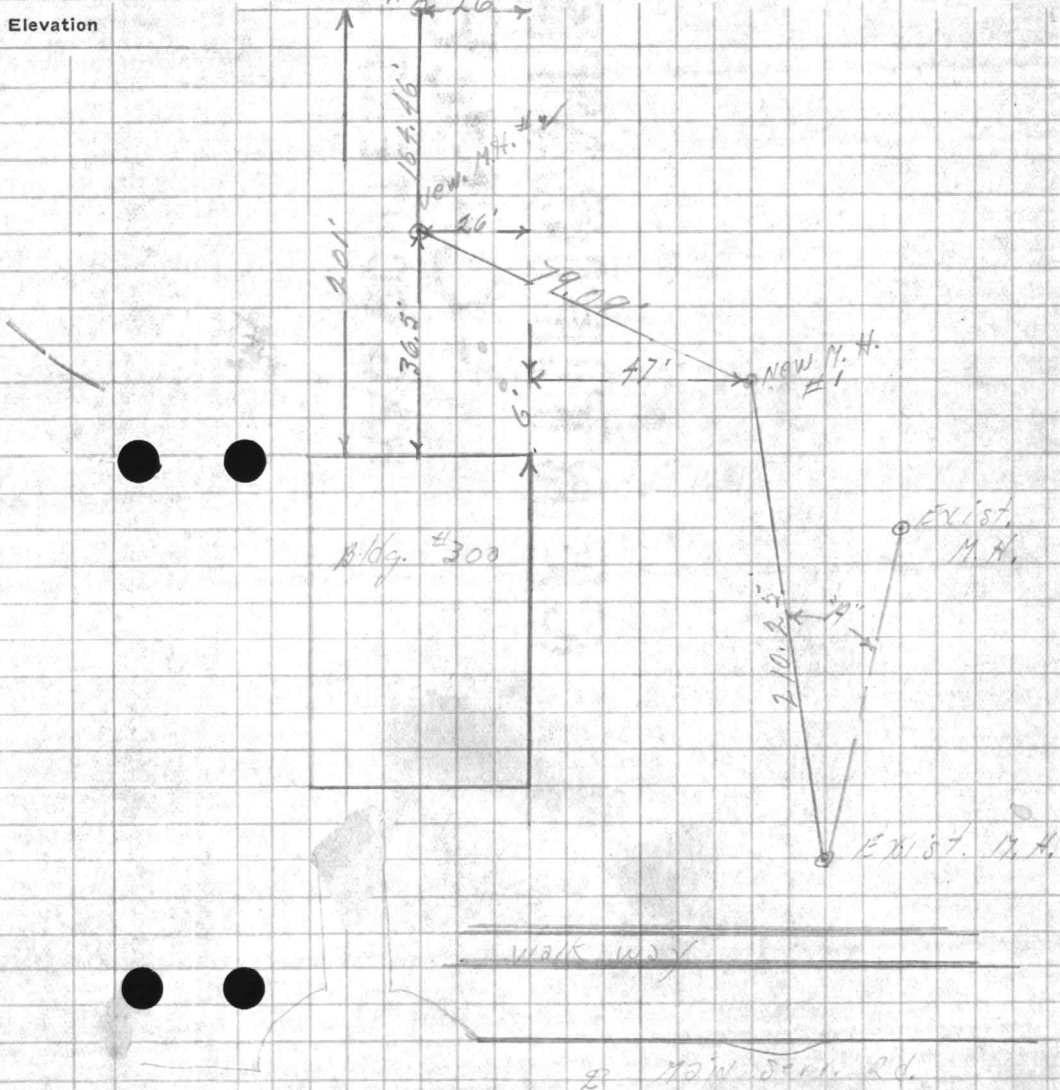

VALLEY

SUBJECT

Return to
Field Work
Office
Camp Station
Valley

FIELD PARTY



















































WEATHER



















































































VALUABLE

SUBJECT sanitary sewer bypass
location cont'd.

Return To
 Public Works
 Office
 Camp Lejeune
 North Carolina

FIELD PARTY


In Charge _____
 Instrument _____
 Notes _____
 Tape Read _____
 Tape or Rod _____
 Tape or Rod _____
 Instrument No. _____
 Tape No. _____

WEATHER

Clear _____
 Cloudy _____
 Windy _____
 Rain _____
 Fair _____
 Snow _____
 Hot _____
 Moderate _____
 Cold _____
 Fog _____

FILE No. _____
 Fldr. No. _____
 Sheet 2 of 4
 Date 7-20 19 51

Quad. No. _____

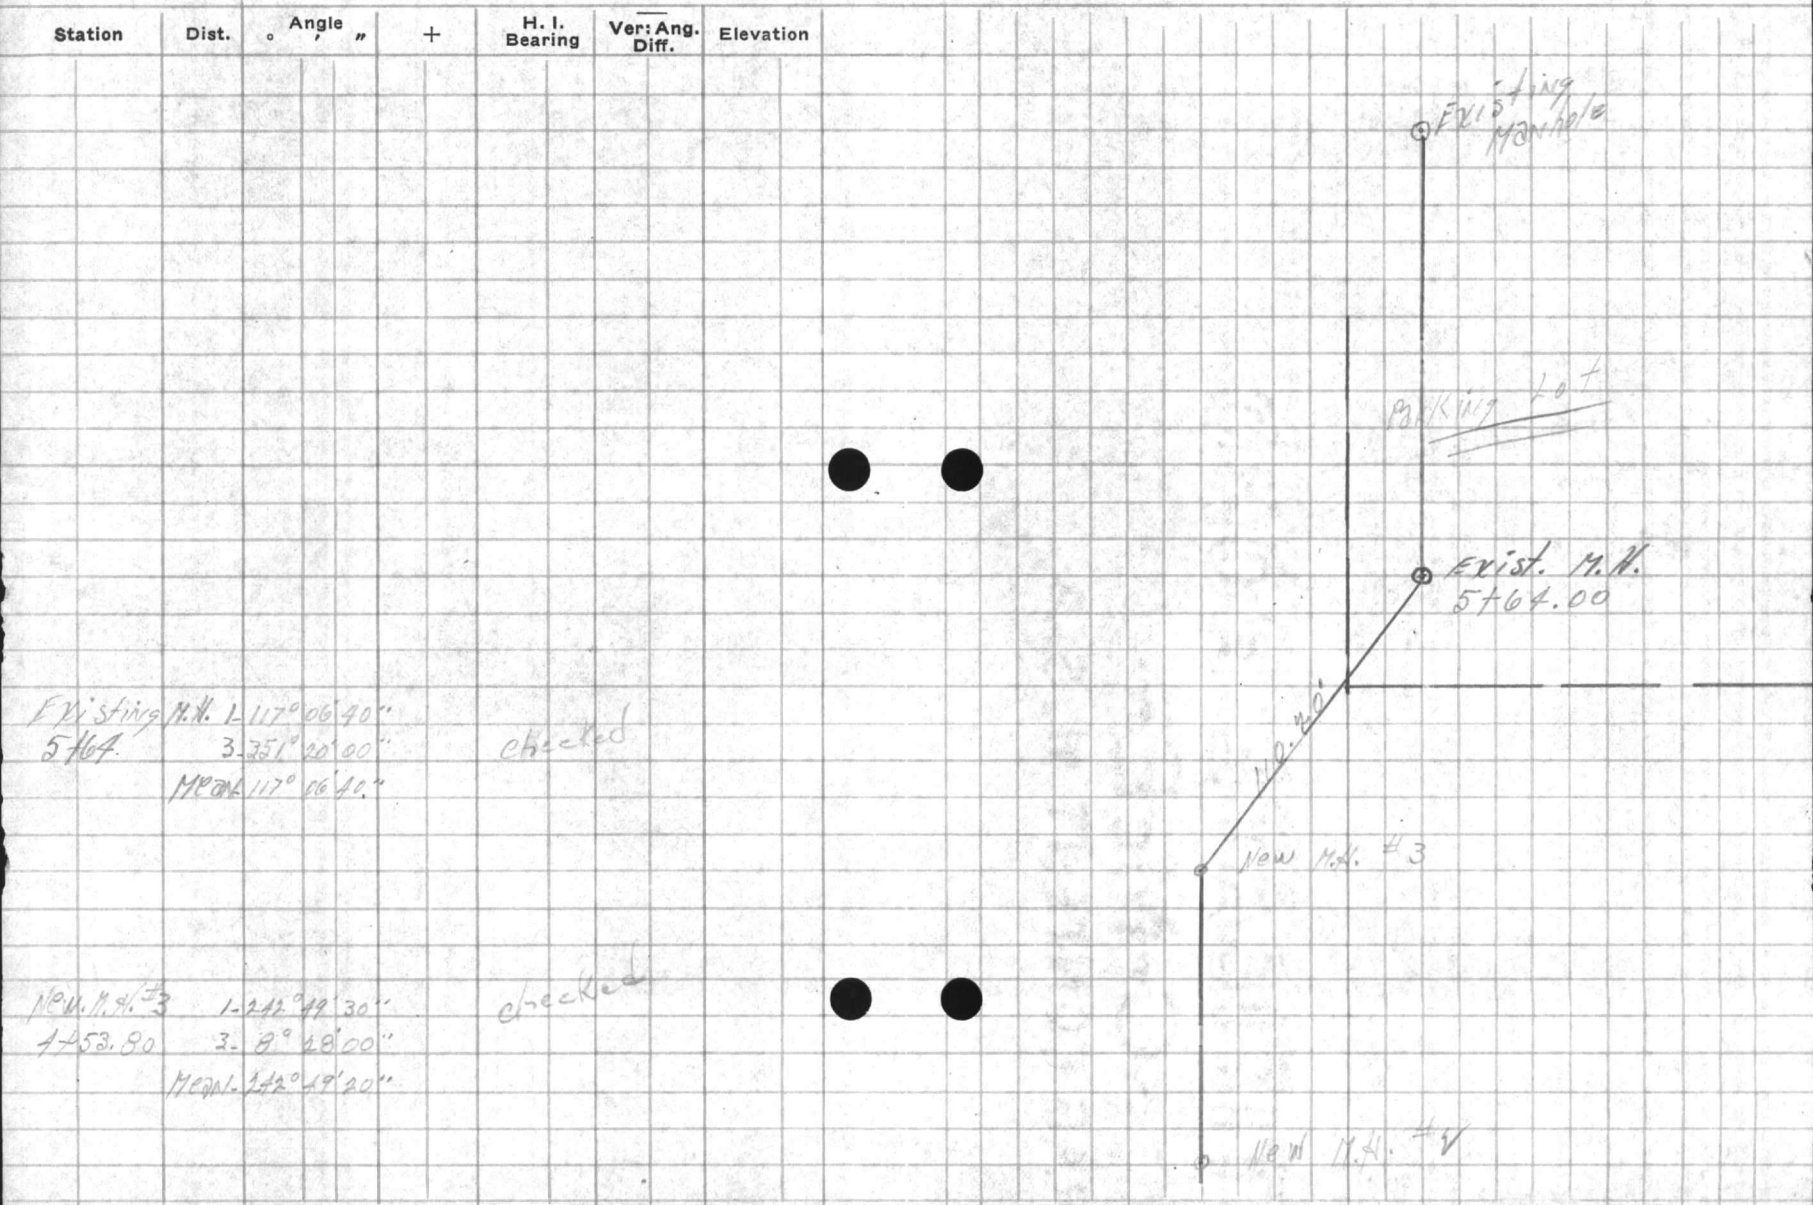

Existing M.N. 1 117° 06' 40"
 Mean 117° 06' 40"


VALUE

Return to
Public Works
Office
Camp Station
North Carolina

SUBJECT

Station

Date

Angle

Dist

Vertical
Dip Elevation

| | | |
|-------|----|----|
| 123 | 07 | 00 |
| | | 3 |
| <hr/> | | |
| 369 | 21 | 00 |

FIELD PARTY

In Charge

Instrument

Notes

Time

Time of Rod













FIELD NO.

Page No.

Sheet

Date

Time

Time

VALUABLE

Return To
Public Works
Office
Camp Lejeune
North Carolina

SUBJECT

Test Boring Locations
Proposed New Clear Water Storage Tank
Water Treatment Plant

FIELD PARTY

Farmer In Charge
____ Instrument
____ Notes
____ Tape Read
____ Tape or Rod
____ Tape or Rod
____ Instrument No.
____ Tape No.

WEATHER

Clear
Cloudy
Windy
Rain
Fair

Snow
Hot
Moderate
Cold
Fog

FILE No. 160-G

Fldr. No. _____


Figured By _____ Sheet 6 of 6

Notes Checked By _____

Plotted By _____ Date _____ 19____

Quad. No. _____

| Station | Dist. | Angle | " | + | H. I. Bearing | Ver: Ang. Diff. | Elevation |
|---------|-------|-------|---|---|------------------|--------------------|-----------|
|---------|-------|-------|---|---|------------------|--------------------|-----------|

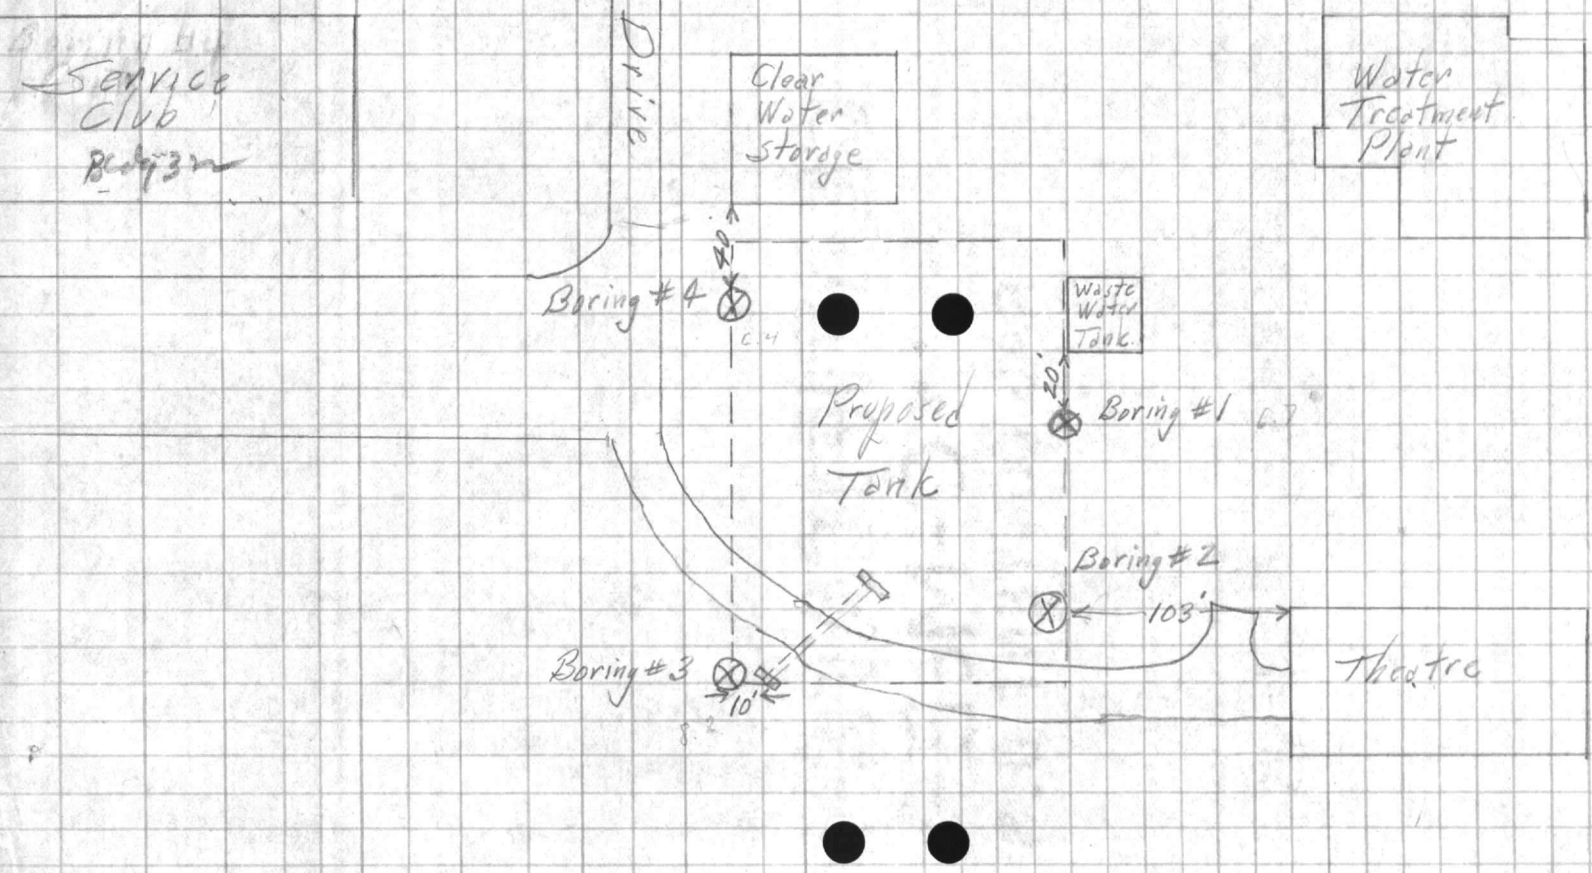

WEATHER
 Clear
 Snow
 Cloudy
 Windy
 Misty
 Foggy
 Rain
 Sleet
 Hail
 Other

Filled By _____
 Checked By _____
 Date _____





VALUABLE

SUBJECT Test Borings In The
Water Treatment Plant Area

Return To
 Public Works
 Office
 Camp Lejeune
 North Carolina

FIELD PARTY

Garnier In Charge
 _____ Instrument
 _____ Notes
 _____ Tape Read
 _____ Tape or Rod
 _____ Tape or Rod
 _____ Instrument No.
 _____ Tape No.

WEATHER

Clear _____
 Cloudy _____
 Windy _____
 Rain _____
 Fair _____
 Snow _____
 Hot _____
 Moderate _____
 Cold _____
 Fog _____
 Figured By _____
 Notes Checked By _____
 Plotted By _____

FILE No. _____
 Fldr. No. _____
 Sheet 1 of 5
 Date 1-12 1957

Quad. No. _____

| Station | Dist. | Angle " | + | H. I. Bearing | Ver: Ang. Diff. | Elevation | |
|-----------|-------|---------|----|---------------|-----------------|-----------------|------------------------|
| Boring #1 | 146 | 26 | 21 | 24 | 75 | Fl. ele theater | Waste Water Tank |
| | | | | | | | S.W. 20m → |
| | | | | | | | 20' |
| | | | | 815 | 1816 | Ground ele | ↓ |
| | | | | 91 | 171 | | Coarse white sand |
| | | | | | | | Fine, black sandy loam |
| | | | | 102 | 160 | | |
| | | | | 109 | 153 | | Fine, white sand |
| | | | | | | | Coarse yellow sand |
| | | | | 114 | 148 | | |
| | | | | 152 | 110 | | Water table |
| | | | | | | | Fine, grey sand |
| | | | | 157 | 105 | | |
| | | | | | | | Fine, dark brown sand |
| | | | | 167 | 95 | | |
| | | | | | | | Fine, light brown sand |

































VALUABLE

SUBJECT Test Borings ContiReturn To
Public Works
Office
Camp Lejeune
North Carolina

FIELD PARTY

_____ In Charge
 _____ Instrument
 _____ Notes
 _____ Tape Read
 _____ Tape or Rod
 _____ Instrument No.
 _____ Tape No.

WEATHER

Clear _____
 Cloudy _____
 Windy _____
 Rain _____
 Fair _____

Snow _____
 Hot _____
 Moderate _____
 Cold _____
 Fog _____

FILE No. _____

Fldr. No. _____

Sheet 2 of 5

Date _____ 19__

Figured By _____

Notes Checked By _____

Plotted By _____

Quad. No. _____

| Station | Dist. | Angle ° ' " | + | H. I. Bearing | Ver: Ang. Diff. | Elevation |
|---------|-------|----------------|---|------------------|--------------------|-----------|
|---------|-------|----------------|---|------------------|--------------------|-----------|

26 21

Boring #1
Conti

195 67

50% Fine brown sand
& blue clay

21 2 50

50% fine, light brown
sand & blue clay















































VALUABLE

SUBJECT Test Borings Conti

Return To
Public Works
Office
Camp Lejeune
North Carolina

FIELD PARTY

_____ In Charge
_____ Instrument
_____ Notes
_____ Tape Read
_____ Tape or Rod
_____ Tape or Rod
_____ Instrument No.
_____ Tape No.

WEATHER

Clear _____
Cloudy _____
Windy _____
Rain _____
Fair _____
Snow _____
Hot _____
Moderate _____
Cold _____
Fog _____
Figured By _____
Notes Checked By _____
Plotted By _____

FILE No. _____
Fldr. No. _____
Sheet 3 of 5
Date _____ 19__

Quad. No. _____

| Station | Dist. | Angle " " | + | H. I. Bearing | Ver: Ang. Diff. | Elevation |
|---------|-------|--------------|---|------------------|--------------------|-----------|
|---------|-------|--------------|---|------------------|--------------------|-----------|

26 21

Boring # 2

Theater

Bldg #

NW
Cor

103'

9 3 16 9

Ground ele.

Fine, brown sandy
loam

10 2 16 0

Fine brown sand

11 3 14 9

Fine, light grey sand

11 8 14 4

Fine, brown sand

12 3 13 9

Impossible to get
auger below this ele.

15 3 10 9

Water table

Fine, yellow sand

18 8 → 7 4

probed to this ele.

21 5 → 5 7

sand

Firm substance

AVAILABLE

Return to
Public Works
Office
Camp Lejeune
North Carolina

SUBJECT

Station
District
Andis
Billing
Vol and
Elevation

FIELD PARTY

Mr. Ordan
Instrument
Notes
Type Read
Type or Rod
Type of Trip
Instrument No.
Case No.

WEATHER

Clear
Snow
Cloudy
Fog
Mist
Moderate
Rain
Cold
Fair

FILE No.

Field No.

Sheet

Notes Checked By

Date

Hand No.

Station

District

Andis

Billing

Vol and

Elevation



VALUABLE

SUBJECT Test Borings Cont.

Return To
Public Works
Office
Camp Lejeune
North Carolina

FIELD PARTY

_____ In Charge
_____ Instrument
_____ Notes
_____ Tape Read
_____ Tape or Rod
_____ Tape or Rod
_____ Instrument No.
_____ Tape No.

WEATHER

Clear
Cloudy
Windy
Rain
Fair

Snow
Hot
Moderate
Cold
Fog

Figured By _____
Notes Checked By _____
Plotted By _____

FILE No. _____


Fldr. No. _____

Sheet 4076

Date _____ 19____

Quad. No. _____

| Station | Dist. | Angle " | + | H. I. Bearing | Ver: Ang. Diff. | Elevation | |
|------------|-------|---------|---|---------------|-----------------|-----------|------------------------------|
| | | | | 26 21 | | | |
| Boring # 3 | | | | | | | |
| | 120 | 14 | 2 | | | | Ground ele. |
| | | | | | | | Fine yellow sand |
| | 145 | 11 | 7 | | | | Water table |
| | 155 | 10 | 7 | | | | Fine, black sand 15% clay |
| | 180 | 8 | 2 | | | | 50% fine sand & blue clay |
| | 200 | 6 | 2 | | | | Fine sand & 10% blue clay |
| | 210 | 5 | 2 | | | | |

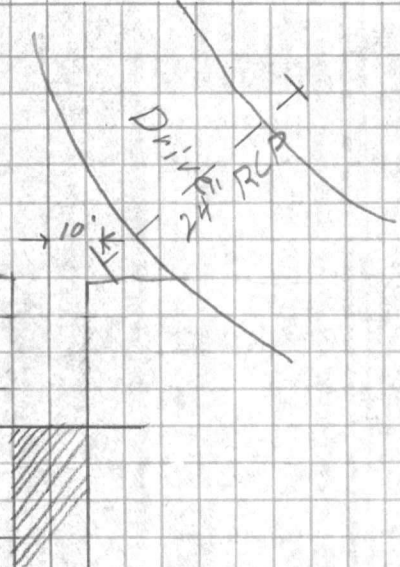

VALUABLE
Return to
Public Works
Office
Camp (Station)
North Carolina

SUBJECT

SECTION

DEF.

ANGLE

DEPT.

YR. AND
SERIAL

FIELD PARTY

In Charge

Assistant

Notes

Your Name

Type of Rod

Type of Rod

Instrument No.

Date

WEATHER

Clear

Cloudy

Partly

Light

Notes

Remarks

Remarks

Field No.

Date

Time

Place

Remarks

VALUABLE

SUBJECT Test Borings Cont.

Return To
Public Works
Office
Camp Lejeune
North Carolina

FIELD PARTY

_____ In Charge
_____ Instrument
_____ Notes
_____ Tape Read
_____ Tape or Rod
_____ Tape or Rod
_____ Instrument No.
_____ Tape No.

WEATHER

Clear _____
Cloudy _____
Windy _____
Rain _____
Fair _____
Snow _____
Hot _____
Moderate _____
Cold _____
Fog _____
Figured By _____
Notes Checked By _____
Plotted By _____

FILE No. _____

Fldr. No. _____

Sheet 5 of 5

Date _____ 19__

Quad. No. _____

| Station | Dist. | Angle ° ' " | + | H. I. Bearing | Ver. Ang. Diff. | Elevation | |
|-----------|-------|----------------|---|------------------|--------------------|-----------|--------------------------------|
| | | | | 26 21 | | | |
| Boring #4 | | | | | | | |
| | | | | | | | Fresh Water Storage |
| | | | | | | | SW Cor. → |
| | | | | | | | 40' |
| | | | | | | 58 20 4 | Ground ele |
| | | | | | | 60 20 2 | Black sandy loam |
| | | | | | | | Back fill yellow sand |
| | | | | | | 10 3 15 9 | Fine yellow sand + 10% clay |
| | | | | | | 12 6 13 6 | Fine yellow sand |
| | | | | | | 13 1 13 1 | Water table |
| | | | | | | 16 8 9 4 | Fine white sand |
| | | | | | | 17 3 8 9 | Fine brown sand + 5% clay |
| | | | | | | 17 8 8 4 | |

UNITED STATES

OFFICE

Referred to
Public Works
Office
Civil Service
North Carolina

Station

Dist.

Angle

to Bearing

to Azim. Elevation

FIELD PARTY

In Charge

Assistant

Notes

Time Read

Type of Run

Kind of Rod

Instrument No.

Tap No.

WEATHER

Snow

Wind

Cloud

Barometer

Thermometer

Hygrometer

Other

FIELD No.

Project No.

Station

Check by

Date

Book No.

VALUABLE

SUBJECT Test Boring At WaterTreatment PlantReturn To
Public Works
Office
Camp Lejeune
North Carolina

FIELD PARTY

Gunner In Charge
 _____ Instrument
 _____ Notes
 _____ Tape Read
 _____ Tape or Rod
 _____ Tape or Rod
 _____ Instrument No.
 _____ Tape No.

WEATHER

Clear _____
 Cloudy _____
 Windy _____
 Rain _____
 Fair _____
 Snow _____
 Hot _____
 Moderate _____
 Cold _____
 Fog _____

FILE No. 160-6

Fldr. No. _____

Figured By _____ Sheet 1 of 4

Notes Checked By _____

Plotted By _____ Date 1-18 1957

Quad. No. _____

| Station | Dist. | Angle " " | + | H. I. Bearing | Ver: Ang. Diff. | Elevation |
|---------|-------|--------------|---|------------------|--------------------|-----------|
|---------|-------|--------------|---|------------------|--------------------|-----------|

#5

NCO Club

000 283

283 Top storage tank.

74 209 = Ground ele

Note: edge drive 0.5' lower
 than ground ele.
 at boring.

79 204

Top soil

91 194

Fine, grey sand

114 189

Fine, yellow sand
& 20% clay

134 149

Fine, light yellow
sand

149 134

Fine, yellow sand

186 97

Fine, light yellow
sandCoarse, very light
yellow sand

Drive

← 7' * 26' → Storage Tank

Water

Tank

FIELD PARTY

Return to
Public Works
Office
Camp Lejeune
North Carolina

SUBJECT

Station

Date

Route

Weather
Wind
Temp

Wind
Temp
Bar

FIELD PARTY

Wind

Temp

Bar

Humidity

Visibility

Clouds

Pressure

WEATHER

Snow

Fog

Rain

Clouds

Wind

Temp

Bar

Field No.

Station

Date

Route

Field No.

VALUABLE

SUBJECT Test Boring Conti

Return To _____
Public Works Office _____
Camp Lejeune _____
North Carolina _____

FIELD PARTY

____ In Charge
____ Instrument
____ Notes
____ Tape Read
____ Tape or Rod
____ Instrument No.
____ Tape No.

WEATHER

Clear _____
Cloudy _____
Windy _____
Rain _____
Fair _____
Snow _____
Hot _____
Moderate _____
Cold _____
Fog _____

FILE No. _____

Fldr. No. _____

Sheet 2 of 4

Date _____ 19____

Figured By _____
Notes Checked By _____
Plotted By _____

Quad. No. _____

Station Dist. ° Angle ' " + H. I. Bearing Ver: Ang. Diff. Elevation

283

194 89

Water table

202 81

Blue clay

209 74

" "



AVAILABLE

Report To
Public Works
Office
District
North Carolina

SUBJECT

Station _____ Dist. _____ Angle _____
H. I. _____
V. I. _____
D. I. _____
E. I. _____

FIELD PARTY

In Charge _____
Instrument _____
Level _____
Tape _____
Tape No. _____
Tape No. _____

WEATHER

Clear _____
Snow _____
Hazy _____
Moderate _____
Rain _____
Fog _____
Thunder _____
Lightning _____
Wind _____
Direction _____
Speed _____
Date _____
By _____

FILE NO.

RECEIVED
GENERAL INVESTIGATION
DIVISION
MAY 19 1954

27.5
2
2.6

VALUABLE

SUBJECT Test Borings Cont.

Return To
Public Works
Office
Camp Lejeune
North Carolina


FIELD PARTY
In Charge _____
Instrument _____
Notes _____
Tape Read _____
Tape or Rod _____
Tape or Rod _____
Instrument No. _____
Tape No. _____

WEATHER
Clear _____
Cloudy _____
Windy _____
Rain _____
Fair _____
Snow _____
Hot _____
Moderate _____
Cold _____
Fog _____
Figured By _____
Notes Checked By _____
Plotted By _____

FILE No. _____
Fldr. No. _____
Sheet 3 of 4
Date _____ 19__

Quad. No. _____

| Station | Dist. | Angle " + | H. I. Bearing | Ver: Ang. Diff. | Elevation | | |
|---------|-------|--------------|------------------|--------------------|-----------|------------------------------------|---------------------------------|
| | | 9 00 | 29 5 | | 27 5 | Ft. elev. of treatment plant | Water Storage Tank |
| | | | | | 66 | 229 | Ground elev. |
| | | | | | 70 | 225 | Top soil |
| | | | | | 91 | 204 | Fine, yellow sand + 10% clay |
| | | | | | 11.4 | 181 | Fine, yellow sand + 30% clay |
| | | | | | 14.9 | 146 | Fine, yellow sand |
| | | | | | 15.8 | 137 | Fine, white sand |
| | | | | | 16.8 | 127 | Fine, yellow sand |
| | | | | | | | Fine, brown sand |

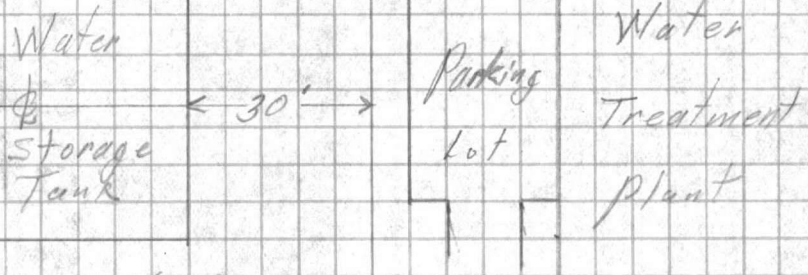

ADVISABLE

North Carolina
Camp I Station
Office
Rush Works
North Carolina

SUBJECT

FIELD PARTY

In Charge
Instrument
Dates
Time Read
Type of Rod
Type of Rod
Instrument Used
Trip No.

WEATHER

Clear
Snow
Fog
Windy
Moderate
Rain
Cold
Fog
Figured by
Notes Checked by
Pictorial by

FILE NO.

FIELD NO.

SHEET

DATE

Grid No.

Station
Date
Angle
M. S. Sighting
Elevation

VALUABLE

SUBJECT _____

Return To
Public Works
Office
Camp Lejeune
North Carolina

FIELD PARTY

_____ In Charge
_____ Instrument
_____ Notes
_____ Tape Read
_____ Tape or Rod
_____ Tape or Rod
_____ Instrument No.
_____ Tape No.

WEATHER

Clear
Cloudy
Windy
Rain
Fair
Snow
Hot
Moderate
Cold
Fog

FILE No. _____

Fldr. No. _____

Sheet 40 of 4

Date _____ 19____

Figured By _____
Notes Checked By _____
Plotted By _____

Quad. No. _____

| Station | Dist. | Angle ° ' " | + | H. I. Bearing | Ver: Ang. Diff. | Elevation |
|---------|-------|----------------|---|------------------|--------------------|-----------|
|---------|-------|----------------|---|------------------|--------------------|-----------|

29.5

146 99

Water table

Fine, brown sand

450% blue clay

22 1 77

11 11 11



Return to
Public Works
Office
Camp Lejeune
Housing Building

SUBJECT

Station

Date

H. H. BOALBY

Vol. App. Relation
Dir.

FIELD PARTY

in Charge

Instrument

Notes

Tap or Road

Tap or Road

Tap or Road

Tap No.

WEATHER

Snow

Fog

Moderate

Wind

Clear

Partly

Cloudy

W.P. No.

Field No.

Checked By

Station By

Date

Check No.

VALUABLE

SUBJECT CO-ORD TIE FOR
FIELD HOUSE

Return To
Public Works
Office
Camp Lejeune
North Carolina

FIELD PARTY
DENNIS In Charge
____ Instrument
____ Notes
____ Tape Read
____ Tape or Rod
____ Tape or Rod
____ Instrument No.
____ Tape No.

WEATHER
Clear _____
Cloudy _____
Windy _____
Rain _____
Fair _____
Snow _____
Hot _____
Moderate _____
Cold _____
Fog _____
Figured By _____
Notes Checked By _____
Plotted By _____

FILE No. 160-6
Fldr. No. _____
Sheet 1 of 1
Date 10/13 1950

Quad. No. _____

| Station | Dist. | Angle ° ' " | + | H. I. Bearing | Ver: Ang. Diff. | Elevation |
|---------------|-------|----------------|---|------------------|--------------------|-----------|
| T. Mon. # 191 | 1- | 122 47 00 | | | | |
| to cor. "A" | 3- | 08 20 30 | | | | |
| Mean | | 122 46 50 | | | | |
| T. Mon. # 191 | 1- | 165 26 00 | | | | |
| to cor. "B" | 3- | 136 17 30 | | | | |
| Mean | | 165 25 50 | | | | |

FIELD HOUSE

COR "B"

COR "A"

252.78

76.14

MON. # 191

MON. # 195

Form 100

SUBJECT

11/11/52

FIELD PARTY

In Charge
Instrument
Tape Read
Tape or Roll
Tape No.

WEATHER

Clear
Cloudy
Fog
Hot
Moderate
Cold
Rain
Thunder
Checked By
Rotted By

FILE No.

Plan No.

Sheet

Date

Grid No.

Vertical
Dist.

Section

Area

Dist.

Station

REPRODUCTION OF
ORIGINAL RECORD

VALUABLE

SUBJECT

Bldg. Dimensions

Field House

Return To
Public Works
Office
Camp Lejeune
North Carolina

FIELD PARTY

DENNIS In Charge

Instrument

Notes

Tape Read

Tape or Rod

Instrument No.

Tape No.

WEATHER

Clear
Cloudy
Windy
Rain
Fair

Snow
Hot
Moderate
Cold
Fog

Figured By

Notes Checked By

Plotted By


FILE No. 160-6

Fldr. No.

Sheet # 1 of 1

Date 10/13 1950

Quad. No.

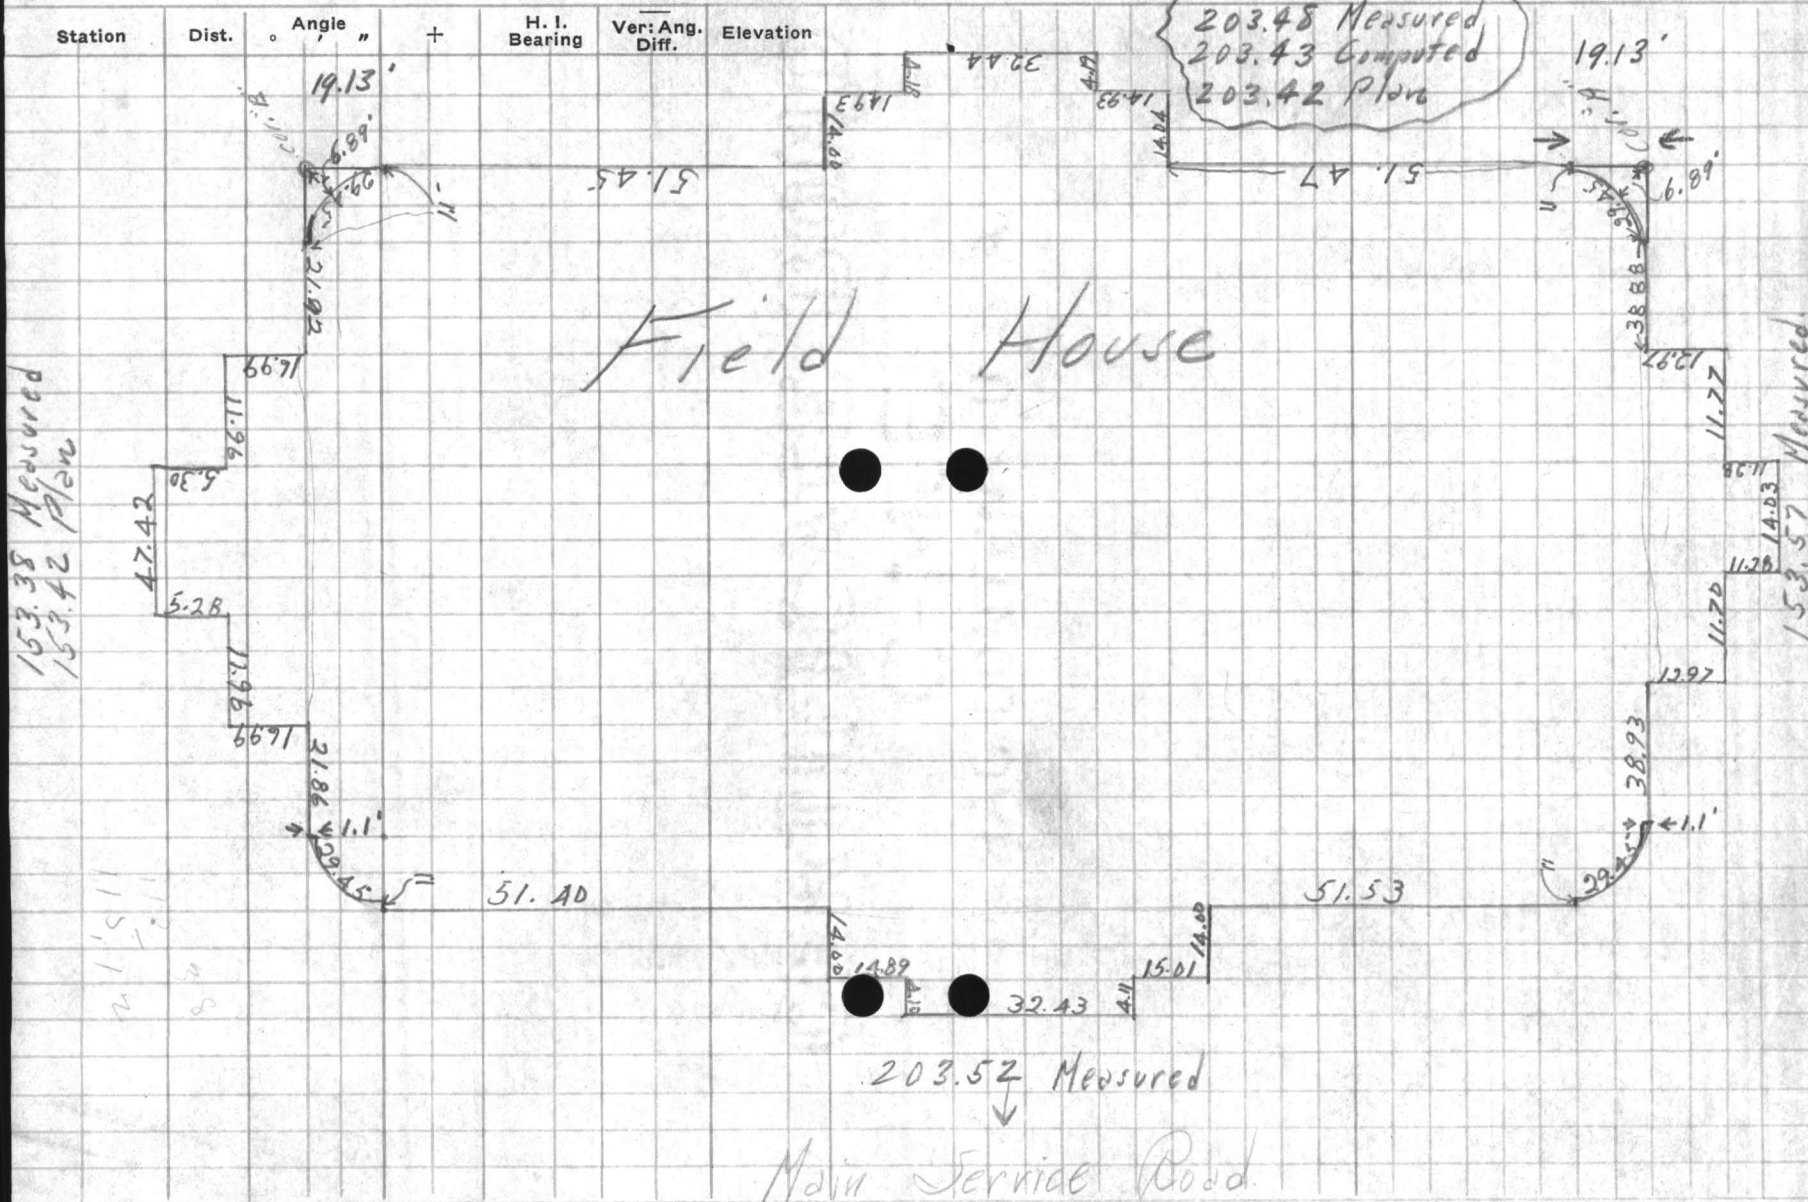
















 

VALUABLE

SUBJECT

Baseball Field Loc.

RETURN TO
PUBLIC WORKS
OFFICE
CAMP LEJEUNE
NORTH CAROLINA

FIELD PARTY

Kellum IN CHARGE

INSTRUMENT

NOTES

TAPE READ

TAPE OR ROD

TAPE OR ROD

INSTRUMENT NO.

TAPE NO.

WEATHER

CLEAR
CLOUDY
WINDY
RAIN
FAIR

SNOW
HOT
MODERATE
COLD
FOG

FIGURED BY

NOTES CHECKED BY

PLOTTED BY

FILE No. 160 G

FLDR. No.

SHEET 1-0/1

DATE 4-17 59

Quad. No.

| STATION | DIST. | ANGLE ° ' " | + | H. I. BEARING | VER. ANG. DIFF. | ELEVATION |
|---------|-------|----------------|---|------------------|--------------------|-----------|
|---------|-------|----------------|---|------------------|--------------------|-----------|


N 336,602.06
E 2,498,425.81

N 336,378.10
E 2,498,625.41

Used for
Construction

Mon. #192


Mon. #194

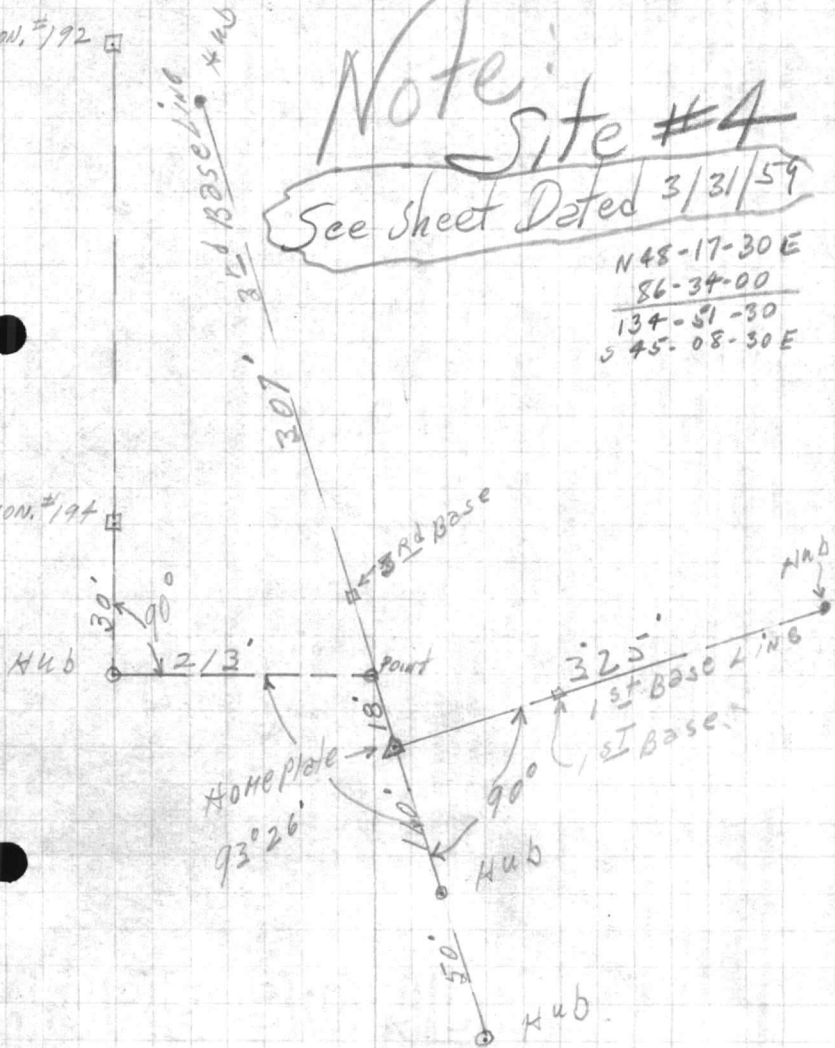




 

VALUABLERETURN TO
PUBLIC WORKS
OFFICE
CAMP LEJEUNE
NORTH CAROLINA

SUBJECT

Proposed additional Ball Field
Baseball and Football at
Camp Athletic Field - Reg Area #3

FIELD PARTY

Dillon
IN CHARGE
INSTRUMENT
NOTES
TAPE READ
TAPE OR ROD
TAPE OR ROD
INSTRUMENT No.
TAPE No.

WEATHER

CLEAR
CLOUDY
WINDY
RAIN
FAIR
SNOW
HOT
MODERATE
COLD
FOG

FILE No. 160-G

FLDR. No. _____

SHEET _____

DATE 3/31 1959

FIGURED BY _____

NOTES CHECKED BY _____

PLOTTED BY _____

Quad. No. _____

| STATION | DIST. | ANGLE ° ' " | + | H. I. BEARING | VER: ANG. DIFF. | ELEVATION |
|---------|-------|----------------|---|------------------|--------------------|-----------|
|---------|-------|----------------|---|------------------|--------------------|-----------|

Drill Field - Back Troop Line
102'

Center Field Fence

375'

148° 03' 25"

Home Plate

391.88

202° 56' 10"

Mon. # 191

Mon. # 196

DRILL and REVIEW
FIELDBACK TROOP
LINE
$$\begin{array}{r} 227 \\ 126.0 \\ 72.0 \\ \hline 357.15 \end{array}$$
FENCE
55'

102'

500.40

55'

FENCE

FENCE

Not Approved
Relocated
Site # 2Used on
Site # 4

180'

320'

160'

180'

127.3

60.5












Back stop

Bleachers
15' width

#191

Existing
Football Field






















PUBLIC WORKS DEPARTMENT
Camp Lejeune, North Carolina
Survey Department

File 160-6
Quadrangle _____
Date Mar. 31 1959
Sheet #1 of 1

Traverse Computation
Description

Athletic Field - Topog Controls - Location of 14" Raw Water Line

| Station | Distance | Bearing | Cosine | Sine | Latitude | Departure | Y Coordinate North | X Coordinate East |
|----------------------------|----------|-----------------------|-----------------|--------|----------|-----------|-----------------------|----------------------|
| Mon. # 191 | | N41°42'30"W | from Mon. # 196 | | | | 336,482.30 | 2,498,291.43 |
| P.I. #1 | 690' | " " " | 746541 | 665339 | 515.11 | 459.08 | 336,997.41 | 2,497,832.35 |
| P.I. #2 | 450 | N89-57-30W | 000727 | 999999 | 0.33 | 450.00 | 336,997.74 | 2,497,382.35 |
| | 1000' | N89-57-30W | 000727 | 999999 | 0.73 | 1000.00 | 336,998.14 | 2,496,832.35 |
| P.I. #1 | | | | | | | 336,997.41 | 2,497,832.35 |
| 14" Raw Water Transit Pipe | 169.05 | N16-46-00E | 95749 | 28847 | 161.86 | 48.77 | 337,159.27 | 2,497,881.12 |
| " " " " " | 456.45 | N77-19-30E | 21942 | 97563 | 100.15 | 445.33 | 337,097.56 | 2,498,277.68 |
| MON. # 191 | | N41°42'30"W | from Mon. # 196 | | | | 336,482.30 | 2,498,291.43 |
| HOME plate | 391.88 | N18-46-20W | 946805 | 321807 | 371.03 | 126.11 | 336,853.33 | 2,498,165.32 |
| center field fence | 375.00 | N50-42-55W | 633175 | 774009 | 237.44 | 290.25 | 337,090.77 | 2,497,875.07 |
| | 102.00 | " | | | | | | |

Return to
Public Works
Division
Camp Station
North Carolina

SUBJECT

Station

Date

Angle

Station

Vol. Amt.

Division

FIELD PARTY

In Charge
Inspector
Notes
Tape Head
Tape on Roll
Tape on Roll
Tape on Roll
Tape No.

WEATHER

Clear
Snow
Hot
Cloudy
Moderate
Wind
Cool
Rain
Fog
Fogged By
Checked By
Date

FILE No.

Field No.

Sheet

Date

Tag No.

RECEIVED
NOV 19 1944

VALUABLE

SUBJECT NEW WATER LINE
LOCATION CONTINUED


Return To
 Public Works
 Office
 Camp Lejeune
 North Carolina

FIELD PARTY
 _____ In Charge
 _____ Instrument
 _____ Notes
 _____ Tape Read
 _____ Tape or Rod
 _____ Tape or Rod
 _____ Instrument No.
 _____ Tape No.

WEATHER
 Clear _____
 Cloudy _____
 Windy _____
 Rain _____
 Fair _____
 Snow _____
 Hot _____
 Moderate _____
 Cold _____
 Fog _____
 Figured By _____
 Notes Checked By _____
 Plotted By _____

FILE No. _____
 Fldr. No. _____
 Sheet 5058
 Date 1-24-1957

Quad. No. _____

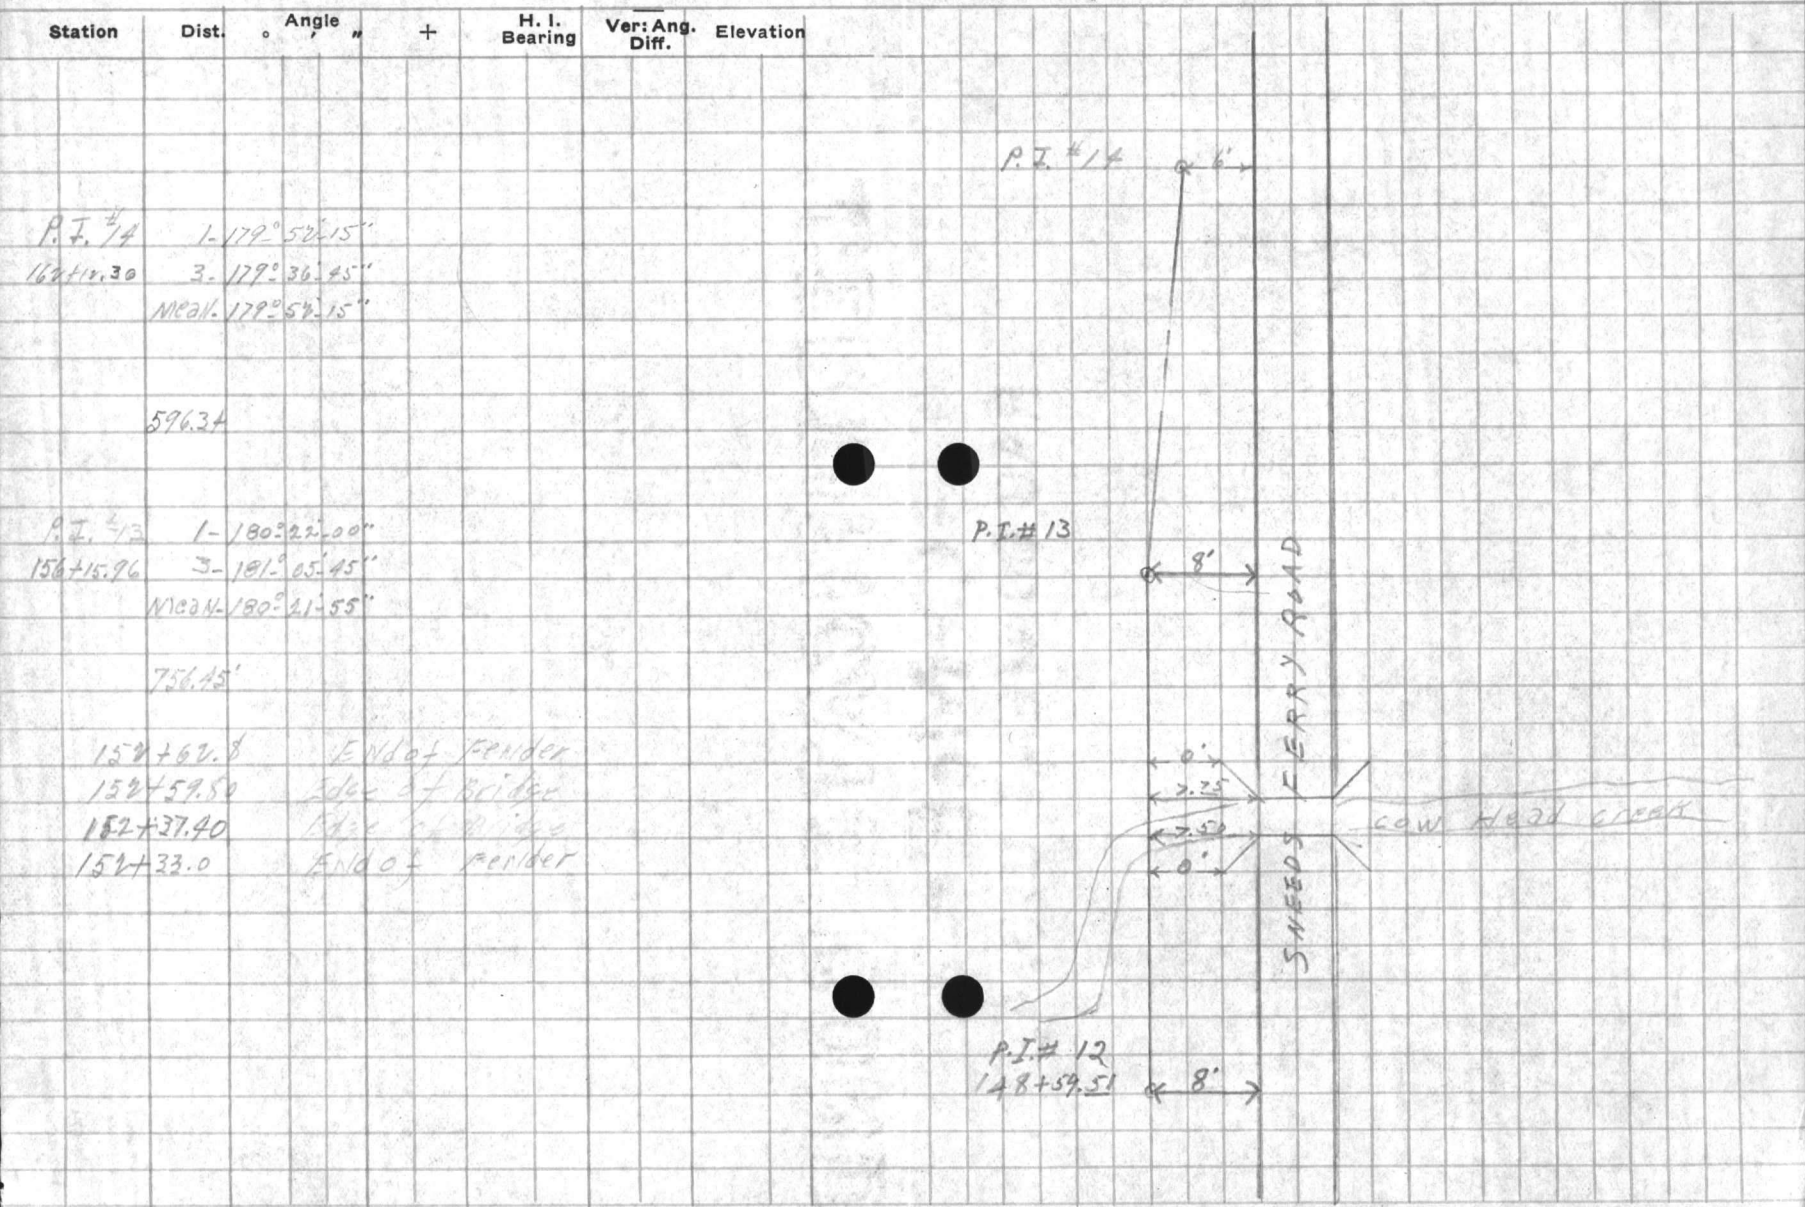

VALUABLE
Station To
Public Notice
Office
Camp Station
North Carolina

SUBJECT

Station
Date
Angle
H. A.
V. A.
Dist.
Elevation

FIELD PARTY

In Charge
Instrument
Notes
Tape Used
Type of
Station No.
Type No.

WEATHER

Clear
Snow
Hot
Cloudy
Foggy
Moderate
Rain
Cold
F. D.

FILE No.

Plotted by
Checked by
Notes

Sheet No.

REPRODUCTION
OF
OFFICIAL
RECORDS

VALUABLE

SUBJECT RAW water line location
contd.

Return To
 Public Works
 Office
 Camp Lejeune
 North Carolina

FIELD PARTY
 _____ In Charge
 _____ Instrument
 _____ Notes
 _____ Tape Read
 _____ Tape or Rod
 _____ Instrument No. _____
 _____ Tape No. _____


WEATHER
 Clear _____
 Cloudy _____
 Windy _____
 Rain _____
 Fair _____
 Snow _____
 Hot _____
 Moderate _____
 Cold _____
 Fog _____
 Figured By _____
 Notes Checked By _____
 Plotted By _____

FILE No. _____
 Fldr. No. _____
 Sheet 6-0/8
 Date 1-24-51

Quad. No. _____

| Station | Dist. | Angle | H. I. Bearing | Ver. Ang. Diff. | Elevation |
|---------|-------|-------|---------------|-----------------|-----------|
|---------|-------|-------|---------------|-----------------|-----------|

| | | | | | |
|-----------|----|--------------|--|--|--|
| MCAN- | | 179° 50' 05" | | | |
| 1481.54 | | | | | |
| P.I. #15 | 1- | 180° 01' 00" | | | |
| 177+00.60 | 2- | 180° 02' 45" | | | |
| NIPON- | | 180° 00' 55" | | | |
| 1488.30 | | | | | |

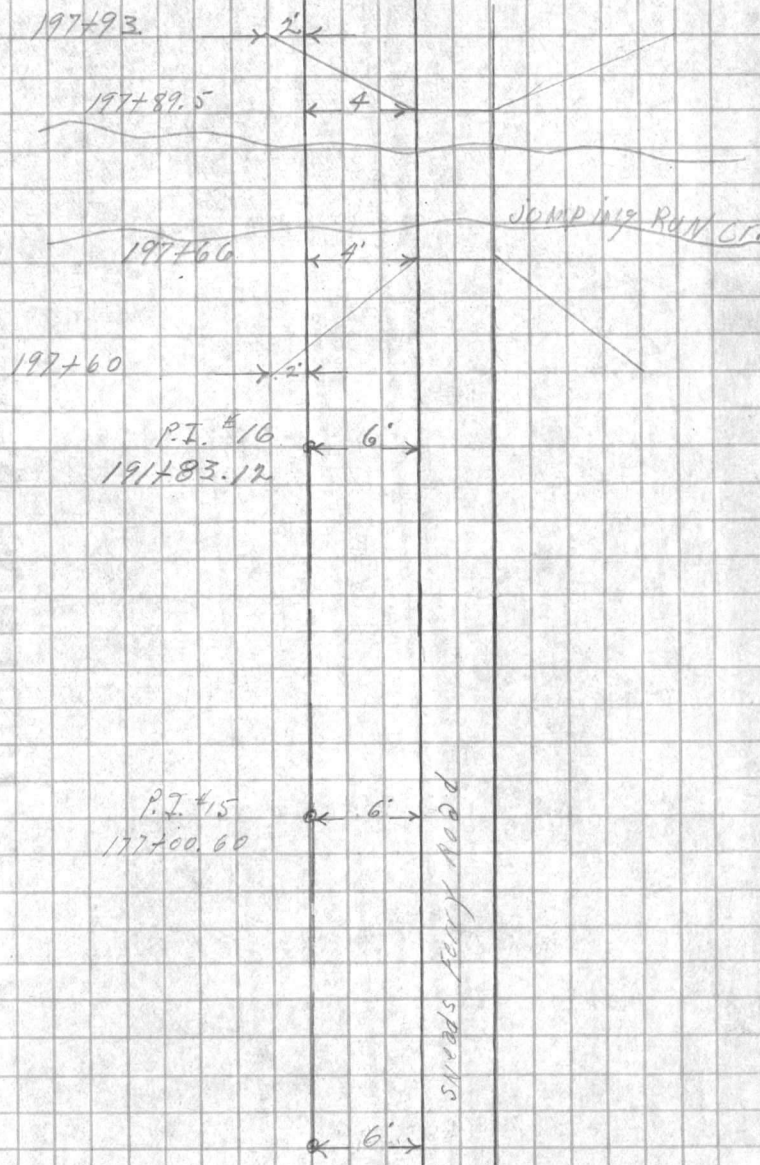

REMARKS
Location
Route
Office
Camp
Notes

SUBJECT

Station
Date
Angle
M. I.
Bearing
Ver. Ang.
Elevation

FIELD PARTY
In Charge
Instrument
Tape
Tape Pace
Type of
Tape of No.
Account No.
Tape No.

WEATHER
Clear
Snow
Cloudy
Fog
Rain
Thunder
Wind
Force
Direction
Barometer
Notes
Checked by
Date

FILE No.


VALUABLE

Return To
Public Works
Office
Camp Lejeune
North Carolina

SUBJECT Proposed Raw Water Line
Location continued

FIELD PARTY

In Charge _____
Instrument _____
Notes _____
Tape Read _____
Tape or Rod _____
Tape or Rod _____
Instrument No. _____
Tape No. _____


WEATHER

Clear _____
Cloudy _____
Windy _____
Rain _____
Fair _____
Snow _____
Hot _____
Moderate _____
Cold _____
Fog _____

FILE No. _____
Fldr. No. _____
Sheet 7 of 8
Date 1-25-1951

Quad. No. _____

| Station | Dist. | Angle | + | H. I. Bearing | Ver. Ang. Diff. | Elevation |
|---------------|--------------|-------|---|---------------|-----------------|-----------|
| P.I. #20 | 1-357°26'15" | | | | | |
| 236+00.00 | 3-352°18'15" | | | | | |
| END LINE MEAN | 357°26'05" | | | | | |
| | 1352.87' | | | | | |
| P.I. #19 | 1-185°43'45" | | | | | |
| 222+47.13 | 3-197°10'45" | | | | | |
| MEAN | 185°43'35" | | | | | |
| | 336.85' | | | | | |
| P.I. #18 | 1-184°51'00" | | | | | |
| 219+10.28 | 3-194°32'25" | | | | | |
| MEAN | 184°50'55" | | | | | |
| | 528.14' | | | | | |
| P.I. #17 | 1-180°12'45" | | | | | |
| 213+82.16 | 3-180°38'00" | | | | | |
| MEAN | 180°12'40" | | | | | |
| | 2199.04' | | | | | |

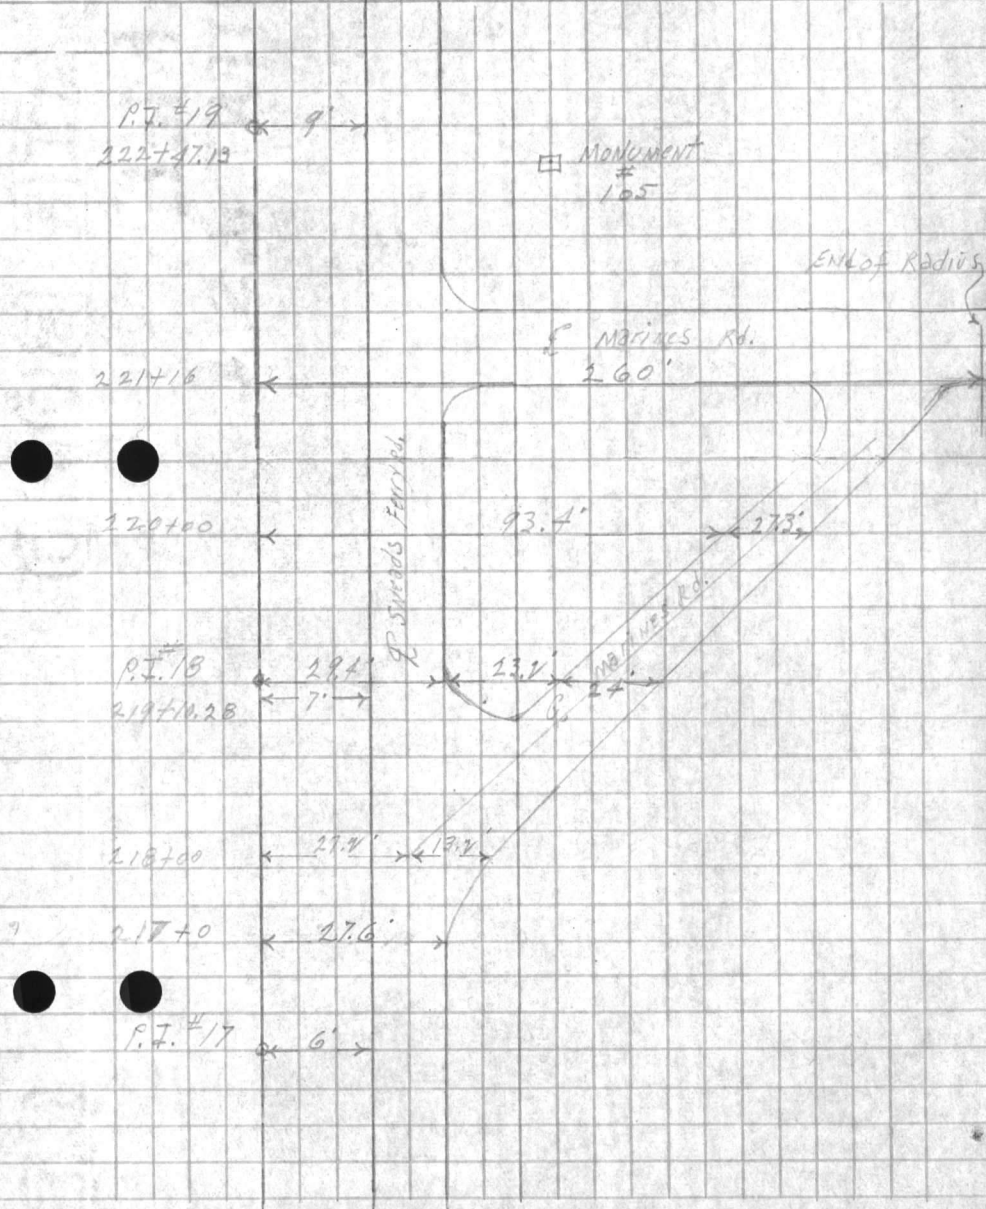

VAUGHAN
Return To
Public Works
Office
Camp Lejeune
North Carolina

SUBJECT

Station

Dist

Angle

Bearing

Vol. Area Elevation
Cm

Tag No.

Instrument No.

Date of Use

Date of Recd

Tool Hand

Notes

Remarks

Chip Desc

FIELD PARTY

WEATHER

Temp

Wind

Cloud

Humid

Bar

Wind

Temp

FILE No.

File No.

Sheet

Date

THE BOND

VALUABLE

Return To
Public Works
Office
Camp Lejeune
North Carolina

SUBJECT Water Line Location
tie.

FIELD PARTY

_____ In Charge
_____ Instrument
_____ Notes
_____ Tape Read
_____ Tape or Rod
_____ Tape or Rod
_____ Instrument No.
_____ Tape No.

WEATHER

Clear
Cloudy
Windy
Rain
Fair

Snow
Hot
Moderate
Cold
Fog

FILE No. _____


Fldr. No. _____

Figured By _____ Sheet 8 of 8

Notes Checked By _____

Plotted By _____ Date 1-25-1951

Quad. No. _____

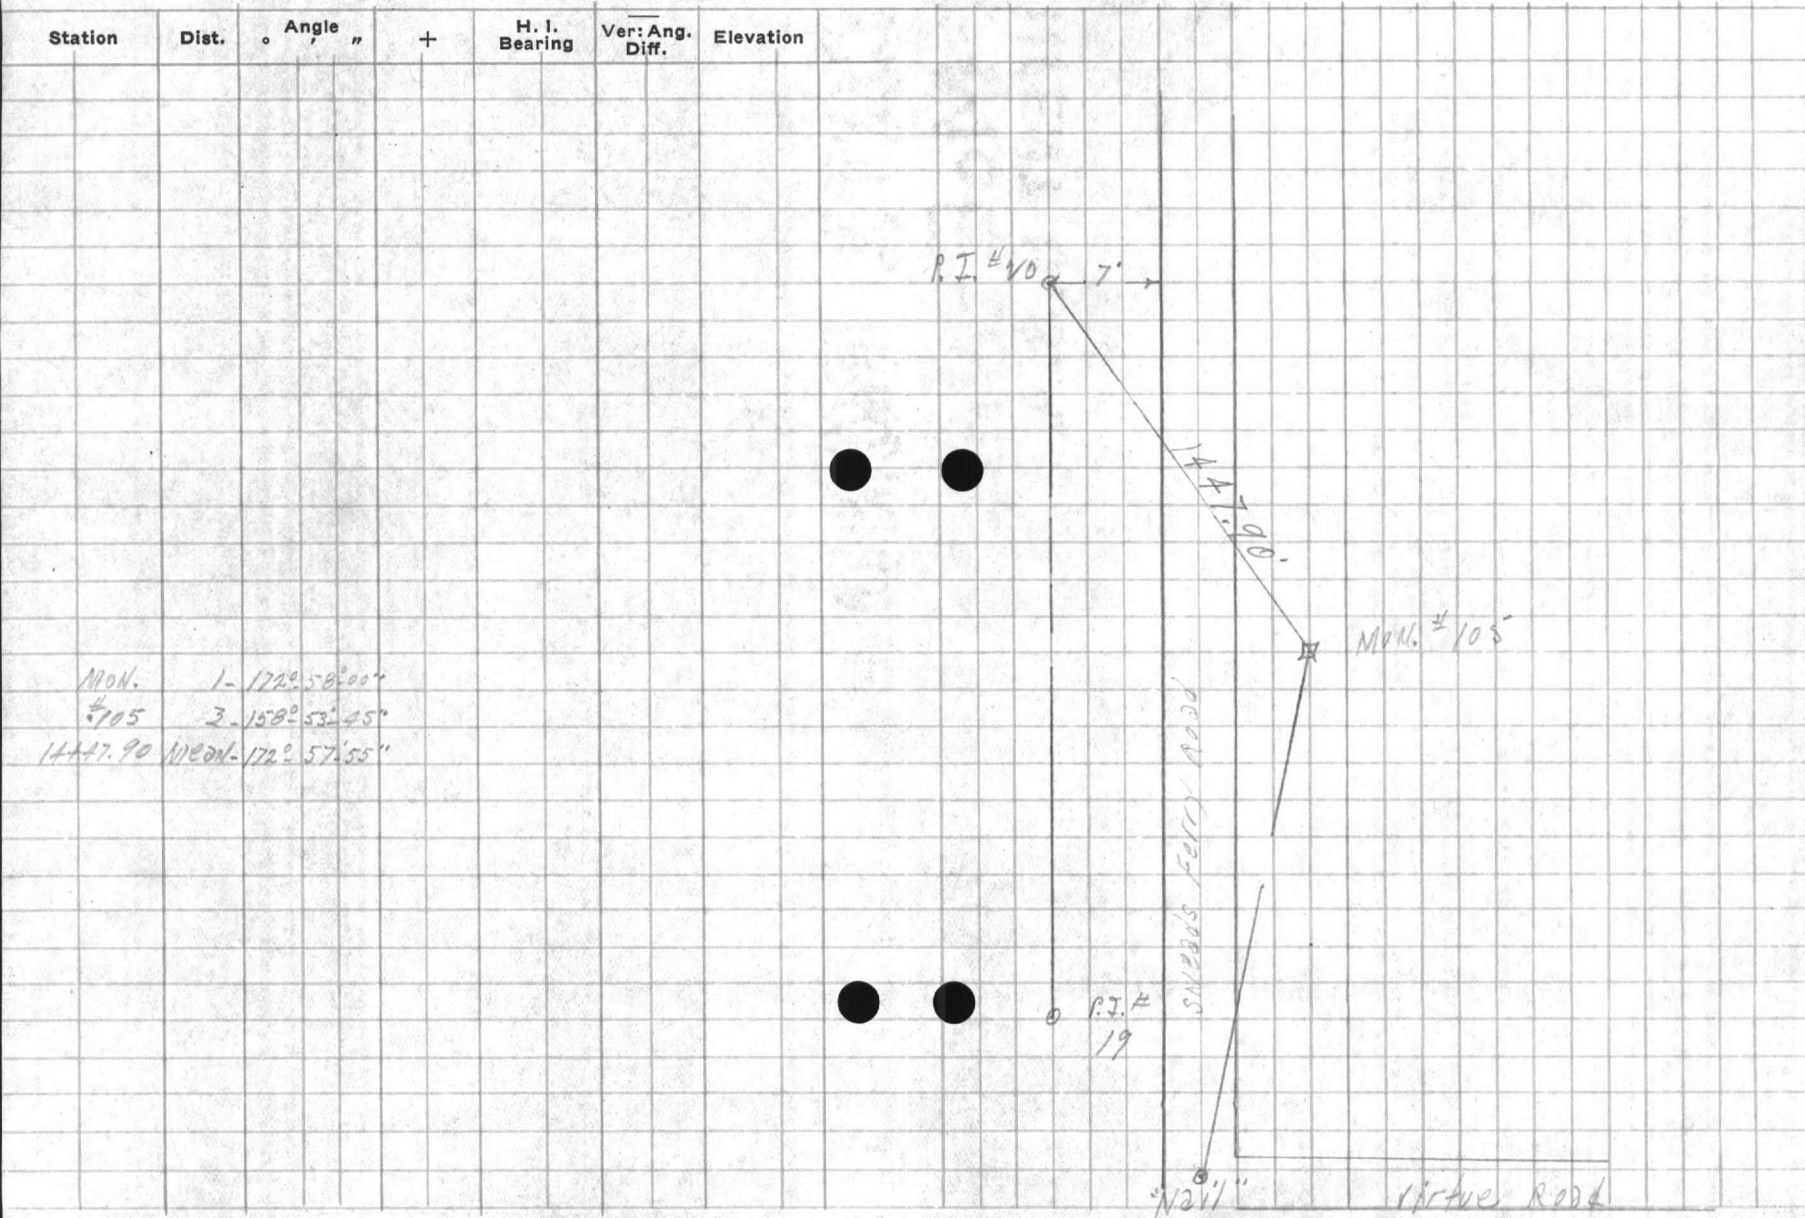

100-100000

SUBJECT

Return to
Public Works
Office
Camp Lejeune
North Carolina

Station Dist.

ADIC

H. I. Year: Aug. Elevation
Dist.

FIELD PARTY

In Charge

Instrument

Notes

Time Read

Type of Run

Type of Rod

Notes

Time

WEATHER

Snow

Fog

Cloud

Wind

Temp

Barom

Humid

Notes

File No.

Sheet

Checked by

Date

Plotted by












$$\begin{array}{r}
 36 \\
 36 \\
 \hline
 216 \\
 108 \\
 \hline
 1296 \\
 10841
 \end{array}$$

$$\begin{array}{r}
 47 \\
 16 \\
 \hline
 2137 \\
 16 \\
 \hline
 1537 \\
 516
 \end{array}$$

$$\begin{array}{r}
 29 \\
 824 \\
 \hline
 261 \\
 58 \\
 \hline
 10841
 \end{array}$$

$$\begin{array}{r}
 21747 \\
 1 \\
 \hline
 46 \overline{) 9995.78} \\
 92 \\
 \hline
 79 \\
 46 \\
 \hline
 335 \\
 328 \\
 \hline
 77 \\
 46 \\
 \hline
 318
 \end{array}$$

VALUABLE

SUBJECT Proposed Raw water Line
Location AND tie.

Return To
Public Works
Office
Camp Lejeune
North Carolina

FIELD PARTY

Medium In Charge
Instrument
Notes
Tape Read
Tape or Rod
Tape or Rod
Instrument No.
Tape No.

WEATHER

Clear
Cloudy
Windy
Rain
Fair

Snow
Hot
Moderate
Cold
Fog

FILE No. 160-6

Fldr. No. _____


Sheet #104

Figured By _____
Notes Checked By _____
Plotted By _____

Date 1-23-1951

Quad. No. _____

| Station | Dist. | Angle | + | H. I. Bearing | Ver. Ang. Diff. | Elevation |
|---------------|---------------|-------|---|---------------|-----------------|---------------|
| P.I. 97489.36 | 1-45°-00'00" | | | | | |
| 15° BEND | 3-135°-00'00" | | | | | |
| MEAN | 45°-00'00" | | | | | |
| 70.36' | | | | | | |
| 9719.00 | 1-135°-00'00" | | | | | P.I. 97899.36 |
| 45° BEND | 3-45°-00'00" | | | | | 45° BEND |
| MEAN | 135°-00'00" | | | | | |
| 163.35' | | | | | | |
| 7755.65 | 1-269°-54'30" | | | | | |
| 90° BEND | 3-89°-37'15" | | | | | |
| MEAN | 269°-54'25" | | | | | |
| 115.85' | | | | | | |
| 3739.80 | 1-202°-31'30" | | | | | |
| | 3-272°-34'00" | | | | | |
| MEAN | 202°-31'30" | | | | | |
| 173.94' | | | | | | |
| 1765.86 | 1-272°-05'15" | | | | | |
| EXISTING | 3-702°-15'30" | | | | | |
| MEAN | 272°-05'10" | | | | | |
| P.I. | 1-245°-36'45" | | | | | |
| | 3-10°-50'30" | | | | | |
| MEAN | 245°-36'50" | | | | | |

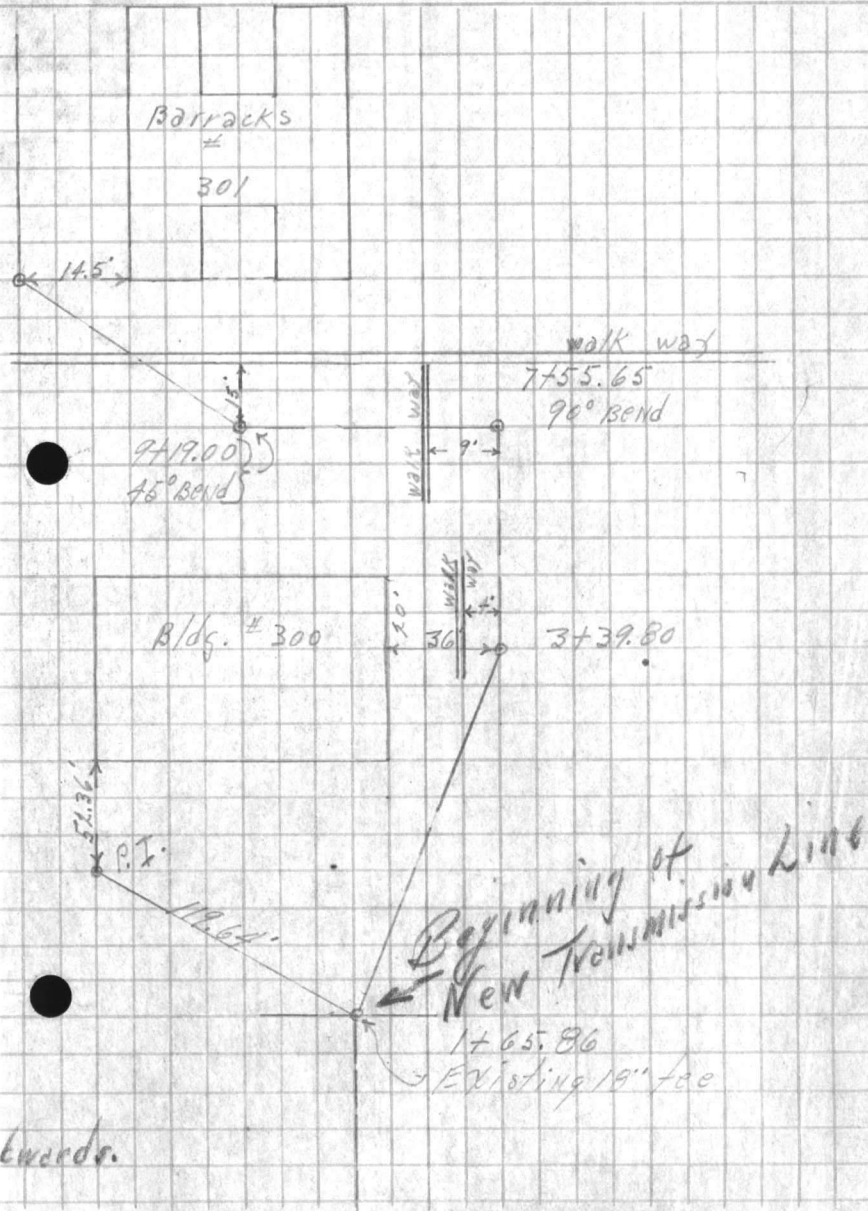

Angles Reversed
Line was Produced Backwards.







 

VALUABLE
Return To
Public Works
Office
Camp Lejeune
North Carolina





56. 2/15/59

VALUABLE

Return To
Public Works
Office
Camp LeJeune
North Carolina


SUBJECT New Location of Proposed
ROW Water Line in Regimental Area
#5
see sheets dated 1-9-51
For tie.

FIELD PARTY
Kellum In Charge
Instrument _____
Notes _____
Tape Read _____
Tape or Rod _____
Tape or Rod _____
Instrument No. _____
Tape No. _____

WEATHER
Clear _____
Cloudy _____
Windy _____
Rain _____
Fair _____
Snow _____
Hot _____
Moderate _____
Cold _____
Fog _____
Figured By _____
Notes Checked By _____
Plotted By _____

FILE No. _____
Fldr. No. _____
Sheet 3 of _____
Date 1-22-1951
Quad. No. _____

| Station | Dist. | Angle " | + | H. I. Bearing | Ver: Ang. Diff. | Elevation |
|--|----------|--------------------------|---|---------------|-----------------|-----------|
| P.I. #9 50+74.33 to P.C. 65+14.43 | 1- 3- | 179°56'30" 179°49'15" | | | | |
| | | MEAN 179°56'25" | | | | 1586.25' |
| P.I. #8 34+88.08 | 1- 3- | 201°54'00" 145°41'30" | | | | |
| | | MEAN 201°53'50" | | | | 185.74' |
| P.I. #7 33+02.34 | 1- 3- | 157°30'15" 112°31'15" | | | | |
| | | MEAN 157°30'25" | | | | 736.64' |
| P.I. #6 25+65.70 | 1- 3- | 176°02'00" 168°06'30" | | | | |
| | | MEAN 176°02'10" | | | | |

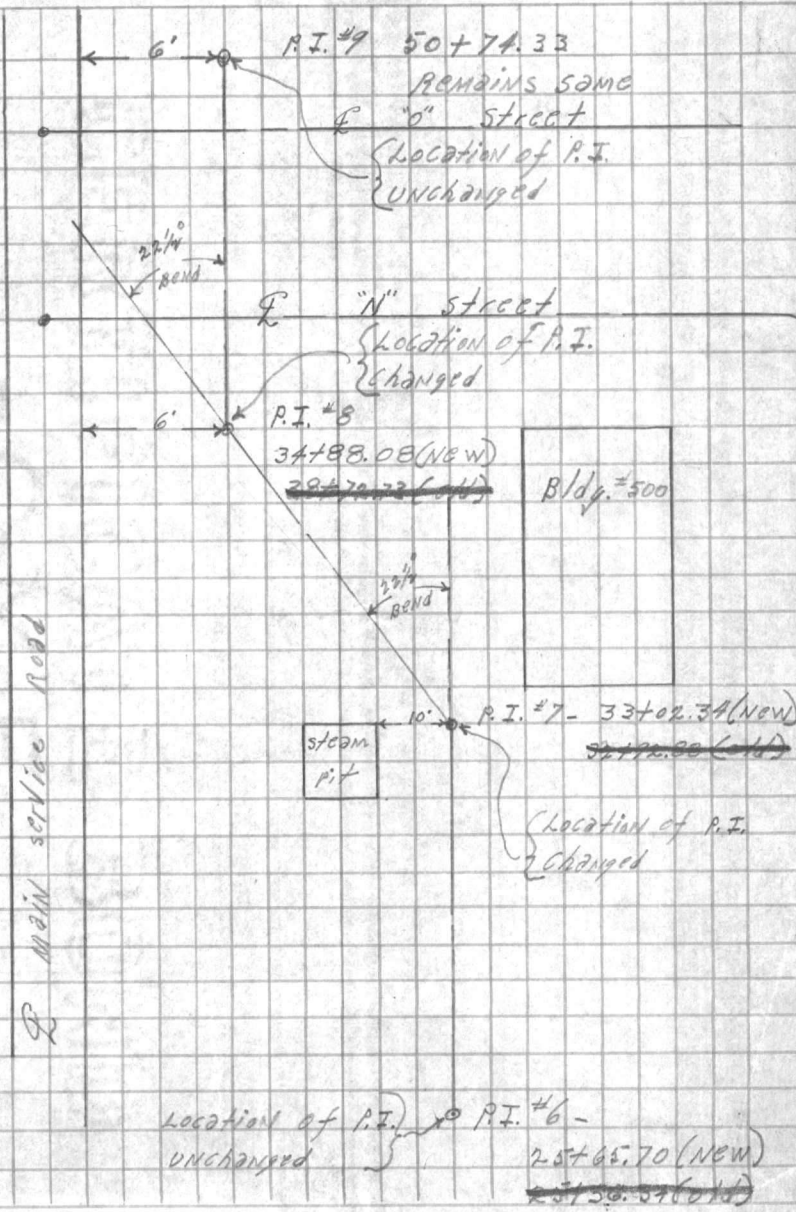




1911
1912
VALUABLE

Return To
Public Works
Office
Camp Lejeune
North Carolina

SUBJECT Proposed Water Line
Location
Tie Line from Transmission Line to
Water Storage Tank in Drill Field on
Holcomb Blvd.

FIELD PARTY

Kelton In Charge
Instrument _____
Notes _____
Tape Read _____
Tape or Rod _____
Tape or Rod _____
Instrument No. _____
Tape No. _____

WEATHER

Clear _____
Cloudy _____
Windy _____
Rain _____
Fair _____
Snow _____
Hot _____
Moderate _____
Cold _____
Fog _____

FILE No. 160-6

Fldr. No. _____

Figured By _____ Sheet 1 of 2


Notes Checked By _____

Plotted By _____ Date 1-26-51

Quad. No. _____

| Station | Dist. | Angle | + | H. I. Bearing | Ver: Ang. Diff. | Elevation |
|---------|-------|-------|---|---------------|-----------------|-----------|
|---------|-------|-------|---|---------------|-----------------|-----------|

1450

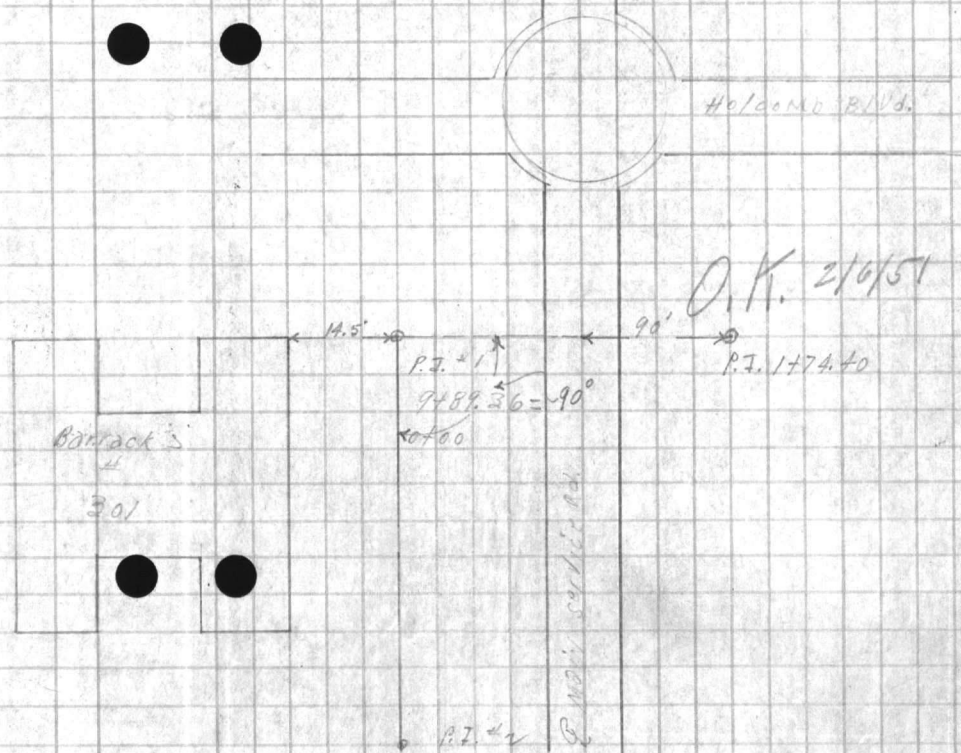

VALUABLE

SUBJECT Proposed water line location
Continued

Return To
 Public Works
 Office
 Camp Lejeune
 North Carolina

FIELD PARTY

_____ In Charge
 _____ Instrument
 _____ Notes
 _____ Tape Read
 _____ Tape or Rod
 _____ Tape or Rod
 _____ Instrument No.
 _____ Tape No.

WEATHER

Clear _____
 Cloudy _____
 Windy _____
 Rain _____
 Fair _____
 Snow _____
 Hot _____
 Moderate _____
 Cold _____
 Fog _____

FILE No. _____


Fldr. No. _____

Figured By _____ Sheet 2 of 2

Notes Checked By _____

Plotted By _____ Date 1-26-1951

Quad. No. _____

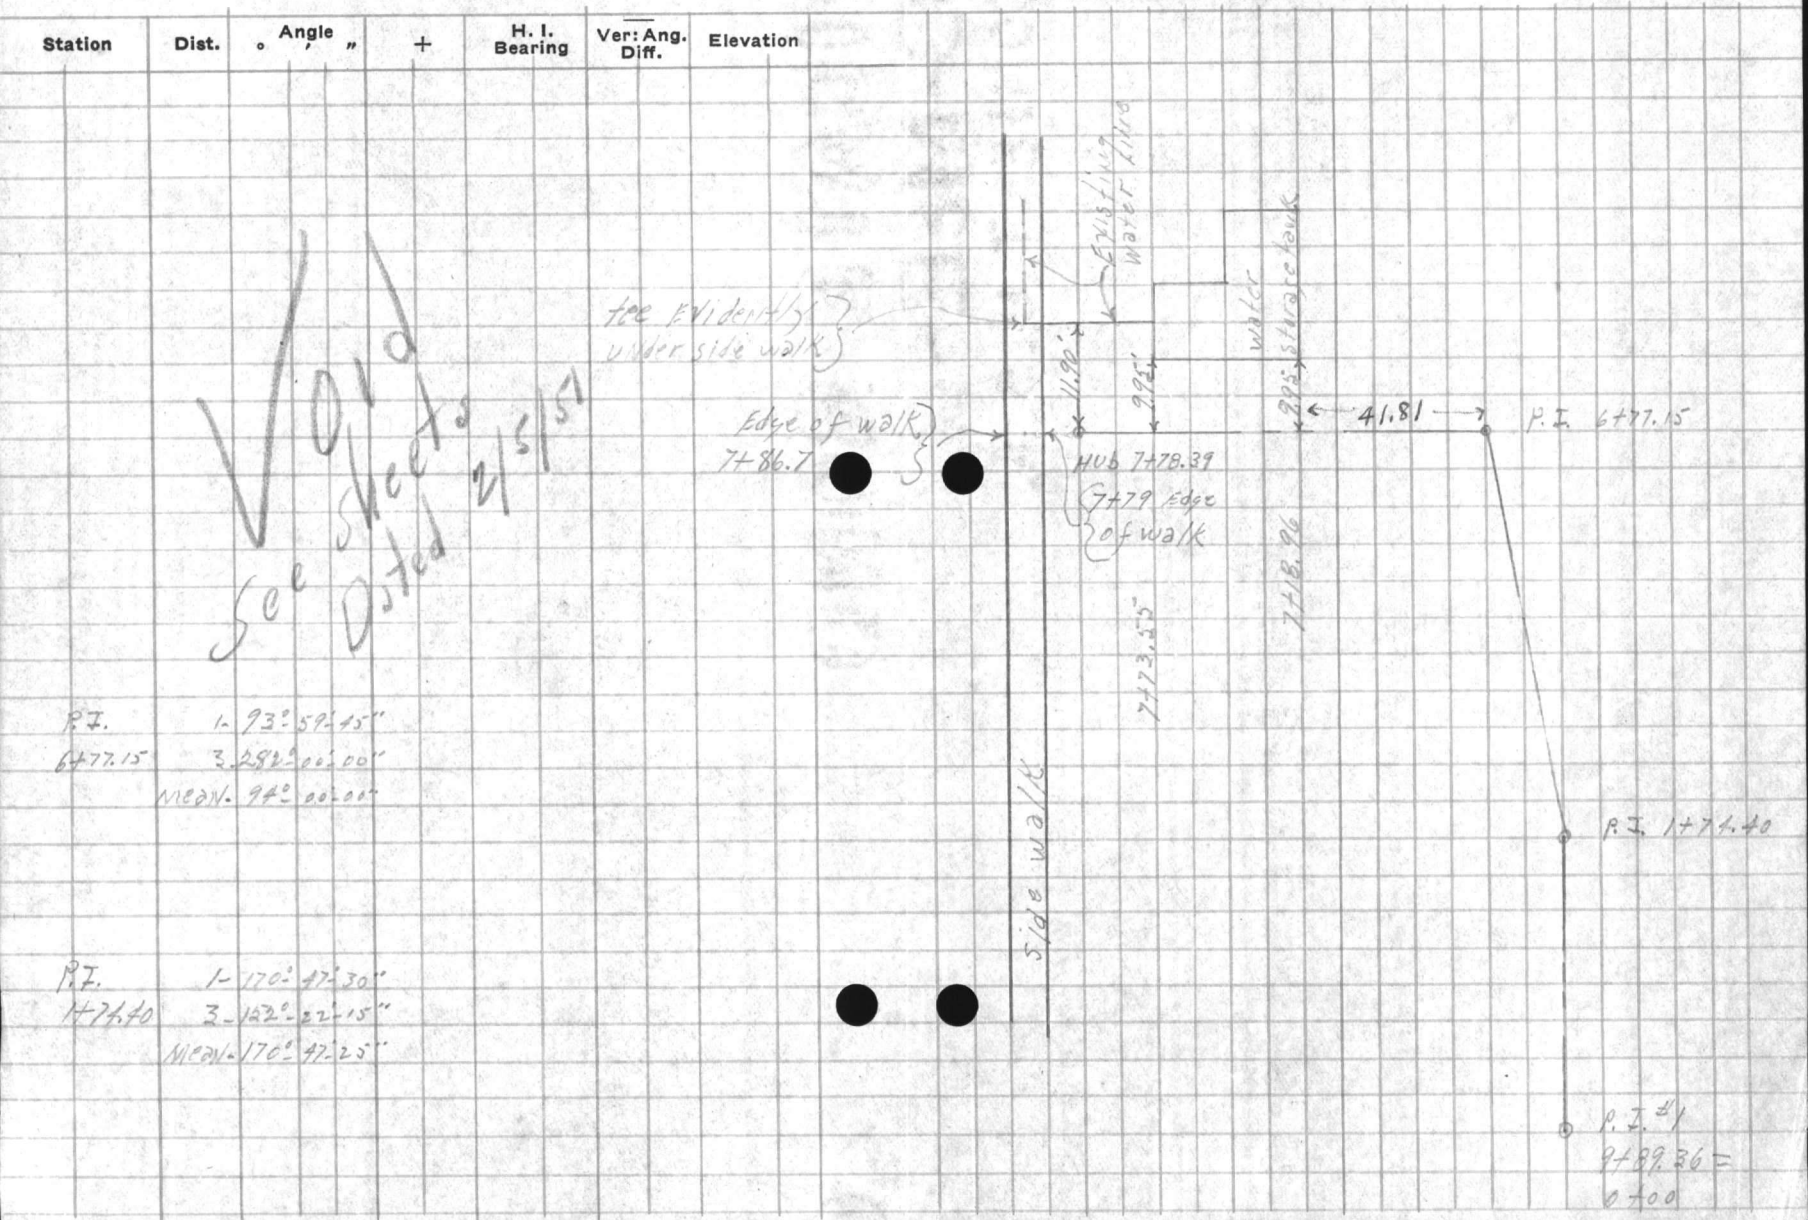

VALUABLE

SUBJECT profile on proposed
water line to water storage
tanks

Return To
 Public Works
 Office
 Camp LeJeune
 North Carolina

FIELD PARTY

Kellum In Charge
 Instrument _____
 Notes _____
 Tape Read _____
 Tape or Rod _____
 Tape or Rod _____
 Instrument No. _____
 Tape No. _____

WEATHER

Clear _____
 Cloudy _____
 Windy _____
 Rain _____
 Fair _____

Snow _____
 Hot _____
 Moderate _____
 Cold _____
 Fog _____

FILE No. _____
 Fldr. No. _____
 Sheet 1 of 4
 Date 1-26- 1957
 Plotted By _____

Quad. No. _____

| Station | Dist. | Angle " | + | H. I. Bearing | Ver: Ang. Diff. | Elevation | |
|-----------|-------|---------|---|---------------|-----------------|-----------|-------------------------------------|
| B.M. | | | | 90 | | 26.30 | Finish Floor Barracks = 301 |
| 9+89.36 = | | | | 3.50 | 29.80 | | |
| 0+00 | | | | | 4.7 | 25.7 | |
| 0+10 | | | | | | | 9.5' left edge of steam pit |
| 0+15 | | | | | 6.75 | 23.05 | top of 12" steam main |
| 0+17 | | | | | 7.40 | 22.5 | top of 5" return |
| 0+21 | | | | | | | 10' left to edge of steam pit |
| 0+34 | | | | | 4.6 | 25.3 | Edge side walk |
| 0+41 | | | | | 4.6 | 25.3 | 12" G.I. water line under side walk |
| 0+47 | | | | | 9.1 | 20.8 | top of tel. conduit |
| 0+55 | | | | | 5.2 | 24.7 | 2' ditch |
| 0+64 | | | | | 4.0 | 25.9 | Bank - 11' left to fire hydr. |
| 0+73 | | | | | 3.5 | 26.4 | Edge of M.S. Rd. |
| 0+90 | | | | | 3.5 | 26.4 | " " " |
| 1+00 | | | | | 3.7 | 26.7 | |
| 1+08 | | | | | 4.1 | 25.8 | ditch |

Handwritten notes:
 2/6/51
 (Large scribble)

VALUABLE

SUBJECT Profile cont'd.

Return To _____
 Public Works _____
 Office _____
 Camp Lejeune _____
 North Carolina _____

FIELD PARTY

_____ In Charge
 _____ Instrument
 _____ Notes
 _____ Tape Read
 _____ Tape or Rod
 _____ Tape or Rod
 _____ Instrument No.
 _____ Tape No.

WEATHER

Clear _____
 Cloudy _____
 Windy _____
 Rain _____
 Fair _____

Snow _____
 Hot _____
 Moderate _____
 Cold _____
 Fog _____

FILE No. _____

Fldr. No. _____

Figured By _____ Sheet 2-044

Notes Checked By _____

Plotted By _____ Date 1-26-1951

Quad. No. _____

| Station | Dist. | Angle " | + | H. I. Bearing | Ver: Ang. Diff. | Elevation |
|--------------------|-------|---------|---|----------------------------------|-----------------|-------------------------|
| | | | | <u>29.90</u> 29.81 | | |
| 1420 | | | | | 2.6 | 26.3 |
| 1428 | | | | | 3.3 | 26.6 |
| 1435 | | | | | 3.2 | 26.7 |
| P.I. 1474.40 | | | | | 2.9 | 26.9 27.0 |
| 2400 | | | | | 2.7 | 27.2 |
| T.P. | | | | 970 | 2.83 | 26.97 |
| 4450 | | | | 5.90 | 3.1 | 27.5 |
| 3400 | | | | | 5.1 | 27.9 |
| 3750 top | | | | | 4.9 | 28.1 |
| 3788 1/3" stream | | | | | 7.25 | 25.72 |
| 3790 top 2" return | | | | | 2.22 | 25.55 |
| 4400 | | | | | 4.7 | 28.3 |
| 4450 | | | | | 4.8 | 28.2 |
| 5400 | | | | | 4.7 | 28.3 |
| 5450 | | | | | 4.8 | 28.2 |
| 6400 | | | | | 4.9 | 28.1 |

O.K.
 2/6/51
 Void
 See Sheets
 Dated 2/5/51

BANK
 Edge of walk

Note:
 Electric cable somewhere between 5400, 4450 and 5450. The way the cable goes through tunnel shows cable hitting water line at 4450. cable is about 30' deep.

See next sheet







VALUABLE

SUBJECT

Profile contd.

Return To
Public Works
Office
Camp Lejeune
North Carolina

FIELD PARTY

In Charge
Instrument
Notes
Tape Read
Tape or Rod
Tape or Rod
Instrument No.
Tape No.

WEATHER

Clear
Cloudy
Windy
Rain
Fair
Snow
Hot
Moderate
Cold
Fog

FILE No.

Fldr. No.

Sheet

Date


3-04

1-26-1951

Quad. No.

| Station | Dist. | Angle | H. I. Bearing | Ver. Ang. Diff. | Elevation |
|-----------------------------|-------|-------|---------------|-----------------|-----------|
| | | | 32.87 | | |
| 6+50 | | | | 5.0 | 28.0 |
| P.I. 6+77.15 | | | | 5.1 | 27.9 |
| INV. INM. H. "A" 24" R.C.P. | | | | 13.90 | 19.07 |
| INV. 24" R.C.P. IN M.H. "B" | | | | 14.36 | 18.61 |
| 6+88.6 | | | | 5.4 | 27.6 |
| STEAM PIT "A" | | | | 9.00 | 23.97 |
| top of 14" steam in pit "A" | | | | 9.10 | 23.87 |
| top of 8" return in pit "A" | | | | 9.70 | 23.27 |
| ON top 14" steam IN PIT "B" | | | | 8.65 | 24.32 |
| ON top 14" steam in PIT "B" | | | | 8.75 | 24.22 |
| ON top 8" return in PIT "B" | | | | 9.10 | 23.87 |
| 7+00 | | | | 4.8 | 28.2 |
| 7+05 | | | | 4.7 | 28.3 |
| 7+09 | | | | 4.32 | 28.45 |

Void

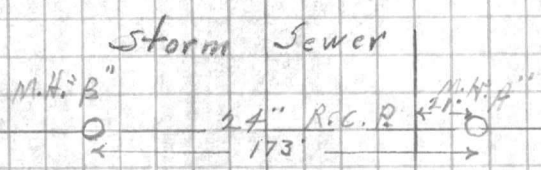

R between steam lines
Edge of steam tunnel

VALUABLE

SUBJECT

Profile contd.

Return To
Public Works
Office
Camp LeJeune
North Carolina

FIELD PARTY

_____ In Charge
 _____ Instrument
 _____ Notes
 _____ Tape Read
 _____ Tape or Rod
 _____ Tape or Rod
 _____ Instrument No.
 _____ Tape No.

WEATHER

Clear
 Cloudy
 Windy
 Rain
 Fair

Snow
 Hot
 Moderate
 Cold
 Fog

FILE No. _____

Fldr. No. _____

Figured By _____

Sheet

4 of 4

Notes Checked By _____

Plotted By _____

Date

1-26-1951

Quad. No. _____

| Station | Dist. | Angle | " | + | H. I. Bearing | Ver. Ang. Diff. | Elevation |
|----------------|-------|-------|---|---|------------------|--------------------|---------------|
| 7419 | | | | | 32.87 | 9.24 | 28.73 |
| | | | | | | | 24.04 |
| | | | | | | 8.93 | 22.74 |
| | | | | | | | 24.03 |
| | | | | | | 8.94 | 23.92 |
| | | | | | | | 26 |
| | | | | | | 9.71 | 23.76 |
| | | | | | | | 48 |
| | | | | | | 11.49 | 21.38 |
| 7455 | | | | | | 4.3 | 28.7 |
| 7470 | | | | | | 4.5 | 29.5 |
| 7478.39 | | | | | | 4.2 | 28.8 |
| | | | | | | | 47 |
| | | | | | | 2.30 | 27.27 |
| | | | | | | | 86 |
| | | | | | | 8.11 | 24.76 |
| B.M. | | | | | | 4.09 | 28.78 (28.88) |
| Floor Bldg. #1 | | | | | | 1.70 | 31.17 (31.30) |

Edge of steam tunnel

2' Right 8" Pipe 2.5' Left 10" Pipe

5' ± Electric cable

7' Right of Sta. 7478.39 TOP of 12" overflow pipe

on top of 12" existing water line at
Storage tankspike in guy pole on south side of Helcomb
Bldg. off S.W. cor. Bldg. #15

Void
























RECEIVED

VALUABLE

SUBJECT PROPOSED RAW
WATER LINE STAKE OUT.
Tie to Existing 8" X 8" Tee at
Well # 9 on Snoods Ferry Road

Return To
 Public Works
 Office
 Camp LeJeune
 North Carolina


FIELD PARTY
DENNIS In Charge
 Instrument _____
 Notes _____
 Tape Read _____
 Tape or Rod _____
 Tape or Rod _____
 Instrument No. _____
 Tape No. _____

WEATHER
 Clear _____
 Cloudy _____
 Windy _____
 Rain _____
 Fair _____
 Snow _____
 Hot _____
 Moderate _____
 Cold _____
 Fog _____
 Figured By _____
 Notes Checked By _____
 Plotted By _____

FILE No. _____
 Fldr. No. _____
 Sheet 1 D F 1
 Date 1-27 1951

Quad. No. _____

| Station | Dist. | Angle | H. I. Bearing | Ver: Ang. Diff. | Elevation |
|-------------------------|---------------|-------------------|---------------|-----------------|-----------|
| 8" X 8" Tee 22+41.34 | | | | | |
| 22 1/2° Bend | 2+61.05 | 160° 20' 15" | | | 175.40 |
| 22 1/2° Bend | 0+85.65 | 157° 30' 00" | | | 85.65 |
| P.O.C. | 133+41 = 0+00 | 92° 35' = 90° Tee | | | |
| P.C. | 131+47.24 | 2° 35' Ret. | | | |

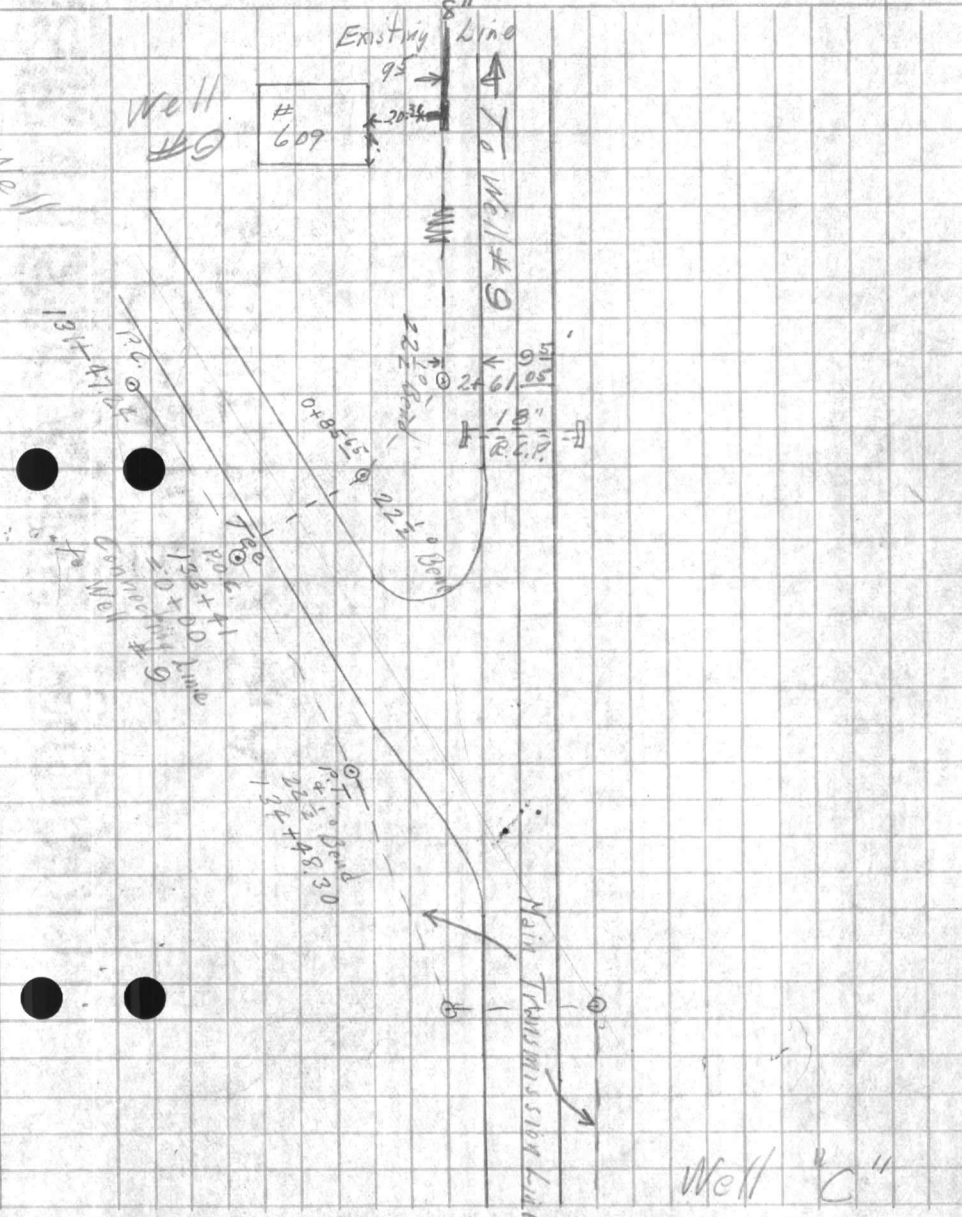

VALUABLE

SUBJECT

PROFILE DN
 PROPOSED RAW LINE
 TO Existing Well #9 on S.F. Rd.

Return To
 Public Works
 Office
 Camp LeJeune
 North Carolina

FIELD PARTY

DANNIS In Charge

Instrument

Notes

Tape Read

Tape or Rod

Tape or Rod

Instrument No.

Tape No.

WEATHER

Clear
 Cloudy
 Windy
 Rain
 Fair

Snow
 Hot
 Moderate
 Cold
 Fog

FILE No. _____

Fldr. No. _____

Sheet

1 OF 5

Date

1-27 1951

Figured By _____

Notes Checked By _____

Plotted By _____

Quad. No. _____

| Station | Dist. | Angle | H. I. Bearing | Ver. Ang. Diff. | Elevation | |
|---------------------|--------------------------|-------|---------------|-----------------|-----------|---|
| B.M. | | | 467 35 38 | | 30.71 | DN OAK TREE RIGHT OF SNEEDS Rd 8 M.S.R. INTERSECTION |
| 133+41 ² | Trans. Mark | | | | | |
| 0+00 | Lat. to Existing Well #9 | | | 6 1 | 29.3 | |
| 0+16 | | | | 5 0 | 30.4 | EDGE Rd. |
| 0+37 | | | | 5 0 | 30.4 | EDGE Rd. |
| 0+42 | | | | 5 2 | 30.2 | |
| 0+50 | | | | 5 7 | 29.7 | |
| 0+55 | | | | 6 4 | 29.0 | |
| 0+71 | | | | 4 1 | 31.3 | |
| 0+72 | 12' R | | 14" PINE | | | |
| 0+85 ² | | | | 3 5 | 31.9 | |
| 0+87 ² | 42' R | | TEL. POLE | | | |
| 1+00 | | | | 3 5 | 31.9 | |
| 1+06 | 13' LEFT | | 6" OAK | | | |
| 1+28 | 14' LEFT | | 10" PINE | 4 0 | 31.4 | |
| 1+40 | 13' LEFT | | 8" PINE | | | |
| 1+50 | | | | 4 4 | 31.0 | |






























































VALUABLE

SUBJECT _____

Return To
Public Works
Office
Camp Lejeune
North Carolina

FIELD PARTY

 _____ In Charge
 _____ Instrument
 _____ Notes
 _____ Tape Read
 _____ Tape or Rod
 _____ Tape or Rod
 _____ Instrument No.
 _____ Tape No.

WEATHER

 Clear
 Cloudy
 Windy
 Rain
 Fair
 Snow
 Hot
 Moderate
 Cold
 Fog

FILE No. _____

Fldr. No. _____

Sheet 3055

Figured By _____

Notes Checked By _____

Plotted By _____ Date _____ 19____

Quad. No. _____

| Station | Dist. | Angle | H. I. Bearing | Ver. Ang. Diff. | Elevation | |
|---------|-------|-------|---------------|-----------------|-----------|--------------------|
| | | | 35 48 | | | |
| 6+50 | | | | 5 9 | 29.6 | |
| 7+00 | | | | 5 5 | 30.0 | |
| 7+50 | | | | 5 5 | 30.0 | |
| 8+00 | | | | 5 5 | 30.0 | |
| 8+50 | | | | 5 4 | 30.1 | |
| 9+00 | | | | 5 5 | 30.0 | |
| 9+50 | | | | 5 0 | 30.5 | |
| 10+00 | | | | 5 1 | 30.4 | |
| 10+50 | | | | 4 9 | 30.6 | |
| 11+00 | | | | 4 7 | 30.8 | |
| 11+11 | 19' | LEFT | TEL. POLE | | | |
| 11+50 | | | | 4 5 | 31.0 | |
| 11+80 | | | | 4 10 | 31.4 | EDGE TANK CROSSING |
| 11+88 | | | | 4 07 | 31.4 | EDGE TANK CROSSING |
| 12+00 | | | | 4 4 | 31.1 | |
| T.P. | | | | 3 46 | 32.02 | |
| | | 4 28 | 36 30 | | | |
| 12+50 | | | | 5 4 | 30.9 | |
| 13+00 | | | | 5 6 | 30.7 | |
| 13+50 | | | | 5 4 | 30.9 | |

















VALUABLE

SUBJECT _____

Return To
Public Works
Office
Camp Lejeune
North Carolina

FIELD PARTY

_____ In Charge
_____ Instrument
_____ Notes
_____ Tape Read
_____ Tape or Rod
_____ Tape or Rod
_____ Instrument No.
_____ Tape No.

WEATHER

Clear
Cloudy
Windy
Rain
Fair

Snow
Hot
Moderate
Cold
Fog

FILE No. _____

Fldr. No. _____

Sheet 4055

Date _____ 19____

Figured By _____
Notes Checked By _____
Plotted By _____

Quad. No. _____

| Station | Dist. | Angle ° ' " | + | H. I. Bearing | Ver: Ang. Diff. | Elevation |
|---------|-------|----------------|---|------------------|--------------------|-----------|
| | | | | 36 30 | | |
| 14+00 | | | | | 5 6 | 30.7 |
| 14+50 | | | | | 5 5 | 30.8 |
| 15+00 | | | | | 5 6 | 30.7 |
| 15+50 | | | | | 5 5 | 30.8 |
| 16+00 | | | | | 5 6 | 30.7 |
| 16+50 | | | | | 5 6 | 30.7 |
| 17+00 | | | | | 5 8 | 30.5 |
| 17+50 | | | | | 5 7 | 30.6 |
| 18+00 | | | | | 5 7 | 30.6 |
| 18+50 | | | | | 5 5 | 30.8 |
| 19+00 | | | | | 5 A | 30.9 |
| T.P. | | | | | 4 74 | 31.56 |
| | | | | 3 91 | 35 40 | |
| 19+50 | | | | | 5 0 | 30.5 |
| 20+00 | | | | | 5 2 | 30.3 |
| 20+50 | | | | | 5 6 | 29.9 |






























VALUABLE

SUBJECT _____

Return To
Public Works
Office
Camp LeJeune
North Carolina

FIELD PARTY

____ In Charge
____ Instrument
____ Notes
____ Tape Read
____ Tape or Rod
____ Tape or Rod
____ Instrument No.
____ Tape No.

WEATHER

Clear
Cloudy
Windy
Rain
Fair

Snow
Hot
Moderate
Cold
Fog

FILE No. _____

Fldr. No. _____

Sheet 5 DFS

Date _____ 19____

Figured By _____

Notes Checked By _____

Plotted By _____

Quad. No. _____

| Station | Dist. | Angle | " | + | H. I. Bearing | Ver: Ang. Diff. | Elevation |
|---------------------|-------|-------|---|---|------------------|--------------------|-----------|
| | | | | | 35 47 | | |
| 21+00 | | | | | 5 8 | | 29.7 |
| 21+50 | | | | | 6 3 | | 29.2 |
| 22+00 | | | | | 7 0 | | 28.5 |
| 22+41 ³⁴ | | | | | 7 3 | | 28.2 |
| | | | | | 12.3 | | 23.2 |
| B.M. #8 | | | | | 1 61 | | 33.86 |

Ground
Top of 8" x 8" Tee

ON 3rd Pole East of well #609

These
Elev. Checked by Two Runs of Check Levels.















PUBLIC WORKS DEPARTMENT
Camp Lejeune, North Carolina
Survey Department

File _____
Quadrangle _____
Date 1/29/51
Sheet # 1 of 2

Traverse Computation
Description

Tie Line to Well House # 9 in Speeds Ferry Rd. " " " " " "
Tie Line to Water Storage Tank on Holcomb Blvd. from New Row Water Transmission Line

To Storage Tank

| Station | Distance | Bearing | Cosine | Sine | Latitude | Departure | Y Coordinate North | X Coordinate East |
|--------------------------------------|--|--------------|--------------------|--------|----------|-----------|--------------------|-------------------|
| P.I. 9+89.36 = 0+00 Tee | | N36°26'54" W | from P.I. 12+27.44 | | | | 336,779.06 | 2,496,717.42 |
| P.I. 1+74.40 11 1/4° Bend | 174.40 | N53-33-06 E | 594098 | 804393 | 103.61 | 140.29 | 336,882.67 | 2,496,857.77 |
| P.I. 6+77.15 Tee or 90° Bend | 502.75 | N44-20-31 E | 715181 | 698939 | 359.56 | 351.39 | 337,242.23 | 2,497,209.16 |
| P.I. 7+78.39 | 101.24 | N41-39-29 W | 747125 | 664684 | 75.64 | 67.29 | 337,317.87 | 2,497,141.87 |
| See Location Sheet for Tie ± | <div style="border: 1px solid black; border-radius: 50%; padding: 10px; display: inline-block;"> Changed to New Location 2/6/51 See Attached sheet Date 2/6/51 </div> | | | | | | | |
| P.I. 12 to P.I. #11 | | N82°46'13" W | | | | | 332,376.19 | 2,507,712.29 |
| P.C. 131+47.24 | 150.43 | " | 125848 | 992049 | 18.93 | 149.23 | 332,395.12 | 2,507,563.06 |
| P.O.C. 133+41 = 0+00 Tee | 193.69 | S80-11-13 E | 170434 | 985369 | 33.01 | 190.86 | 332,362.11 | 2,507,753.92V |
| P.I. 0+85.65 22 1/2° Bend | 85.65 | N12-23-47E | 976686 | 214674 | 83.65 | 18.39 | 332,445.76 | 2,507,772.31 |
| P.I. 2+61.05 22 1/2° Bend | 175.40 | N10-06-13 W | 984492 | 175429 | 172.68 | 30.77 | 332,618.44 | 2,507,741.54 |
| P.I. 22+41.34 = 8"x8" Tee at Well #9 | 1980.29 | N29-45-58 W | 868059 | 496461 | 1719.01 | 983.14 | 334,337.45 | 2,506,758.40 |

74.40
25.60

0.0

D 20 40'
R 2148.79



































VALUABLE

SUBJECT

Profile and topog. on
Relocation of water line Bldg. #1 Area.Return To
Public Works
Office
Camp Lejeune
North Carolina

FIELD PARTY

In Charge _____
Instrument _____
Notes _____
Tape Read _____
Tape or Rod _____
Tape or Rod _____
Instrument No. _____
Tape No. _____

WEATHER

Clear _____
Cloudy _____
Windy _____
Rain _____
Fair _____
Snow _____
Hot _____
Moderate _____
Cold _____
Fog _____

FILE No. _____

Fldr. No. _____

Sheet 2 of 4

Date 2-5-1951

Quad. No. _____

| Station | Dist. | Angle | " | + | H. I. Bearing | Ver: Ang. Diff. | Elevation | |
|---------|----------|-------|---|---|------------------|--------------------|-----------|--------------------------------------|
| B.M. | | | | | | ✓ | 28.89 | Spike in guy pole front of Bldg. #15 |
| | | | | | | ✓ | | |
| 1+74.40 | 45° Bend | | | | | 6.3 | 27.0 | |
| 2+00 | | | | | | 6.4 | 27.1 | |
| 2+32 | | | | | | | | Small planted tree 12' left |
| 2+50 | | | | | | 5.8 | 27.5 | |
| 2+56 | | | | | | | | Power pole 11' left |
| 2+56 | | | | | | 10.4 | 22.9 | top of 6" steam return |
| 2+59 | | | | | | 9.6 | 23.7 | top of 12" steam main |
| 2+65 | | | | | | | | 12' right to guy wire anchor |
| 2+88 | | | | | | | | 9' left 4" planted tree |
| 3+00 | | | | | | 8.5 | 27.8 | |
| 3+50 | | | | | | 5.2 | 28.1 | |
| 3+57 | P.I. | | | | | | | 8' left point of structure |
| 3+82 | | | | | | | | 9' left to 3" planted tree |
| 4+00 | | | | | | 4.8 | 28.5 | |
| 4+31 | | | | | | | | 9' left small planted tree |

SUBJECT

Return To
Public Works
Office
Camp Lejeune
North Carolina






























VALUABLE

SUBJECT

Profile and Topog.

Return To
Public Works
Office
Camp Lejeune
North Carolina

FIELD PARTY

In Charge _____
Instrument _____
Notes _____
Tape Read _____
Tape or Rod _____
Tape or Rod _____
Instrument No. _____
Tape No. _____

WEATHER

Clear _____
Cloudy _____
Windy _____
Rain _____
Fair _____
Snow _____
Hot _____
Moderate _____
Cold _____
Fog _____
Figured By _____
Notes Checked By _____
Plotted By _____

FILE No. _____
Fldr. No. _____
Sheet *3 of 4*
Date *2-5-1937*

Quad. No. _____

| Station | Dist. | Angle | " | + | H. I. Bearing | Ver. Ang. Diff. | Elevation | |
|---------|-------|-------|---|---|---------------|-----------------|-----------|------------------------------------|
| | | | | | 33.31 | ✓ | | |
| 442 | | | | | | | | 10' Right End of steam tunnel pit |
| 456 | | | | | 9.6 | | 28.7 | 10' Right to Edge of Pit |
| 482 | | | | | | | | 9' Left 3" planted tree |
| T.B.M. | | | | | 1.74 | | 28.57 | |
| | | | | | 5.04 | | 33.69 | |
| 431 | | | | | 10.15 | | 23.54 | top of 14" steam main |
| 433.5 | | | | | 10.90 | | 23.29 | top of 8" return |
| 500 | | | | | 5.0 | | 28.6 | |
| 531 | | | | | | | | 9' Left to 3" planted tree |
| 532 | | | | | | | | 12' Right to angle in steam tunnel |
| 550 | | | | | 5.9 | | 28.3 | |
| 581 | | | | | | | | 9' Left to small planted tree |
| 600 | | | | | 5.3 | | 28.4 | |
| 637 | | | | | | | | 6" black gum on line |
| 650 | | | | | 5.3 | | 28.4 | |

Station
Camp Lejeune
North Carolina

SUBJECT

Barometric
Pressure

Other

Station

Dir.

Angle

Barang

Var. Ang.

Elevation

Tap No.
Instrument No.

Tap at End

Tap on Rod

Tap Lead

Notes

Instrument

In. Operate

FIELD PARTY

WEATHER

Cloud

Wind

Rain

Fog

Other

Remarks

Time

Date

FILE No.

Field No.

Sheet

Checked By

Plotted By

Date

VALUABLE

SUBJECT

Profile and topog. cont'd

Return To
Public Works
Office
Camp Lejeune
North Carolina

FIELD PARTY

In Charge _____
Instrument _____
Notes _____
Tape Read _____
Tape or Rod _____
Instrument No. _____
Tape No. _____

WEATHER

Clear _____
Cloudy _____
Windy _____
Rain _____
Fair _____
Snow _____
Hot _____
Moderate _____
Cold _____
Fog _____

FILE No. _____

Fldr. No. _____

Sheet

4 of 4

Date

2-5-1957

Figured By _____

Notes Checked By _____

Plotted By _____

Quad. No. _____

| Station | Dist. | Angle | " | + | H. I. Bearing | Ver: Ang. Diff. | Elevation |
|---------|-------|-------|---|---|------------------|--------------------|-----------|
|---------|-------|-------|---|---|------------------|--------------------|-----------|

33.69

✓

6+61

8' Right to 10" pine

6+75

1' Right to 8" Pine

P.I. 6+87

5.3

28.

 $\frac{4}{2}$

7+00

5.2

28.

 $\frac{5}{4}$

7+21

4.82

28.

 $\frac{87}{77}$

Edge of 8' sidewalk

7+31.10

1.89

28.

 $\frac{80}{72}$

7+41.10

4.92

28.

 $\frac{77}{67}$

on sidewalk over existing fee

8.87

24.

 $\frac{82}{74}$

top of existing 12" main

B.M.

1.80

28.81

(28.89)

spike in guy pole opposite B.M. #15

VALENTINE
Form for
Public Works
Office
Camp Lejeune
North Carolina

SUBJECT

Station Dist. Angle H. L. H. L. H. L. H. L.
Bearing Bearing Bearing Bearing Bearing Bearing Bearing

FIELD PARTY
In Charge _____
Instrument _____
Notes _____
Tape Rod _____
Type of Rod _____
Type of Rod _____
Instrument No. _____
Tape No. _____

WEATHER
Clear _____
Cloudy _____
Windy _____
Rain _____
Fog _____
Faintly _____
Notes Checked By _____
Placed By _____

FIELD NO. _____
Fid. No. _____
Sheet _____
Date _____


PUBLIC WORKS DEPARTMENT
Camp Lejeune, North Carolina
Survey Department

File 160-5
Quadrangle _____
Date _____
Sheet _____ of _____

Traverse Computation
Description

Proposed Well Sites - Main Service Road & Sweets Ferry Road.

| Station | Distance | Bearing | Cosine | Sine | Latitude | Departure | Y Coordinate North | X Coordinate East |
|--------------------------------------|----------|--------------------------------------|---------|---------|----------|-----------|--------------------|-------------------|
| * Well "A" See sheet Dated 1/22/51 - | | | | | | | * 333,733.27 | 2,503,588.39 |
| P.I. #10 95+33.96 | | Water Trans. Line to New Well Sites. | | | | | 332,850.13 | 2,503,978.66 |
| Sta. 109+00 | 1366.04 | 582°45'36"E to P.I. #11 | 126026 | 992027 | 172.16 | 1355.15 | 332,677.97 | 2,505,333.81 |
| * Well "B" 90° 85' 04" E Rd. | 68.00 | 57-14-24 W | 992027 | 126026 | 67.46 | 18.57 * | 332,610.51 | 2,505,325.24 |
| P.I. 135+86.23 | | 529°41'15"E to P.I. 145+58.51 | | | | | 332,293.66 | 2,507,969.40 |
| Sta. 140+00 | 413.77 | " | 8687396 | 195269 | 359.46 | 204.93 | 331,934.20 | 2,508,174.33 |
| * Well "C" 90° 108.5' 04" E Rd. | 91.5 | N60-18-45 E | 495269 | 8687396 | 45.32 | 79.49 * | 331,979.52 | 2,508,253.82 |
| P.I. 162+12.30 | | 528°58'06"E to P.I. 177+00.60 | | | | | 330,005.26 | 2,509,251.44 |
| Sta. 169+0 | 687.70 | " | 8748875 | 484326 | 601.66 | 333.07 | 329,403.60 | 2,509,585.51 |
| * Well "D" 90° 108.5' 04" E Rd. | 91.5 | N61-01-54 E | 484326 | 8748875 | 44.32 | 80.05 * | 329,447.92 | 2,509,669.56 |
| P.I. 191+83.12 | | 528°59'22"E to P.I. 213+82.16 | | | | | 327,406.48 | 2,510,694.71 |
| Sta. 204+0 | 1216.88 | " | 874709 | 484648 | 1064.42 | 589.76 | 326,342.06 | 2,511,284.87 |
| * Well "E" 90° 108.5' 04" E Rd. | 91.5 | N61-00-38 E | 484648 | 874709 | 44.35 | 80.04 * | 326,386.41 | 2,511,364.51 |
| P.I. 236+00.00 | | N18°12'38"W Back to P.I. 222+47.13 | | | | | 323,427.89 | 2,512,573.55 |
| Sta. 233+0 | 300.00 | " | 949914 | 312510 | 284.97 | 93.75 | 323,712.86 | 2,512,480.10 |
| * Well "F" 90° 108.5' 04" E Rd. | 91.5 | N71-47-22 E | 312510 | 949914 | 28.59 | 86.92 * | 323,741.45 | 2,512,566.02 |

 

Well Sites A, B, C, D, E, F, G

