

VALUABLE

Return To
Public Works
Office
Camp Lejeune
North Carolina

SUBJECT coordinate position of Bend
in water line in back of Bldg.
#1709
"Elevation"

FIELD PARTY
Return In Charge
Instrument
Notes
Tape Read
Tape or Rod
Tape or Rod
Instrument No.
Tape No.

WEATHER
Clear
Cloudy
Windy
Rain
Fair
Snow
Hot
Moderate
Cold
Fog
Figured By
Notes Checked By
Plotted By
Quad. No.

FILE No. 160-H
Fldr. No. _____
Sheet 1 of 2
Date 12-21-1950

Station	Dist.	Angle "	+	H. I. Bearing	Ver: Ang. Diff.	Elevation	
B.M.				34.44		30.50	Finish concrete floor Bldg. #1705
	4.00			34.50			
T.P.					5.43	29.01 29.07	ON nail intersection of Gum St. and Michael Rd.
	5.00			34.07			
T.P.					5.43	28.64	
	5.66			34.30			
T.P.					9.00	25.30	top of 14" water line at 11 1/2° bend
	8.92			34.22			
T.P.					5.18	29.04	ON nail intersection of Gum St. and Michael Rd.
	5.41			34.45			
B.M.					3.96	30.47	ON Finish concrete floor Bldg. #1705
						<u>30.50</u>	

AVAILABLE










Station
Dist.
Bearing
Elevation

VALUABLE

Return To
Public Works
Office
Camp Lejeune
North Carolina

SUBJECT Position of Bend in
Water line in Back of Bldg.
1709
"coordinates"

FIELD PARTY

____ In Charge
____ Instrument
____ Notes
____ Tape Read
____ Tape or Rod
____ Tape or Rod
____ Instrument No.
____ Tape No.


WEATHER

Clear
Cloudy
Windy
Rain
Fair
Snow
Hot
Moderate
Cold
Fog
Figured By _____
Notes Checked By _____
Plotted By _____

FILE No. 160-H
Fldr. No. _____
Sheet 2 of 2
Date 12-21 19 50

Quad. No. _____

Station	Dist.	Angle "	+	H. I. Bearing	Ver: Ang. Diff.	Elevation
---------	-------	---------	---	---------------	-----------------	-----------

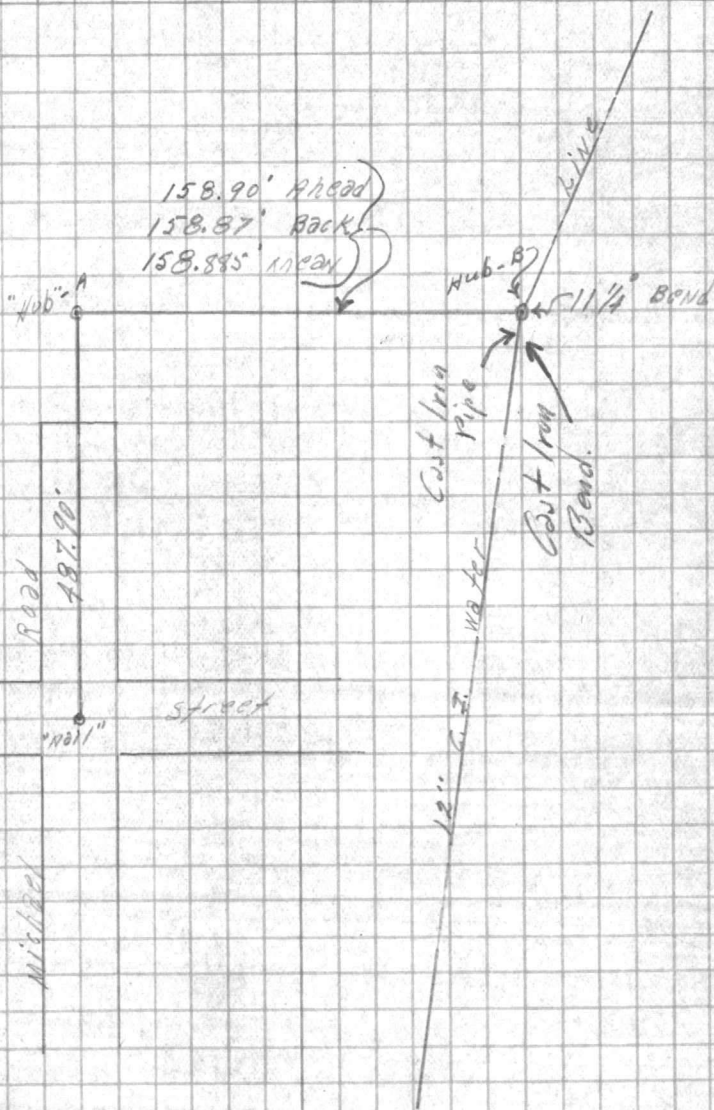

T-At "Hub-A" 128° 57' 15"
Back site 2-89° 54' 00"
at "Nail" mean 269° 57' 20"













Station Dist. Angle + Bearing M. I. Vert. Ang. Elevation

