

**VALUABLE**

Return To  
Public Works  
Office  
Camp LeJeune  
North Carolina

SUBJECT Location of tree at  
Mess Hall Hospital Area

**FIELD PARTY**

Pierce In Charge  
\_\_\_\_ Instrument  
\_\_\_\_ Notes  
\_\_\_\_ Tape Read  
\_\_\_\_ Tape or Rod  
\_\_\_\_ Tape or Rod  
\_\_\_\_ Instrument No.  
\_\_\_\_ Tape No.

**WEATHER**

Clear \_\_\_\_\_  
Cloudy \_\_\_\_\_  
Windy \_\_\_\_\_  
Rain \_\_\_\_\_  
Fair \_\_\_\_\_  
Snow \_\_\_\_\_  
Hot \_\_\_\_\_  
Moderate \_\_\_\_\_  
Cold \_\_\_\_\_  
Fog \_\_\_\_\_  
Figured By \_\_\_\_\_  
Notes Checked By \_\_\_\_\_  
Plotted By \_\_\_\_\_

FILE No. 139-X  
Fldr. No. \_\_\_\_\_  
Sheet #1 of  
Date 9-25- 1946

Quad. No. \_\_\_\_\_

Station	Dist.	Angle	+	H. I. Bearing	Ver: Ang. Diff.	Elevation
---------	-------	-------	---	------------------	--------------------	-----------

Occupational therapy

New water line for sprinkler system

Mess Hall

Porch

Water main existing

19'

tree

EXISTING

TABLET

Return To  
Public Works  
Office  
Camp Lejeune  
Newport, N.C.

SUBJECTS

Station  
Date  
Angle

H. L. Verrill  
E. L. ...

Vertical  
Elevation

FIELD PARTY

In Charge  
Instrument  
Notes  
Tape Book  
Tape or Plot  
Tape or Not  
Instrument No.  
Tape No.

WEATHER

Snow  
Foggy  
Moderate  
Fair  
Partly  
Cloudy  
Checked  
Plotted

MEMO

File #  
Sheet  
Date

RECEIVED BOARD

VALUABLE

SUBJECT

Profile on New  
Water Line at Hoop

Return To  
Public Works  
Office  
Camp Lejeune  
North Carolina

FIELD PARTY

Turlington In Charge  
Instrument  
Notes  
Tape Read  
Tape or Rod  
Tape or Rod  
Instrument No.  
Tape No.

WEATHER

Clear  
Cloudy  
Windy  
Rain  
Fair  
Snow  
Hot  
Moderate  
Cold  
Fog

FILE No. 139-X

Fldr. No.

Sheet 1-3

Date 4-23 1946

Figured By

Notes Checked By


Plotted By

Quad. No.

139

Station	Dist.	Angle "	+	H. I. Bearing	Ver: Ang. Diff.	Elevation
BM						15.265
			216	17.42		
0700					8.45	8.97
+41					7.94	9.48
86					7.65	9.77
1720	= 070 Bldg. Line				7.72	9.70
743					7.90	9.52
790.4 (A)	Hyd				8.41	9.01
39 (A)					8.34	9.08
84 (A)					10.20	7.22


car platform

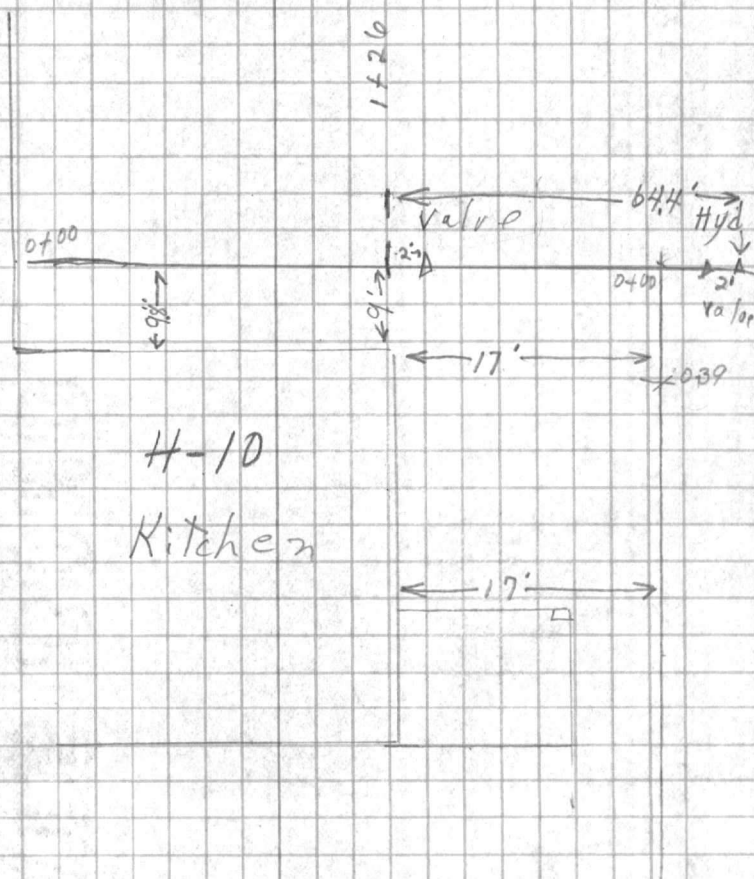




 

**VALUABLE**

SUBJECT \_\_\_\_\_

Return To  
Public Works  
Office  
Camp Lejeune  
North Carolina

\_\_\_\_\_  
\_\_\_\_\_  
\_\_\_\_\_

**FIELD PARTY**

\_\_\_\_\_. In Charge  
\_\_\_\_\_. Instrument  
\_\_\_\_\_. Notes  
\_\_\_\_\_. Tape Read  
\_\_\_\_\_. Tape or Rod  
\_\_\_\_\_. Tape or Rod  
\_\_\_\_\_. Instrument No.  
\_\_\_\_\_. Tape No.

**WEATHER**

Clear  
Cloudy  
Windy  
Rain  
Fair

Snow  
Hot  
Moderate  
Cold  
Fog

FILE No. \_\_\_\_\_

Fldr. No. \_\_\_\_\_

Sheet 2-3

Notes Checked By \_\_\_\_\_

Plotted By \_\_\_\_\_ Date 4-23 19\_\_\_\_

Quad. No. \_\_\_\_\_

Station	Dist.	Angle ° ' "	+	H. I. Bearing	Ver: Ang. Diff.	Elevation
<p>Pipe Some Eled as Tee</p>						










OVER

VALUABLE

SUBJECT \_\_\_\_\_

Return To  
Public Works  
Office  
Camp LeJeune  
North Carolina

FIELD PARTY

\_\_\_\_\_ In Charge  
\_\_\_\_\_ Instrument  
\_\_\_\_\_ Notes  
\_\_\_\_\_ Tape Read  
\_\_\_\_\_ Tape or Rod  
\_\_\_\_\_ Tape or Rod  
\_\_\_\_\_ Instrument No. \_\_\_\_\_  
\_\_\_\_\_ Tape No. \_\_\_\_\_

WEATHER

Clear \_\_\_\_\_  
Cloudy \_\_\_\_\_  
Windy \_\_\_\_\_  
Rain \_\_\_\_\_  
Fair \_\_\_\_\_  
Snow \_\_\_\_\_  
Hot \_\_\_\_\_  
Moderate \_\_\_\_\_  
Cold \_\_\_\_\_  
Fog \_\_\_\_\_

FILE No. \_\_\_\_\_

Fldr. No. \_\_\_\_\_

Sheet 3-3

Date 4-23 19\_\_


Figured By \_\_\_\_\_

Notes Checked By \_\_\_\_\_

Plotted By \_\_\_\_\_

Quad. No. \_\_\_\_\_

Station	Dist.	Angle ° ' "	+	H. I. Bearing	Ver: Ang. Diff.	Elevation
---------	-------	----------------	---	------------------	--------------------	-----------

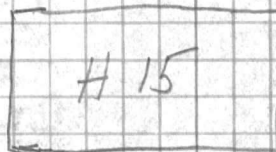

133'

95'

22.5'

Hyd

Y. L. L. L.  
Public Works  
Office  
Camp Lejeune  
North Carolina

Subject

Station

Dist.

Angle

M. I. Station

Vertical Angle

Horizontal Angle

Tap No.

Wind No.

Time on Rec.

Tap No.

Notes

In Charge

FIELD PARTY

Grid No.

Plotted By

Checked By

Plotted By

Checked By

Notes

Class

WEATHER

THIS NO.

Dist. No.

Sheet

Date

Page



**VALUABLE**

SUBJECT WATER SERVICE LOCATION  
NAVAL HOSPITAL.

Return To  
Public Works  
Office  
Camp Lejeune  
North Carolina


FIELD PARTY  
KELMAN In Charge  
\_\_\_\_ Instrument  
\_\_\_\_ Notes  
\_\_\_\_ Tape Read  
\_\_\_\_ Tape or Rod  
\_\_\_\_ Tape or Rod  
\_\_\_\_ Instrument No.  
\_\_\_\_ Tape No.

WEATHER  
Clear \_\_\_\_\_  
Cloudy \_\_\_\_\_  
Windy \_\_\_\_\_  
Rain \_\_\_\_\_  
Fair \_\_\_\_\_  
Snow \_\_\_\_\_  
Hot \_\_\_\_\_  
Moderate \_\_\_\_\_  
Cold \_\_\_\_\_  
Fog \_\_\_\_\_  
Figured By \_\_\_\_\_  
Notes Checked By \_\_\_\_\_  
Plotted By \_\_\_\_\_  
Quad. No. \_\_\_\_\_

FILE No. 139-X  
Fldr. No. \_\_\_\_\_  
Sheet 1-05-1  
Date 1-24-1947

Station	Dist.	Angle " +	H. I. Bearing	Ver: Ang. Diff.	Elevation
B.M.		0.74	17.58		16.84
0+00				9.25	8.39
0+07				8.60	8.98
1+73.5				7.65	9.93
2+56.9				6.46	11.12
B.M.		0.74	16.84		

ON NAIL RIVER ROAD AND WALLACE ROAD.

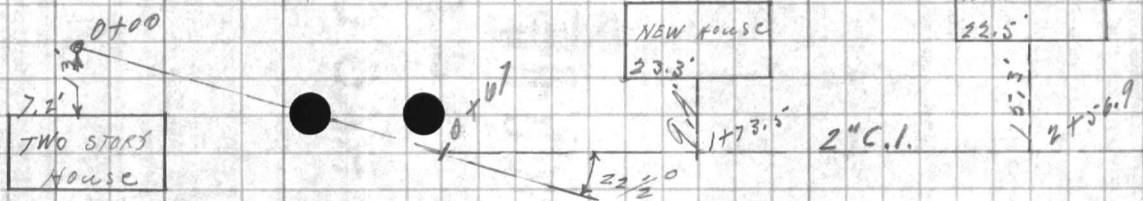

NAIL RIVER ROAD & WALLACE ROAD.








**VALUABLE**

SUBJECT

Maint. Force const. Bldg.

RETURN TO  
PUBLIC WORKS  
OFFICE  
CAMP LEJEUNE  
NORTH CAROLINA

Incinerator

Naval Hospital

FIELD PARTY

Merton IN CHARGE

INSTRUMENT

NOTES

TAPE READ

TAPE OR ROD

TAPE OR ROD

INSTRUMENT No.

TAPE No.

WEATHER

CLEAR  
CLOUDY  
WINDY  
RAIN  
FAIR

SNOW  
HOT  
MODERATE  
COLD  
FOG

FILE No. 139-X

FLDR. No.

FIGURED BY SHEET 1 of

NOTES CHECKED BY

PLOTTED BY DATE 5/2 1955


Quad. No.

STATION	DIST.	ANGLE " "	+	H. I. BEARING	VER. ANG. DIFF.	ELEVATION
MEDICAL INCINERATOR						

H-20

H-19

Drive

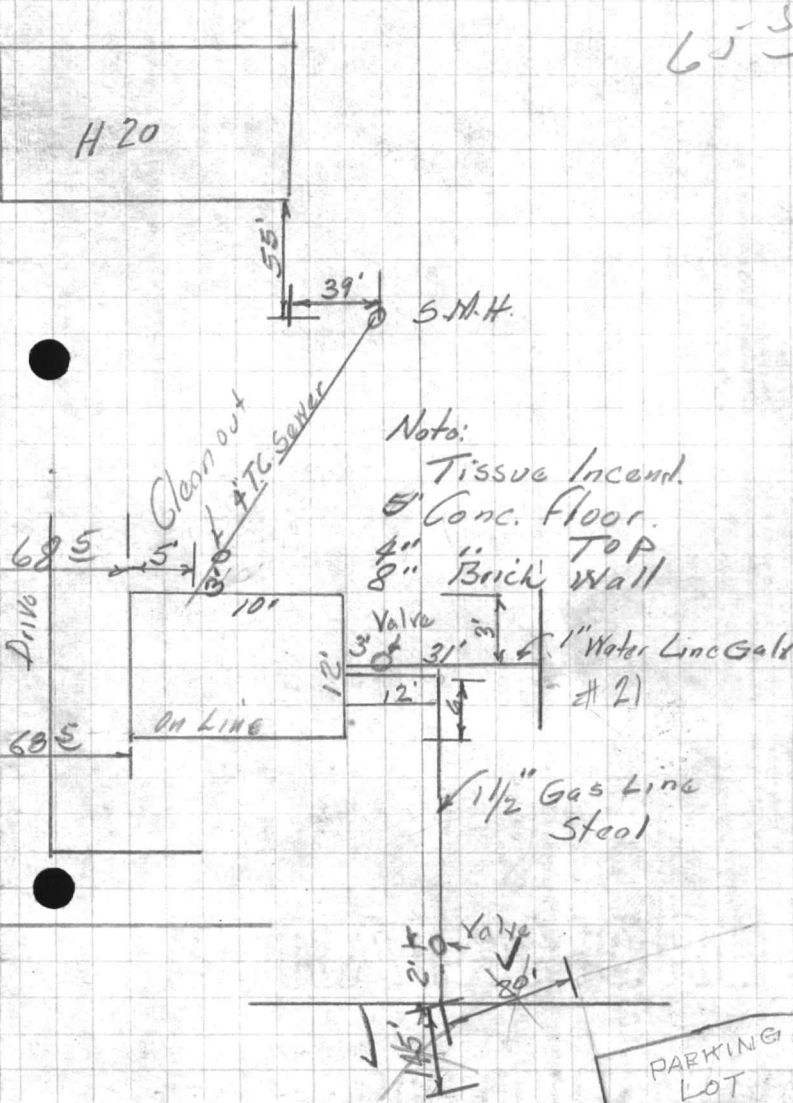

1235  
655

Notes:

- Tissue Incand.
- 5' Conc. Floor.
- 4" TOP
- 8" Brick Wall
- 3" Valve
- 1" Water Line Galv #2
- 1 1/2" Gas Line Steel

PARKING LOT



68.5  
40  
23  
8.5

---

5  
5




**VALUABLE**

SUBJECT sewer Replacement survey  
At Naval Hosp.

RETURN TO  
PUBLIC WORKS  
OFFICE  
CAMP LEJEUNE  
NORTH CAROLINA

FIELD PARTY

Kellum IN CHARGE  
\_\_\_\_\_  
INSTRUMENT  
\_\_\_\_\_  
NOTES  
\_\_\_\_\_  
TAPE READ  
\_\_\_\_\_  
TAPE OR ROD  
\_\_\_\_\_  
TAPE OR ROD  
\_\_\_\_\_  
INSTRUMENT NO. 3  
TAPE NO. 3


WEATHER

CLEAR  
CLOUDY  
WINDY  
RAIN  
FAIR  
SNOW  
HOT  
MODERATE  
COLD  
FOG

FILE No. 139-X  
FLDR. No. \_\_\_\_\_  
SHEET 1-04  
DATE 5-13 1959

Quad. No. \_\_\_\_\_

STATION	DIST.	ANGLE " "	+	H. I. BEARING	VER. ANG. DIFF.	ELEVATION
M.H. #373 5+59.33						
M.H. #372 3+92.68						
M.H. #371 2+02.42						
M.H. #237 0+00						

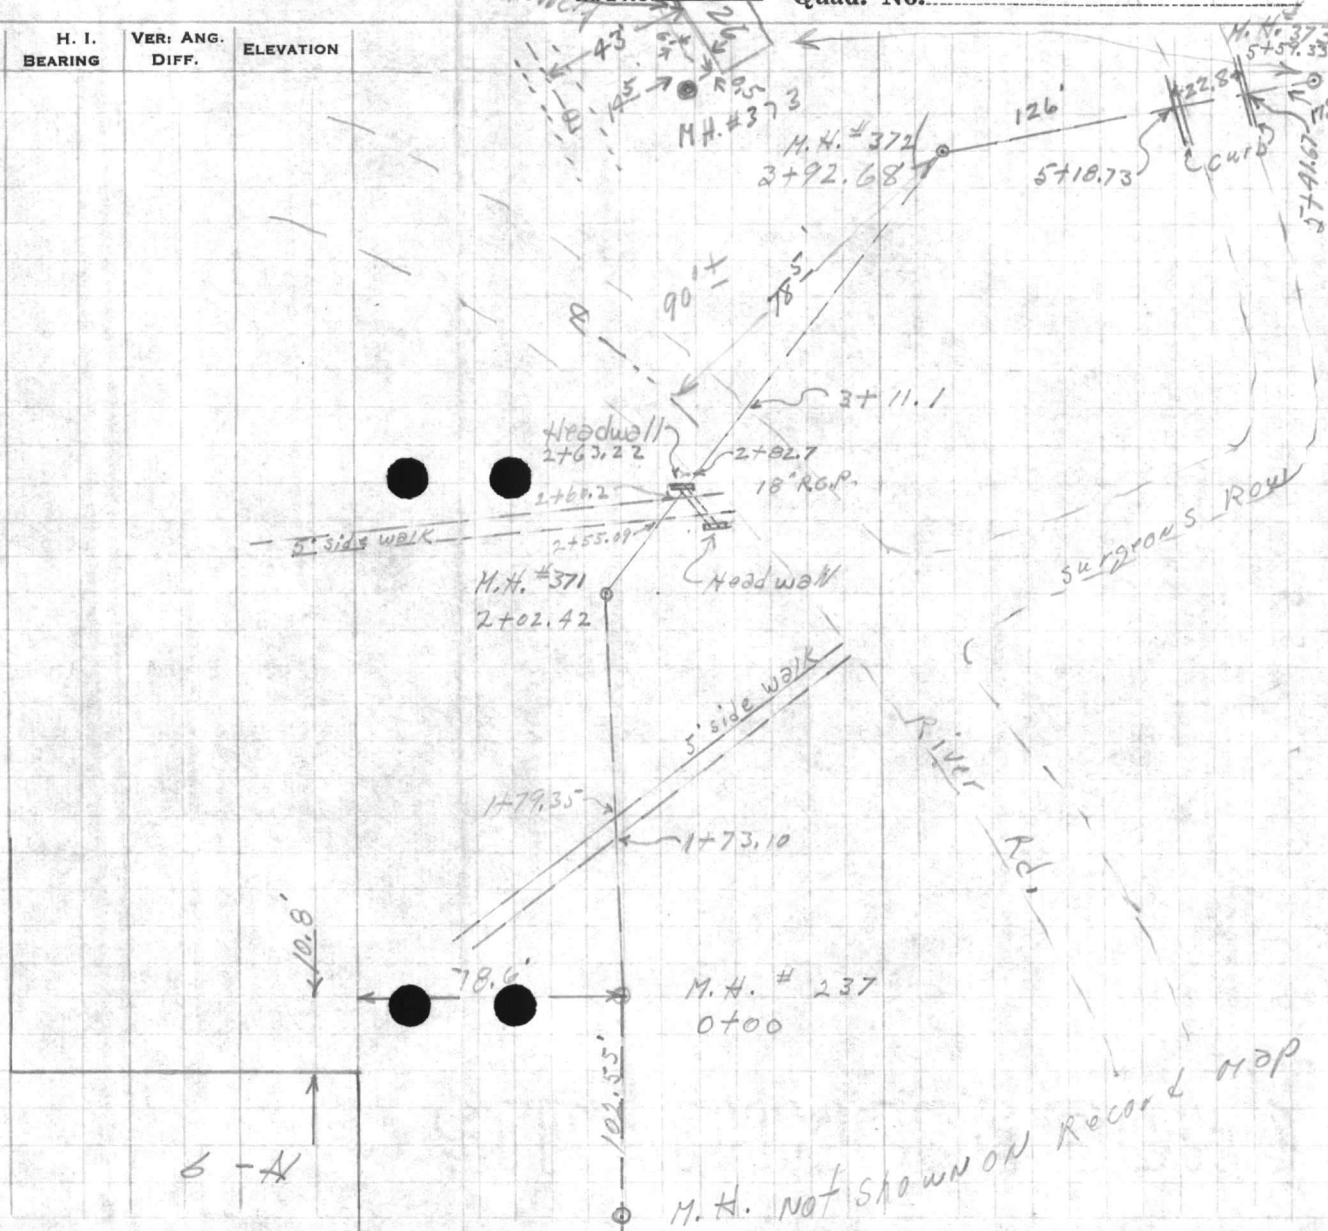

M.H. NOT SHOWN ON RECORD MAP








**VALUABLE**

SUBJECT Profile on sewer  
Replacement at level  
Hospital

RETURN TO  
PUBLIC WORKS  
OFFICE  
CAMP LEJEUNE  
NORTH CAROLINA

FIELD PARTY  
Kellum IN CHARGE  
INSTRUMENT \_\_\_\_\_  
NOTES \_\_\_\_\_  
TAPE READ \_\_\_\_\_  
TAPE OR ROD \_\_\_\_\_  
TAPE OR ROD \_\_\_\_\_  
TRUMENT No. \_\_\_\_\_  
TAPE No. \_\_\_\_\_


WEATHER  
CLEAR SNOW  
CLOUDY HOT  
WINDY MODERATE  
RAIN COLD  
FAIR FOG  
FIGURED BY \_\_\_\_\_  
NOTES CHECKED BY \_\_\_\_\_  
PLOTTED BY \_\_\_\_\_

FILE No. \_\_\_\_\_  
FLDR. No. \_\_\_\_\_  
SHEET 2-0f  
DATE 5-13 1959

Quad. No. \_\_\_\_\_

STATION	DIST.	ANGLE ° ' "	+	H. I. BEARING	VER: ANG. DIFF.	ELEVATION
B.M.						151.33
					0.96/16.29	
0+00	TOP M.H. # 237				5.9	10.4
	Floor M.H.				12.16	4.13
INV. "A"	M.H. # 237				12.59	3.70
INV. "B"	" "				12.58	3.71
INV. "C"	" "				12.45	3.84
0+28	12' Lft. 18" pine					
0+44	18' Lft. 20" pine					
0+50					5.6	10.7
0+89	15' Lft. 16" pine					
1+0					5.6	10.7
1+50					5.6	10.7
+73.10	Edge 5' walk				4.93	11.36
+79.35	" " "				4.90	11.39
2+0					5.7	10.6
2+02.42	TOP M.H. # 371				5.7	10.6
INV. "A"	M.H. # 371				11.60	4.69
" "B"	" "				11.38	4.91
INV. "C"	" "				11.36	4.93
2+29	6' Lft. 18" pine					
2+50	4' Rt. End of 6" H.W.				8" W.I.	
+50					6.4	9.9
2+50	8' Rt. INV. 18" R.C.P.				9.32	6.97
2+55.09	Edge 5' walk				6.34	9.95
2+60.1	" " "				6.38	9.91
2+63.22	HEADWAY				6.44	9.85
" "	" "				9.02	7.27

FINISH FLOOR Bldg. N-8

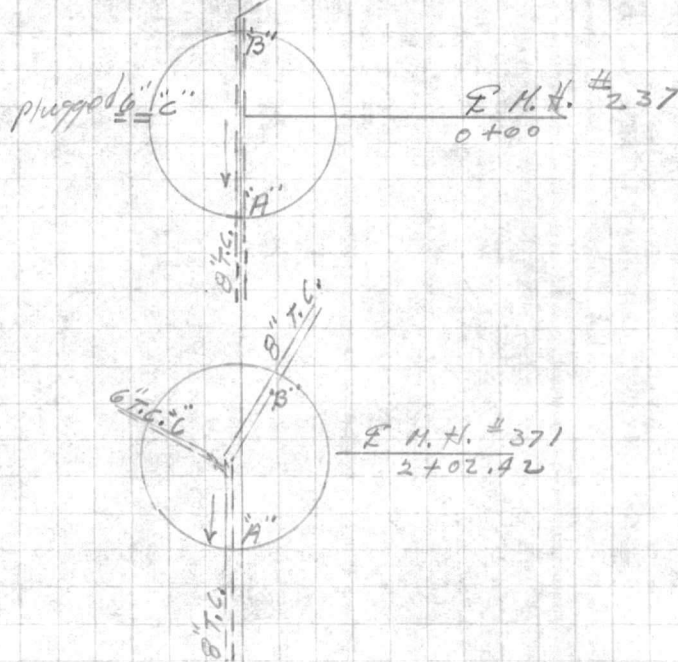

Floor M.H. # 371, Elev. 5.19

End Headway 1' Rt. 6' Long.  
2' Lt. INV. 18" R.C.P.


























**VALUABLE**

SUBJECT

*Profile contd.*

RETURN TO  
PUBLIC WORKS  
OFFICE  
CAMP LEJEUNE  
NORTH CAROLINA

**FIELD PARTY**

IN CHARGE \_\_\_\_\_  
INSTRUMENT \_\_\_\_\_  
NOTES \_\_\_\_\_  
TAPE READ \_\_\_\_\_  
TAPE OR ROD \_\_\_\_\_  
TAPE OR ROD \_\_\_\_\_  
INSTRUMENT NO. \_\_\_\_\_  
TAPE NO. \_\_\_\_\_

**WEATHER**

CLEAR \_\_\_\_\_ SNOW \_\_\_\_\_  
CLOUDY \_\_\_\_\_ HOT \_\_\_\_\_  
WINDY \_\_\_\_\_ MODERATE \_\_\_\_\_  
RAIN \_\_\_\_\_ COLD \_\_\_\_\_  
FAIR \_\_\_\_\_ FOG \_\_\_\_\_

FILE No. \_\_\_\_\_

FLDR. No. \_\_\_\_\_

SHEET *3-07*

DATE *5-13 1959*

FIGURED BY \_\_\_\_\_

NOTES CHECKED BY \_\_\_\_\_

PLOTTED BY \_\_\_\_\_

Quad. No. \_\_\_\_\_

STATION	DIST.	ANGLE ° ' "	+	H. I. BEARING	VER. ANG. DIFF.	ELEVATION	
				<i>16.29</i>			
<i>2+63.5</i>					<i>8.7</i>	<i>7.6</i>	<i>Ground at H.W. in ditch</i>
<i>2+69</i>					<i>7.1</i>	<i>9.2</i>	<i>BANK</i>
<i>2+82.7</i>	<i>Edge River Road</i>				<i>6.57</i>	<i>9.72</i>	
<i>3+00</i>	<i>IN RIVER ROAD</i>				<i>6.00</i>	<i>10.29</i>	
<i>3+11.1</i>	<i>Edge River Road</i>				<i>5.72</i>	<i>10.57</i>	
<i>T.B.M.</i>				<i>✓</i>	<i>6.44</i>	<i>9.85</i>	<i>ON COR. OF H.W. 2+63.2</i>
				<i>5.63</i>	<i>15.48</i>		
<i>3+16</i>	<i>9' Rt.</i>						<i>2" Dogwood</i>
<i>3+24</i>	<i>4' Lt.</i>				<i>5.2</i>	<i>10.3</i>	<i>Corner of Rose Garden</i>
<i>3+41</i>	<i>12' Rt.</i>				<i>5.8</i>	<i>9.7</i>	<i>18" Pine — Azalea Bed Starts here, lies to Rt.</i>
<i>"</i>	<i>3' Rt.</i>						<i>Edge Rose Garden</i>
<i>3+63</i>	<i>3' Rt.</i>						<i>Valve on Water Line.</i>
<i>"</i>	<i>4' Rt.</i>						<i>1" Spigot</i>
<i>3+65</i>							<i>End of Rose Garden</i>
<i>3+69</i>					<i>6.1</i>	<i>9.4</i>	<i>Center of 2' Wide, Conc. Stone Path. Ends 45' Rt.</i>
<i>3+82</i>							<i>Edge of 2nd. Rose Garden</i>
<i>3+90</i>					<i>6.6</i>	<i>8.9</i>	
<i>3+92.68</i>	<i>M.H.# 372 Top</i>				<i>6.44</i>	<i>9.04</i>	
<i>"</i>	<i>Inlet Inv. 8" T.C.</i>				<i>10.06</i>	<i>5.42</i>	
<i>"</i>	<i>Outlet " 8" T.C.</i>				<i>10.14</i>	<i>5.34</i>	
<i>"</i>	<i>Floor of M.H.</i>				<i>9.62</i>	<i>5.86</i>	
<i>4+0</i>					<i>6.6</i>	<i>8.9</i>	
<i>4+27</i>	<i>11' Rt.</i>						<i>15" Pine - Azalea Bed Rt. of Tree.</i>
<i>4+41</i>	<i>5' Rt.</i>				<i>6.2</i>	<i>9.3</i>	<i>18" " " " "</i>
<i>4+76</i>	<i>10' Lt.</i>						<i>8" Pine</i>
<i>5+0</i>					<i>5.3</i>	<i>10.2</i>	




VALUABLE





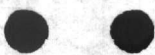

9.39

**VALUABLE**

SUBJECT

Sewer Replacement  
U.S.V. HospitalRETURN TO  
PUBLIC WORKS  
OFFICE  
CAMP LEJEUNE  
NORTH CAROLINA

FIELD PARTY

\_\_\_\_ IN CHARGE  
 \_\_\_\_ INSTRUMENT  
 \_\_\_\_ NOTES  
 \_\_\_\_ TAPE READ  
 \_\_\_\_ TAPE OR ROD  
 \_\_\_\_ TAPE OR ROD  
 \_\_\_\_ INSTRUMENT NO.  
 \_\_\_\_ TAPE NO.

WEATHER

CLEAR  
 CLOUDY  
 WINDY  
 RAIN  
 FAIR

SNOW  
 HOT  
 MODERATE  
 COLD  
 FOG

FILE No. \_\_\_\_\_

FLDR. No. \_\_\_\_\_

SHEET #4

DATE 5/14/1959

FIGURED BY \_\_\_\_\_

NOTES CHECKED BY \_\_\_\_\_

PLOTTED BY \_\_\_\_\_

Quad. No. \_\_\_\_\_

STATION	DIST.	ANGLE ° ' " +	H. I. BEARING	VER: ANG. DIFF.	ELEVATION
			15.48 ✓		
5+0					
5+10	1' Lt.			5.1	10.4
5+18.7				5.83	9.65
5+19.2				6.31	9.17
5+30.5	⊗ Drive (Asphalt)			5.96	9.52
5+41.2				6.29	9.19
5+41.7				5.80	9.68
5+51				5.4	10.1
5+59.33	M.H. #373 Top.			5.33	10.15
Inlet Inv. "A"	6" T.C.			9.35	6.13
" " "B"	6" T.C.			9.35	6.13
Outlet " "C"	8" T.C.			9.42	6.06
Floor M.H. "D"				8.90	6.58
B.M.				4.58	10.90 ✓

30" Quince Shrub. moved  
 Top 6" Curb. 2 1/2' Curb & Gutter  
 Gutter

Gutter  
 Top 6" Curb






(10.90)  
 Intersection of River Road + Surgeons Row  
 Near Bldg. H-42

USE for Const. B.M.




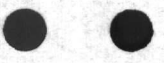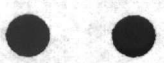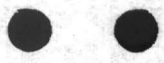



**VALUABLE**

SUBJECT \_\_\_\_\_  
 \_\_\_\_\_  
 \_\_\_\_\_  
 \_\_\_\_\_  
 \_\_\_\_\_

RETURN TO  
 PUBLIC WORKS  
 OFFICE  
 CAMP LEJEUNE  
 NORTH CAROLINA

**FIELD PARTY**

\_\_\_\_\_  
 IN CHARGE  
 \_\_\_\_\_  
 INSTRUMENT  
 \_\_\_\_\_  
 NOTES  
 \_\_\_\_\_  
 TAPE READ  
 \_\_\_\_\_  
 TAPE OR ROD  
 \_\_\_\_\_  
 TAPE OR ROD  
 \_\_\_\_\_  
 INSTRUMENT NO. \_\_\_\_\_  
 TAPE NO. \_\_\_\_\_

**WEATHER**

CLEAR  
 CLOUDY  
 WINDY  
 RAIN  
 FAIR

SNOW  
 HOT  
 MODERATE  
 COLD  
 FOG

FILE No. \_\_\_\_\_

FLDR. No. \_\_\_\_\_

FIGURED BY \_\_\_\_\_ SHEET \_\_\_\_\_

NOTES CHECKED BY \_\_\_\_\_

PLOTTED BY \_\_\_\_\_ DATE \_\_\_\_\_ 19\_\_\_\_

Quad. No. \_\_\_\_\_

STATION	DIST.	ANGLE ° ' "	+	H. I. BEARING	VER: ANG. DIFF.	ELEVATION	
T.B.M			5 10	14.95		9.85	on South H.W North end 90' from N.W. Corner Bldg # H-44
2+325					10.12	4.83	Top 10" C.I. Water line
T.B.M					5.10	9.85	← on South H.W North end 90' from N.W. Corner Bldg. # H-44
T.B.M			5.59	15.44			Top Concrete Slab Elect
0+29					7.57	7.87	Top Telephone
0+365					7.60	7.84	Top Power line
2+725					8.34	7.10	Top 1" water line
3+65					6.90	8.54	TOP Fire alarm Cable
4+97					7.22	8.22	Top power line
5+44					8.21	7.23	








 

**VALUABLE**

SUBJECT \_\_\_\_\_

RETURN TO  
PUBLIC WORKS  
OFFICE  
CAMP LEJEUNE  
NORTH CAROLINA

100

275

725

## FIELD PARTY

 \_\_\_\_\_ IN CHARGE  
 \_\_\_\_\_ INSTRUMENT  
 \_\_\_\_\_ NOTES  
 \_\_\_\_\_ TAPE READ  
 \_\_\_\_\_ TAPE OR ROD  
 \_\_\_\_\_ TAPE OR ROD  
 \_\_\_\_\_ INSTRUMENT NO.  
 \_\_\_\_\_ TAPE NO.

## WEATHER

 CLEAR SNOW  
 CLOUDY HOT  
 WINDY MODERATE  
 RAIN COLD  
 FAIR FOG

FILE No. \_\_\_\_\_

FLDR. No. \_\_\_\_\_


SHEET \_\_\_\_\_

NOTES CHECKED BY \_\_\_\_\_

PLOTTED BY \_\_\_\_\_ DATE \_\_\_\_\_ 19\_\_

Quad. No. \_\_\_\_\_

STATION	DIST.	ANGLE			H. I. BEARING	VER: ANG. DIFF.	ELEVATION
		°	'	"			
5+44							
5+12							
4+97							Fire alarm cable
3+65							1" water line
2+72 <sup>S</sup>							Elect. line
2+32 <sup>S</sup>							10" water line
0+36 <sup>S</sup>							Telephone
0+29							Concrete slab

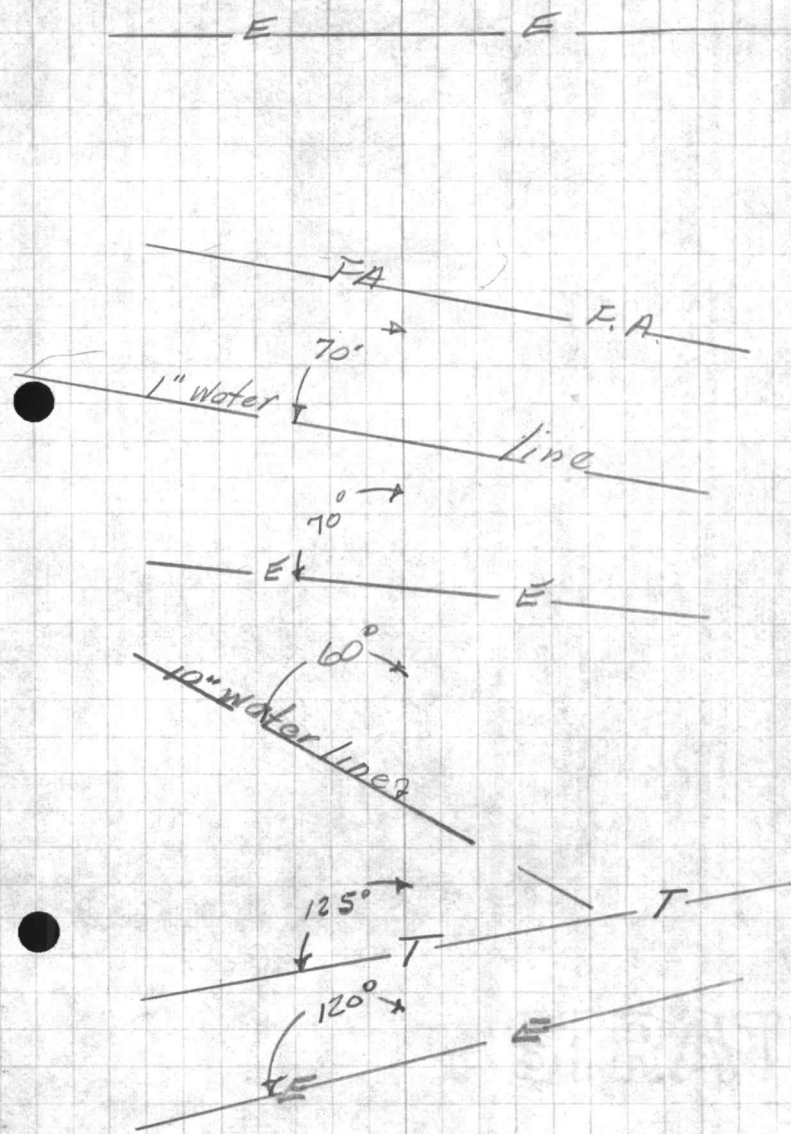



















VALUABLE

SUBJECT Existing utilities  
Location for sewer  
Replacement at Naval  
Hospital

RETURN TO  
PUBLIC WORKS  
OFFICE  
CAMP LEJEUNE  
NORTH CAROLINA

FIELD PARTY

\_\_\_\_ IN CHARGE  
\_\_\_\_ INSTRUMENT  
\_\_\_\_ NOTES  
\_\_\_\_ TAPE READ  
\_\_\_\_ TAPE OR ROD  
\_\_\_\_ TAPE OR ROD  
\_\_\_\_ INSTRUMENT No.  
\_\_\_\_ TAPE No.

WEATHER

CLEAR SNOW  
CLOUDY HOT  
WINDY MODERATE  
RAIN COLD  
FAIR FOG

FILE No. \_\_\_\_\_


FLDR. No. \_\_\_\_\_

SHEET \_\_\_\_\_

FIGURED BY \_\_\_\_\_  
NOTES CHECKED BY \_\_\_\_\_  
PLOTTED BY \_\_\_\_\_  
DATE 5-15-59

Quad. No. \_\_\_\_\_

STATION	DIST.	ANGLE ° ' "	+	H. I. BEARING	VER: ANG. DIFF.	ELEVATION
---------	-------	----------------	---	------------------	--------------------	-----------

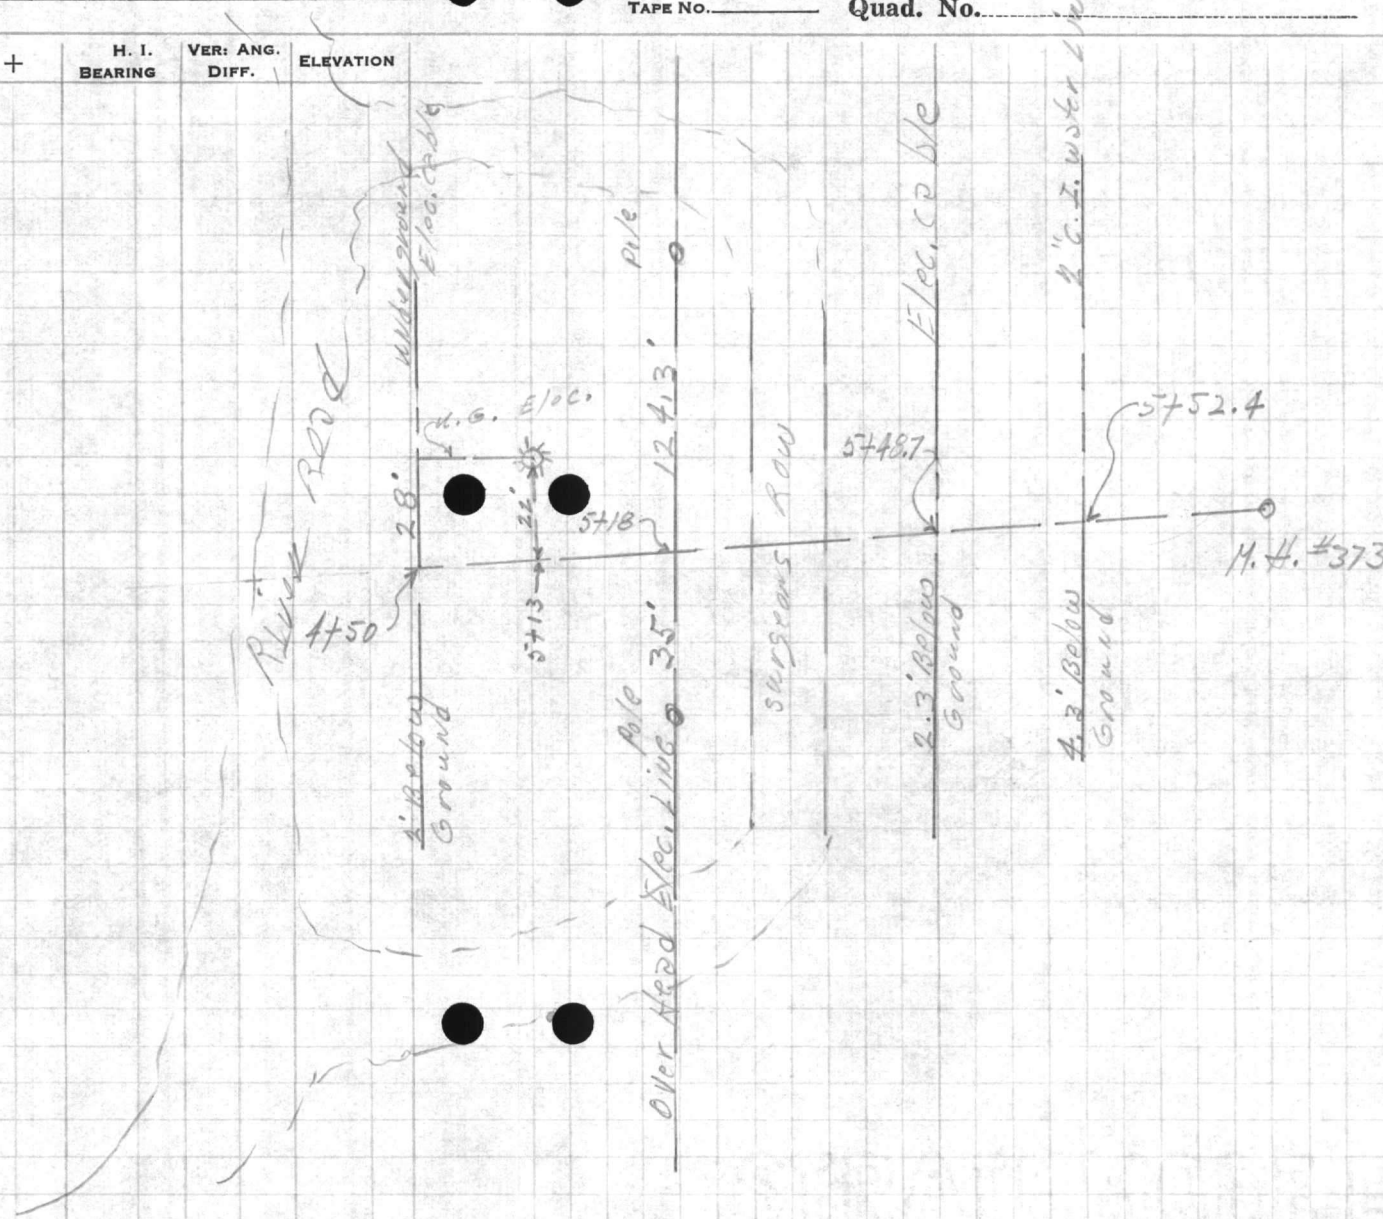

VALUABLE

SUBJECT





































**VALUABLE**

SUBJECT

ELEV. EXISTING  
WATER & SEWER LINES  
NAVAL HOSP. AREA.

RETURN TO  
 PUBLIC WORKS  
 OFFICE  
 CAMP LEJEUNE  
 NORTH CAROLINA

FIELD PARTY

DENNIS IN CHARGE

INSTRUMENT

NOTES

TAPE READ

TAPE OR ROD

TAPE OR ROD

INSTRUMENT No.

TAPE No.

WEATHER

CLEAR  
 CLOUDY  
 WINDY  
 RAIN  
 FAIR

SNOW  
 HOT  
 MODERATE  
 COLD  
 FOG

FIGURED BY

NOTES CHECKED BY

PLOTTED BY

FILE No. \_\_\_\_\_

FLDR. No. \_\_\_\_\_

SHEET 10A 1DATE 5-18 1959

Quad. No. \_\_\_\_\_

STATION	DIST.	ANGLE ° ' "	+	H. I. BEARING	VER: ANG. DIFF.	ELEVATION
				423 15.13		10 90
TOP 10" C.I.					10 28 4.85	STA. 2 + 32.5
TOP 8" T.C.					9 48 5.65	STA. 2 + 32.5
				232 13.22		10 90
TOP 4" C.I. WATER					7 42 5.80	STA. 5 + 52.4
GROUND.					3.1 10.1	AT STA. 5 + 52.4
TOP 8" T.C. SEWER					6 51 5.71	STA. 5 + 52.4














**VALUABLE**RETURN TO  
PUBLIC WORKS  
OFFICE  
CAMP LEJEUNE  
NORTH CAROLINASUBJECT Percolation TestAT U.S.N. HospitalWing H-3 Air Conditioning

FIELD PARTY

Kellum IN CHARGE

INSTRUMENT

NOTES

TAPE READ

TAPE OR ROD

TAPE OR ROD

INSTRUMENT No.

TAPE No.

WEATHER

CLEAR  
CLOUDY  
WINDY  
RAIN  
FAIRSNOW  
HOT  
MODERATE  
COLD  
FOG

FIGURED BY

NOTES CHECKED BY

PLOTTED BY

FILE No. 139-X

FLDR. No.

SHEET #1 of 2DATE 3-12 1960

Quad. No.

STATION	DIST.	ANGLE ° ' "	+	H. I. BEARING	VER: ANG. DIFF.	ELEVATION
---------	-------	----------------	---	------------------	--------------------	-----------

HOLE 2' X 6" DRY

HOLE FILLED WITH WATER AT 9<sup>35</sup>Water 1.75' deep AT 9<sup>50</sup>Water 1.60' deep AT 10<sup>05</sup>Water 1.40' deep AT 10<sup>20</sup>Water 1.30' deep AT 10<sup>50</sup>

See Next sheet






**VALUABLE**

SUBJECT SOIL BORINGS &  
PERCOLATION TEST AT  
W.S.M. HOSPITAL

RETURN TO  
 PUBLIC WORKS  
 OFFICE  
 CAMP LEJEUNE  
 NORTH CAROLINA

## FIELD PARTY

\_\_\_\_ IN CHARGE  
 \_\_\_\_ INSTRUMENT  
 \_\_\_\_ NOTES  
 \_\_\_\_ TAPE READ  
 \_\_\_\_ TAPE OR ROD  
 \_\_\_\_ TAPE OR ROD  
 \_\_\_\_ INSTRUMENT NO.  
 \_\_\_\_ TAPE NO.

## WEATHER

CLEAR  
 CLOUDY  
 WINDY  
 RAIN  
 FAIR

SNOW  
 HOT  
 MODERATE  
 COLD  
 FOG

FILE No. \_\_\_\_\_

FLDR. No. \_\_\_\_\_

SHEET # 242FIGURED BY \_\_\_\_\_ NOTES CHECKED BY \_\_\_\_\_ DATE 3-18-60

PLOTTED BY \_\_\_\_\_

Quad. No. \_\_\_\_\_

STATION	DIST.	ANGLE ° ' "	H. I. BEARING	VER. ANG. DIFF.	ELEVATION
---------	-------	----------------	------------------	--------------------	-----------

# Percolation Test

0.2' x 3" Hole Filled with  
 WATER AT 1<sup>08</sup> P.M.

AT 1<sup>15</sup> water is 10' below  
 TOP of GROUND

AT 1<sup>20</sup> water is 1.5' below grad.

AT 1<sup>25</sup> water is 1.8' below grad.

AT 1<sup>45</sup> water is 2.3' below grad.

AT 2<sup>00</sup> water is 2.5' below grad.

# Soil Boring Data

Ground	0.0
TOP SOIL	0.6
FINE GRAY SAND	2.6
YELLOW SAND 10% CLAY	4.4
MED. FINE YELLOW SAND	5.4
FINE WHITE SAND	6.2

1.0'  
1.0'  
1.8'  
1.8'













































































































**VALUABLE**

RETURN TO  
PUBLIC WORKS  
OFFICE  
CAMP LEJEUNE  
NORTH CAROLINA

SUBJECT

Loc. Buried L.P. Gas  
Tank and Oxygen Storage  
Enclosure at Naval Hospital

FIELD PARTY

IN CHARGE \_\_\_\_\_  
INSTRUMENT \_\_\_\_\_  
NOTES \_\_\_\_\_  
TAPE READ \_\_\_\_\_  
TAPE OR ROD \_\_\_\_\_  
TAPE OR ROD \_\_\_\_\_  
INSTRUMENT No. \_\_\_\_\_  
TAPE No. \_\_\_\_\_

WEATHER

CLEAR \_\_\_\_\_  
CLOUDY \_\_\_\_\_  
WINDY \_\_\_\_\_  
RAIN \_\_\_\_\_  
FAIR \_\_\_\_\_  
SNOW \_\_\_\_\_  
HOT \_\_\_\_\_  
MODERATE \_\_\_\_\_  
COLD \_\_\_\_\_  
FOG \_\_\_\_\_  
FIGURED BY \_\_\_\_\_  
NOTES CHECKED BY \_\_\_\_\_  
PLOTTED BY \_\_\_\_\_

FILE No. 139 X


FLDR. No. \_\_\_\_\_

SHEET 1 of 1

DATE 2/13/1964

Quad. No. \_\_\_\_\_

STATION	DIST.	ANGLE " "	+	H. I. BEARING	VER. ANG. DIFF.	ELEVATION
---------	-------	--------------	---	------------------	--------------------	-----------

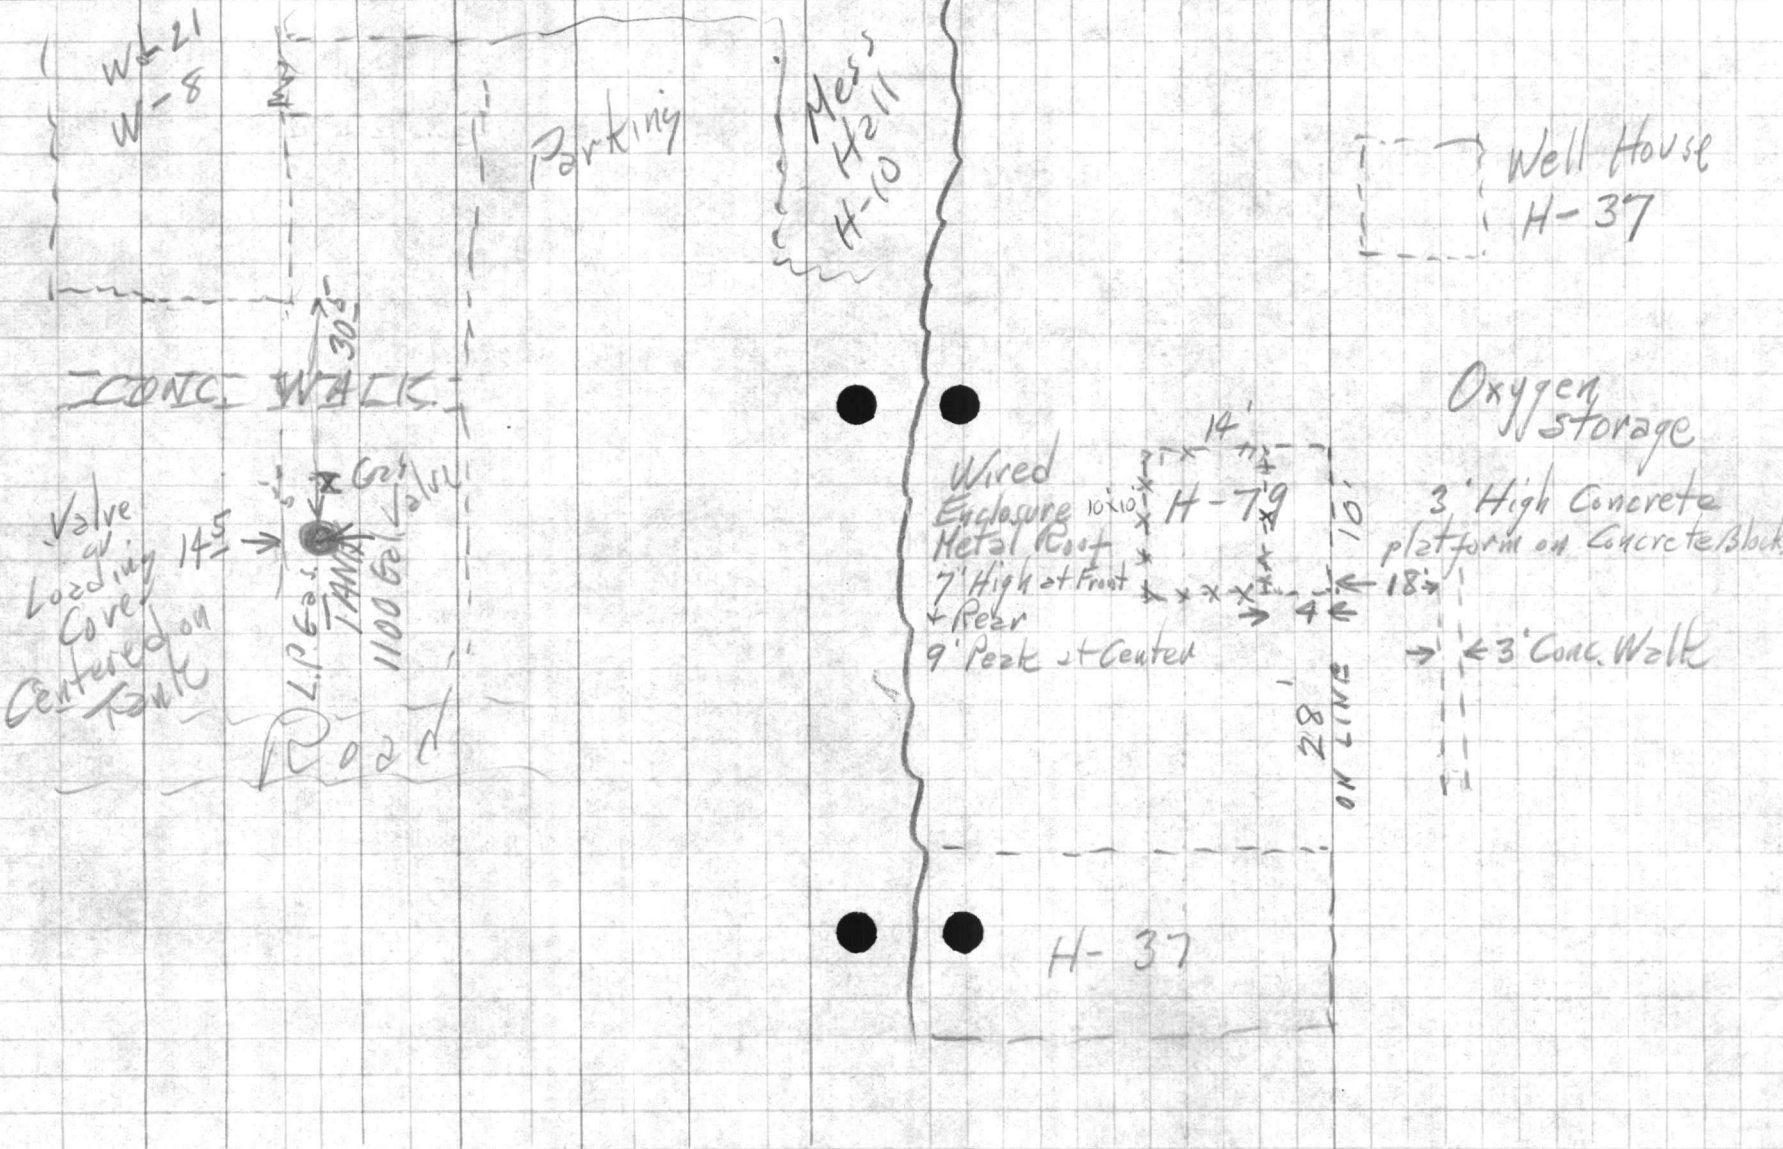




