


REVISION A
JAN. 23. 42.

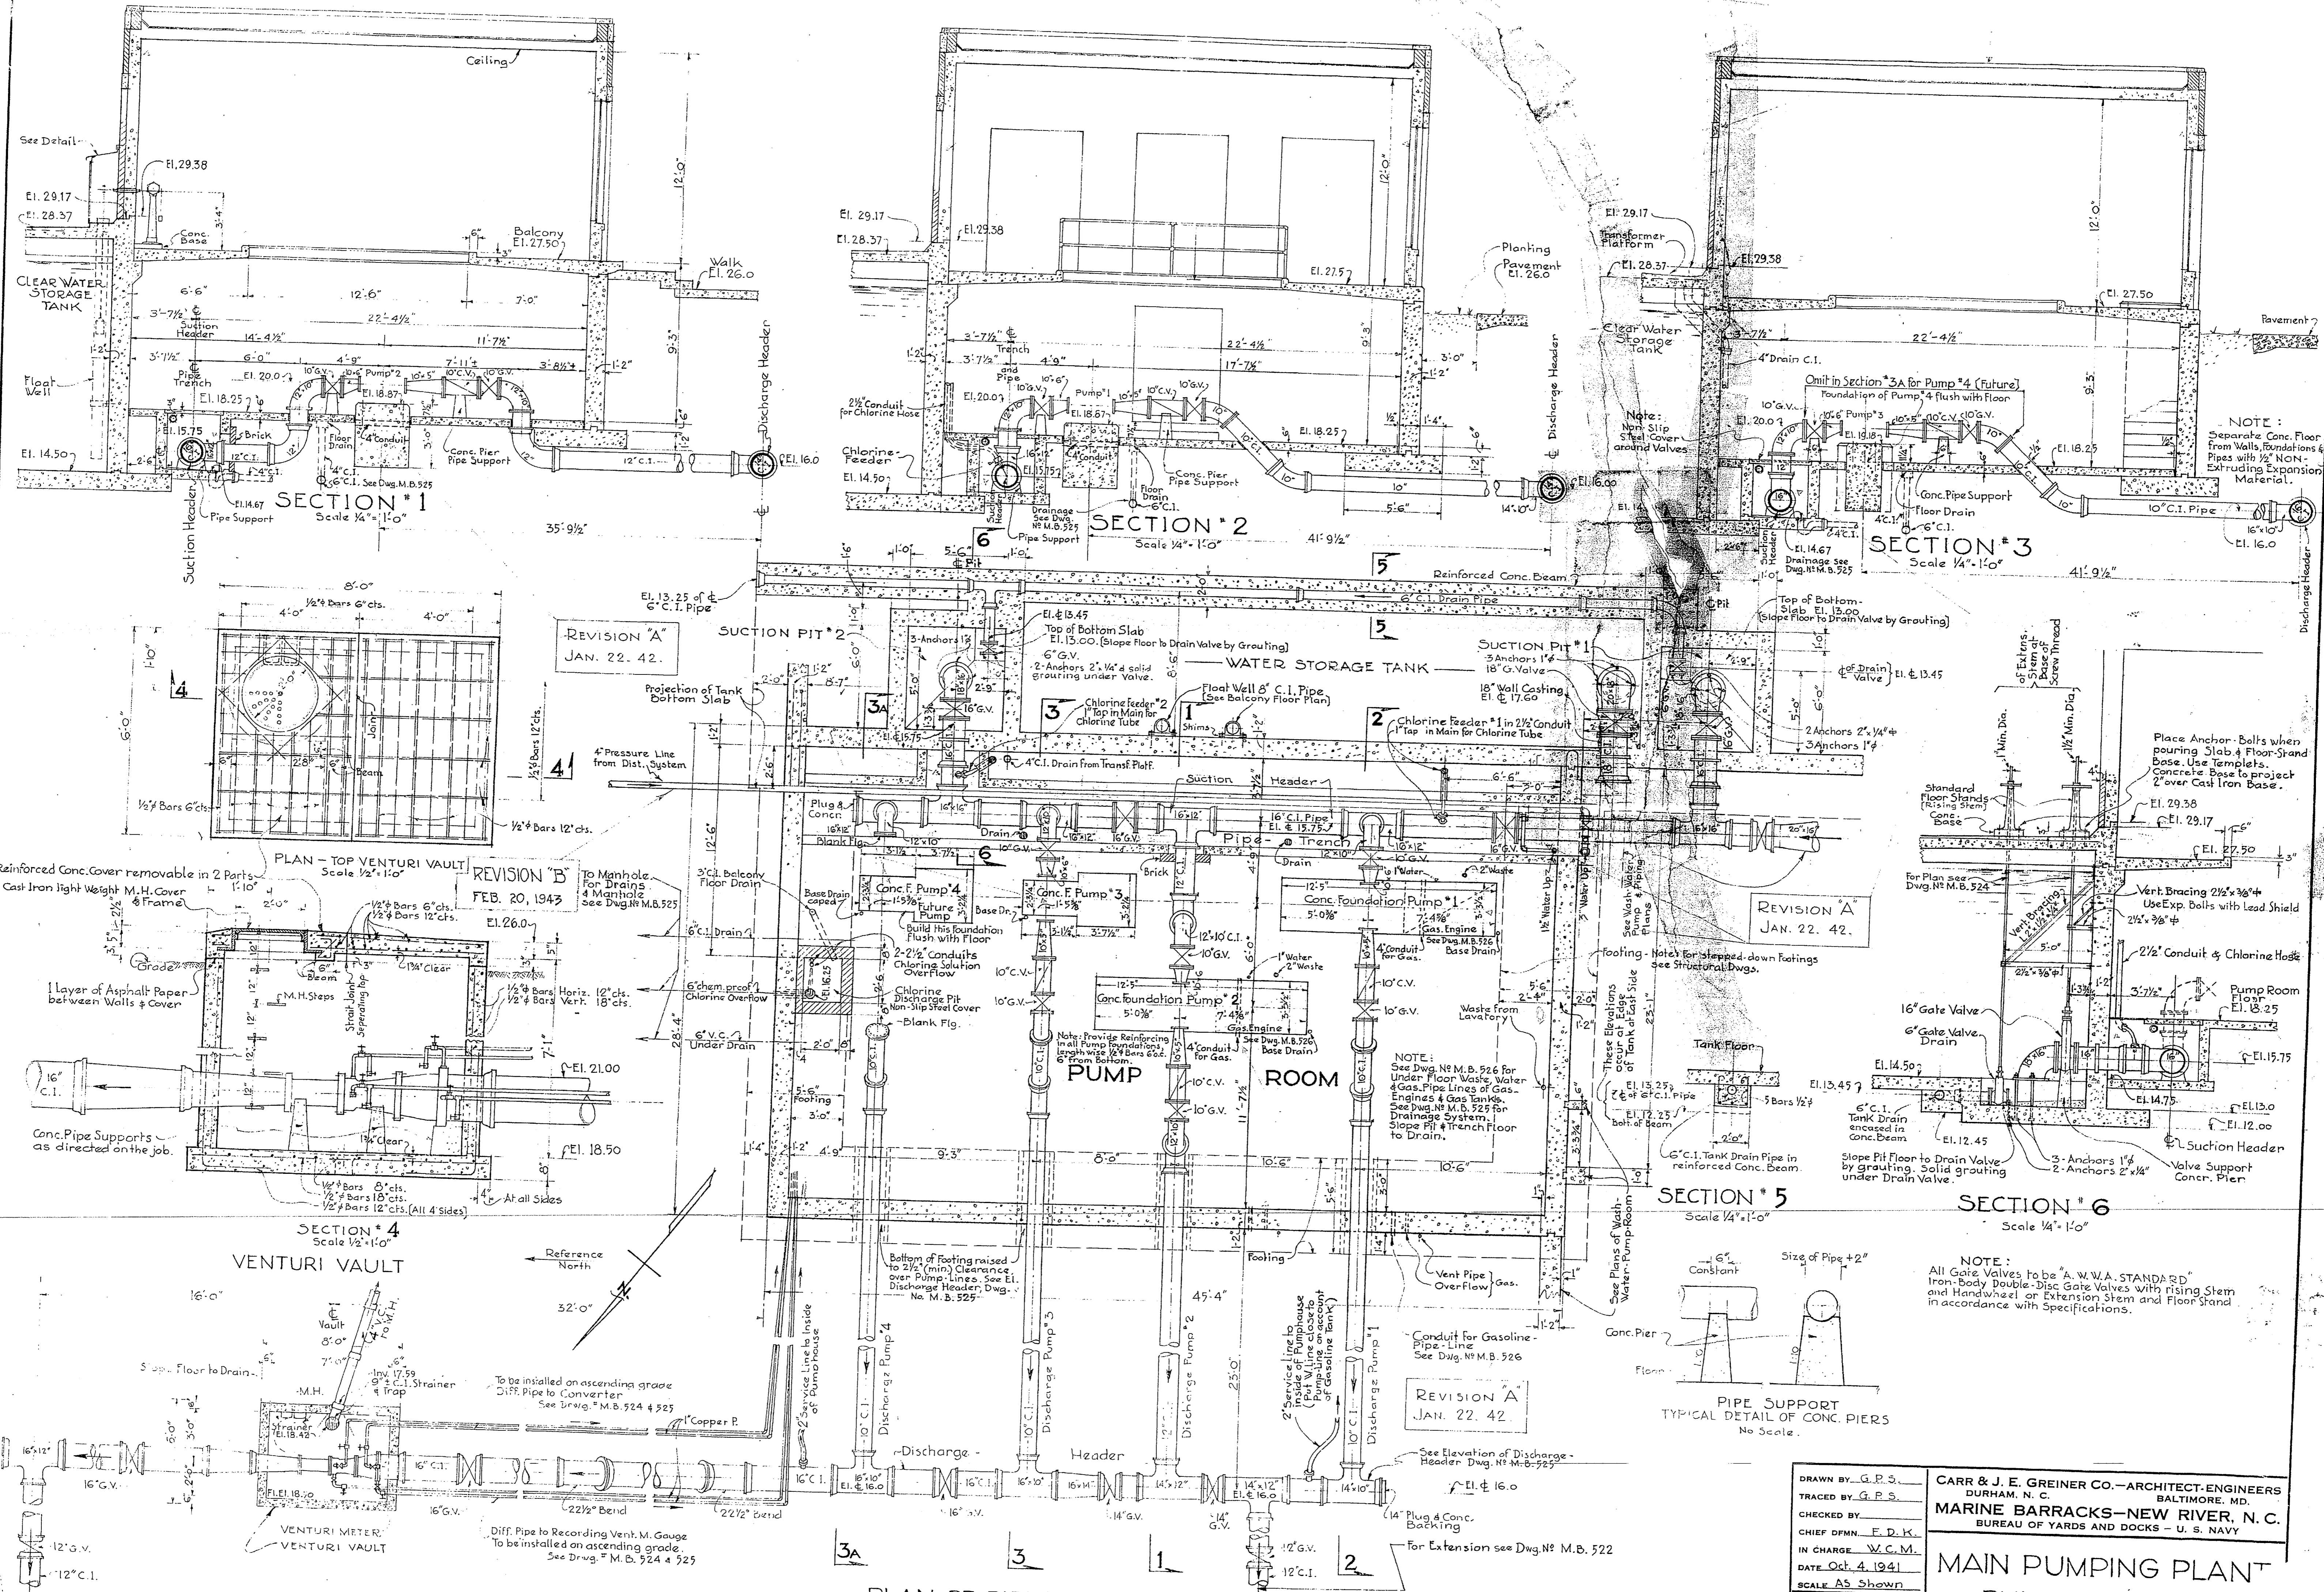

PLAN OF PIPES FOR PUMPS AND DRAINS

B	2-20-43	As Built Revisions - 4" Booster Line to Hydraulic Valves Added	J.W.S.
---	---------	--	--------

A	1.23.42	Architectural Info's. added to Sections	K.C.J. G.P.S.
A	1.22.42	Work on Suction Header, Tank, Fuel Supply & Ceiling System, also Notes added, Tank, etc.	J.W.S. G.P.S.

DRAWN BY: G.P.S.
 TRACED BY: G.P.S.
 CHECKED BY:
 CHIEF DFM: F.D.K.
 IN CHARGE: W.C.M.
 DATE: Oct. 4. 1941
 SCALE: AS SHOWN
 Y. & D. DRAWING NO.: 162203
 ARCHITECT-ENGINEERS: CARR & J. E. GREINER CO. - ARCHITECT-ENGINEERS DURHAM, N. C. BALTIMORE, MD. MARINE BARRACKS-NEW RIVER, N. C. BUREAU OF YARDS AND DOCKS - U. S. NAVY

MAIN PUMPING PLANT
PUMPS, PIPING &
VENTURI-METER

