



FED. ROAD DIST. NO.	STATE	FED. AID PROJ. NO.	FISCAL YEAR	SHEET NO.	TOTAL SHEETS
				10	10

DATE	BY

DATE	BY

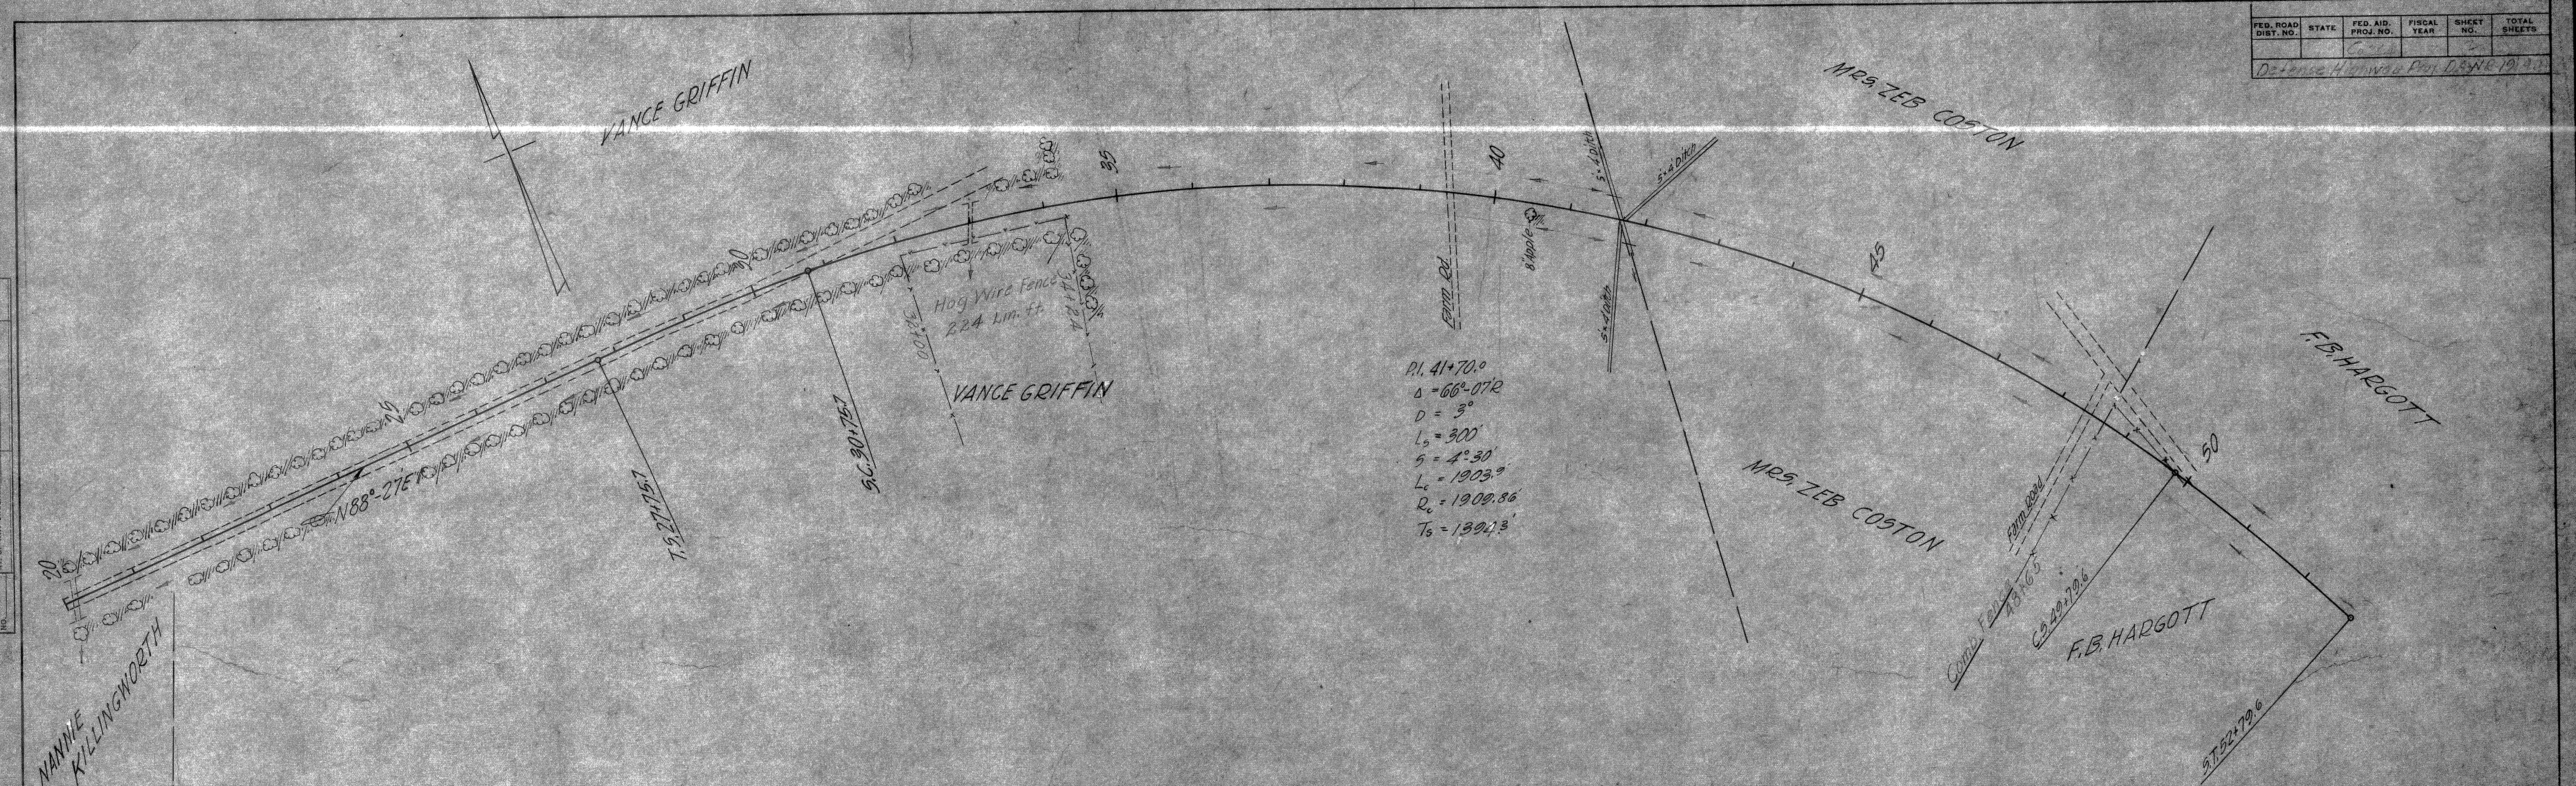

Note: Set encroaching fences back to right of way line.

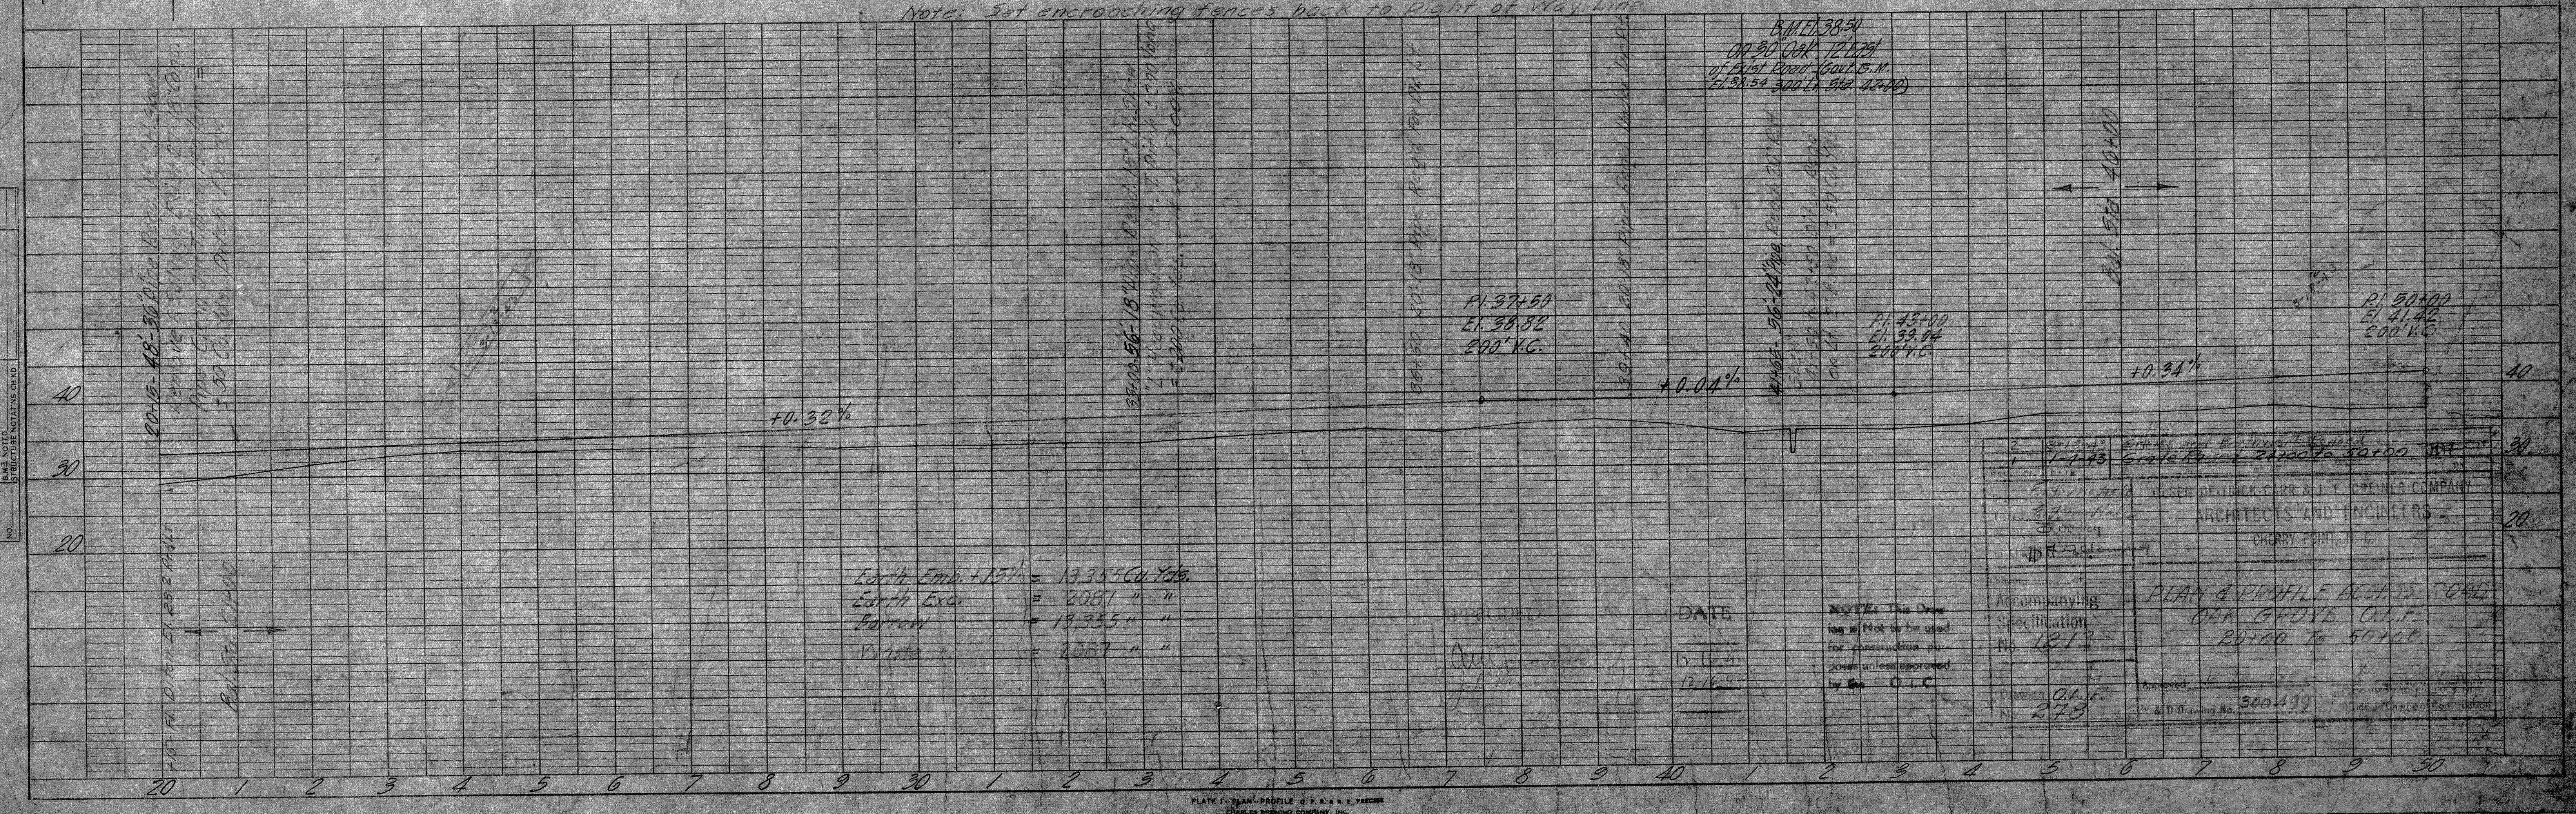



Approved: [Signature]
 C. I. C.

 20100 to 50100

