


- LEGEND**
- BUILDINGS AND STRUCTURES
 - ROADS AND HIGHWAYS
 - ROADS (Unpaved)
 - FENCE
 - 5' CONTOUR (Source - USGS Maps)
 - AIR STATION BOUNDARY
 - SWAMP OR MARSH
 - OVERHEAD PRIMARY POLE LINE 3 PHASE, UNLESS SINGLE PHASE NOTED.
 - POLE IDENTIFICATION NUMBER
 - OVERHEAD DISTRIBUTION TRANSFORMER
 - FUSED CUTOUT (CLOSED POSITION UNLESS INDICATED BY N.O.)
 - AIR SWITCH OPEN POSITION OR CLOSE POSITION
 - UNDERGROUND PRIMARY LINE 3 PHASE, UNLESS SINGLE PHASE NOTED
 - PAD MOUNTED TRANSFORMER
 - PAD MOUNTED SWITCH
 - GENERATOR

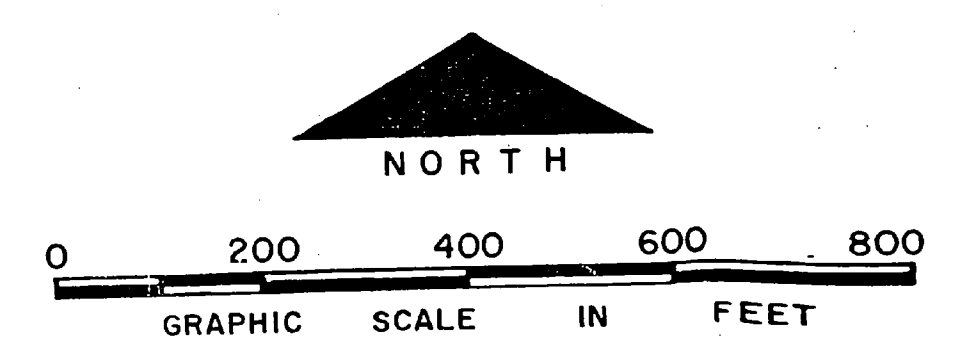

NO.	DESCRIPTION OF REVISION	DATE	INT.

DEPARTMENT OF THE NAVY
MARINE CORPS BASE
CAMP LEJEUNE, NORTH CAROLINA

ELECTRICAL DISTRIBUTION
EXISTING CONDITIONS

DATE 31 JULY 84 SCALE: GRAPHIC SHEET C-2 OF 73

APPROVED / DATE

THIS DRAWING HAS BEEN FIELD VERIFIED

