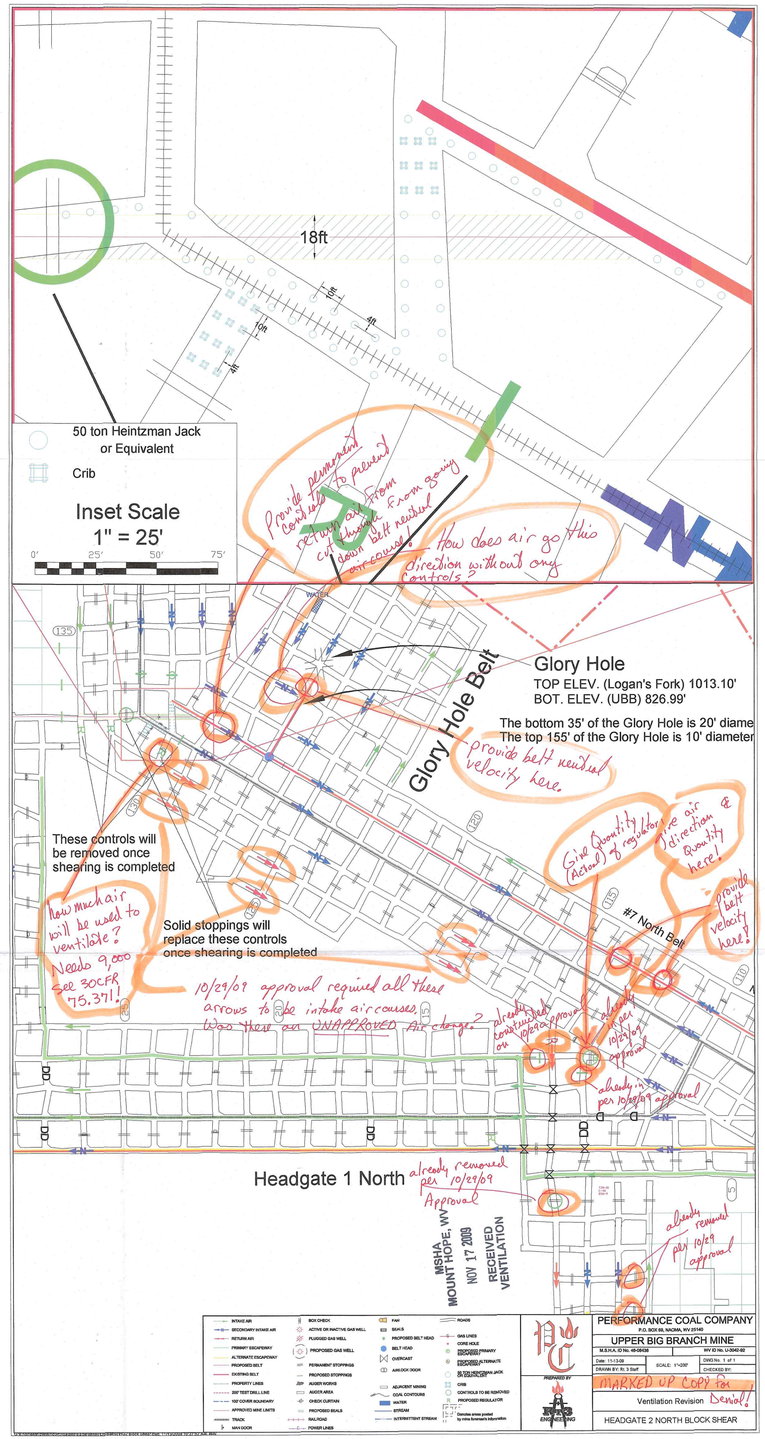
18ft
50 ton Heintzman Jack
or Equivalent
Crib
Inset Scale
1" = 25'
0'
25'
50'
75'
Glory Hole
TOP ELEV. (Logan's Fork) 1013.10'
BOT. ELEV. (UBB) 826.99'
The bottom 35' of the Glory Hole is 20' diame
The top 155' of the Glory Hole is 10' diameter
Glory Hole Belt
#7 North Belt
These controls will
be removed once
shearing is completed
Solid stoppings will
replace these controls
once shearing is completed
Headgate 1 North
MSHA
MOUNT HOPE, WV
NOV 17 2009
RECEIVED
VENTILATION
PERFORMANCE COAL COMPANY
P.O. BOX 99, NALONA, WV 25148
UPPER BIG BRANCH MINE
MARKED UP COPY for
Ventilation Revision
HEADGATE 2 NORTH BLOCK SHEAR